


3	ADDENDUM 2-4	24 MAY 2016
2	ADDENDUM 2-2	19 APR 2016
1	ADDENDUM 2-1	17 MAR 2016
-	ISSUED FOR CONSTRUCTION (BP2)	01 MAR 2016

No.	Description	Date
-----	-------------	------

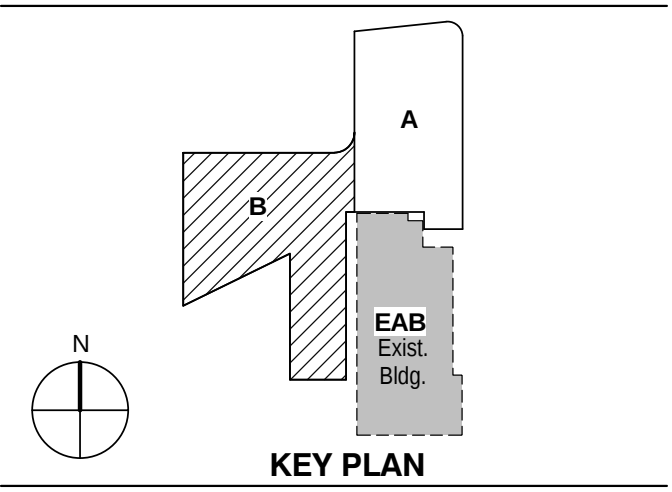


KEY PLAN

LEVEL 02 AREA B FLOOR
PLAN - PLUMBING WASTE
AND VENT

Project No.: 04561.01 Checked by:

P0112.B

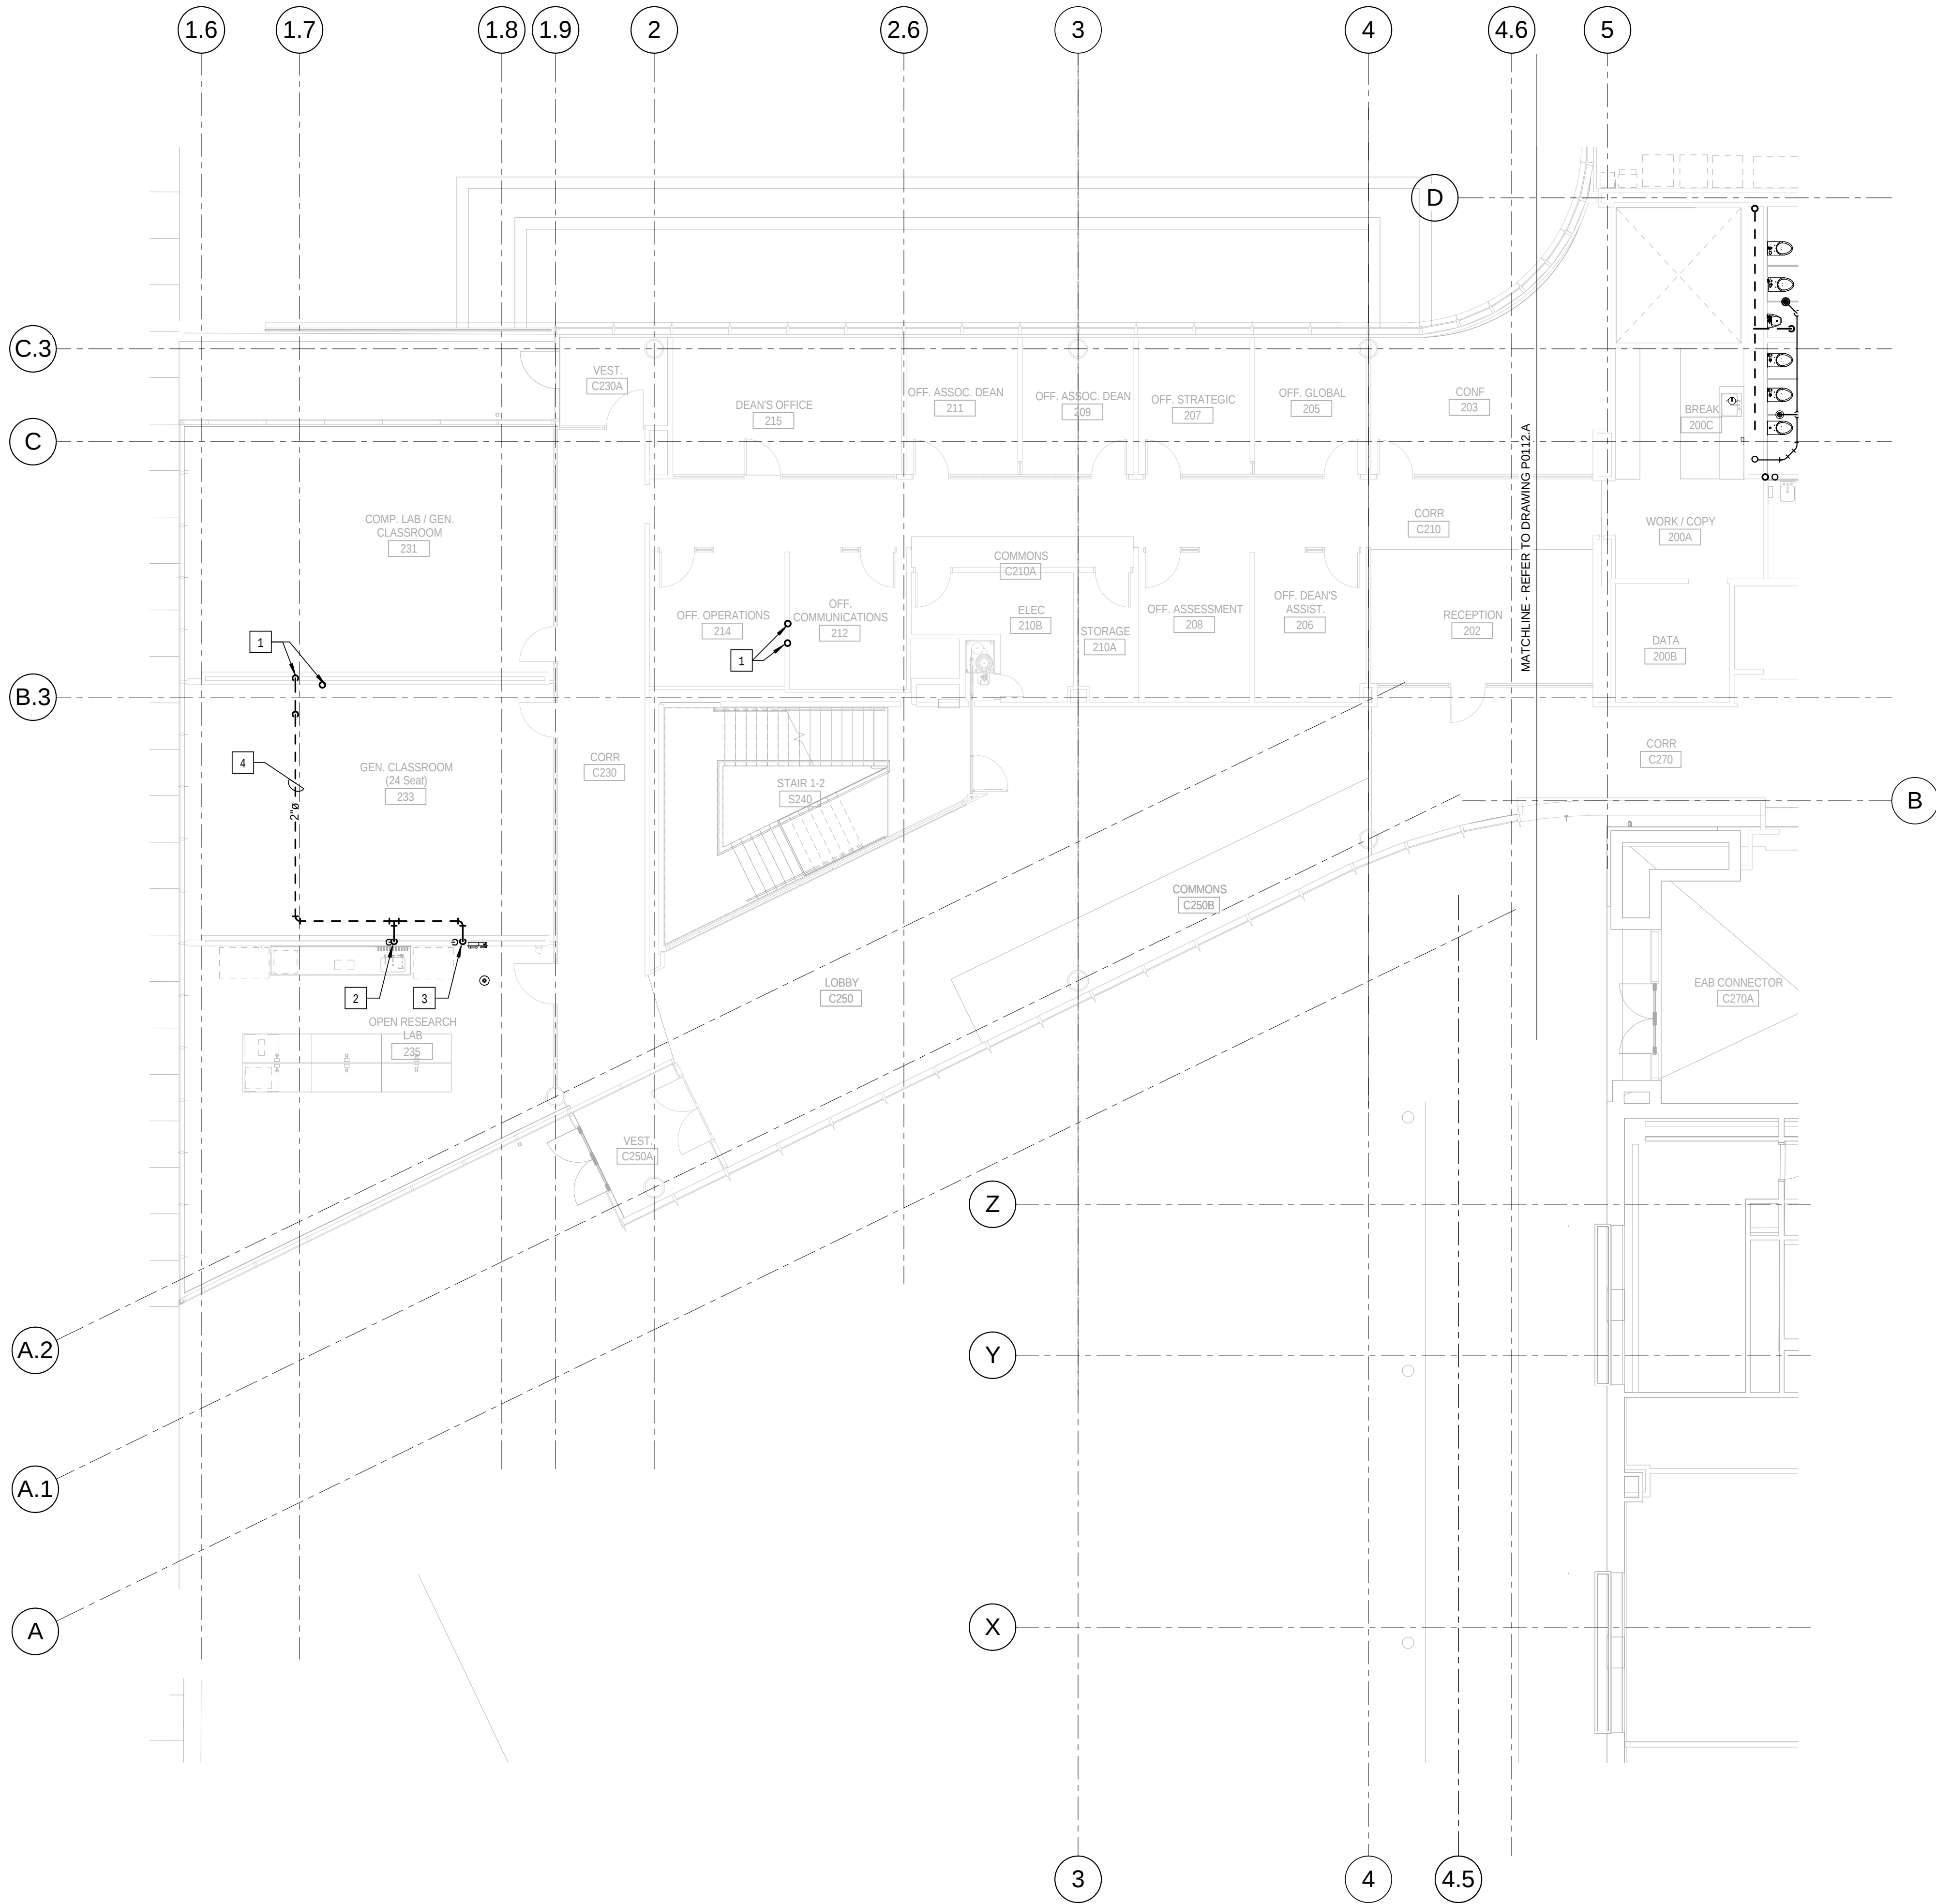

KEYED NOTES: (THIS SHEET ONLY)

- 1 2" SANITARY VENT UP FROM LEVEL 1, TO CONTINUE LEVEL 3, ALIGN WITH WALLS ABOVE. REFER TO DRAWING P0113.B.
- 2 2" SANITARY VENT DOWN IN WALL TO SERVE LAB SINK.
- 3 2" SANITARY VENT DOWN IN WALL TO SERVE EMERGENCY SHOWER.
- 4 PIPING IN EACH ROOM TO BE RUN AS HIGH AS POSSIBLE TO AVOID CONFLICTS. COORDINATE INSTALLATION AND ROUTING WITH OTHER TRADES PRIOR TO ROUGH-IN.
- 5 NOT USED.

1 LEVEL 02 AREA B FLOOR PLAN - PLUMBING WASTE AND VENT
1/8" = 1'-0"