


KEYED NOTES: (THIS SHEET ONLY)


- 1 3" SANITARY WASTE DOWN AND 3" SANITARY VENT UP
- 2 3" SANITARY VENT UP, 3" VTR.
- 3 4" SANITARY VENT RISER, EXTEND FULL SIZE THROUGH THE ROOF.
- 4 4" SANITARY WASTE DOWN, 4" SANITARY VENT UP, EXTEND IN CHASE FULL SIZE TO VENT STACK. REFER TO DRAWING P0401 FOR RISER DIAGRAMS.
- 5 2" SANITARY WASTE DOWN, 2" SANITARY VENT UP, EXTEND IN CHASE FULL SIZE TO VENT STACK. REFER TO DRAWING P0401 FOR RISER DIAGRAMS.
- 6 2" SANITARY VENT UP TO ABOVE THE CEILING, EXTEND AS SHOWN.
- 7 NOT USED.
- 8 2" SANITARY VENT DOWN IN WALL TO SERVE EMERGENCY SHOWER.
- 9 NOT USED.
- 10 3" SANITARY WASTE DOWN, 2" SANITARY VENT UP. REFER TO DRAWING P0401 FOR WASTE AND VENT RISER.
- 11 FLOOR SINK TO BE LOCATED BELOW THE CASEWORK TO ACCEPT DISCHARGE FROM LAB EQUIPMENT. COORDINATE LOCATION WITH CASEWORK.
- 12 2" SANITARY VENT UP IN WALL.
- 13 2" SANITARY VENT UP FROM LEVEL 3. REFER TO DRAWING P113.A FOR OFF-SET AT LEVEL 3.
- 14 2" SANITARY WASTE DOWN, 2" SANITARY VENT UP. REFER TO DRAWING P0401 FOR WASTE AND VENT RISER.
- 15 REFER TO DRAWING P0404 SANITARY WASTE AND VENT RISER DIAGRAM 1-3.
- 16 REFER TO DRAWING P0406 SANITARY WASTE AND VENT RISER DIAGRAM 3-3.
- 17 REFER TO DRAWING P0404 SANITARY WASTE AND VENT RISER DIAGRAM 2-4.
- 18 REFER TO DRAWING P0408 SANITARY WASTE AND VENT RISER DIAGRAM 4-3.
- 19 REFER TO DRAWING P0408 SANITARY WASTE AND VENT RISER DIAGRAM 5-3.
- 20 5-GALLON NEUTRALIZATION TANK WITH SLIP-ON COVER, LOCATED BELOW THE COUNTERTOP. REFER TO DRAWING P0404, DETAILS 1 AND 2 FOR PIPING DIAGRAM INSTALLATION.
- 21 2" ACID VENT DOWN IN WALL TO SERVE NEUTRALIZATION TANK.
- 22 2" ACID VENT RISER.
- 23 2" ACID VENT UP, 3" AVTR.

24 WASTE PIPING ON IN-LET SIDE OF NEUTRALIZATION TANK TO BE MODIFIED TO ACCEPT 3/4" CONDENSATE DRAIN BY MECHANICAL CONTRACTOR. COORDINATE REQUIREMENTS WITH MECHANICAL CONTRACTOR. REFER TO DETAIL 3 ON DRAWING P0404.

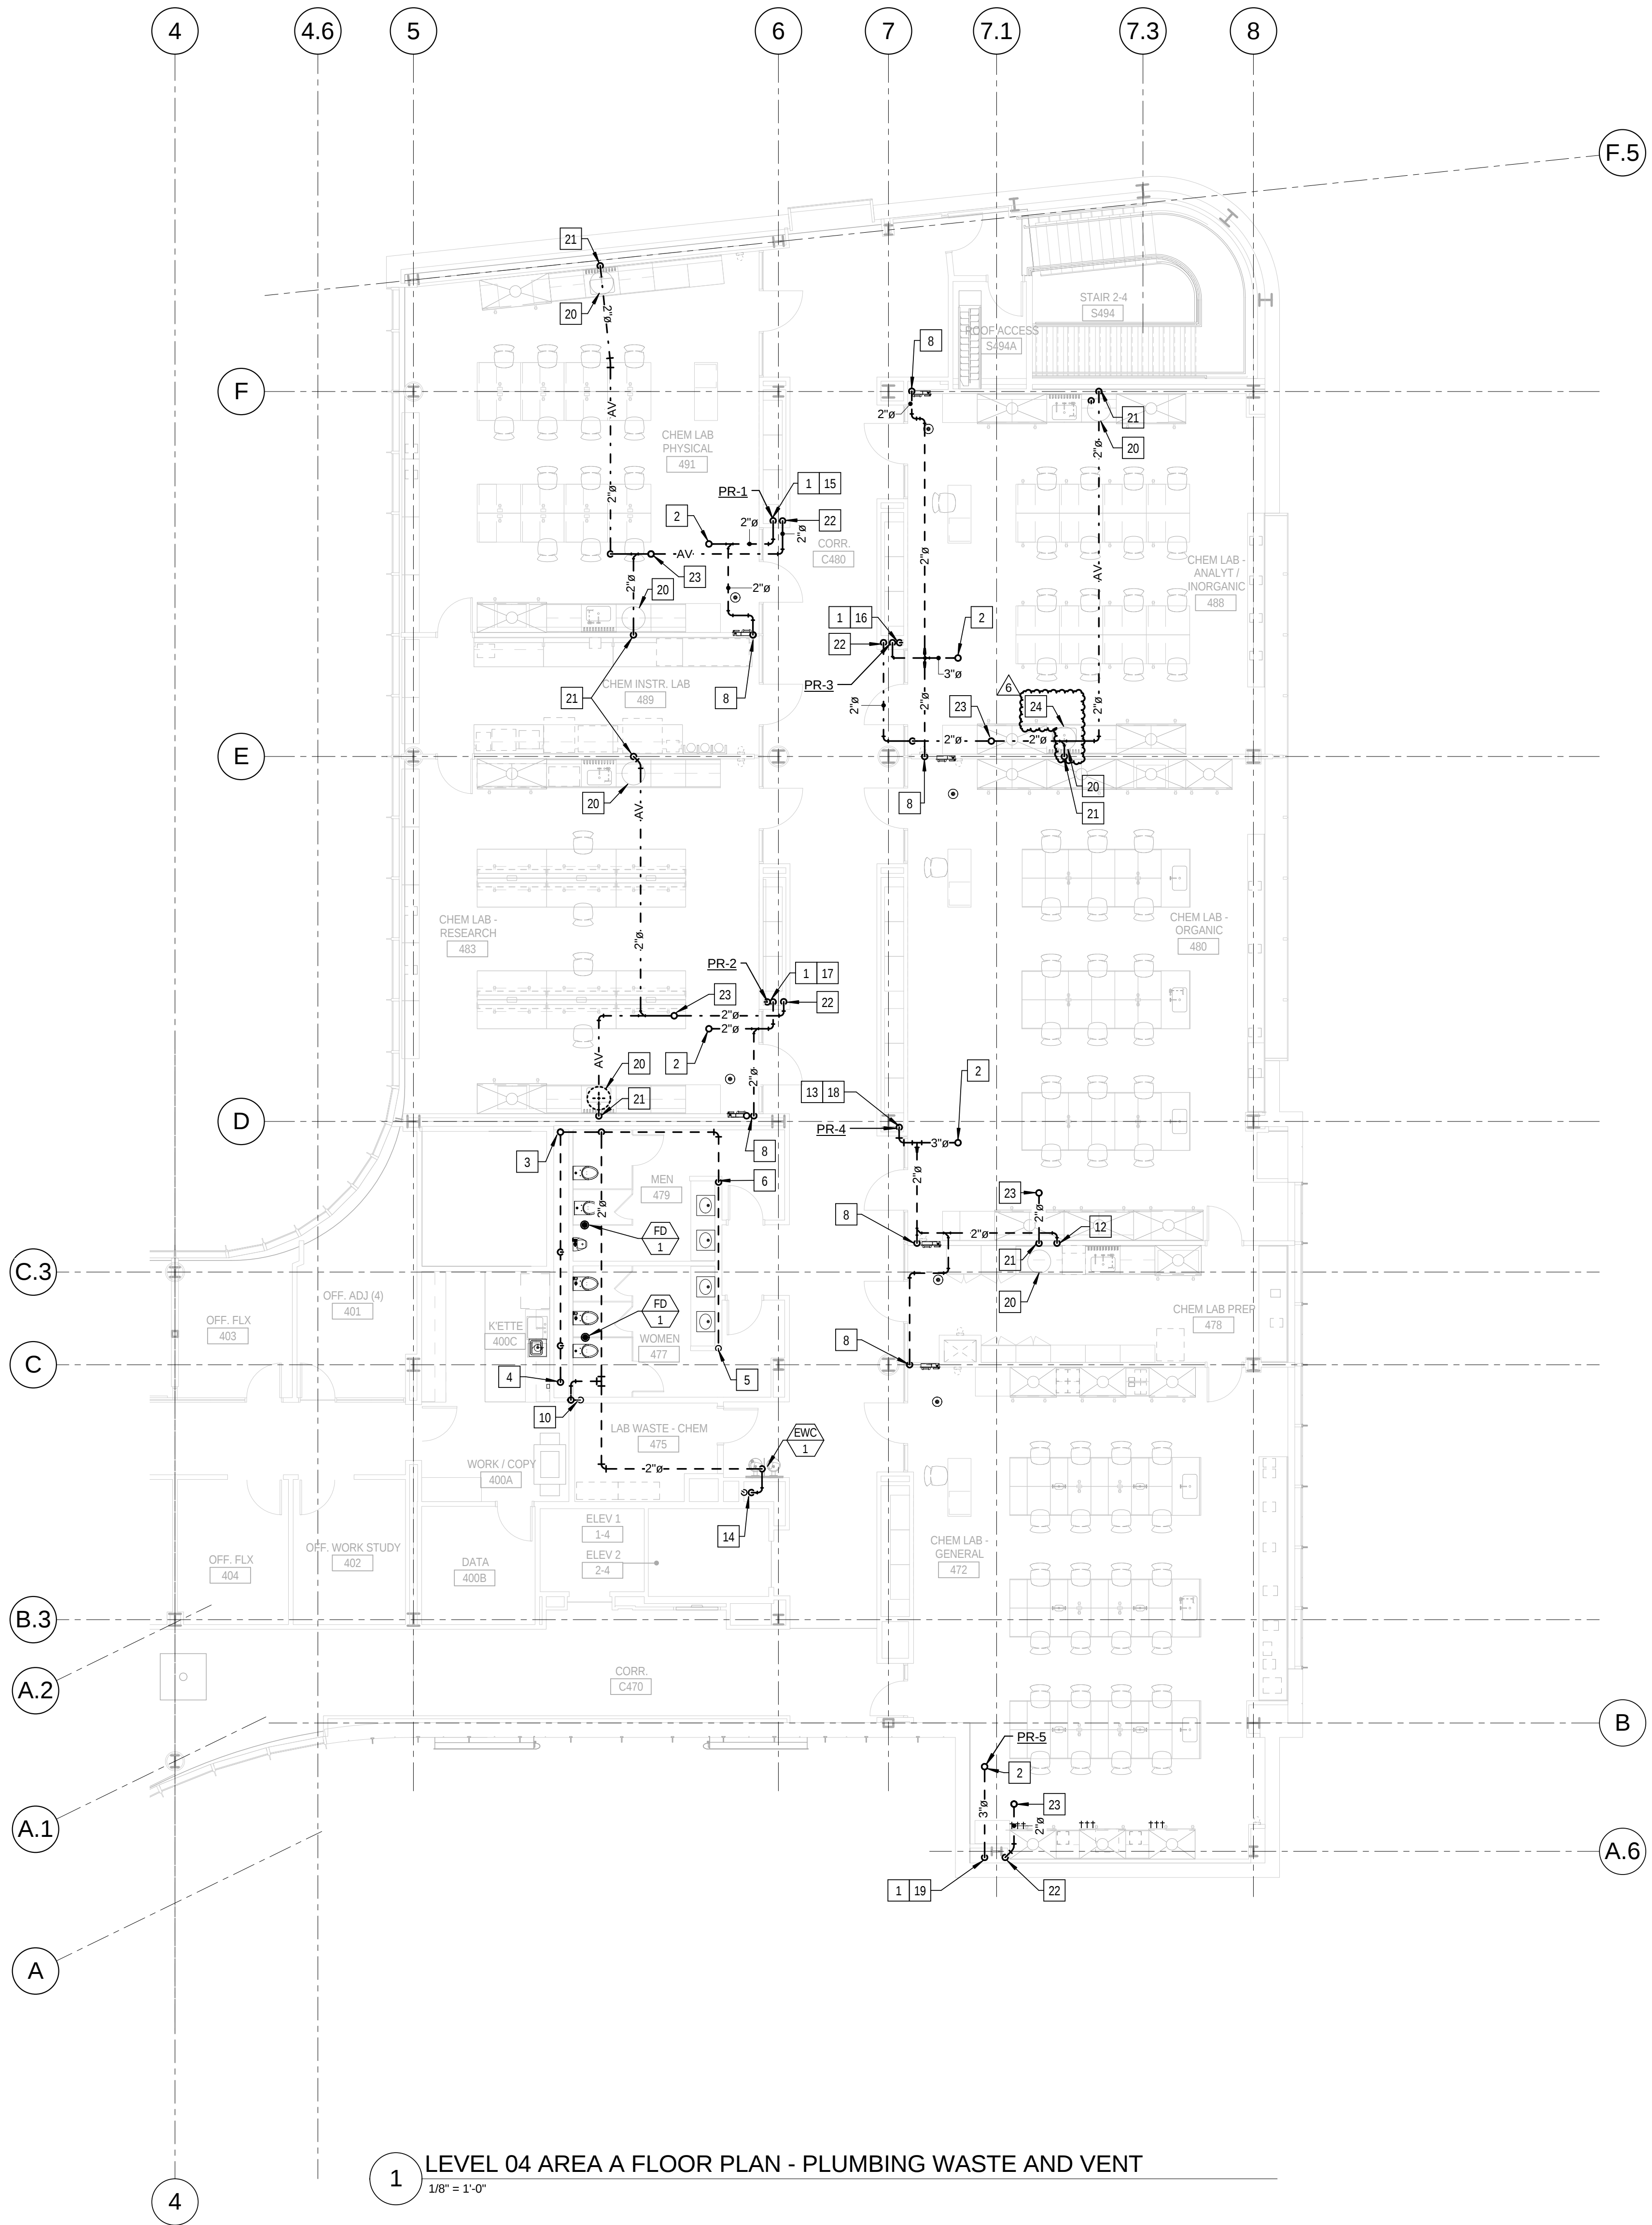

1 LEVEL 04 AREA A FLOOR PLAN - PLUMBING WASTE AND VENT
1/8" = 1'-0"

6	ASI - 051	08 MAR 2017
5	ASI - 025 Neutralization Tanks	09 SEP 2016
4	ASI - 014 (RFI-176)	21 JUL 2016
3	ADDENDUM 2-4	24 MAY 2015
2	ADDENDUM 2-2	19 APR 2016
1	ADDENDUM 2-1	17 MAR 2016
-	ISSUED FOR CONSTRUCTION (BP2)	01 MAR 2016

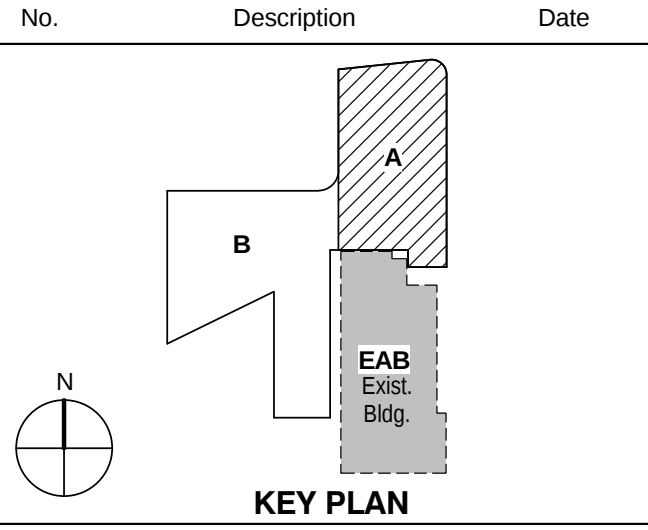

KEY PLAN

LEVEL 04 AREA A FLOOR PLAN - PLUMBING WASTE AND VENT

Project No.: 04561.01 Checked by:

P0114.A