


© Cannon Design 2015
All rights reserved. No part of this document may be reproduced or transmitted in any form without written authorization by The Cannon Corporation.
12/19/2016 9:38:06 AM

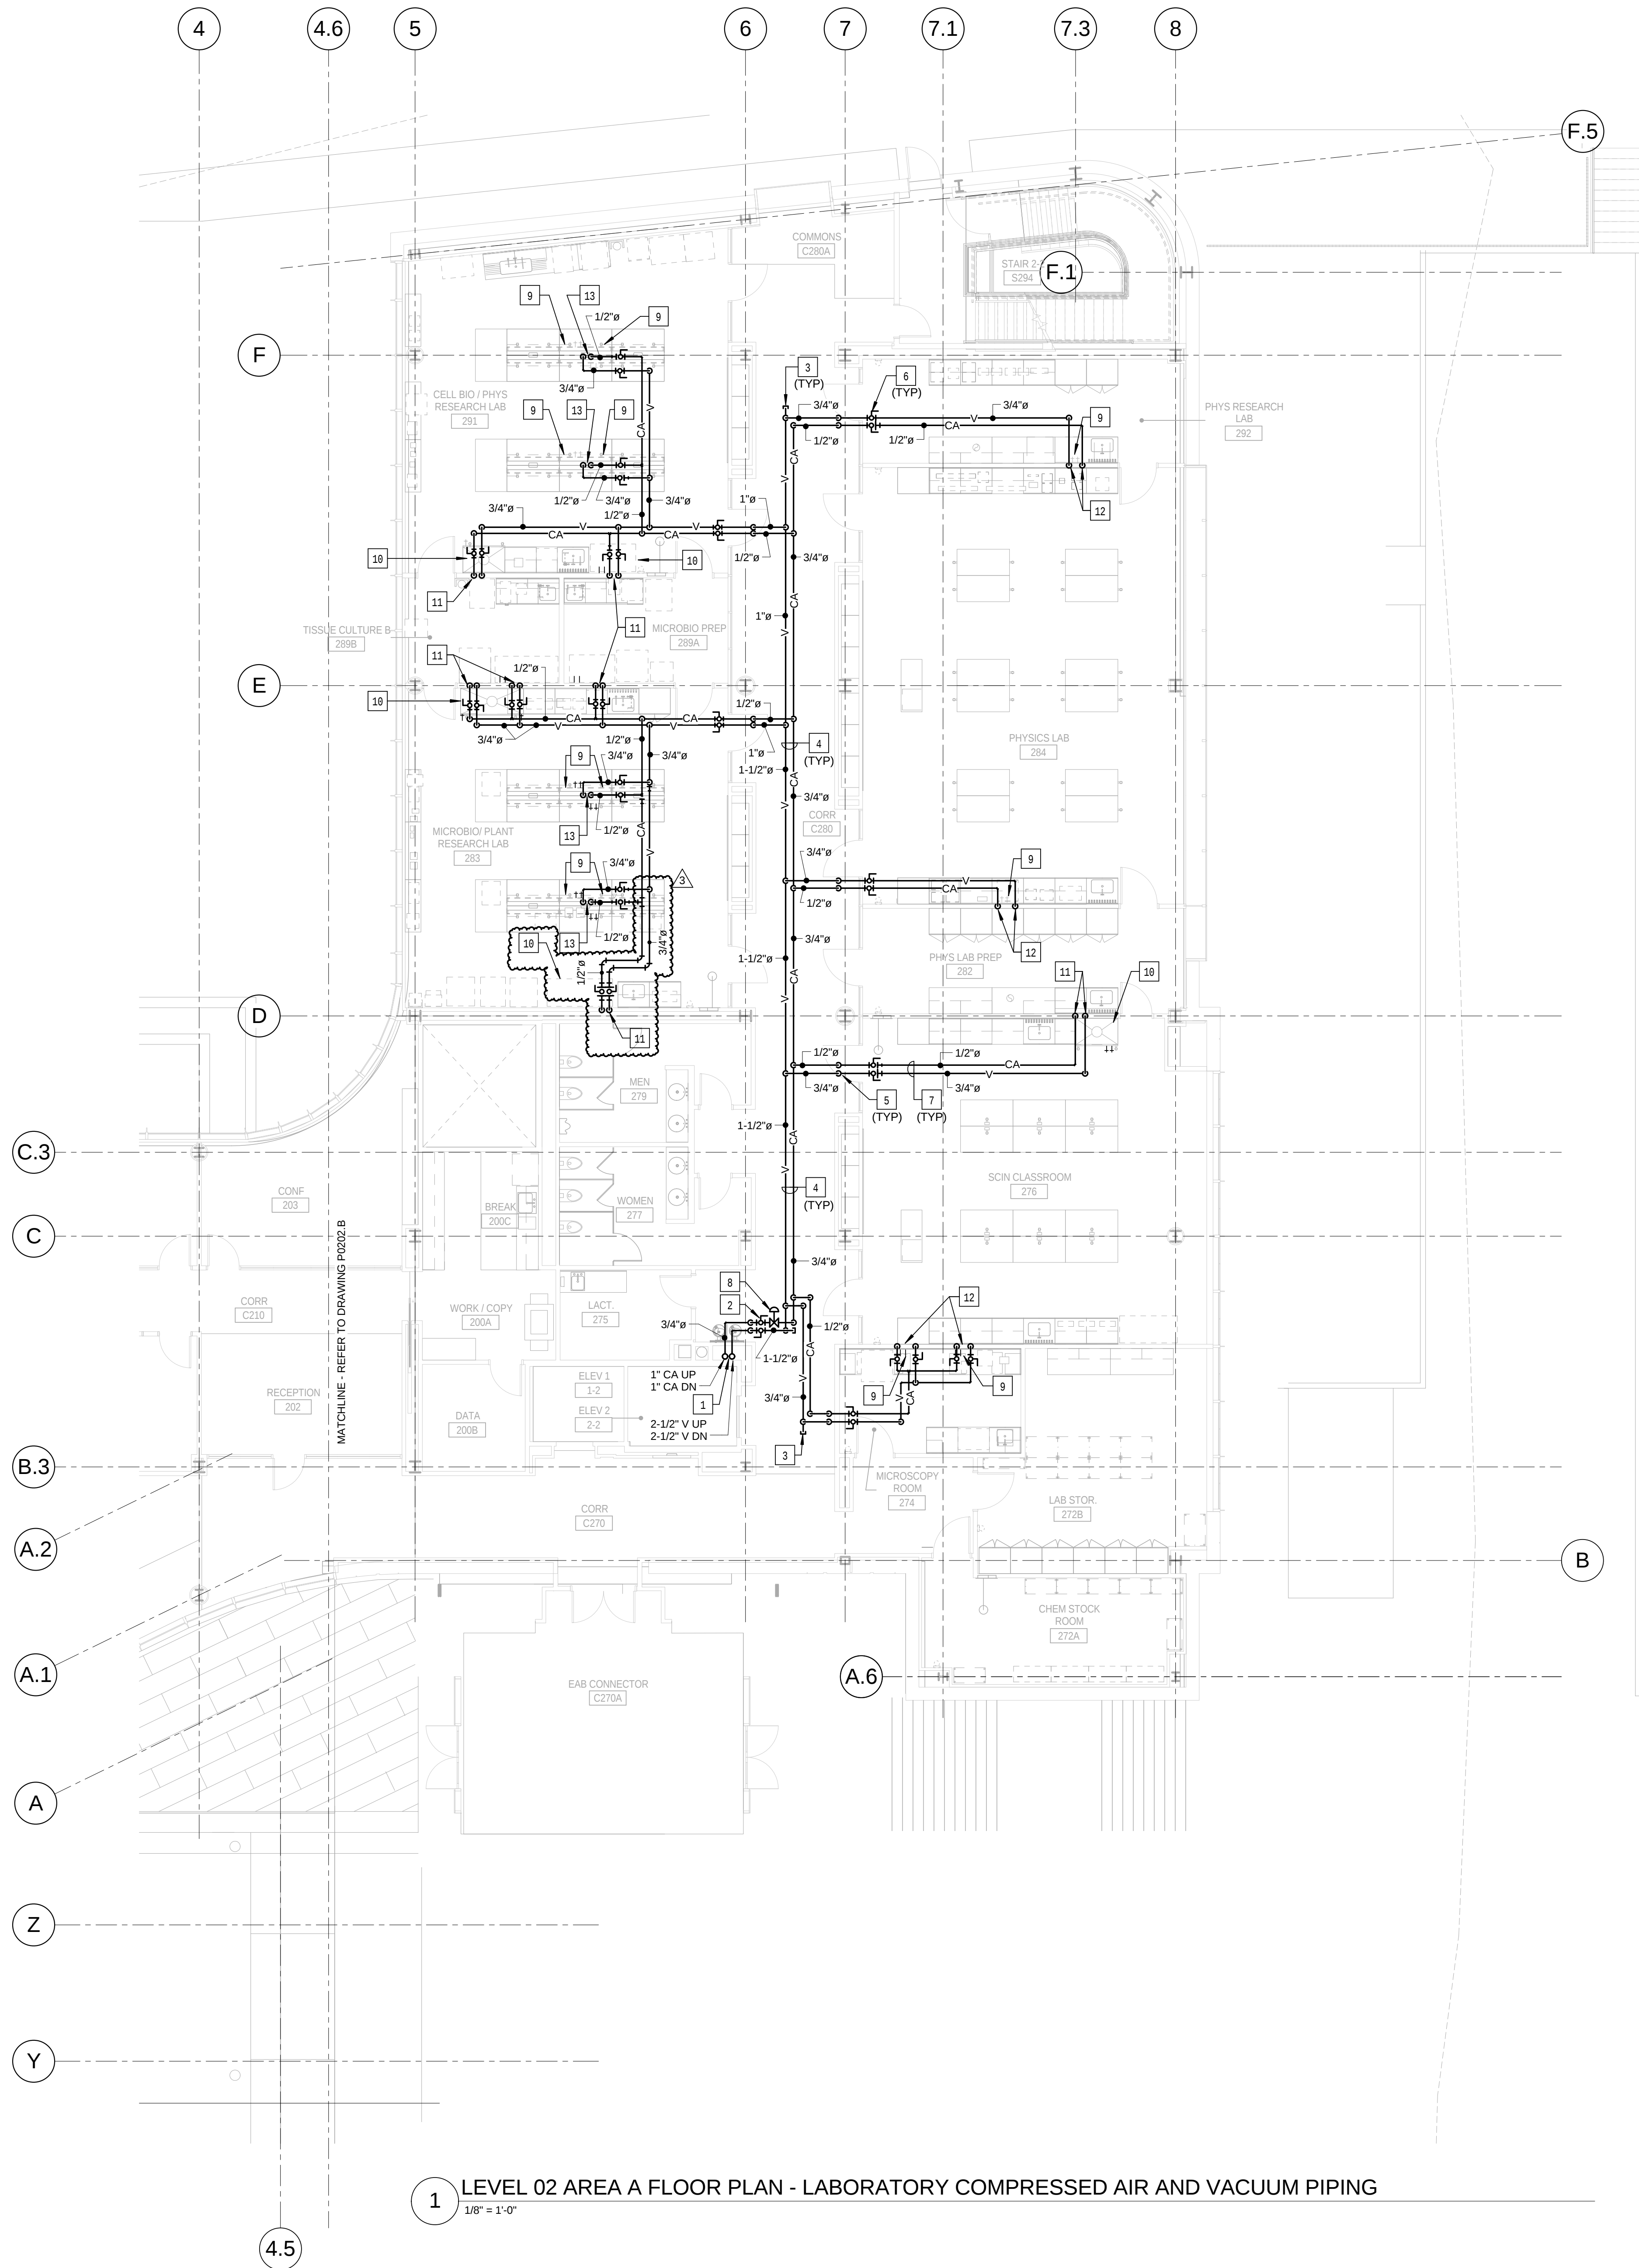

1 LEVEL 02 AREA A FLOOR PLAN - LABORATORY COMPRESSED AIR AND VACUUM PIPING
1/8" = 1'-0"

KEYED NOTES: (THIS SHEET ONLY)

- 1 BUILDING SERVICE RISERS FOR LABORATORY COMPRESSED AIR AND VACUUM. COORDINATE INSTALLATION WITH BUILDING STRUCTURE AND OTHER SERVICES WITHIN CHASE.
- 2 PROVIDE FLOOR ISOLATION VALVES AT EACH FLOOR LEVEL. LOCATE VALVES IN ACCESSIBLE CEILING OR PROVIDE ACCESS PANEL AS REQUIRED.
- 3 PROVIDE CLEANOUTS PLUG IN PIPING.
- 4 PIPING IN CORRIDOR TO BE RUN AT BOTTOM OF STRUCTURAL STEEL CROSS MEMBERS. COORDINATE INSTALLATION AND ROUTING WITH OTHER TRADES PRIOR TO ROUGH-IN.
- 5 DROP PIPING DOWN TO BELOW STRUCTURAL STEEL MEMBER. HOLD TIGHT TO BOTTOM OF STEEL.
- 6 PROVIDE SHUT-OFF VALVES AT THE ENTRY TO EACH ROOM.
- 7 PIPING IN EACH ROOM TO BE RUN AS HIGH AS POSSIBLE TO AVOID CONFLICTS. COORDINATE INSTALLATION AND ROUTING WITH OTHER TRADES PRIOR TO ROUGH-IN.
- 8 INSTALL SINGLE STAGE IN-LINE AIR PRESSURE REGULATOR, BEACONMEDAES MODEL 6-122102-01, .75 INCH INLET AND OUTLET, ADJUSTABLE FROM 40 to 110 PSIG DELIVERY RANGE, PROVIDE WITH MODEL 9-130116-00, 0 TO 300 PRESSURE GAUGE. MOUNT ABOVE THE CEILING IN AN ACCESSIBLE LOCATION. POSITION FOR FULL ACCESS TO THE ADJUSTMENT NUT AND GAUGE. SET TO 50 PSIG.
- 9 LABORATORY COMPRESSED AIR OUTLET AND VACUUM INLET SERVICE FITTING.
- 10 LABORATORY FUME HOOD OR BIO SAFETY CABINET. REFER TO THE ARCHITECTURAL DRAWINGS FOR THE TYPE.
- 11 EXTEND 1/2" COMPRESSED AIR AND 3/4" VACUUM DOWN WITHIN WALL TO SERVE LABORATORY FUME HOOD OR BIO SAFETY CABINET SERVICE FITTINGS. VERIFY CONNECTION LOCATIONS AND REQUIREMENTS WITH EQUIPMENT MANUFACTURER. PROVIDE ALL NECESSARY FITTINGS AND MAKE FINAL CONNECTIONS TO FITTINGS AS REQUIRED. PIPING TO BE CONCEALED AS MUCH AS POSSIBLE BEHIND THE EQUIPMENT OR BELOW THE COUNTERTOPS.
- 12 EXTEND 1/2" COMPRESSED AIR AND 3/4" VACUUM DOWN WITHIN WALL TO SERVE LABORATORY SERVICE FITTINGS. REFER TO THE ARCHITECTURAL DRAWINGS FOR EXACT LOCATION AND TYPE. PROVIDE ALL NECESSARY FITTINGS AND MAKE FINAL CONNECTIONS TO FITTINGS AS REQUIRED.
- 13 EXTEND 1/2" COMPRESSED AIR AND 3/4" VACUUM DOWN INTO LABORATORY BENCH CASEWORK SERVICE CARRIER. ROUTE PIPING DOWN TO CASEWORK UTILITY CHASE AND CONNECT TO BENCH-TOP LABORATORY SERVICE FITTINGS. REFER TO THE ARCHITECTURAL PLAN FOR THE ENTRY POINT OF THE OVERHEAD SERVICE CARRIER AND SERVICE FITTINGS. PROVIDE ALL NECESSARY FITTINGS AND MAKE FINAL CONNECTIONS. COORDINATE INSTALL AND ROUTING OF PIPING WITH OTHER TRADES UTILIZING THE UTILITY CHASE.

1100 Clark Avenue
St. Louis, Missouri 63102
T: 314.241.6250
F: 314.241.2570

William Tao & Associates, Inc.
MEP/FP Engineer
7955 Manchester Road, Suite 125
St. Louis, MO 63143
314-884-7600

David Mason & Associates, Inc.
Structural & Civil Engineer
800 South Vandeventer Avenue
St. Louis, MO 63110
314.534.1053

Faith Group
Technology
3101 S. Hanley Rd. Suite 100
St. Louis, MO 63143
314.991.2229

Kuhnmann Leavitt, Inc.
Environmental Graphics & Signage
7400 Pershing Ave.
St. Louis, MO 63130
314.725.6616


KWA Architects
Architecture
9721 Litzinger Road
St. Louis, MO 63124
314.962.2560

Spellman Brady & Company
Interior Designer
8251 Maryland Avenue, Suite 300
St. Louis, MO 63105
314.862.0070

SWT Design
Landscape Architect
7722 Big Bend Blvd
St. Louis, MO 63119
314.644.5700

Webb Engineering Services, Inc.
Planning & Fire Protection
1400 S. 3rd Street, Suite 201
St. Louis, MO 63104
314.588.0600

3	ASI - 042	19 DEC 2016
2	ADDENDUM 2-4	24 MAY 2016
1	ADDENDUM 2-1	17 MAR 2016
-	ISSUED FOR CONSTRUCTION (BP2)	01 MAR 2016

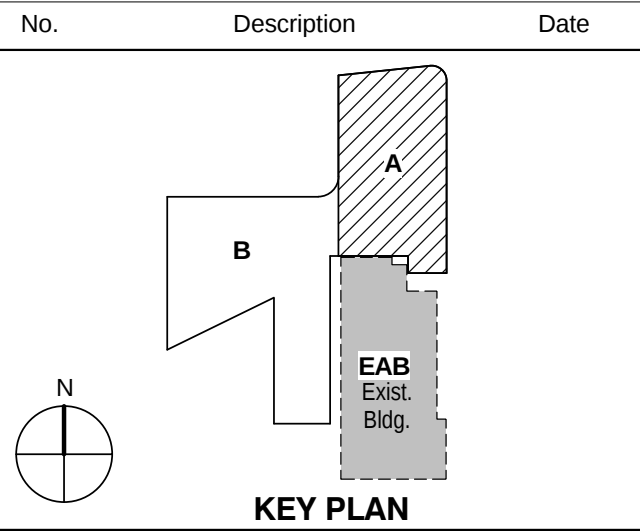

Drawing Title:

**LEVEL 02 AREA A FLOOR
PLAN - LABORATORY
COMPRESSED AIR AND
VACUUM PIPING**

Project No.: 04561.01 Checked by:

P0202.A