



KEYED NOTES: (THIS SHEET ONLY)

- BUILDING SERVICE RISERS FOR LABORATORY COMPRESSED AIR AND VACUUM. COORDINATE INSTALLATION WITH BUILDING STRUCTURE AND OTHER SERVICES WITHIN CHASE.
- PROVIDE FLOOR ISOLATION VALVES AT EACH FLOOR LEVEL. LOCATE VALVES IN ACCESSIBLE CEILING OR PROVIDE ACCESS PANEL AS REQUIRED.
- PROVIDE CLEANOUT PLUG IN PIPING.
- PIPING IN CORRIDOR TO BE RUN AT BOTTOM OF STRUCTURAL STEEL CROSS MEMBERS. COORDINATE INSTALLATION AND ROUTING WITH OTHER TRADES PRIOR TO ROUGH-IN.
- DROP PIPING DOWN TO BELOW STRUCTURAL STEEL MEMBER. HOLD TIGHT TO BOTTOM OF STEEL.
- PROVIDE SHUT-OFF VALVES AT THE ENTRY TO EACH ROOM.
- PIPING IN EACH ROOM TO BE RUN AS HIGH AS POSSIBLE TO AVOID CONFLICTS. COORDINATE INSTALLATION AND ROUTING WITH OTHER TRADES PRIOR TO ROUGH-IN.
- INSTALL SINGLE STAGE IN-LINE AIR PRESSURE REGULATOR, BEACONMEDAES MODEL 6-J22102-01', .75 INCH INLET AND OUTLET, ADJUSTABLE FROM 40 TO 110 PSIG DELIVERY RANGE, PROVIDE WITH MODEL 6-J30116-00', 0 TO 300 PRESSURE GAUGE. MOUNT ABOVE THE CEILING IN AN ACCESSIBLE LOCATION. POSITION FOR FULL ACCESS TO THE ADJUSTMENT NUT AND GAUGE. SET TO 50 PSIG.
- LABORATORY COMPRESSED AIR OUTLET AND VACUUM INLET SERVICE FITTING.
- LABORATORY FUME HOOD OR BIO SAFETY CABINET. REFER TO THE ARCHITECTURAL DRAWINGS FOR THE TYPE.
- EXTEND 1/2" COMPRESSED AIR AND 3/4" VACUUM DOWN WITHIN WALL TO SERVE LABORATORY FUME HOOD OR BIO SAFETY CABINET SERVICE FITTINGS. VERIFY CONNECTION LOCATIONS AND REQUIREMENTS WITH EQUIPMENT MANUFACTURER. PROVIDE ALL NECESSARY FITTINGS AND MAKE FINAL CONNECTIONS TO FITTINGS AS REQUIRED. PIPING TO BE CONCEALED AS MUCH AS POSSIBLE BEHIND THE EQUIPMENT OR BELOW THE COUNTERTOPS.
- PROVIDE EQUIPMENT ISOLATION VALVES IN AN ACCESSIBLE LOCATION ABOVE THE CEILING.
- EXTEND 1/2" COMPRESSED AIR AND 3/4" VACUUM DOWN WITHIN WALL TO SERVE LABORATORY SERVICE FITTINGS. REFER TO THE ARCHITECTURAL DRAWINGS FOR EXACT LOCATION AND TYPE. PROVIDE ALL NECESSARY FITTINGS AND MAKE FINAL CONNECTIONS.

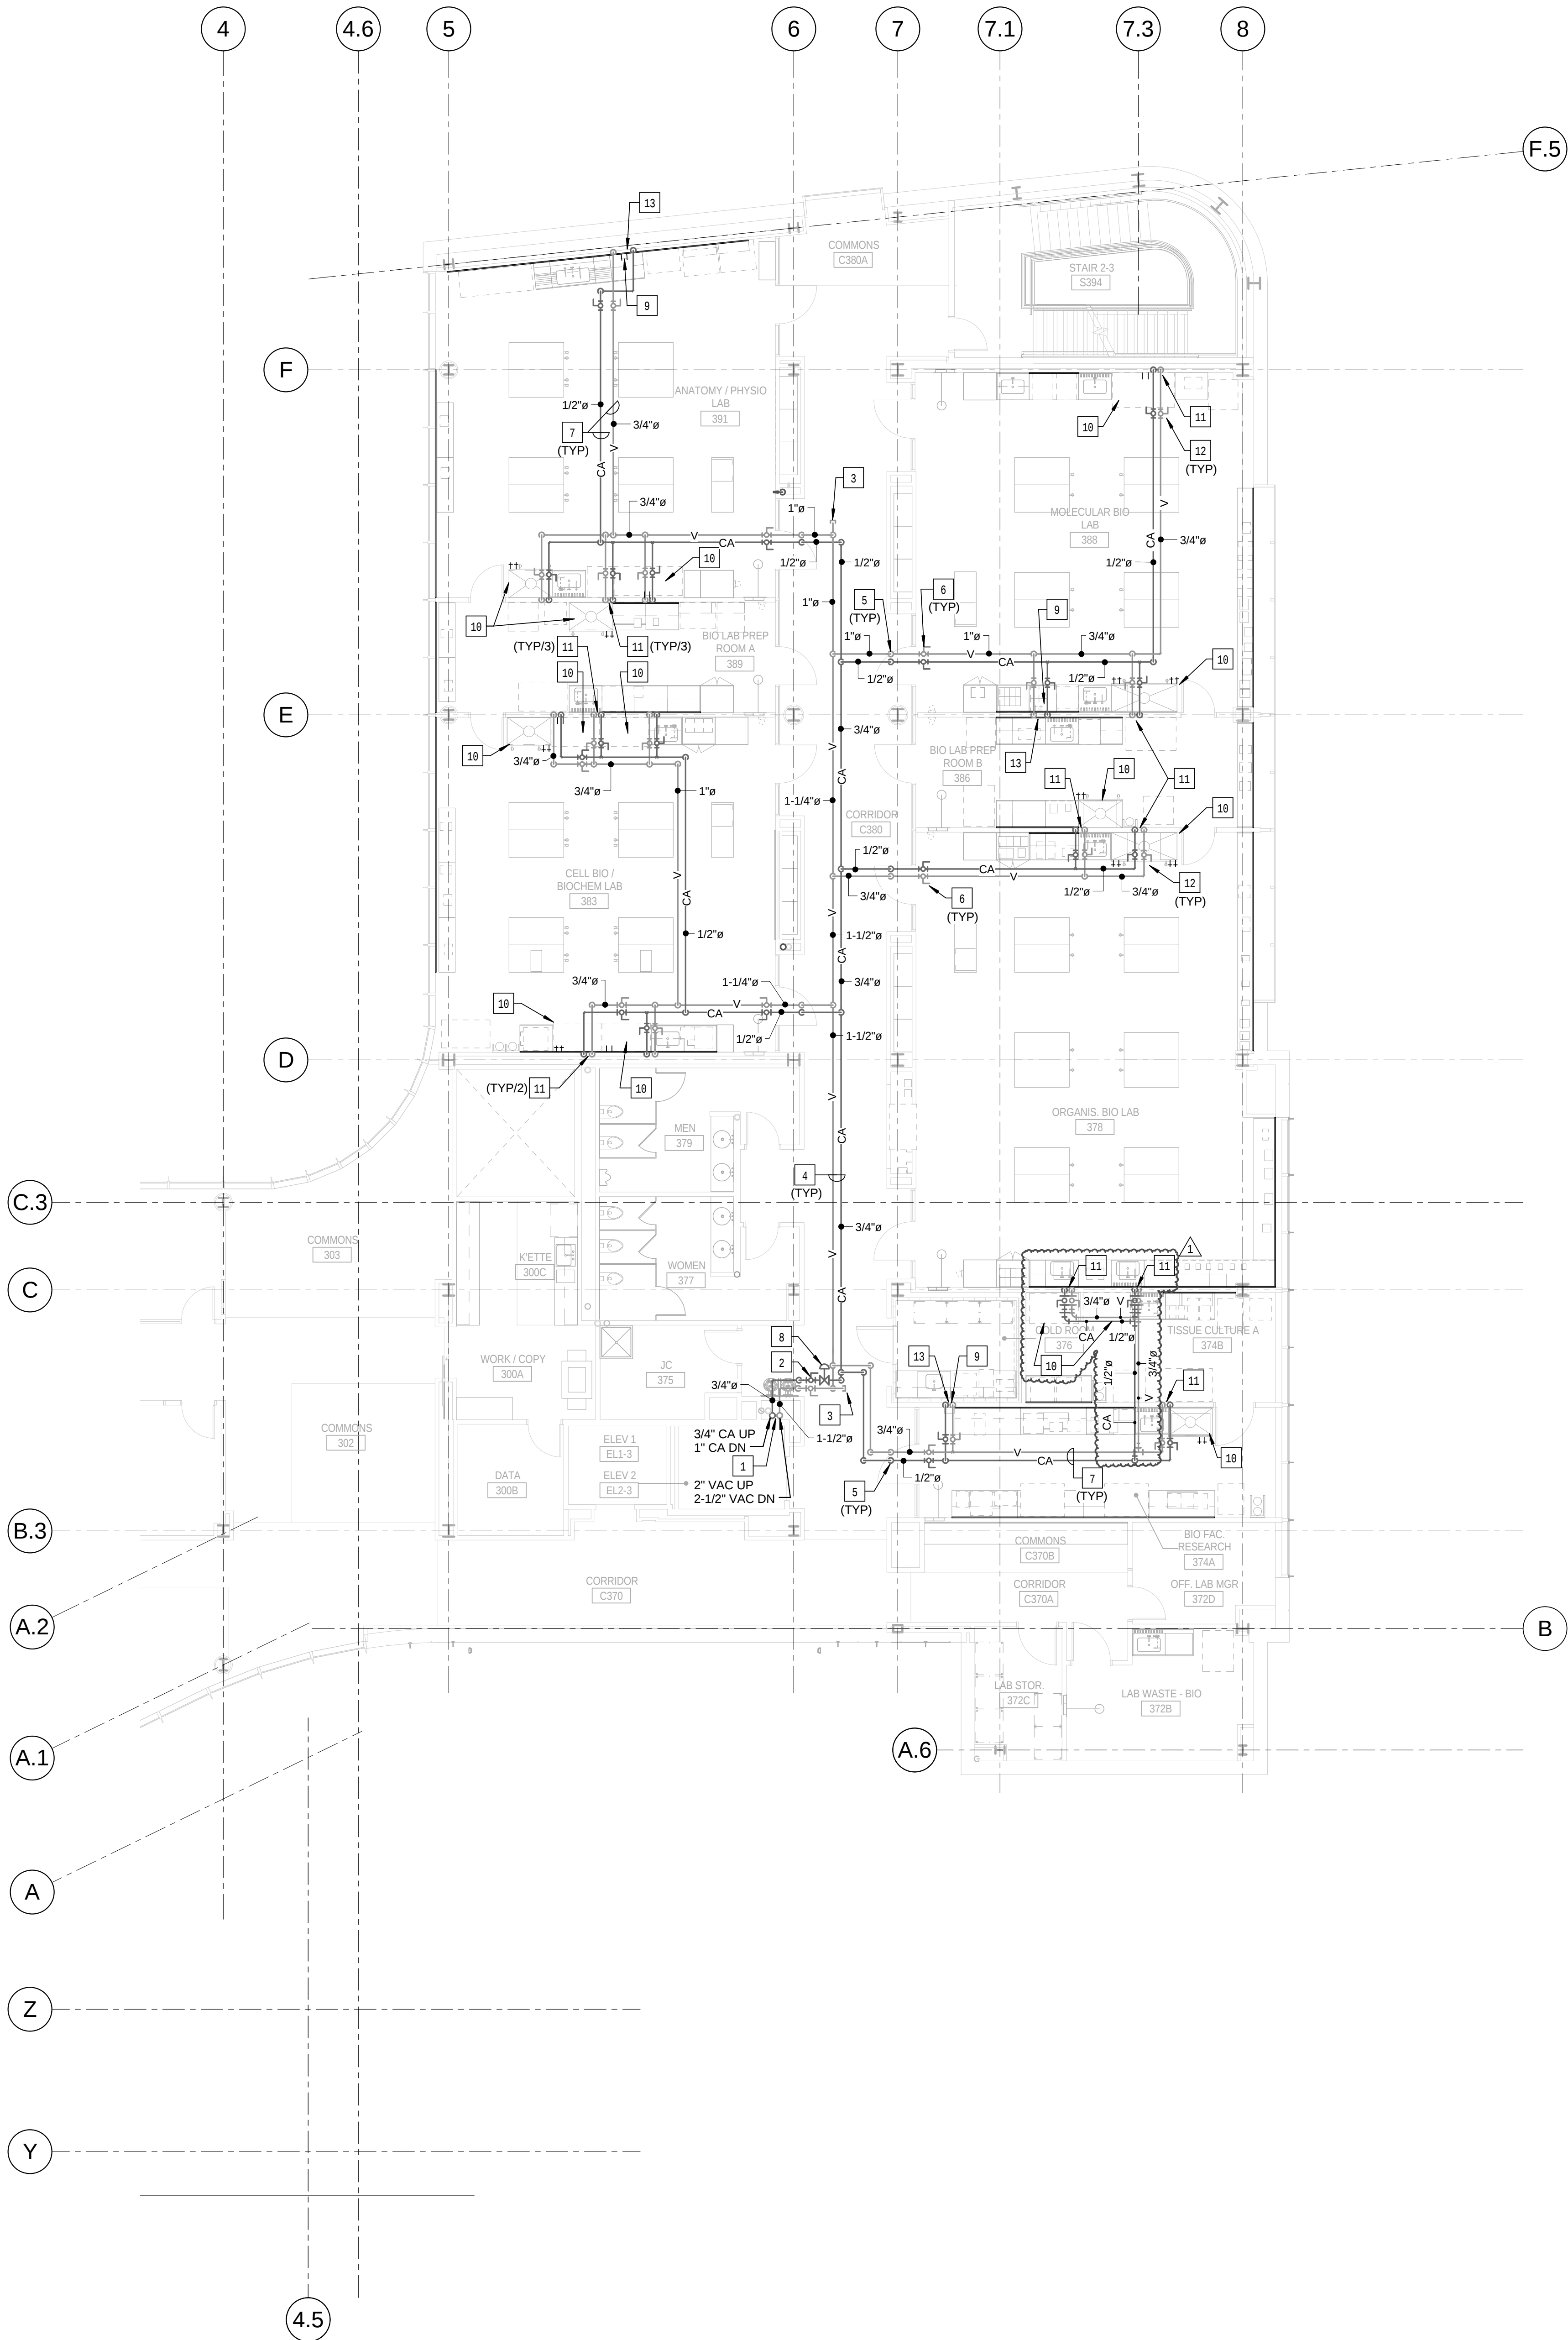

1 LEVEL 03 AREA A FLOOR PLAN - LABORATORY COMPRESSED AIR AND VACUUM PIPING
1/8" = 1'-0"

1	ASI - 071	13 JUN 2017
1	ISSUED FOR CONSTRUCTION (BP2)	01 MAR 2016
No.	Description	Date

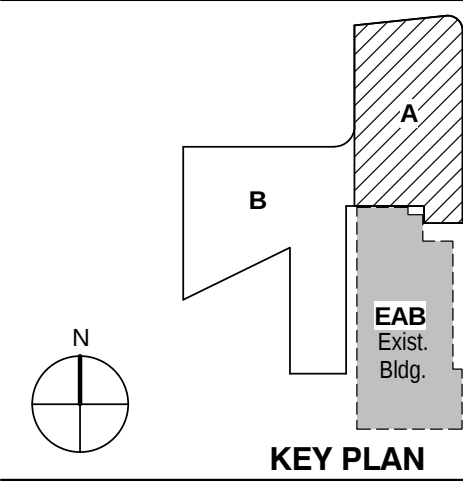

KEY PLAN

LEVEL 03 AREA A FLOOR
PLAN - LABORATORY
COMPRESSED AIR AND
VACUUM PIPING

Project No.: 04561.01 Checked by:

P0203.A