



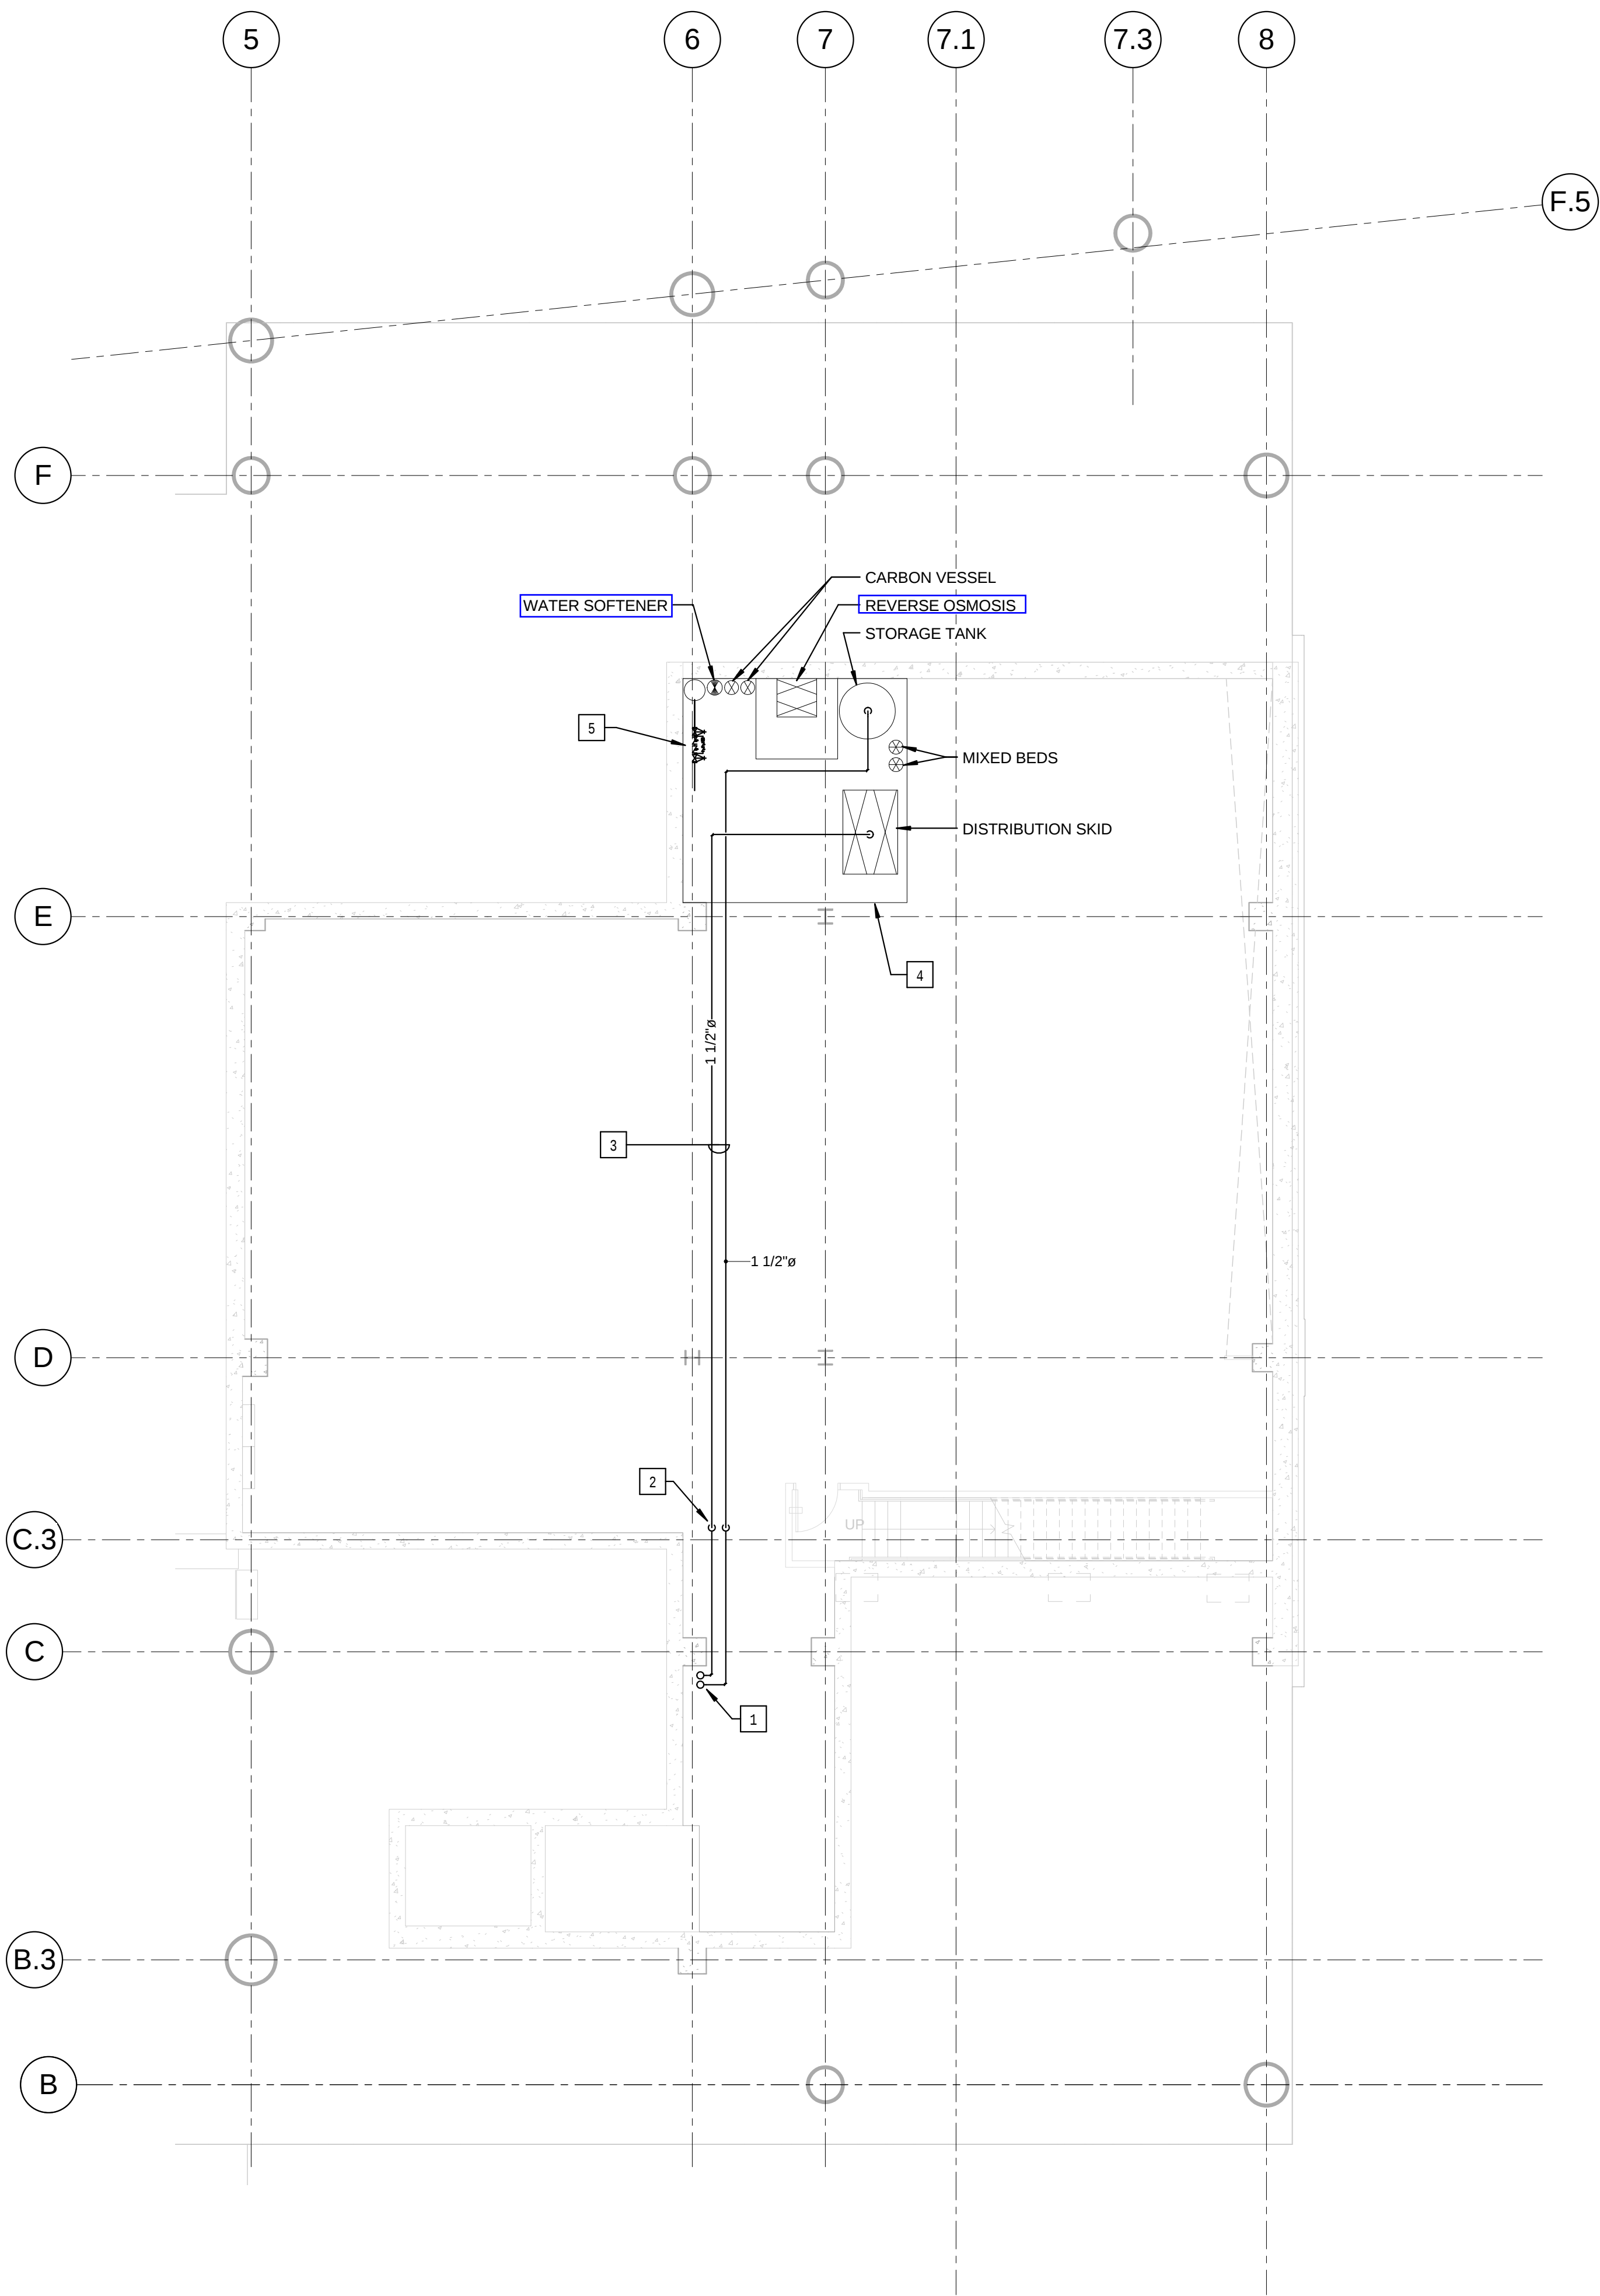

1 LEVEL 0 AREA A FLOOR PLAN - LABORATORY DEIONIZED WATER SYSTEM
1/8" = 1'-0"

- KEYED NOTES: (THIS SHEET ONLY)**
- 1 DEIONIZED WATER RISERS UP TO LEVEL 1. REFER TO DRAWING P0301A FOR CONTINUATION.
 - 2 DROP PIPING TO BOTTOM OF STRUCTURAL MEMBER. HOLD PIPING TIGHT TO BOTTOM OF STEEL.
 - 3 RUN PIPING AT BOTTOM OF STRUCTURAL STEEL CROSS MEMBERS. COORDINATE INSTALLATION AND ROUTING WITH OTHER TRADES.
 - 4 DEIONIZED WATER SYSTEM. REFER TO DRAWING P0503, DETAIL 3/P0503 FOR REFERENCE PIPING DIAGRAM. ACTUAL PIPING LAYOUT AND CONFIGURATION MAY VARY WITH DIFFERENT MANUFACTURERS. CONTRACTOR TO COORDINATE INSTALLATION WITH FINAL EQUIPMENT SELECTION.
 - 5 BACKFLOW PREVENTER (BFP-3) SHOWN FOR REFERENCE. REFER TO DRAWING P011.

ISSUED FOR CONSTRUCTION (BP2)		01 MAR 2016
No.	Description	Date

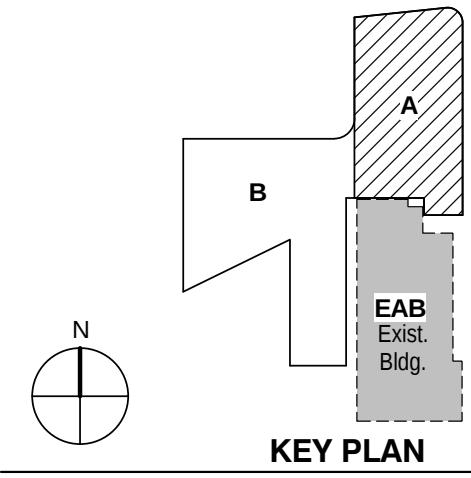

KEY PLAN

LEVEL 0 AREA A FLOOR
PLAN - LABORATORY
DEIONIZED WATER
SYSTEM

Project No.: 04561.01 Checked by:

P0300.A