




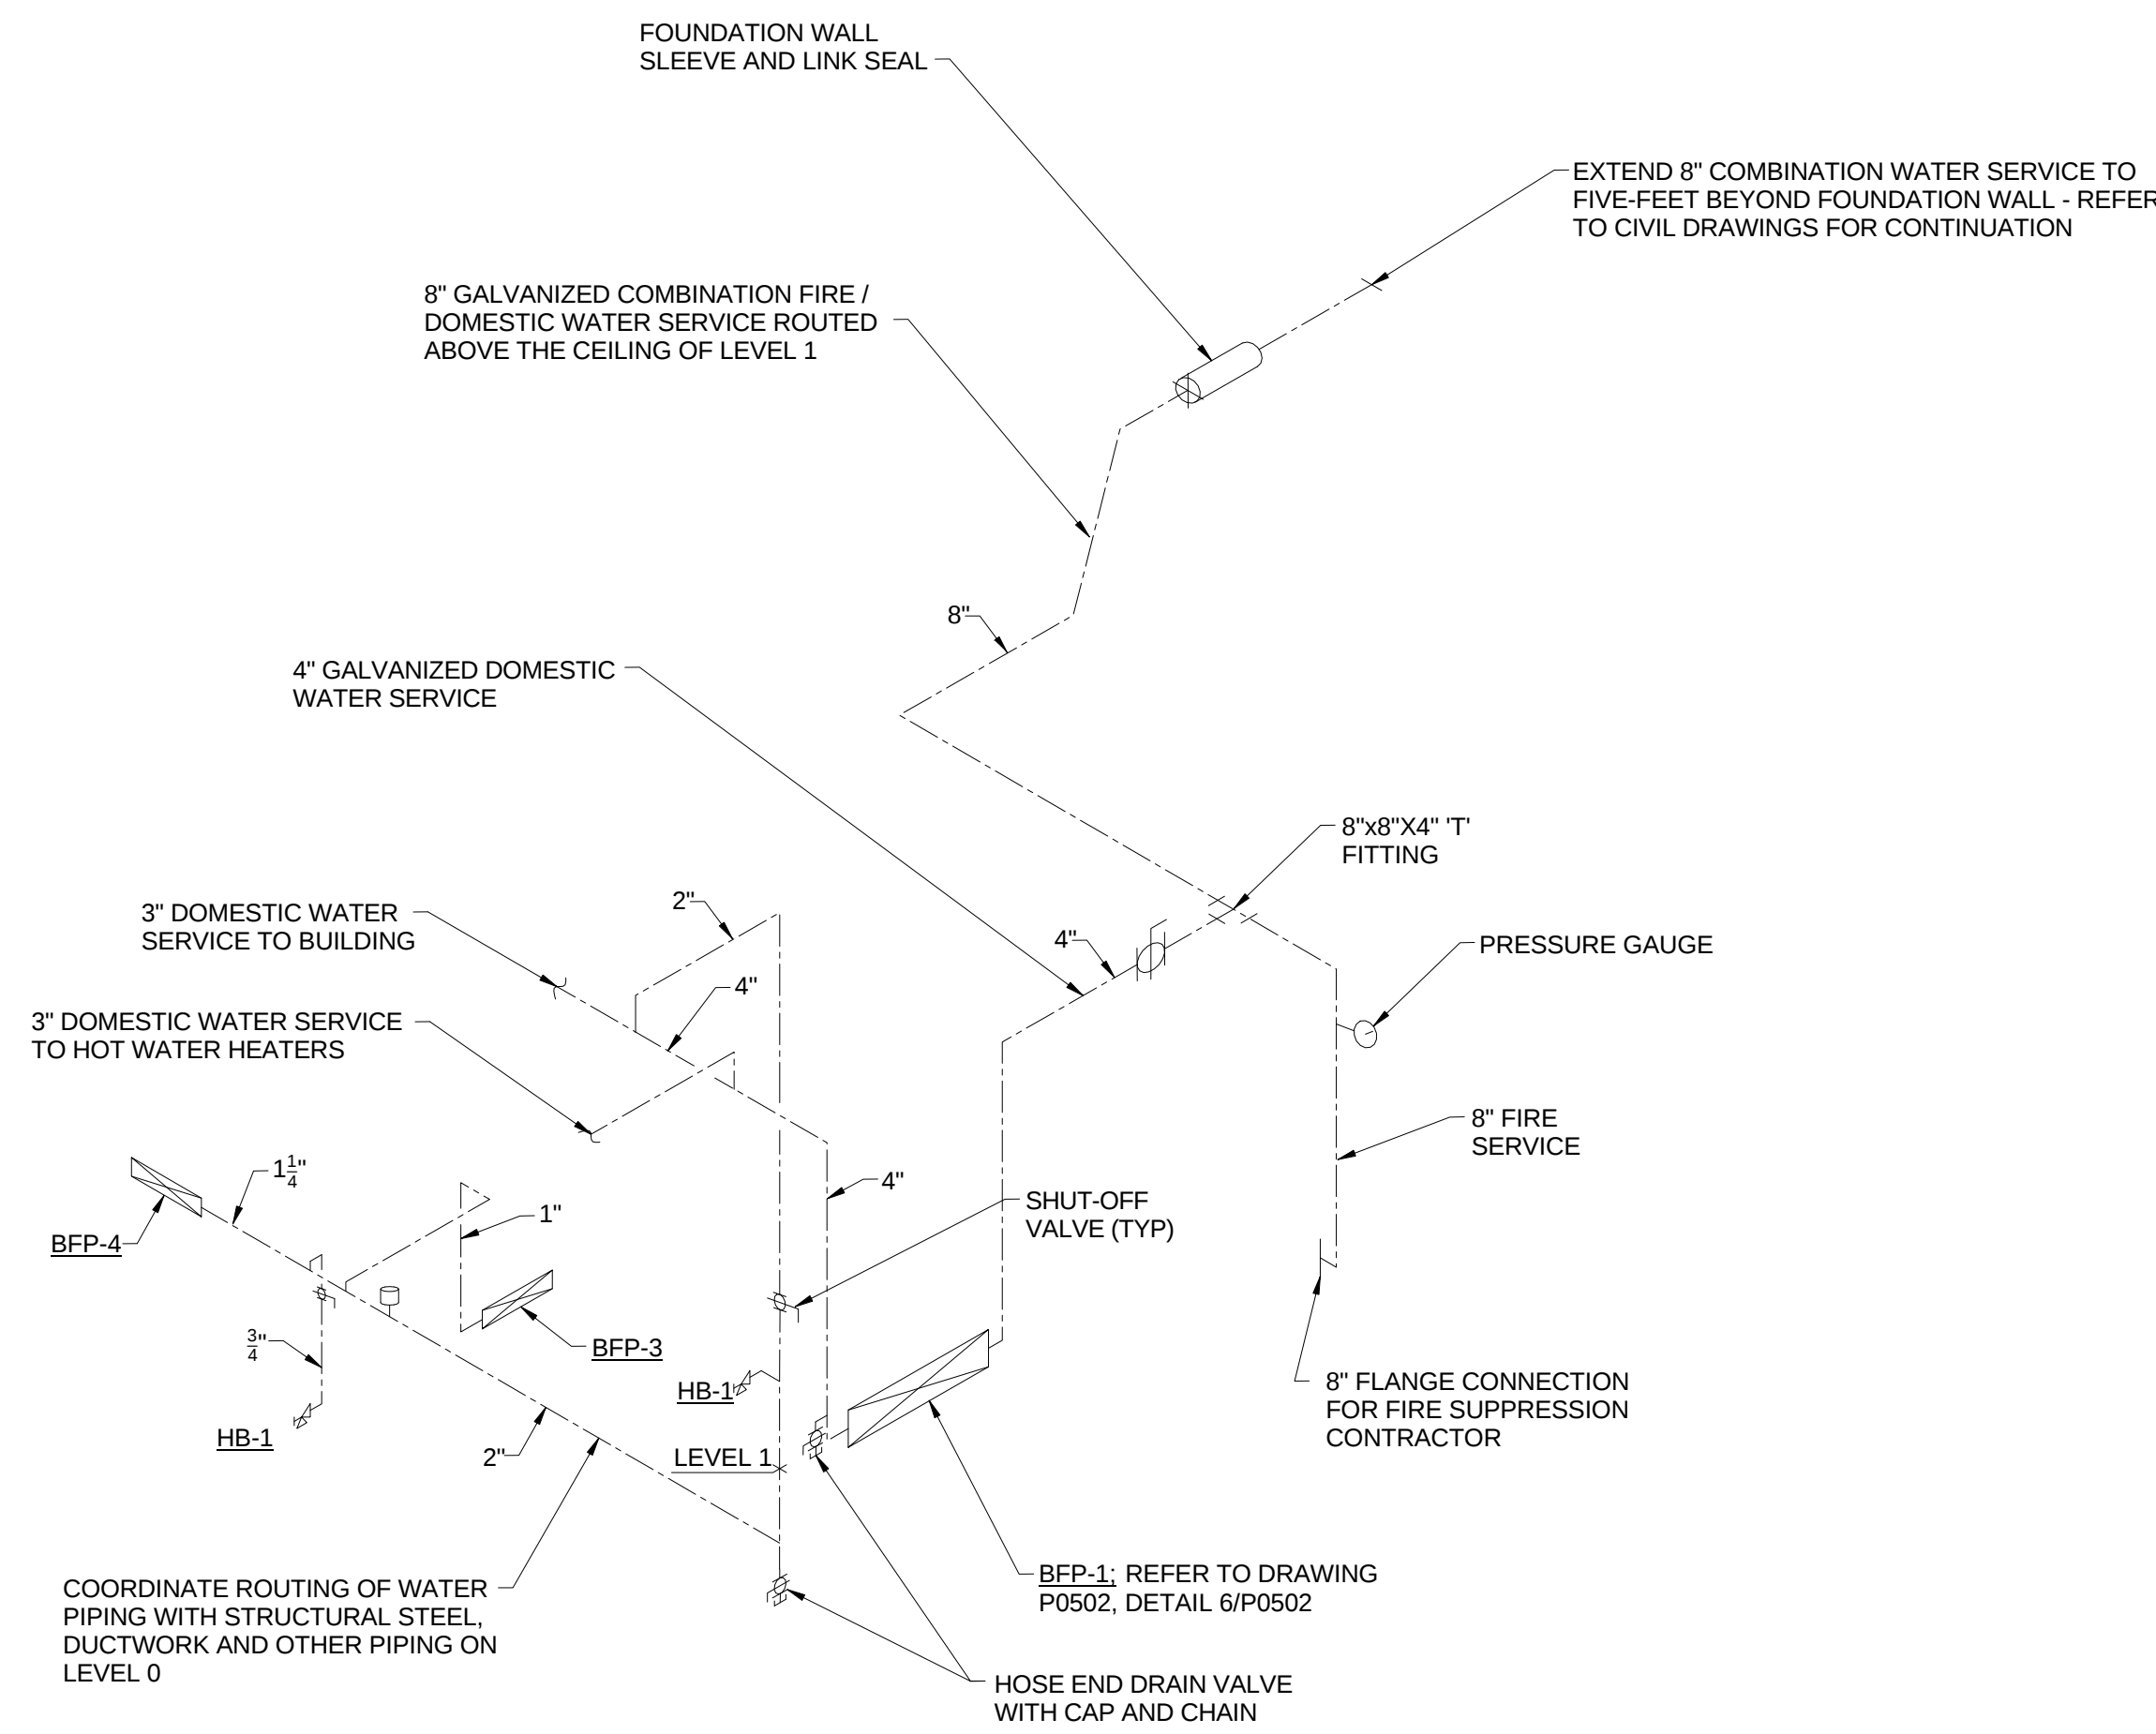


1 COMBINATION FIRE / DOMESTIC BUILDING WATER SERVICE  
P0403 SCALE: N.T.S.

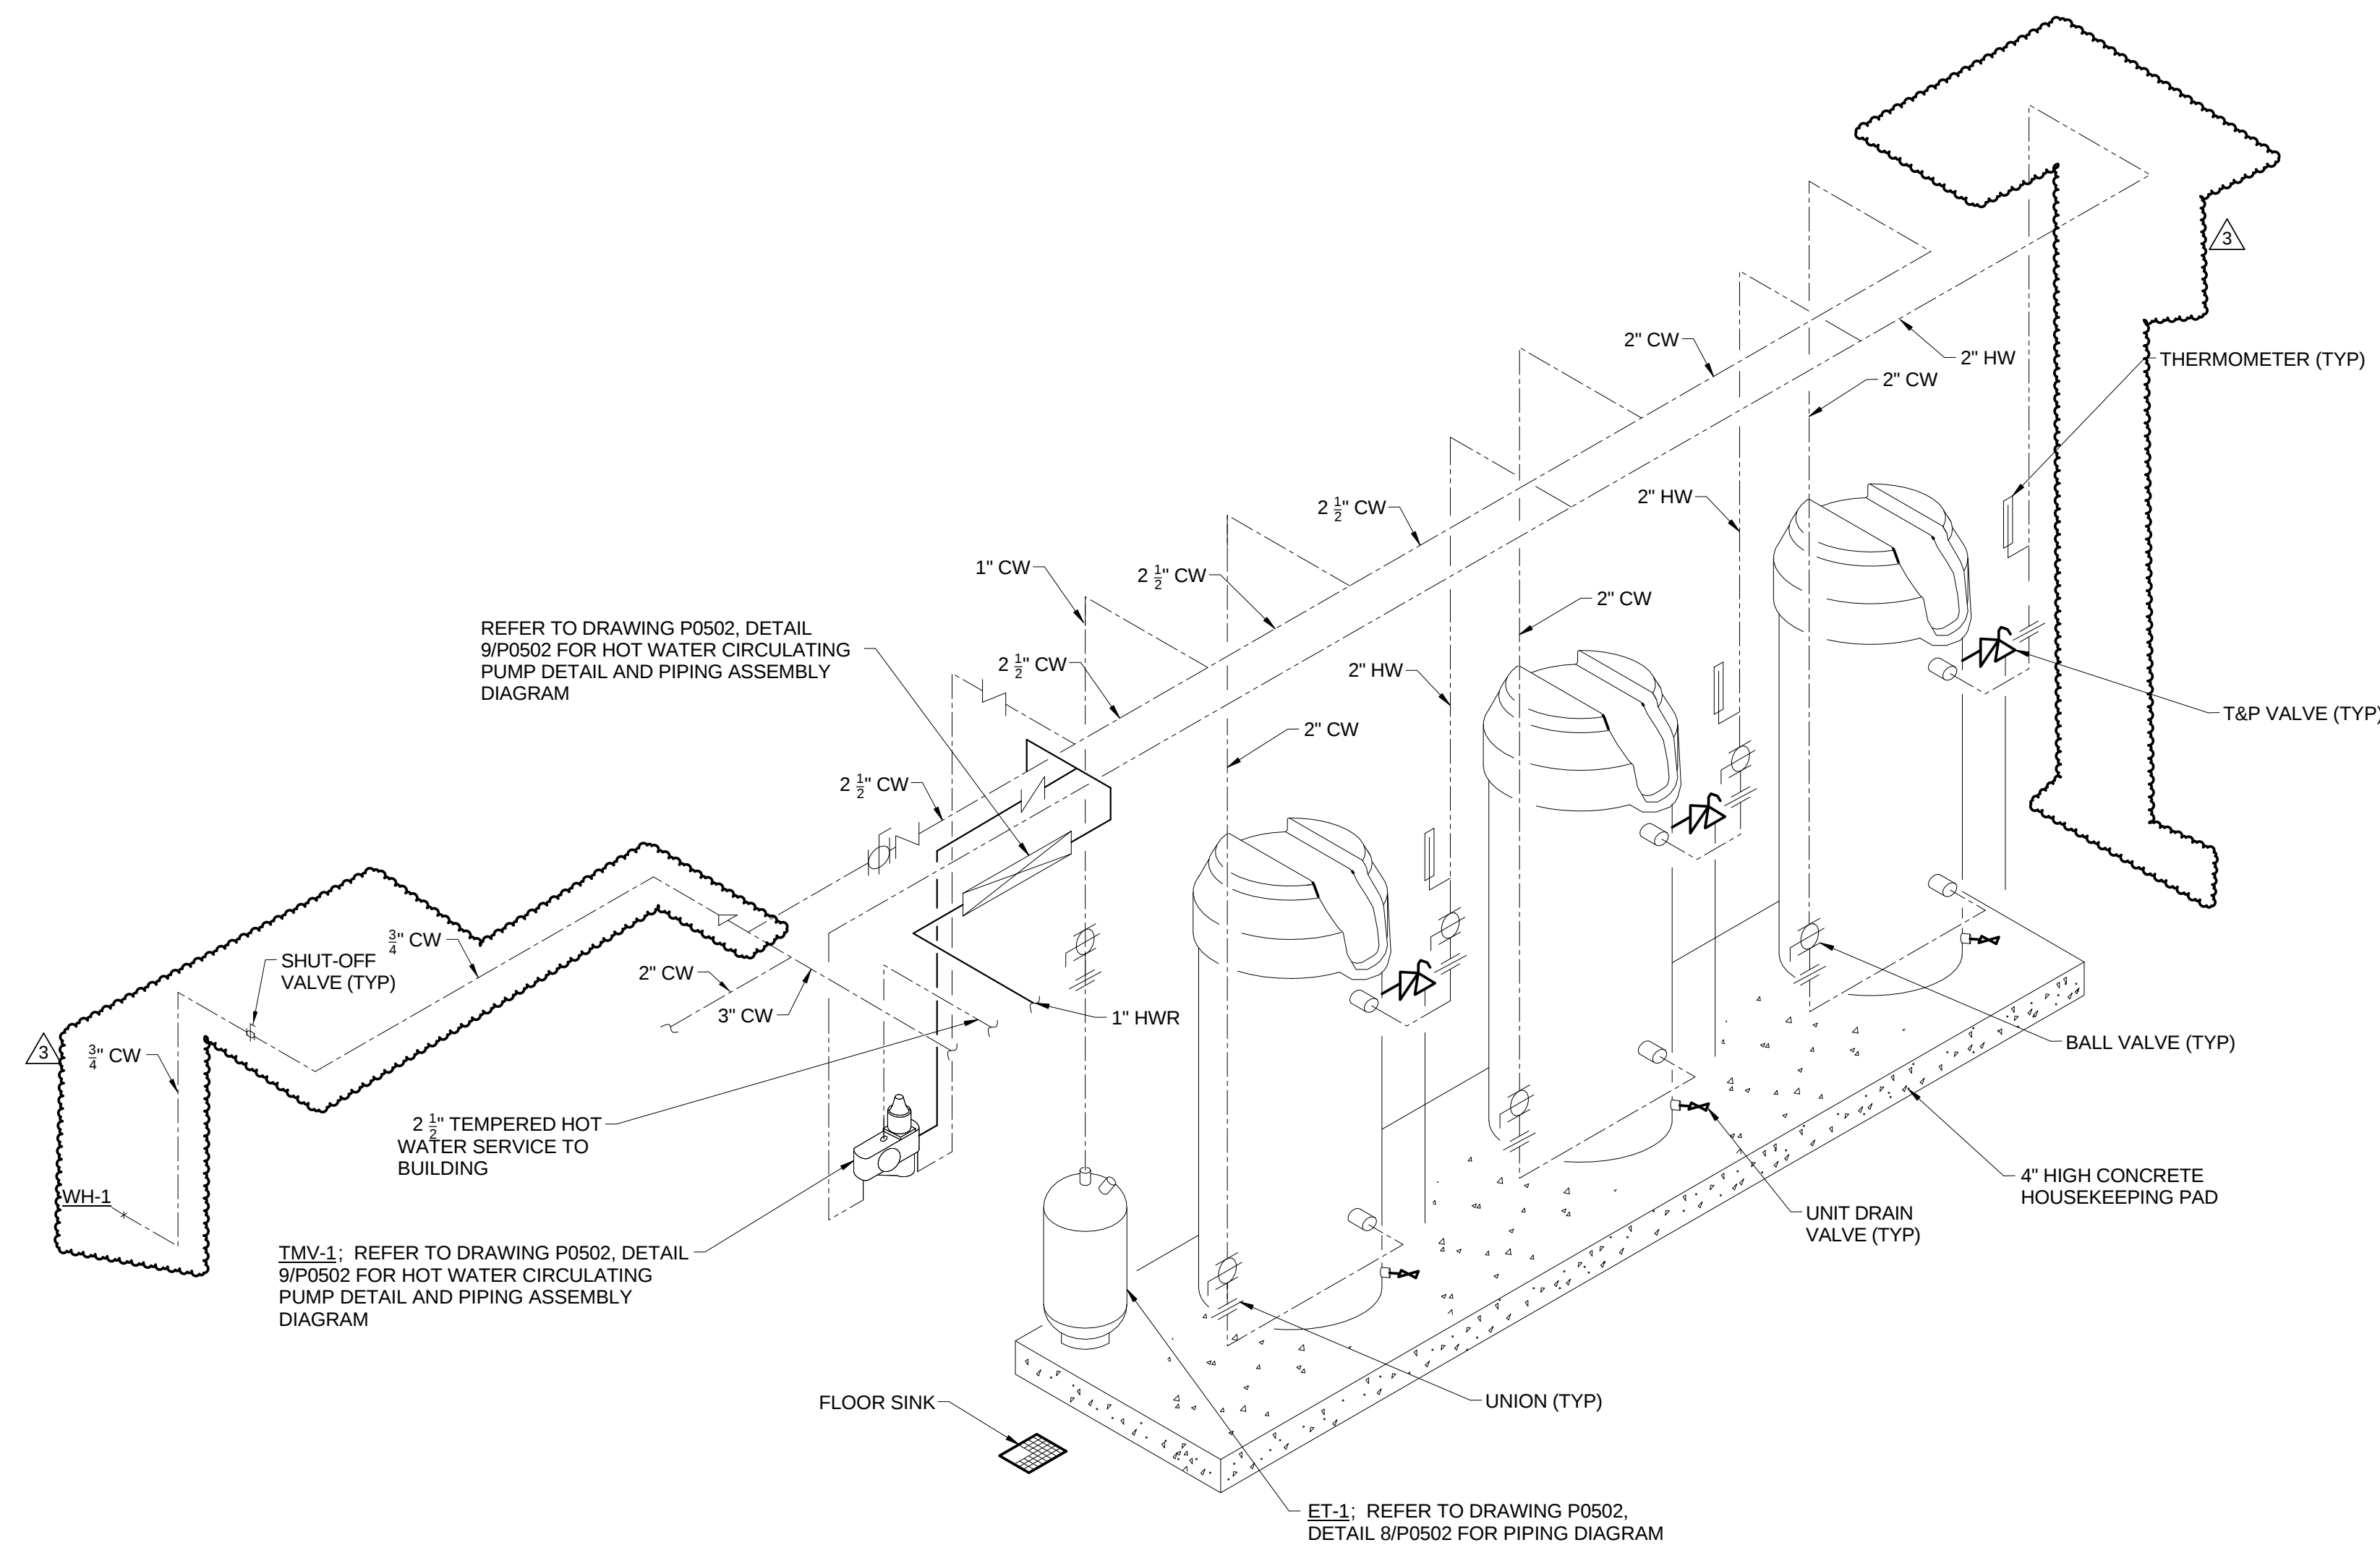

2 DOMESTIC HOT WATER HEATER RISER / PIPING DIAGRAM  
P0403 SCALE: N.T.S.

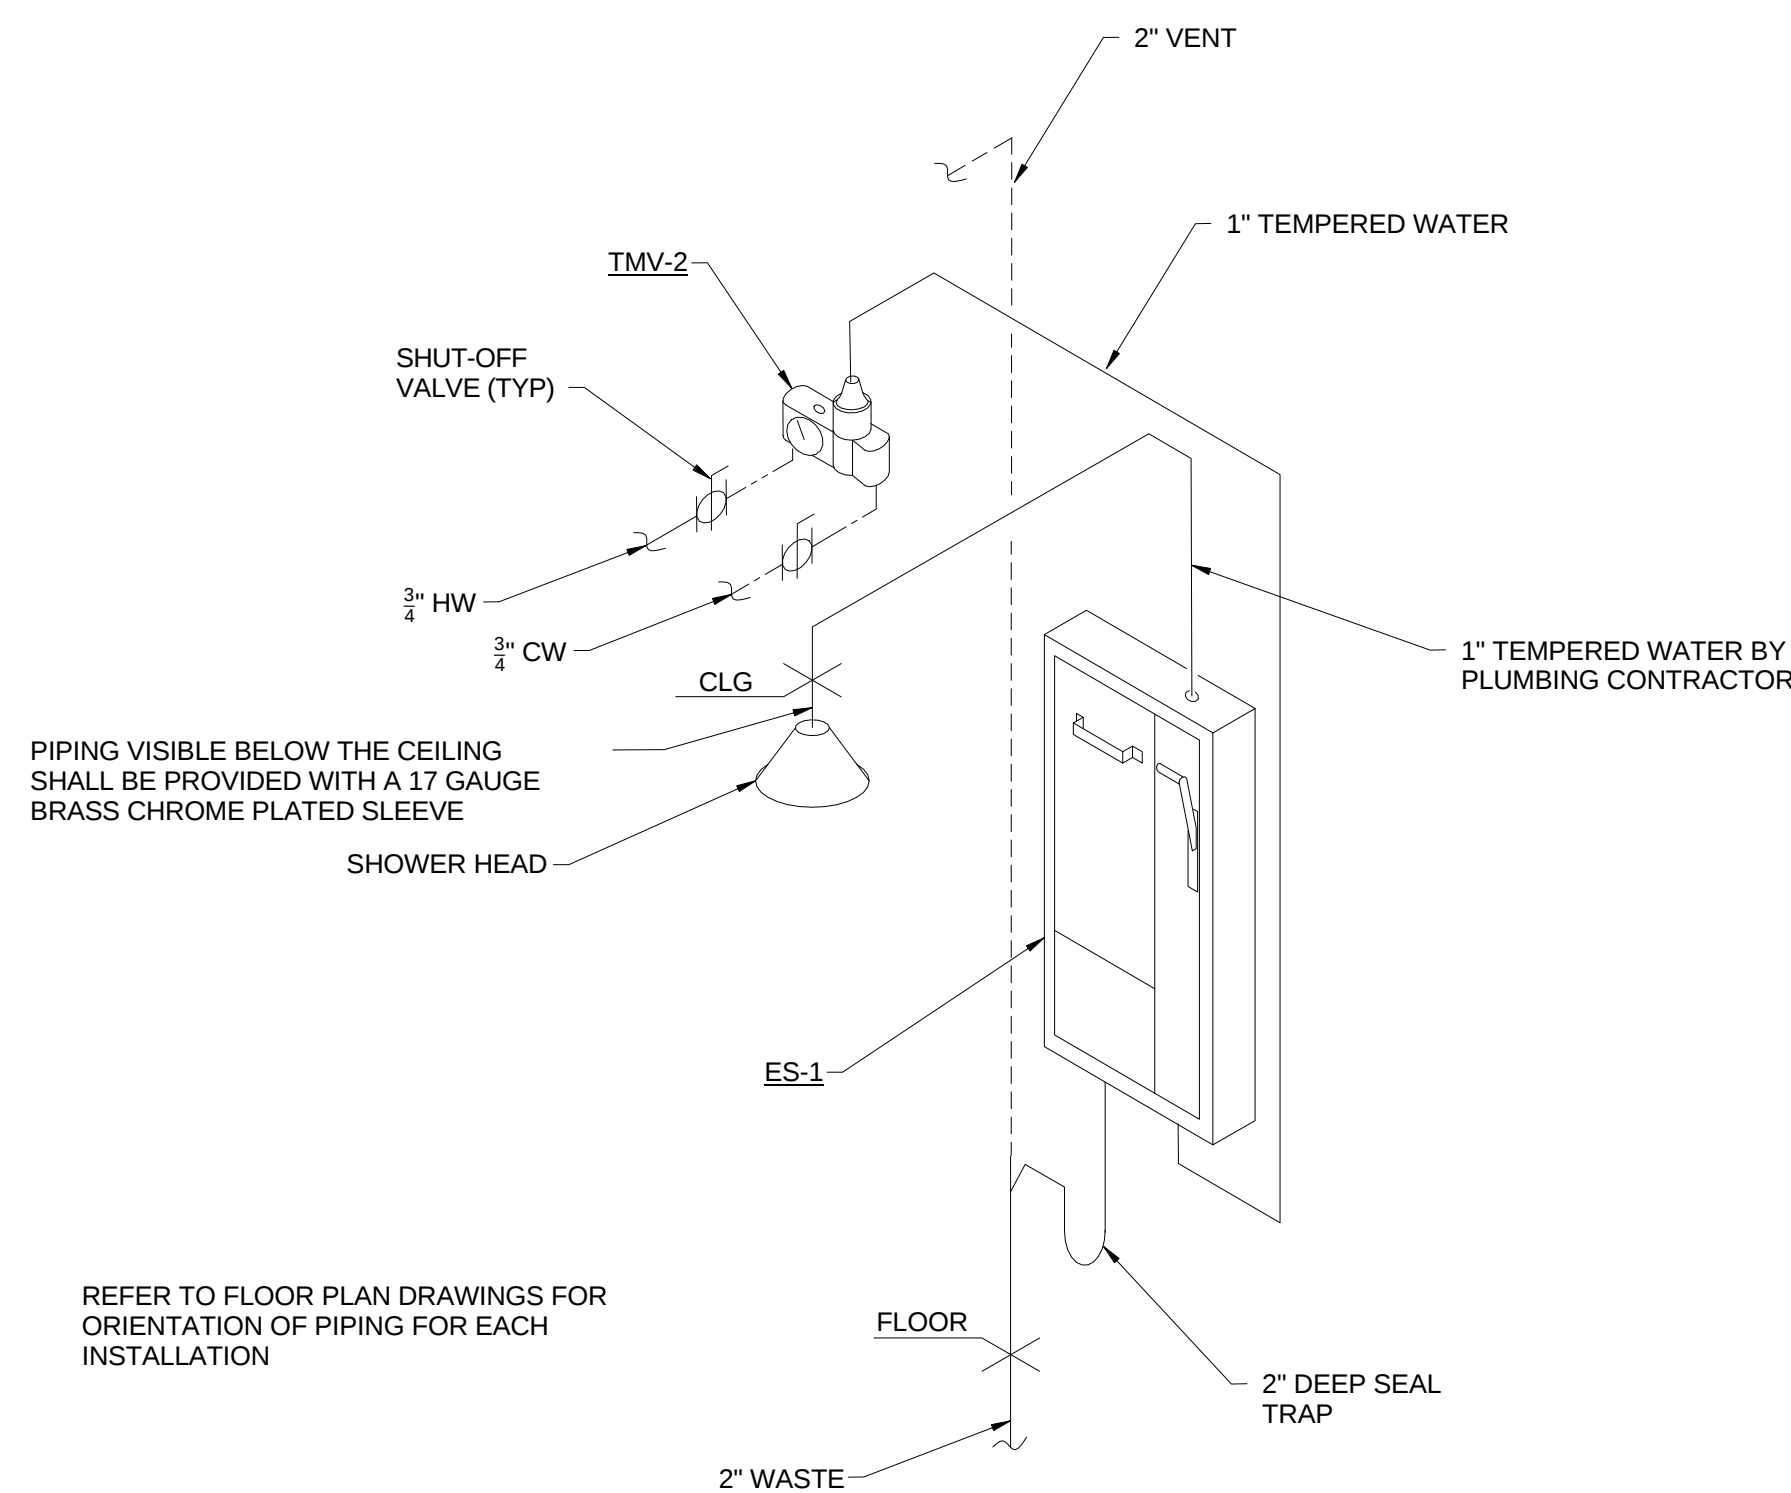

3 TYPICAL EMERGENCY SHOWER PIPING DIAGRAM  
P0403 SCALE: N.T.S.

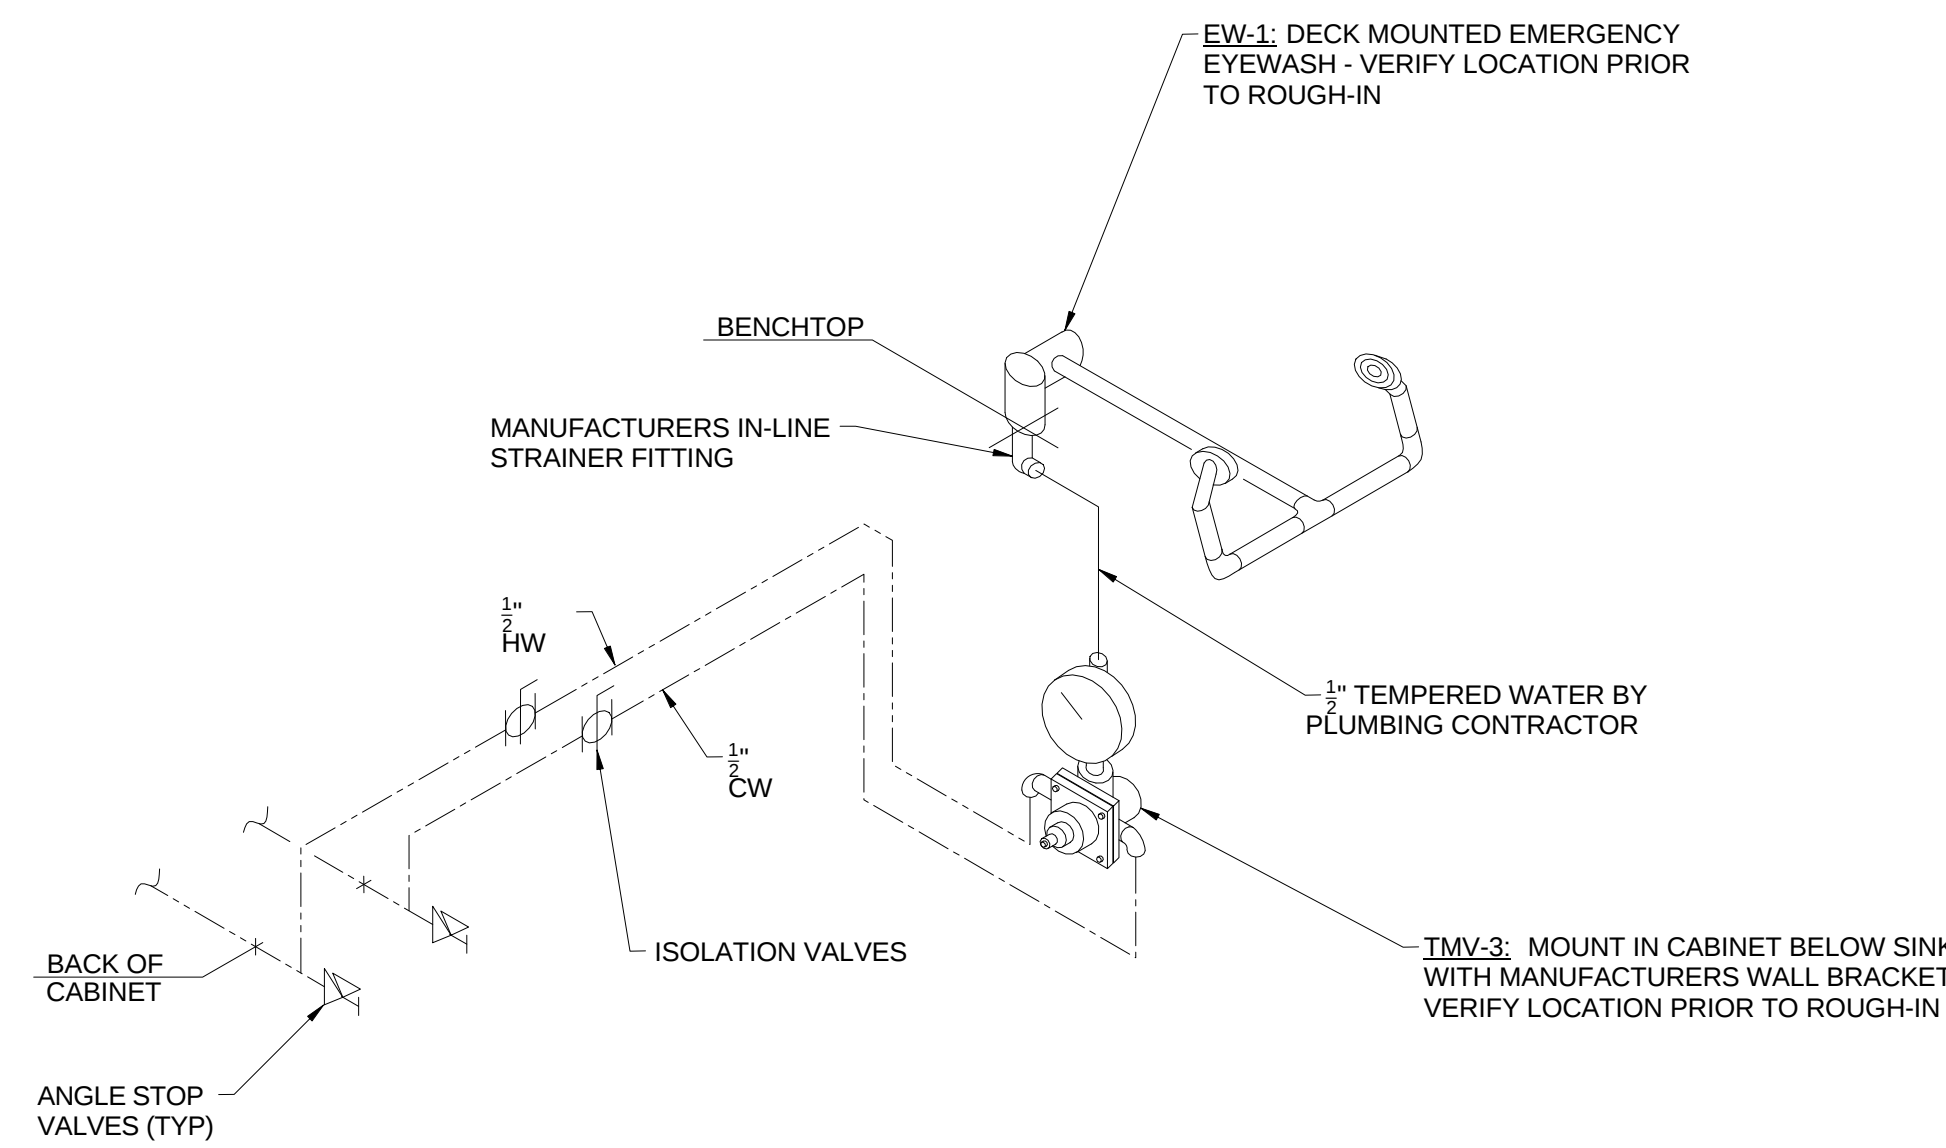

4 TYPICAL EMERGENCY EYEWASH PIPING DIAGRAM  
P0403 SCALE: N.T.S.

| 3   | ASI - 052                         | 22 FEB 2017 |
|-----|-----------------------------------|-------------|
| 2   | ASI - 024 (RFI 222,233,235 & 236) | 24 AUG 2016 |
| 1   | ADDENDUM 2-2                      | 19 APR 2016 |
| -   | ISSUED FOR CONSTRUCTION (BP2)     | 01 MAR 2016 |
| No. | Description                       | Date        |

Drawing Title:

RISERS - PLUMBING

Project No.: 04561.01 Checked by:

P0403