



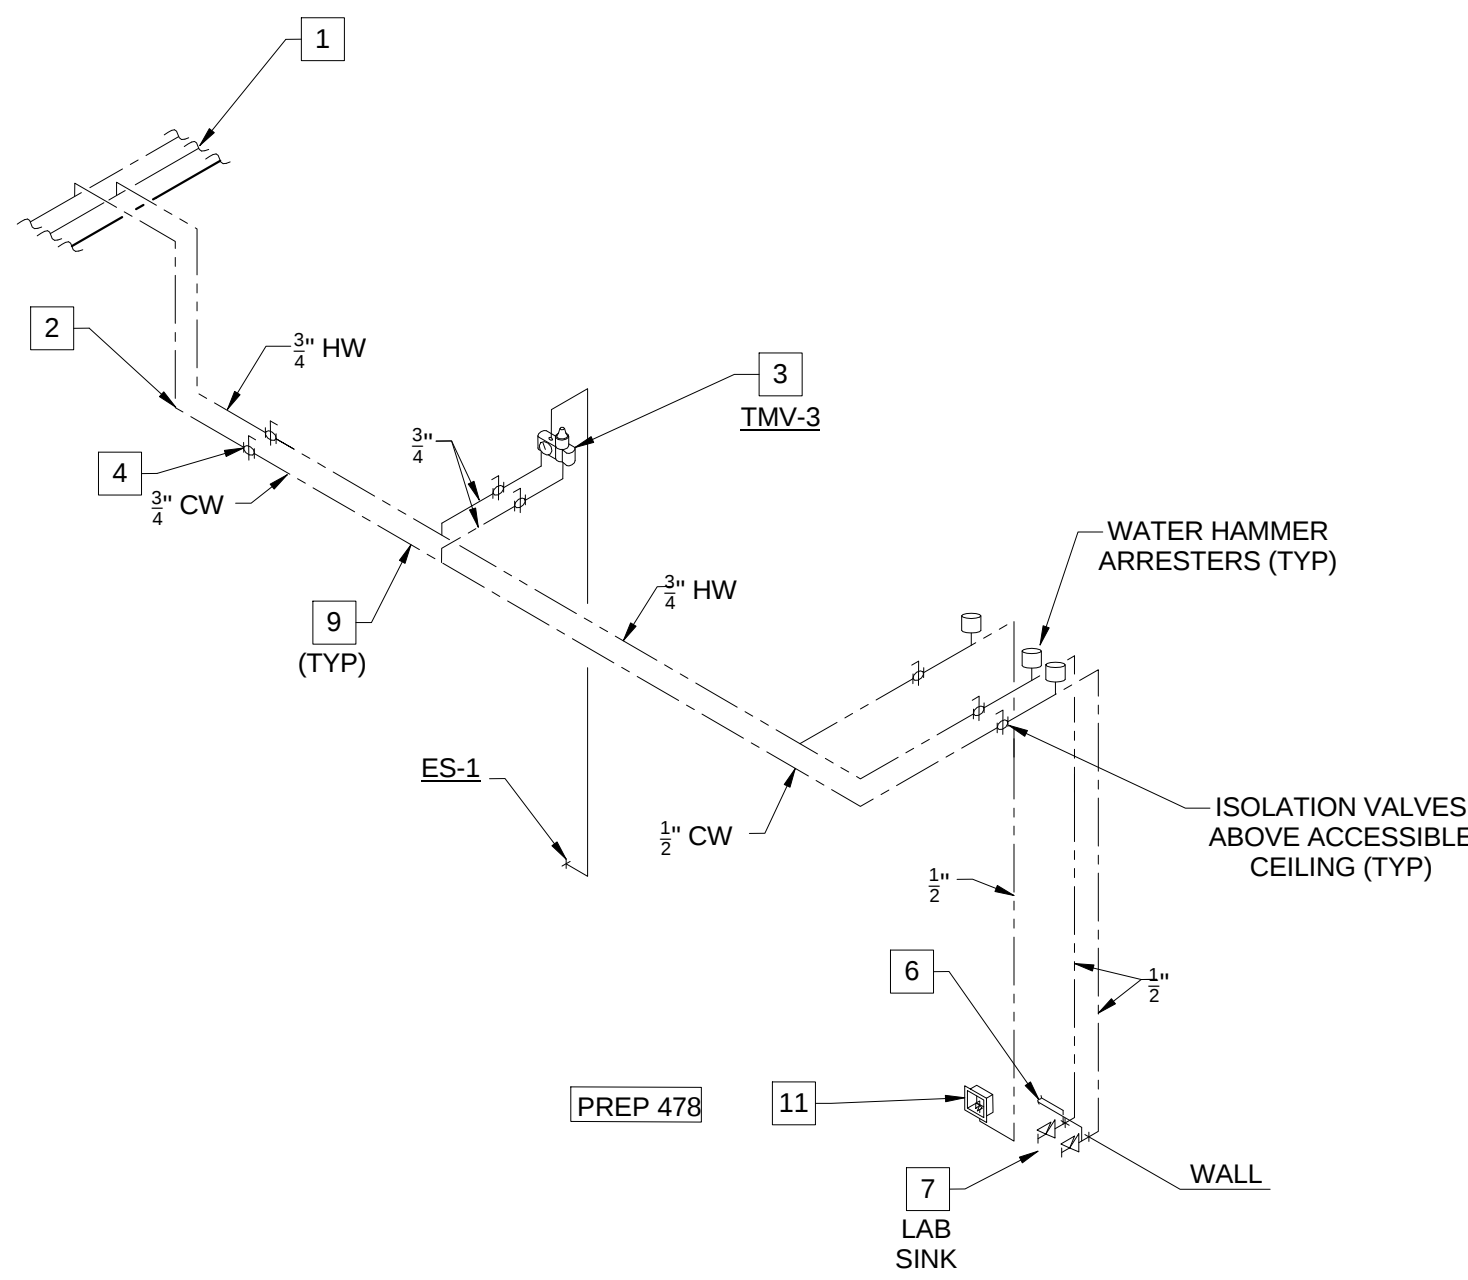


2 DOMESTIC WATER SUPPLY RISER - PREP 478


- KEYED NOTES (THIS SHEET ONLY)
- 1 DOMESTIC WATER PIPING IN THE CORRIDOR TO BE RUN AT THE BOTTOM OF THE STRUCTURAL CROSS MEMBERS. COORDINATE INSTALLATION AND ROUTING WITH OTHER TRADES ON THIS PROJECT.
 - 2 DROP PIPING BELOW THE STRUCTURAL STEEL MEMBER. HOLD TIGHT TO BOTTOM OF STEEL.
 - 3 THERMOSTATIC MIXING VALVE (TMV-2) SERVING THE EMERGENCY SHOWER TO BE LOCATED ABOVE THE ACCESSIBLE CEILING. REFER TO DRAWING P0403, DETAIL 3/P0403 FOR PIPING DIAGRAM OF EMERGENCY SHOWER. VERIFY LOCATION AND PIPING CONFIGURATION PRIOR TO ROUGH-IN.
 - 4 PROVIDE SHUT-OFF VALVES AT THE ENTRY TO EACH ROOM.
 - 5 REFER TO DRAWING P0502, DETAIL 11/P0502 FOR HOT WATER RETURN PIPING DIAGRAM.
 - 6 WATER PIPING CONNECTION TO THERMOSTATIC MIXING VALVE (TMV-3) SERVING THE DECK MOUNTED EMERGENCY EYEWASH. REFER TO DRAWING P0403, DETAIL 4/P0403 FOR PIPING DIAGRAM OF EMERGENCY EYEWASH. VERIFY LOCATION AND PIPING CONFIGURATION PRIOR TO ROUGH-IN.
 - 7 LAB SINK WITH LAB FAUCET TYPE 'LF-1'.
 - 8 CUP SINK WITH LAB FAUCET TYPE 'LF-2'. TYPICAL FOR SIX CUP SINKS AND TWELVE LAB FAUCET 'LF-2'. EXTEND COLD WATER PIPING WITHIN UTILITY CHASE OF CASEWORK. COORDINATE ROUTING AND INSTALLATION WITH OTHER SERVICES IN SPACE.
 - 9 DOMESTIC WATER PIPING IN EACH ROOM TO BE RUN AS HIGH AS POSSIBLE TO AVOID CONFLICTS. COORDINATE INSTALLATION WITH OTHER TRADES ON THIS PROJECT PRIOR TO ROUGH-IN.
 - 10 DOMESTIC WATER PIPING IN CEILING SPACE OF LEVEL 3 TO SERVE LAB AND CUP SINKS ON LEVEL 4. COORDINATE ROUTING AND INSTALLATION WITH SPACE CONDITIONS.
 - 11 WATER CONNECTION FOR UNDER COUNTER GLASS WASHER. COORDINATE LOCATION AND INSTALLATION WITH EQUIPMENT AND CASEWORK.
 - 12 WATER CONNECTION FOR COUNTERTOP MOUNTED AUTOCLAVE. COORDINATE LOCATION AND INSTALLATION WITH EQUIPMENT AND CASEWORK. PROVIDE WATER OUTLET BOX SIMILAR TO CW-1.

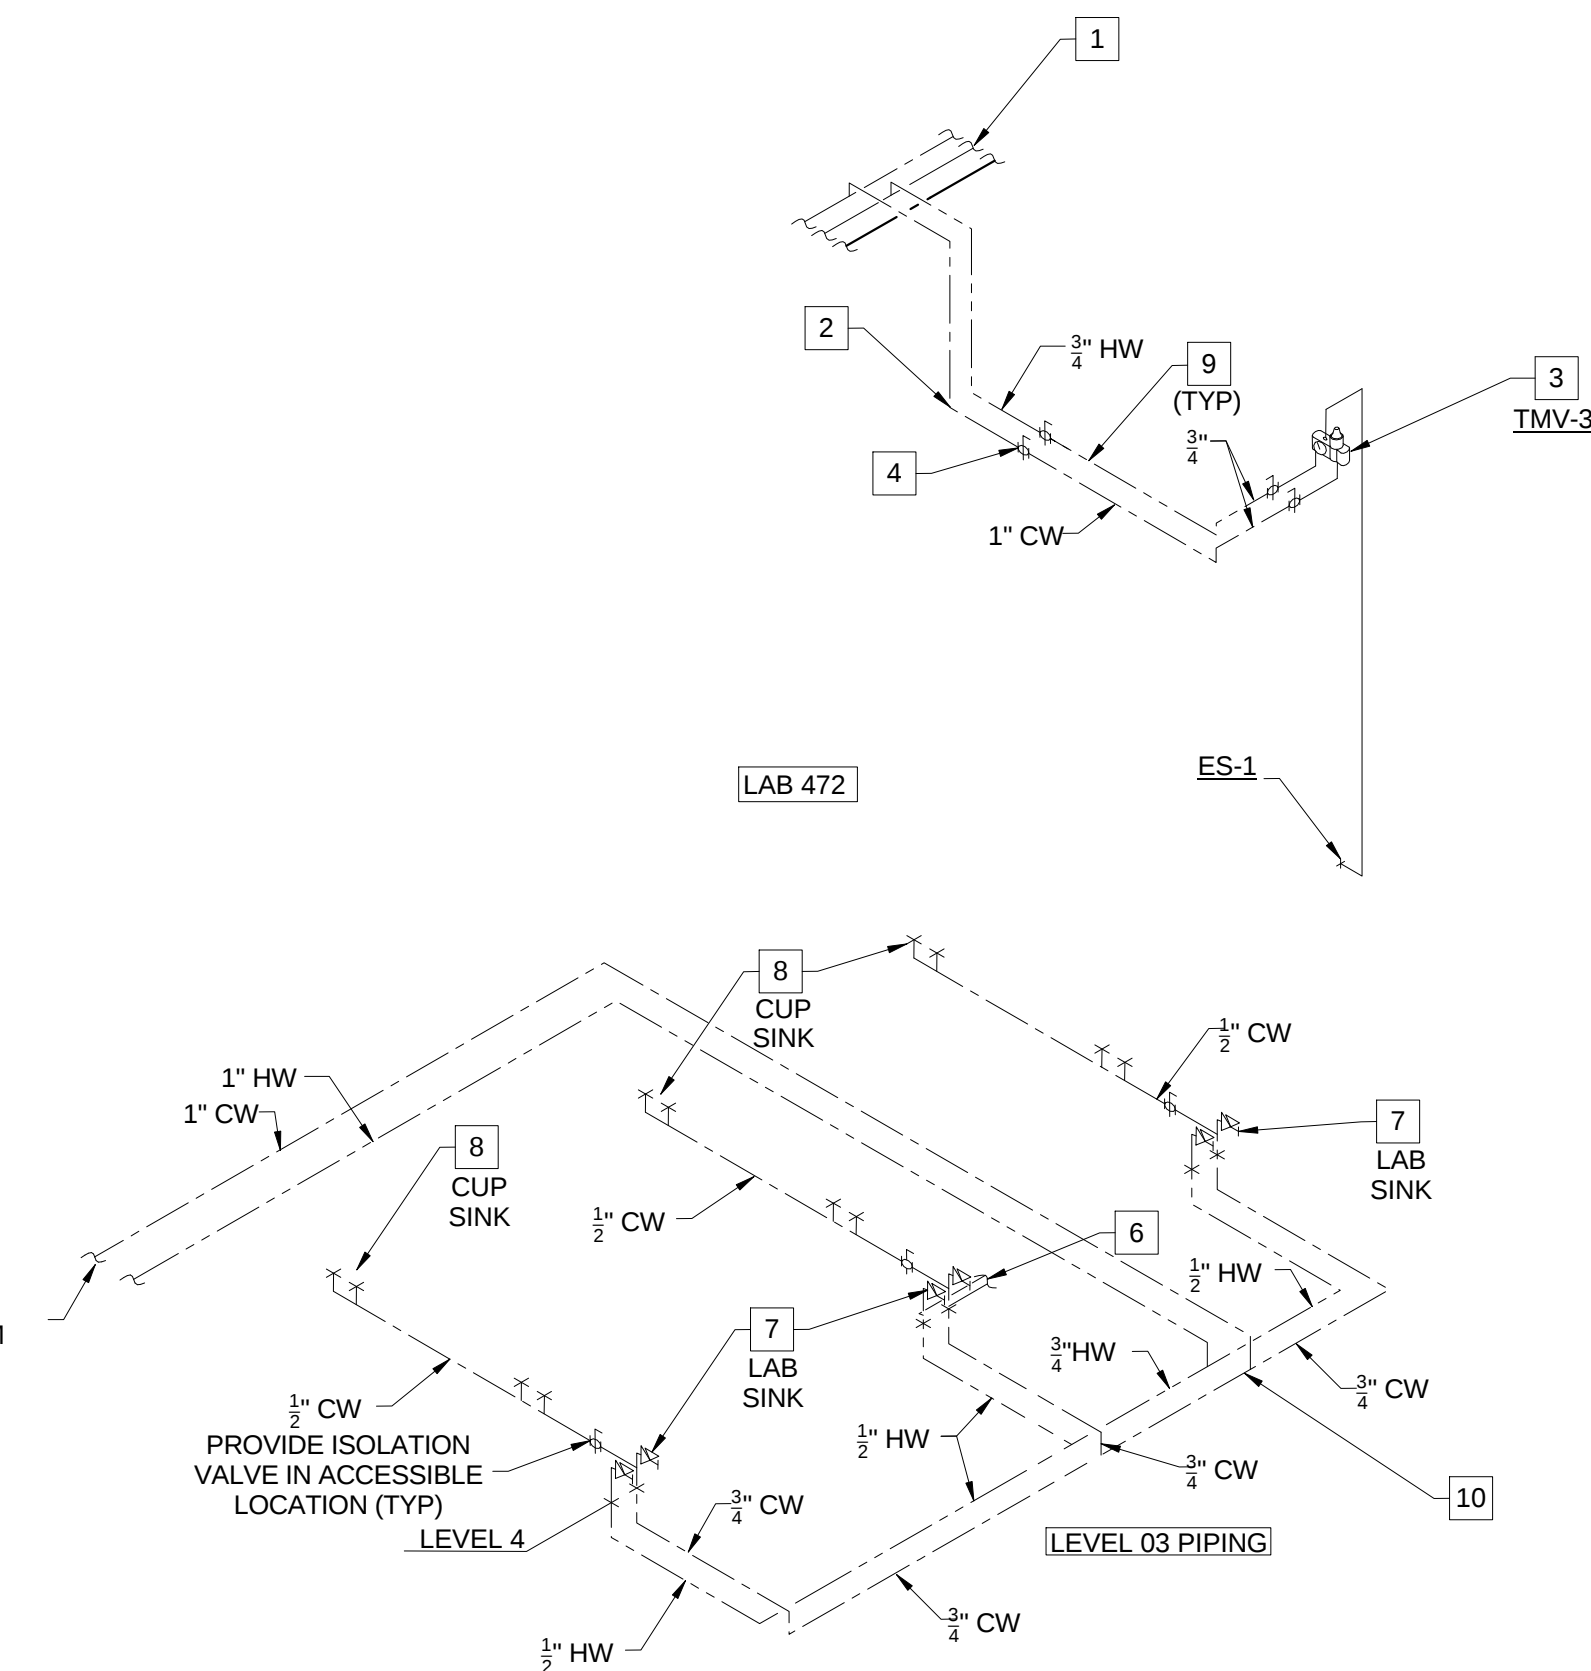

4 DOMESTIC WATER SUPPLY RISER - PREP 472

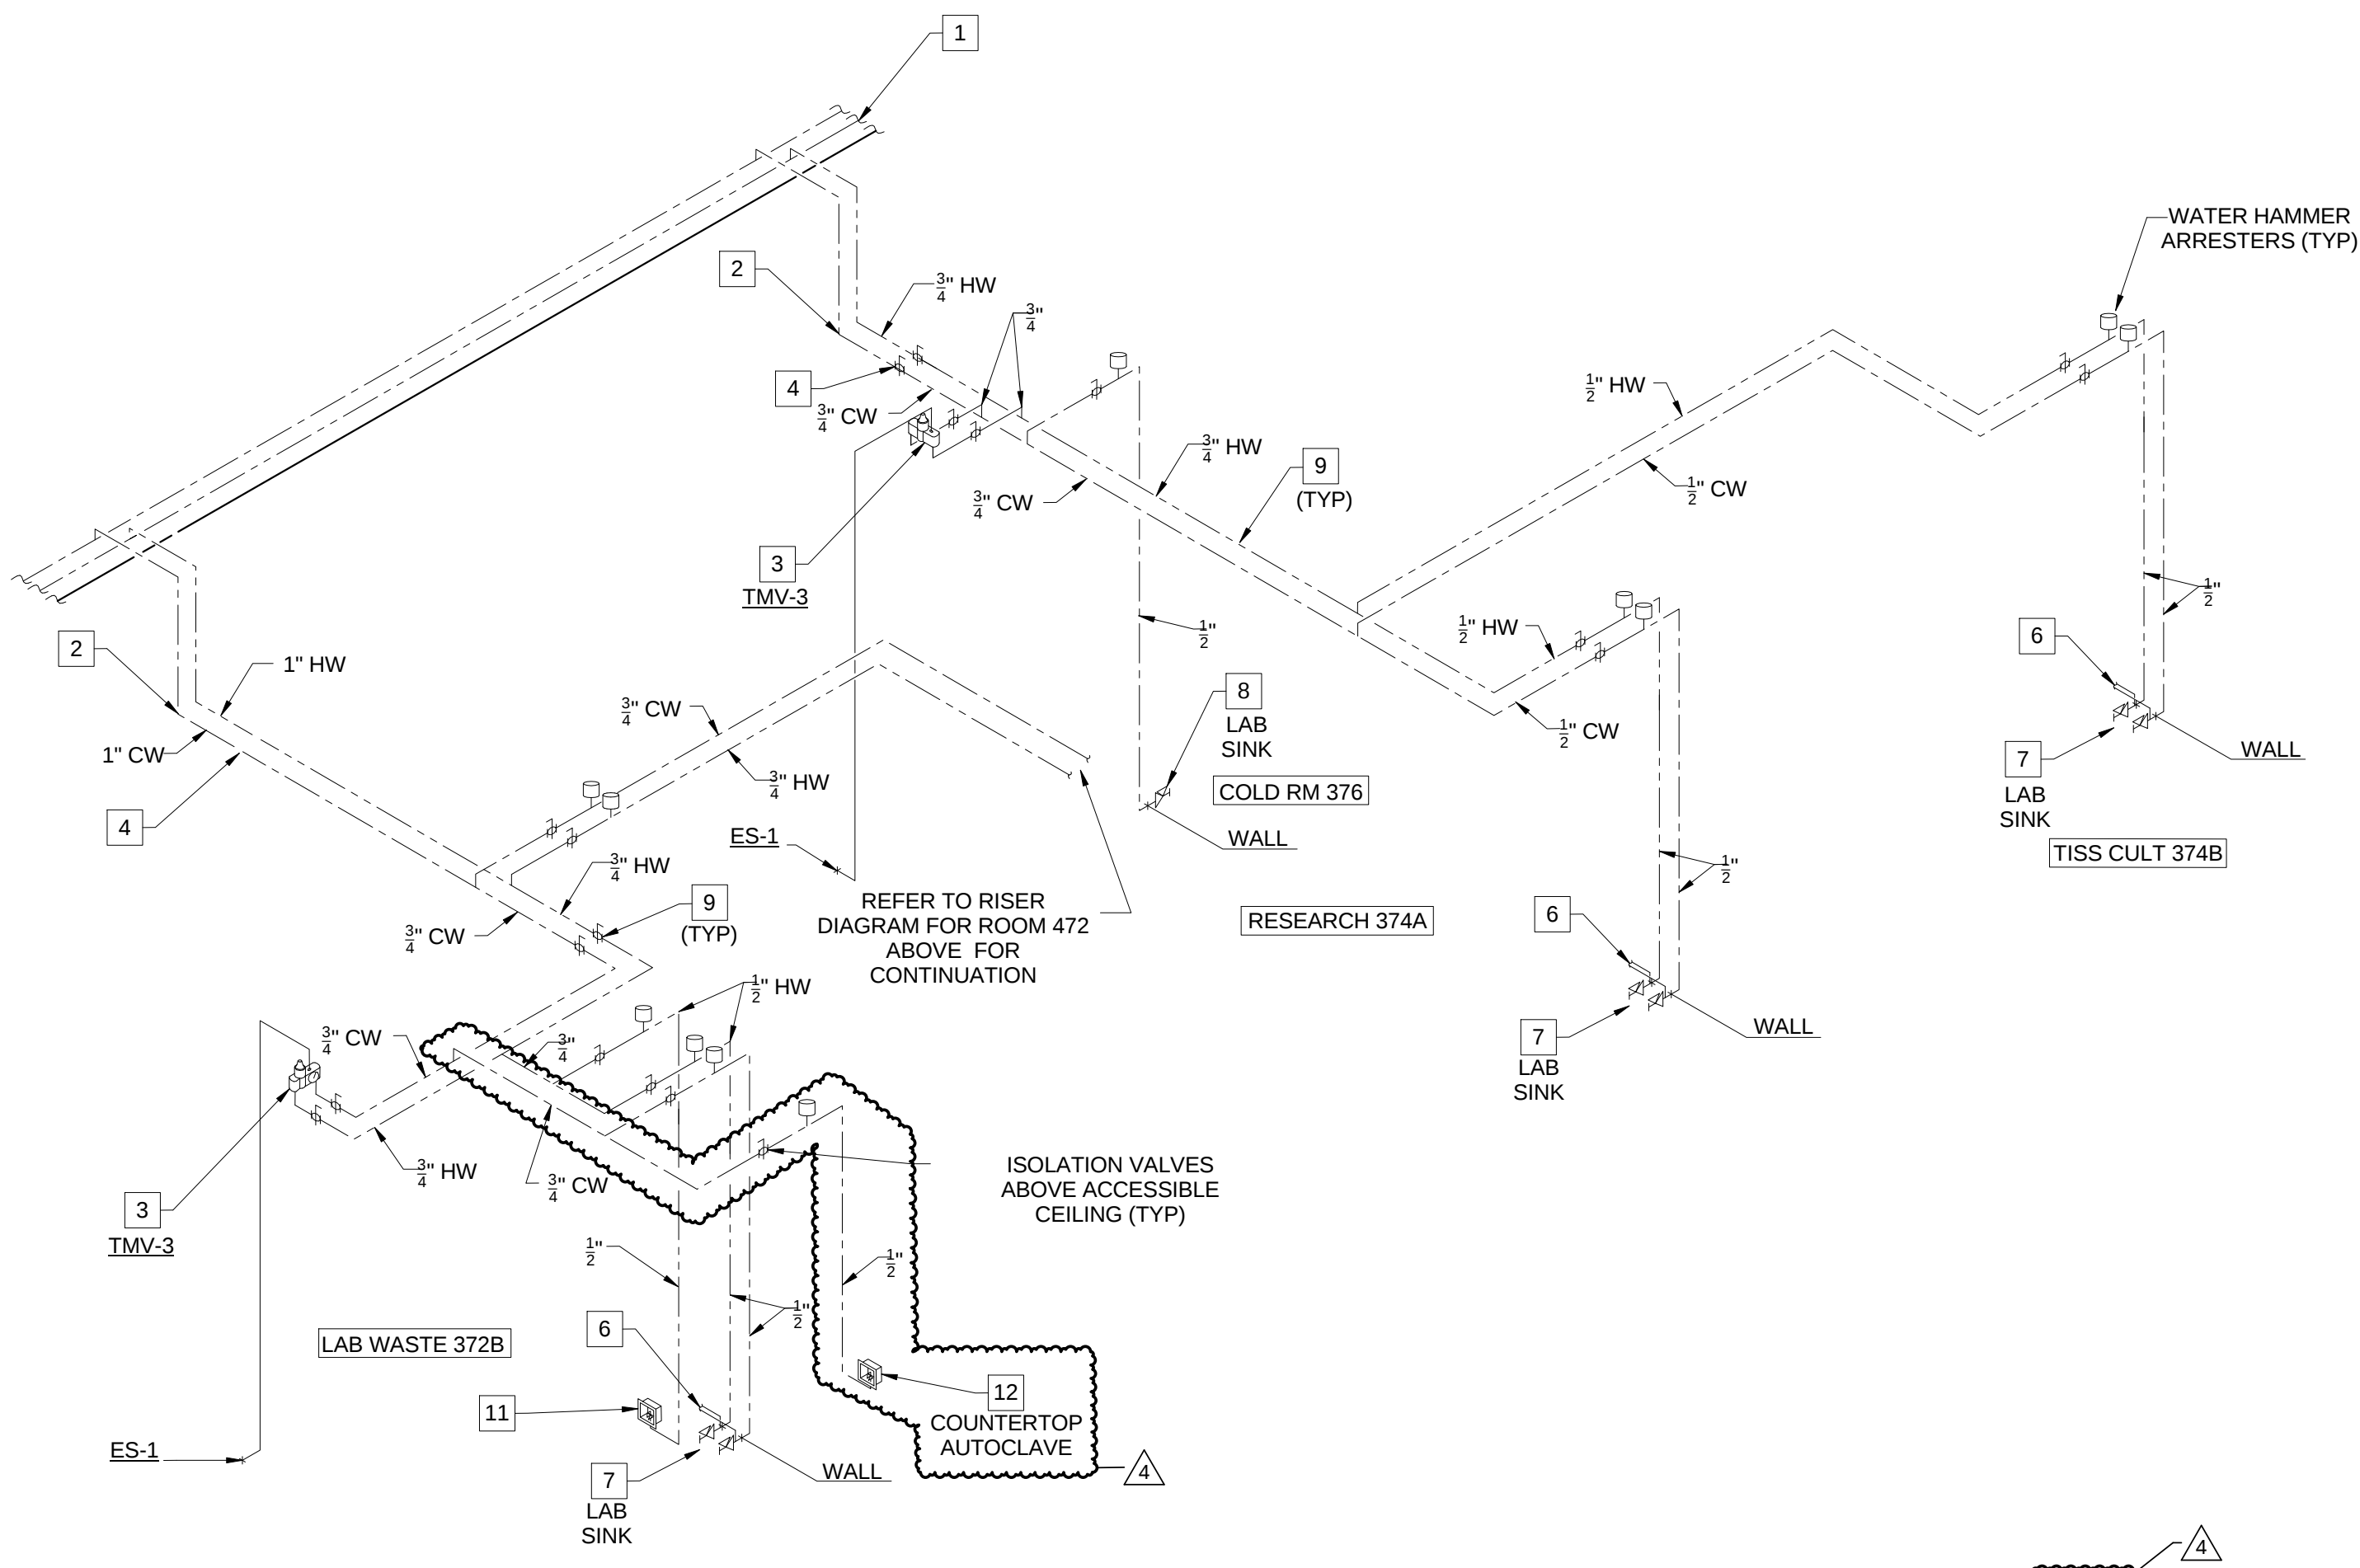

1 DOMESTIC WATER SUPPLY RISER - LAB WASTE 372B, RESEARCH 374A, TISSUE CULTURE 374B AND COLD ROOM 376

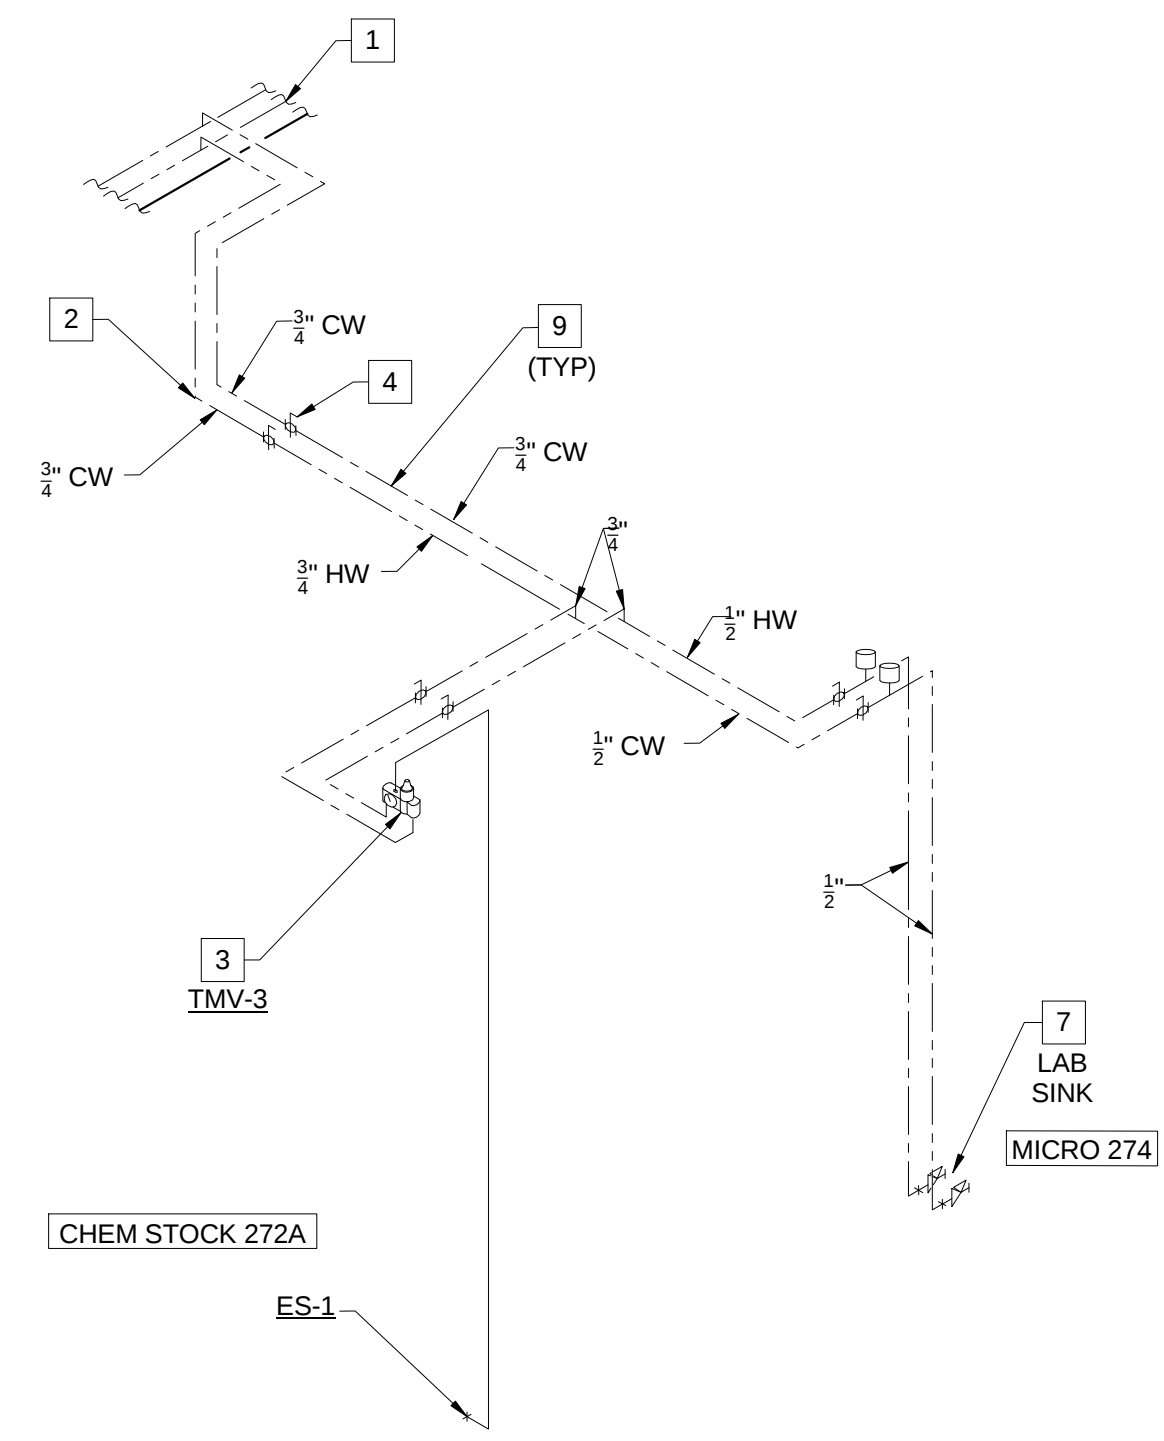

3 DOMESTIC WATER SUPPLY RISER - CHEM STOCK 272A AND MICROSCOPY 274

4	ASI - 033 (RFI 261,286,309 & 310)	03 NOV 2016
3	ASI - 019 (RFI-193,208 & 212)	29 JUL 2016
2	ADDENDUM 2-4	24 MAY 2016
1	ADDENDUM 2-2	19 APR 2016
-	ISSUED FOR CONSTRUCTION (BP2)	01 MAR 2016

No.	Description	Date
-----	-------------	------

Drawing Title:

RISERS - PLUMBING

Project No.: 04561.01 Checked by:

P0409