
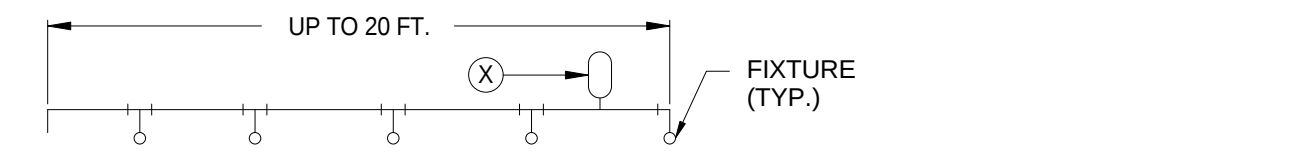


| PLUMBING FIXTURE CONNECTION SCHEDULE                                                                                                                                |                                |              |             |        |          |      |                                                                         |  |  |
|---------------------------------------------------------------------------------------------------------------------------------------------------------------------|--------------------------------|--------------|-------------|--------|----------|------|-------------------------------------------------------------------------|--|--|
| ITEM NO.                                                                                                                                                            | EQUIPMENT DESCRIPTION          | WATER SUPPLY |             | WASTE  |          | VENT | REMARKS                                                                 |  |  |
|                                                                                                                                                                     |                                | HW           | CW          | DIRECT | INDIRECT |      |                                                                         |  |  |
| WC-1                                                                                                                                                                | WATER CLOSET                   | -            | 1-1/4"      | 4"     | -        | 2"   | WALL HUNG, BACK OUTLET STANDARD MOUNTING HEIGHT                         |  |  |
| WC-2                                                                                                                                                                | WATER CLOSET (ADA)             | -            | 1-1/4"      | 4"     | -        | 2"   | WALL HUNG, BACK OUTLET STANDARD ADA MOUNTING HEIGHT                     |  |  |
| U-1                                                                                                                                                                 | URINAL                         | -            | 1"          | 2"     | -        | 2"   | WALL HUNG, BACK OUTLET STANDARD MOUNTING HEIGHT                         |  |  |
| LAV-1                                                                                                                                                               | LAVATORY                       | 1/2"         | 1/2"        | 2"     | -        | 2"   | COUNTERTOP MOUNTED WITH UNDER-COUNTER ADA INSULATION KIT                |  |  |
| LAV-2                                                                                                                                                               | LAVATORY                       | 1/2"         | 1/2"        | 2"     | -        | 2"   | WALL HUNG, ADA MOUNTING HEIGHT WITH UNDER-COUNTER ADA INSULATION KIT    |  |  |
| CSS-1                                                                                                                                                               | CLINICAL SERVICE SINK          | 1/2"         | 1-1/4"/1/2" | 4"     | -        | 2"   | FLUSH VALVE, CW & HW FAUCET, HOSE SPRAY                                 |  |  |
| SS-1                                                                                                                                                                | SURGICAL SCRUB SINK            | 1/2"         | 1/2"        | 2"     | -        | 2"   | WALL HUNG, AUTOMATIC SENSOR DECK MOUNTED FAUCET                         |  |  |
| SK-1                                                                                                                                                                | SINGLE COMPARTMENT SINK        | 1/2"         | 1/2"        | 2"     | -        | 2"   | STAFF BREAK ROOM - COUNTERTOP MOUNTED, TO INCLUDE FIXTURE TYPE 'GD-1'.  |  |  |
| SK-2                                                                                                                                                                | SINGLE COMPARTMENT SINK        | 1/2"         | 1/2"        | 2"     | -        | 2"   | NURSING MOCK EXAM ROOM - COUNTERTOP MOUNTED                             |  |  |
| SK-3                                                                                                                                                                | SINGLE COMPARTMENT SINK        | 1/2"         | 1/2"        | 2"     | -        | 2"   | NURSING CLASSROOM / LAB - COUNTERTOP MOUNTED                            |  |  |
| MS-1                                                                                                                                                                | MOP SINK                       | 1/2"         | 1/2"        | 3"     | -        | 2"   | -                                                                       |  |  |
| EW-C-1                                                                                                                                                              | BI-LEVEL ELECTRIC WATER COOLER | -            | 1/2"        | 2"     | -        | 2"   | WALL HUNG, WITH MANUFACTURERS WALL BRACKETS                             |  |  |
| SP-1                                                                                                                                                                | DUPLEX SUMP PUMP               | -            | -           | -      | 3"       | -    | DUPLEX SUMP PUMP - SUB-SURFACE DRAIN AND DRAIN TILE                     |  |  |
| SP-1                                                                                                                                                                | ELEVATOR SUMP PUMP             | -            | -           | -      | 2"       | -    | ELEVATOR SUMP PUMP - EXTEND PIPING AND DISCHARGE INTO FD-3 ON SUB-LEVEL |  |  |
| SP-2                                                                                                                                                                | ELEVATOR SUMP PUMP             | -            | -           | -      | 2"       | -    | ELEVATOR SUMP PUMP - EXTEND PIPING AND DISCHARGE INTO FD-3 ON SUB-LEVEL |  |  |
| EW-1                                                                                                                                                                | EMERGENCY EYEWASH              | 1/2"         | 1/2"        | -      | -        | -    | COUNTERTOP MOUNTED, WITH TMV-3 BELOW IN BASE CABINET                    |  |  |
| ES-1                                                                                                                                                                | EMERGENCY SHOWER               | 3/4"         | 3/4"        | -      | -        | -    | WALL RECESSED, WITH TMV-2 ABOVE THE CEILING                             |  |  |
| WH-1                                                                                                                                                                | WALL HYDRANT, FREEZE PROOF     | -            | 3/4"        | -      | -        | -    | TO INCLUDE WALL CLAMP AND BACKFLOW DEVICE, SLEEVE TO SUIT WALL DEPTH    |  |  |
| CM-1                                                                                                                                                                | COFFEE MAKER OUTLET BOX        | -            | 1/2"        | -      | -        | -    | -                                                                       |  |  |
| IM-1                                                                                                                                                                | ICE MAKER OUTLET BOX           | -            | 1/2"        | -      | -        | -    | -                                                                       |  |  |
| LF-1                                                                                                                                                                | LABORATORY FAUCET              | 1/2"         | 1/2"        | -      | -        | -    | -                                                                       |  |  |
| LF-2                                                                                                                                                                | LABORATORY FAUCET              | -            | 1/2"        | -      | -        | -    | -                                                                       |  |  |
| DF-1                                                                                                                                                                | DEIONIZED WATER FAUCET         | -            | -           | -      | -        | -    | DECK MOUNTED FAUCET, SERVED FROM THE DEIONIZED WATER SYSTEM ONLY        |  |  |
| DW-1                                                                                                                                                                | UNDER COUNTER DISHWASHER       | 1/2"         | -           | -      | -        | -    |                                                                         |  |  |
| REFER TO PLUMBING FIXTURES SCHEDULE AND SPECIFICATIONS FOR ADDITIONAL INFORMATION. VERIFY FINAL EQUIPMENT SELECTION REQUIREMENTS PRIOR TO ROUGH-IN AND CONNECTIONS. |                                |              |             |        |          |      |                                                                         |  |  |

| KITCHEN FIXTURE CONNECTION SCHEDULE                                                                           |                                  |              |      |        |          |      |   |                                                             |
|---------------------------------------------------------------------------------------------------------------|----------------------------------|--------------|------|--------|----------|------|---|-------------------------------------------------------------|
| ITEM                                                                                                          | EQUIPMENT DESCRIPTION            | WATER SUPPLY |      | WASTE  |          | VENT |   | REMARKS                                                     |
|                                                                                                               |                                  | HW           | CW   | DIRECT | INDIRECT |      |   |                                                             |
| KS-1                                                                                                          | SINGLE BOWL STAINLESS STEEL SINK | 1/2"         | 1/2" | 2"     | -        | 2"   | - |                                                             |
| KS-2                                                                                                          | DOUBLE BOWL STAINLESS STEEL SINK | 1/2"         | 1/2" | 2"     | -        | 2"   |   | WITH GARBAGE DISPOSER                                       |
| KS-3                                                                                                          | SINGLE BOWL STAINLESS STEEL      | 1/2"         | 1/2" | 2"     | -        | 2"   |   |                                                             |
| DW-1                                                                                                          | UNDERCOUNTER DISHWASHER          | 3/4"         | -    | -      | -        | -    |   | EXTEND MANUFACTURERS FURNISHED FLEXIBLE HOSE TO FLOOR SINK. |
| IM-1                                                                                                          | UNDERCOUNTER ICE MAKER           | -            | 1/2" | -      | 3/4"     | -    |   | WITH WATER FILTER                                           |
| IM-1                                                                                                          | REFRIGERATOR ICE MAKER           | -            | 1/2" | -      | -        | -    |   | EXTEND DRAIN TO FLOOR SINK                                  |
| <u>NOTES:</u>                                                                                                 |                                  |              |      |        |          |      |   |                                                             |
| 1. REFER TO FOOD SERVICE CONSULTANTS DRAWINGS AND SPECIFICATIONS FOR ROUGH-IN INFORMATION AND EQUIPMENT DATA. |                                  |              |      |        |          |      |   |                                                             |

| WATER HAMMER ARRESTER SCHEDULE                                                                                                                                                                                                                                                                                                                                                                                                                                                                                                                                       |              |              |                 |                     |                            |
|----------------------------------------------------------------------------------------------------------------------------------------------------------------------------------------------------------------------------------------------------------------------------------------------------------------------------------------------------------------------------------------------------------------------------------------------------------------------------------------------------------------------------------------------------------------------|--------------|--------------|-----------------|---------------------|----------------------------|
| ITEM NO.                                                                                                                                                                                                                                                                                                                                                                                                                                                                                                                                                             | MANUFACTURER | MODEL NUMBER | CONNECTION SIZE | FIXTURE UNIT RATING | REMARKS                    |
| "A"                                                                                                                                                                                                                                                                                                                                                                                                                                                                                                                                                                  | J.R. SMITH   | 5005         | 3/4"            | 1-11                | THREADED NIPPLE CONNECTION |
| "B"                                                                                                                                                                                                                                                                                                                                                                                                                                                                                                                                                                  | J.R. SMITH   | 5010         | 1"              | 12-32               | THREADED NIPPLE CONNECTION |
| "C"                                                                                                                                                                                                                                                                                                                                                                                                                                                                                                                                                                  | J.R. SMITH   | 5020         | 1"              | 33-60               | THREADED NIPPLE CONNECTION |
| "D"                                                                                                                                                                                                                                                                                                                                                                                                                                                                                                                                                                  | J.R. SMITH   | 5030         | 1"              | 61-113              | THREADED NIPPLE CONNECTION |
| "E"                                                                                                                                                                                                                                                                                                                                                                                                                                                                                                                                                                  | J.R. SMITH   | 5040         | 1"              | 114-154             | THREADED NIPPLE CONNECTION |
| "F"                                                                                                                                                                                                                                                                                                                                                                                                                                                                                                                                                                  | J.R. SMITH   | 5050         | 1"              | 155-330             | THREADED NIPPLE CONNECTION |
| RULE 1:<br>THE PREFERRED PLACEMENT LOCATION IS AT THE END OF THE BRANCH LINE BETWEEN THE LAST TWO FIXTURES IN A BRANCH LESS THEN 20 FEET.                                                                                                                                                                                                                                                                                                                                                                                                                            |              |              |                 |                     |                            |
|                                                                                                                                                                                                                                                                                                                                                                                                                                                                                   |              |              |                 |                     |                            |
| RULE 2:<br>IN BRANCHES THAT EXCEED 20 FEET IN LENGTH THE SUM OF THE FIXTURE UNIT RATINGS OF UNITS (X) & (Y) SHALL BE EQUAL TO OR GREATER THAN THE DEMAND OF BRANCH.                                                                                                                                                                                                                                                                                                                                                                                                  |              |              |                 |                     |                            |
|                                                                                                                                                                                                                                                                                                                                                                                                                                                                                   |              |              |                 |                     |                            |
| NOTES:<br>A. INSTALL PER MANUFACTURERS INSTRUCTIONS AND RECOMMENDATIONS. PROVIDE WATER HAMMER ARRESTERS AT ALL QUICK CLOSING VALVES.<br>B. ALL ARRESTERS MUST BE INSTALLED IN A VERTICAL (UPRIGHT) POSITION TO INSURE PROPER OPERATION OF THE INTERNAL BELLOW.<br>C. WHEN INSTALLING, PLACE WRENCH ON NIPPLE ONLY. NEVER TIGHTEN BY GRIPPING THE SHELL.<br>D. SHOCK ABSORBERS MUST BE STAINLESS STEEL, PRE-CHARGED AND PERMANENTLY SEALED AT THE FACTORY. ALL SHOCK ABSORBERS SHELL MEET ASSE 1010 AND FDI-WH201 STANDARDS. SIOUX ABSORBERS ARE NOT TO BE INSTALLED. |              |              |                 |                     |                            |

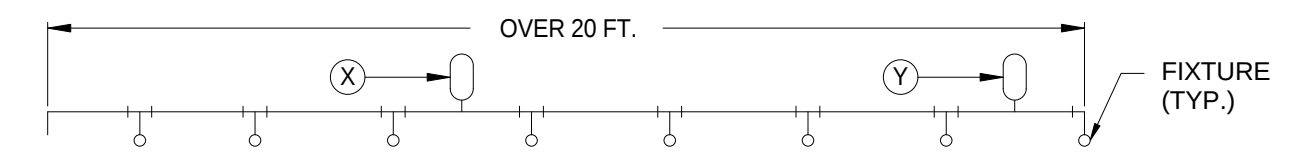

Webster University  
Interdisciplinary Science Building

CANNONDESIGN

1100 Clark Avenue  
St. Louis, Missouri 63102  
T: 314.241.6250  
F: 314.241.2570

William Tao & Associates, Inc  
MEP/FP Engineer  
7955 Manchester Road, Suite 125  
St. Louis, MO 63143  
314-884-7600

David Mason & Associates, Inc  
Structural & Civil Engineer  
800 South Vandeventer Avenue  
St. Louis, MO 63110  
314.534.1053

Faith Group  
Technology  
3101 S. Hanley Rd, Suite 100  
St. Louis, MO 63143  
314.991.2229

Kuhnmann Leavitt, Inc.  
Environmental Graphics & Signage  
7400 Pershing Ave  
St. Louis, MO 63130  
314.725.6616

KWA Architects  
Architecture  
9721 Litzinger Road  
St. Louis, MO 63124  
314.962.2560

Spellman Brady & Company  
Interior Designer  
8251 Mayland Avenue, Suite 300  
St. Louis, MO 63105  
314.862.0070

SWT Design  
Landscape Architect  
7722 Big Bend Blvd  
St. Louis, MO 63119  
314.644.5700

Webb Engineering Services, Inc.  
Plumbing & Fire Protection  
1400 S. 3rd Street, Suite 201  
St. Louis, MO 63104  
314.588.0600

## DOMESTIC GAS FIRED HOT WATER HEATER SCHEDULE

| PLAN<br>MARK                                 | MANUFACTURER | MODEL NUMBER     | LOCATION   | FUEL        | INPUT<br>(BTU/H) | REQ'D. GAS PRESSURE |             | THERMAL<br>EFFICIENCY | STORAGE<br>CAPACITY/GALS. | RECOVERY<br>RATE GALS. @100' | PIPING CONNECTIONS |        |      | VENT,<br>INCHES | ASME<br>RATED<br>TANK | WORKING<br>PRESSURE<br>LBS. | ASME<br>T&P<br>VALVE | OPERATING<br>VOLTAGE | SHIPPING<br>WEIGHT,<br>LBS. | REMARKS |
|----------------------------------------------|--------------|------------------|------------|-------------|------------------|---------------------|-------------|-----------------------|---------------------------|------------------------------|--------------------|--------|------|-----------------|-----------------------|-----------------------------|----------------------|----------------------|-----------------------------|---------|
|                                              |              |                  |            |             |                  | MIN. " W.C.         | MAX. " W.C. |                       |                           |                              | WATER              |        | GAS  |                 |                       |                             |                      |                      |                             |         |
|                                              |              |                  |            |             |                  |                     |             |                       |                           |                              | INLET              | OUTLET |      |                 |                       |                             |                      |                      |                             |         |
| DWH-1                                        | RHEEM        | GHE 100ES-400(A) | MECH. ROOM | NATURAL GAS | 400,000          | 5.3                 | 10.5        | 94%                   | 100                       | 445                          | 2"                 | 2"     | 3/4" | XX              | YES                   | 160                         | YES                  | 120                  | 835                         | -       |
| DWH-2                                        | RHEEM        | GHE 100ES-400(A) | MECH. ROOM | NATURAL GAS | 400,000          | 5.3                 | 10.5        | 94%                   | 100                       | 445                          | 2"                 | 2"     | 3/4" | XX              | YES                   | 160                         | YES                  | 120                  | 835                         | -       |
| DWH-2                                        | RHEEM        | GHE 100ES-400(A) | MECH. ROOM | NATURAL GAS | 400,000          | 5.3                 | 10.5        | 94%                   | 100                       | 445                          | 2"                 | 2"     | 3/4" | XX              | YES                   | 160                         | YES                  | 120                  | 835                         | -       |
| NOTES:                                       |              |                  | 1. SET ON 4" HIGH CONCRETE HOUSEKEEPING PAD. |              |                  
## DOMESTIC WATER BACKFLOW PREVENTER SCHEDULE

| PLAN MARK                                                                                                                                                                                                                                         | MANUFACTURER    | SERIES | MODEL NUMBER       | LOCATION         | USE              | TYPE/STYLE | SIZE   | SHUT-OFF/SERVICE VALVES | MAXIMUM WORKING PRESSURE, PSI | WATER PIPING CONNECTIONS, INCHES |          | LEAD FREE | STRAINER | AIR GAP FITTING | DRAIN SIZE | SHIPPING WEIGHT, LBS. | REMARKS           |
|---------------------------------------------------------------------------------------------------------------------------------------------------------------------------------------------------------------------------------------------------|-----------------|--------|--------------------|------------------|------------------|------------|--------|-------------------------|-------------------------------|----------------------------------|----------|-----------|----------|-----------------|------------|-----------------------|-------------------|
|                                                                                                                                                                                                                                                   |                 |        |                    |                  |                  |            |        |                         |                               | INLET                            | OUTLET   |           |          |                 |            |                       |                   |
| BF-P-1                                                                                                                                                                                                                                            | WATTS REGULATOR | LF909  | LF909-QT-FAD-NRS-S | MECH. ROOM       | DOMESTIC SERVICE | RPZA       | 4"     | NON-RISING STEM         | 175                           | FLANGED                          | FLANGED  | YES       | YES      | 909AG-K         | 3" IPS     | 418                   | NOTE 1 AND NOTE 2 |
| BF-P-2                                                                                                                                                                                                                                            | WATTS REGULATOR | LF909  | LF909-QT-S         | LEVEL 3 (RM 375) | MAKE-UP WATER    | RPZA       | 3/4"   | QUARTER TURN BALL       | 175                           | THREADED                         | THREADED | YES       | YES      | 909AG-C         | 1" IPS     | 18.0                  | NOTE 2 AND NOTE 3 |
| BF-P-3                                                                                                                                                                                                                                            | WATTS REGULATOR | LF909  | LF909-QT-S         | LEVEL 0          | DEIONIZED WATER  | RPZA       | 1"     | QUARTER TURN BALL       | 175                           | THREADED                         | THREADED | YES       | YES      | 909AG-C         | 1" IPS     | 19.0                  | NOTE 2 AND NOTE 3 |
| BF-P-4                                                                                                                                                                                                                                            | WATTS REGULATOR | LF909  | LF909-QT-S         | LEVEL 0          | MAKE-UP WATER    | RPZA       | 1-1/4" | QUARTER TURN BALL       | 175                           | THREADED                         | THREADED | YES       | YES      | 909AG-F         | 2" IPS     | 46.0                  | NOTE 2 AND NOTE 3 |
| NOTES:<br>1. SET ON 4" HIGH CONCRETE HOUSEKEEPING PAD - PROVIDE PIPE STANDS AS REQUIRED TO SUPPORT ASSEMBLY.<br>2. EXTEND DISCHARGE PIPE TO RECEPTOR - TERMINATE WITH AIR-GAP.<br>3. SUPPORT ASSEMBLY FROM STRUCTURE, DO NOT SUPPORT FROM PIPING. |                 |        |                    |                  |                  |            |        |                         |                               |                                  |          |           |          |                 |            |                       |                   |

## LABORATORY CENTRAL AIR COMPRESSOR

| PLAN MARK                                                                                                                                                                                                        | MANUFACTURER  | SYSTEM MODEL NUMBER | LOCATION   | USE        | HP        | SYSTEM CAPACITY 145 PSIG | SYSTEM BTU/Hr | RECEIVER GALLONS | NOISE LEVEL db (A) | ELECTRICAL DATA |       |      | SYSTEM WEIGHT LBS. | DIMSIONS (INCHES) |       |      | REMARKS   |
|------------------------------------------------------------------------------------------------------------------------------------------------------------------------------------------------------------------|---------------|---------------------|------------|------------|-----------|--------------------------|---------------|------------------|--------------------|-----------------|-------|------|--------------------|-------------------|-------|------|-----------|
|                                                                                                                                                                                                                  |               |                     |            |            |           |                          |               |                  |                    | VOLTS           | PHASE | FLA  |                    | LENGTH            | WIDTH | HGT. |           |
| AC-1                                                                                                                                                                                                             | BEACON MEDAES | LA507T-120V-T       | MECH. ROOM | LABORATORY | (3) @ 7.5 | 51.0                     | 51,536        | 120              | 77                 | 480             | 3     | 30.9 | 1997               | 62.00             | 66.00 | 81.9 | SEE NOTES |
| NOTES:<br>1. SET UNIT ON 4" HIGH CONCRETE HOUSEKEEPING PAD.<br>2. REFER TO SPECIFICATION SECTION 226113 - 'COMPRESSED-AIR EQUIPMENT FOR LABORATORY FACILITIES'.<br>3. EXTEND COPPER DRAIN FULL SIZE TO RECEPTOR. |               |                     |            |            |           |                          |               |                  |                    |                 |       |      |                    |                   |       |      |           |

## LABORATORY CENTRAL VACUUM

| PLAN MARK                                                                                                                                                                                                                                                          | MANUFACTURER  | SYSTEM MODEL NUMBER | LOCATION   | USE        | HP      | NOMINAL PUMPING SPEED (ACFM/PUMP) | CAPACITY 20" Hg (SCFM/SYSTEM) | CAPACITY 25" Hg (SCFM/SYSTEM) | END PRESSURE "Hg (TORR) | NOISE LEVEL db (A) | RECEIVER GALLONS | ELECTRICAL DATA |       |      | DIMSIONS (INCHES) |       |       | CONNECTIONS (INCHES) |               |                  |                 | SYSTEM WEIGHT LBS. | REMARKS   |
|--------------------------------------------------------------------------------------------------------------------------------------------------------------------------------------------------------------------------------------------------------------------|---------------|---------------------|------------|------------|---------|-----------------------------------|-------------------------------|-------------------------------|-------------------------|--------------------|------------------|-----------------|-------|------|-------------------|-------|-------|----------------------|---------------|------------------|-----------------|--------------------|-----------|
|                                                                                                                                                                                                                                                                    |               |                     |            |            |         |                                   |                               |                               |                         |                    |                  | VOLTS           | PHASE | FLA  | LENGTH            | WIDTH | HGT.  | INLET (FNPT)         | OUTLET (FNPT) | TANK DRAIN (NPT) | AIR CONN. (NPT) |                    |           |
| VU-1                                                                                                                                                                                                                                                               | BEACON MEDAES | LVHT04D-200H-D      | MECH. ROOM | LABORATORY | (2) @ 5 | 79.0                              | 52.0                          | 26.6                          | 28.4                    | 79                 | 200              | 480             | 3     | 14.5 | 73.00             | 45.5  | 67.00 | 1.50                 | 2.00          | 1/4              | 1/4             | 1809               | SEE NOTES |
| NOTES:<br>1. SET UNIT ON 4" HIGH CONCRETE HOUSEKEEPING PAD.<br>2. REFER TO SPECIFICATION SECTION 226219 - 'VACUUM EQUIPMENT FOR LABORATORY FACILITIES'.<br>3. EXTEND COPPER DRAIN FULL SIZE TO RECEPTOR.<br>4. PROVIDE MUFFLER AS RECOMMENDED BY THE MANUFACTURER. |               |                     
|     |                               |             |
|-----|-------------------------------|-------------|
| 1   | ADDENDUM 2-1                  | 17 MAR 2016 |
| -   | ISSUED FOR CONSTRUCTION (BP2) | 01 MAR 2016 |
| No. | Description                   | Date        |

Drawing Title:

SCHEDULES - PLUMBING

Project No.: 04561.01      Checked by:

P0602