


GRADE BEAM NOTES

1. PROVIDE STANDARD HOOKS FOR TOP & BOTTOM BARS AS INDICATED AT SUPPORTS
2. PROVIDE CORNER BARS AT INTERSECTING GRADE BEAMS.

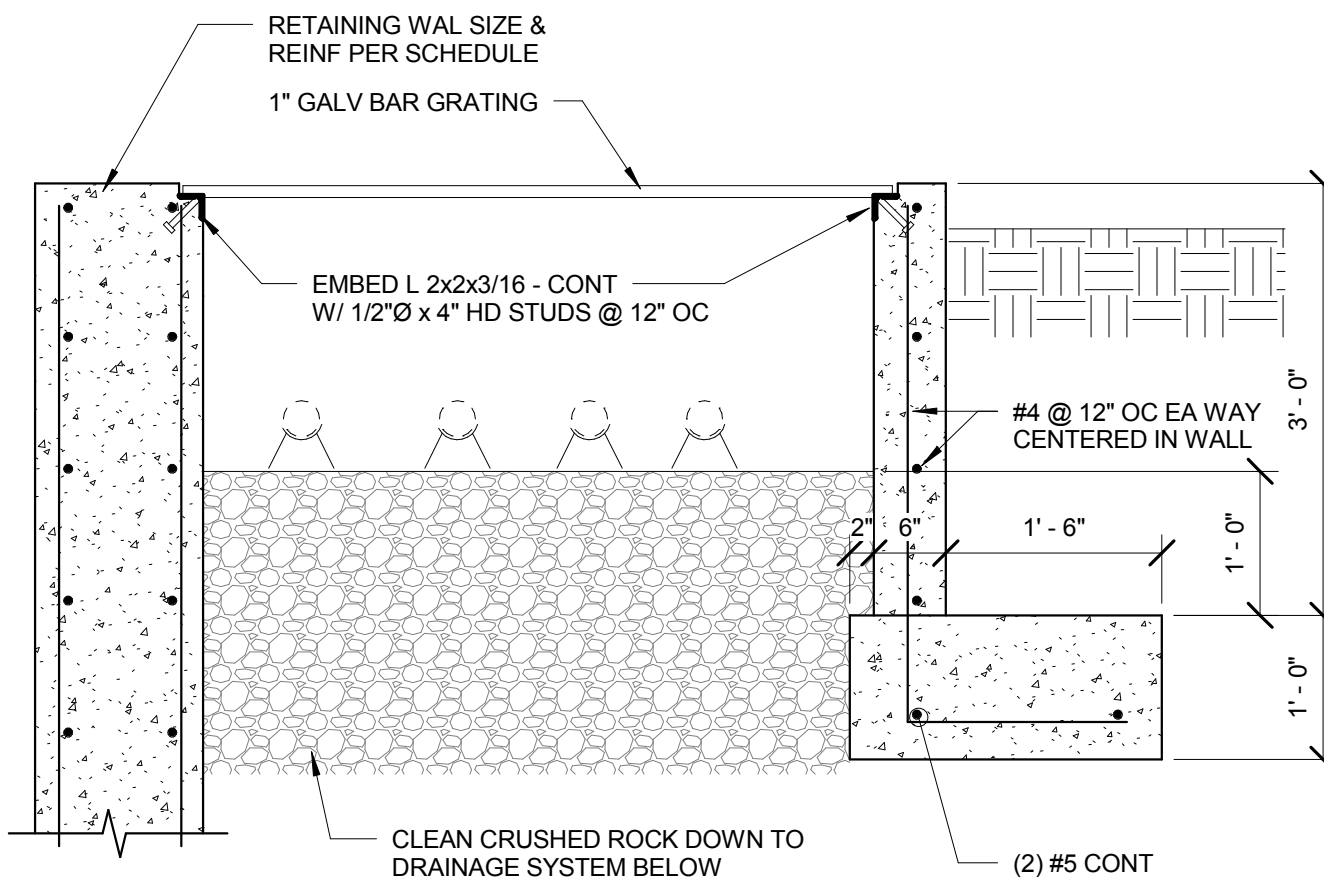

2

ESTIMATED BOTTOM OF DRILLED PIER ELEVATIONS – FOR BIDDING PURPOSES ONLY

ESTIMATED BOTTOM OF DRILLED PIER ELEVATIONS – FOR BIDDING PURPOSES ONLY

LEVEL 0 DRILLED PIERS LOCATED ON AND NORTH OF GRID C.3 = 518'-0"

LEVEL 0 DRILLED PIERS LOCATED SOUTH OF GRID C.3 = 515'-0"
LEVEL 1 DRILLED PIERS LOCATED NORTH OF GRID E = 517'-0"

LEVEL 1 DRILLED PIERS LOCATED ON GRIDS A.6 & B = 522'-0"
LEVEL 1 DRILLED PIERS LOCATED FROM GRID V TO Z ON GRID 3= 508'-0"

LEVEL 1 DRILLED PIERS LOCATED FROM GRID V TO Z ON GRID 4.5 = 521'-0"
LEVEL 1 DRILLED PIERS LOCATED IN WEST WING = 517'-0"

LEVEL 1 BREEDERS PER EGGSORTED IN WEST WING 5/11/0

