



- LEVEL 01 FOUNDATION PLAN NOTES:**
1. SLAB-ON-GRADE CONSTRUCTION: 4" SLAB-ON-GRADE w/6x6 W2.9xW2.9 W.W.F. OVER 2" COMPACTED GRANULAR FILL (1/2" MINUS) AND 4" COMPACTED GRANULAR FILL (6" TOTAL GRANULAR FILL) OVER 15 MIL VAPOR RETARDER, SEE TYPICAL DETAIL ON SHEET S0002.
 2. FOR GENERAL NOTES AND TYPICAL DETAILS, SEE SHEETS S0001 THRU S0003.
 3. FINISHED FLOOR ELEVATION = 86'-0", U.N.O..
 4. JOINT FILLER SHALL BE PLACED IN CLEAN JOINTS, OVERFILLED AND SHAVED FLUSH.
 5. ALL FOOTINGS TO BE CENTERED UNDER WALLS AND/OR COLUMNS, UNLESS NOTED OTHERWISE.
 6. PROVIDE CONTROL JOINT (C.J.) IN SLAB-ON-GRADE AT 15'-0" O.C. (MAXIMUM) IN EACH DIRECTION.
 7. TOP OF INTERIOR COLUMN FOOTINGS = 85'-0", U.N.O..

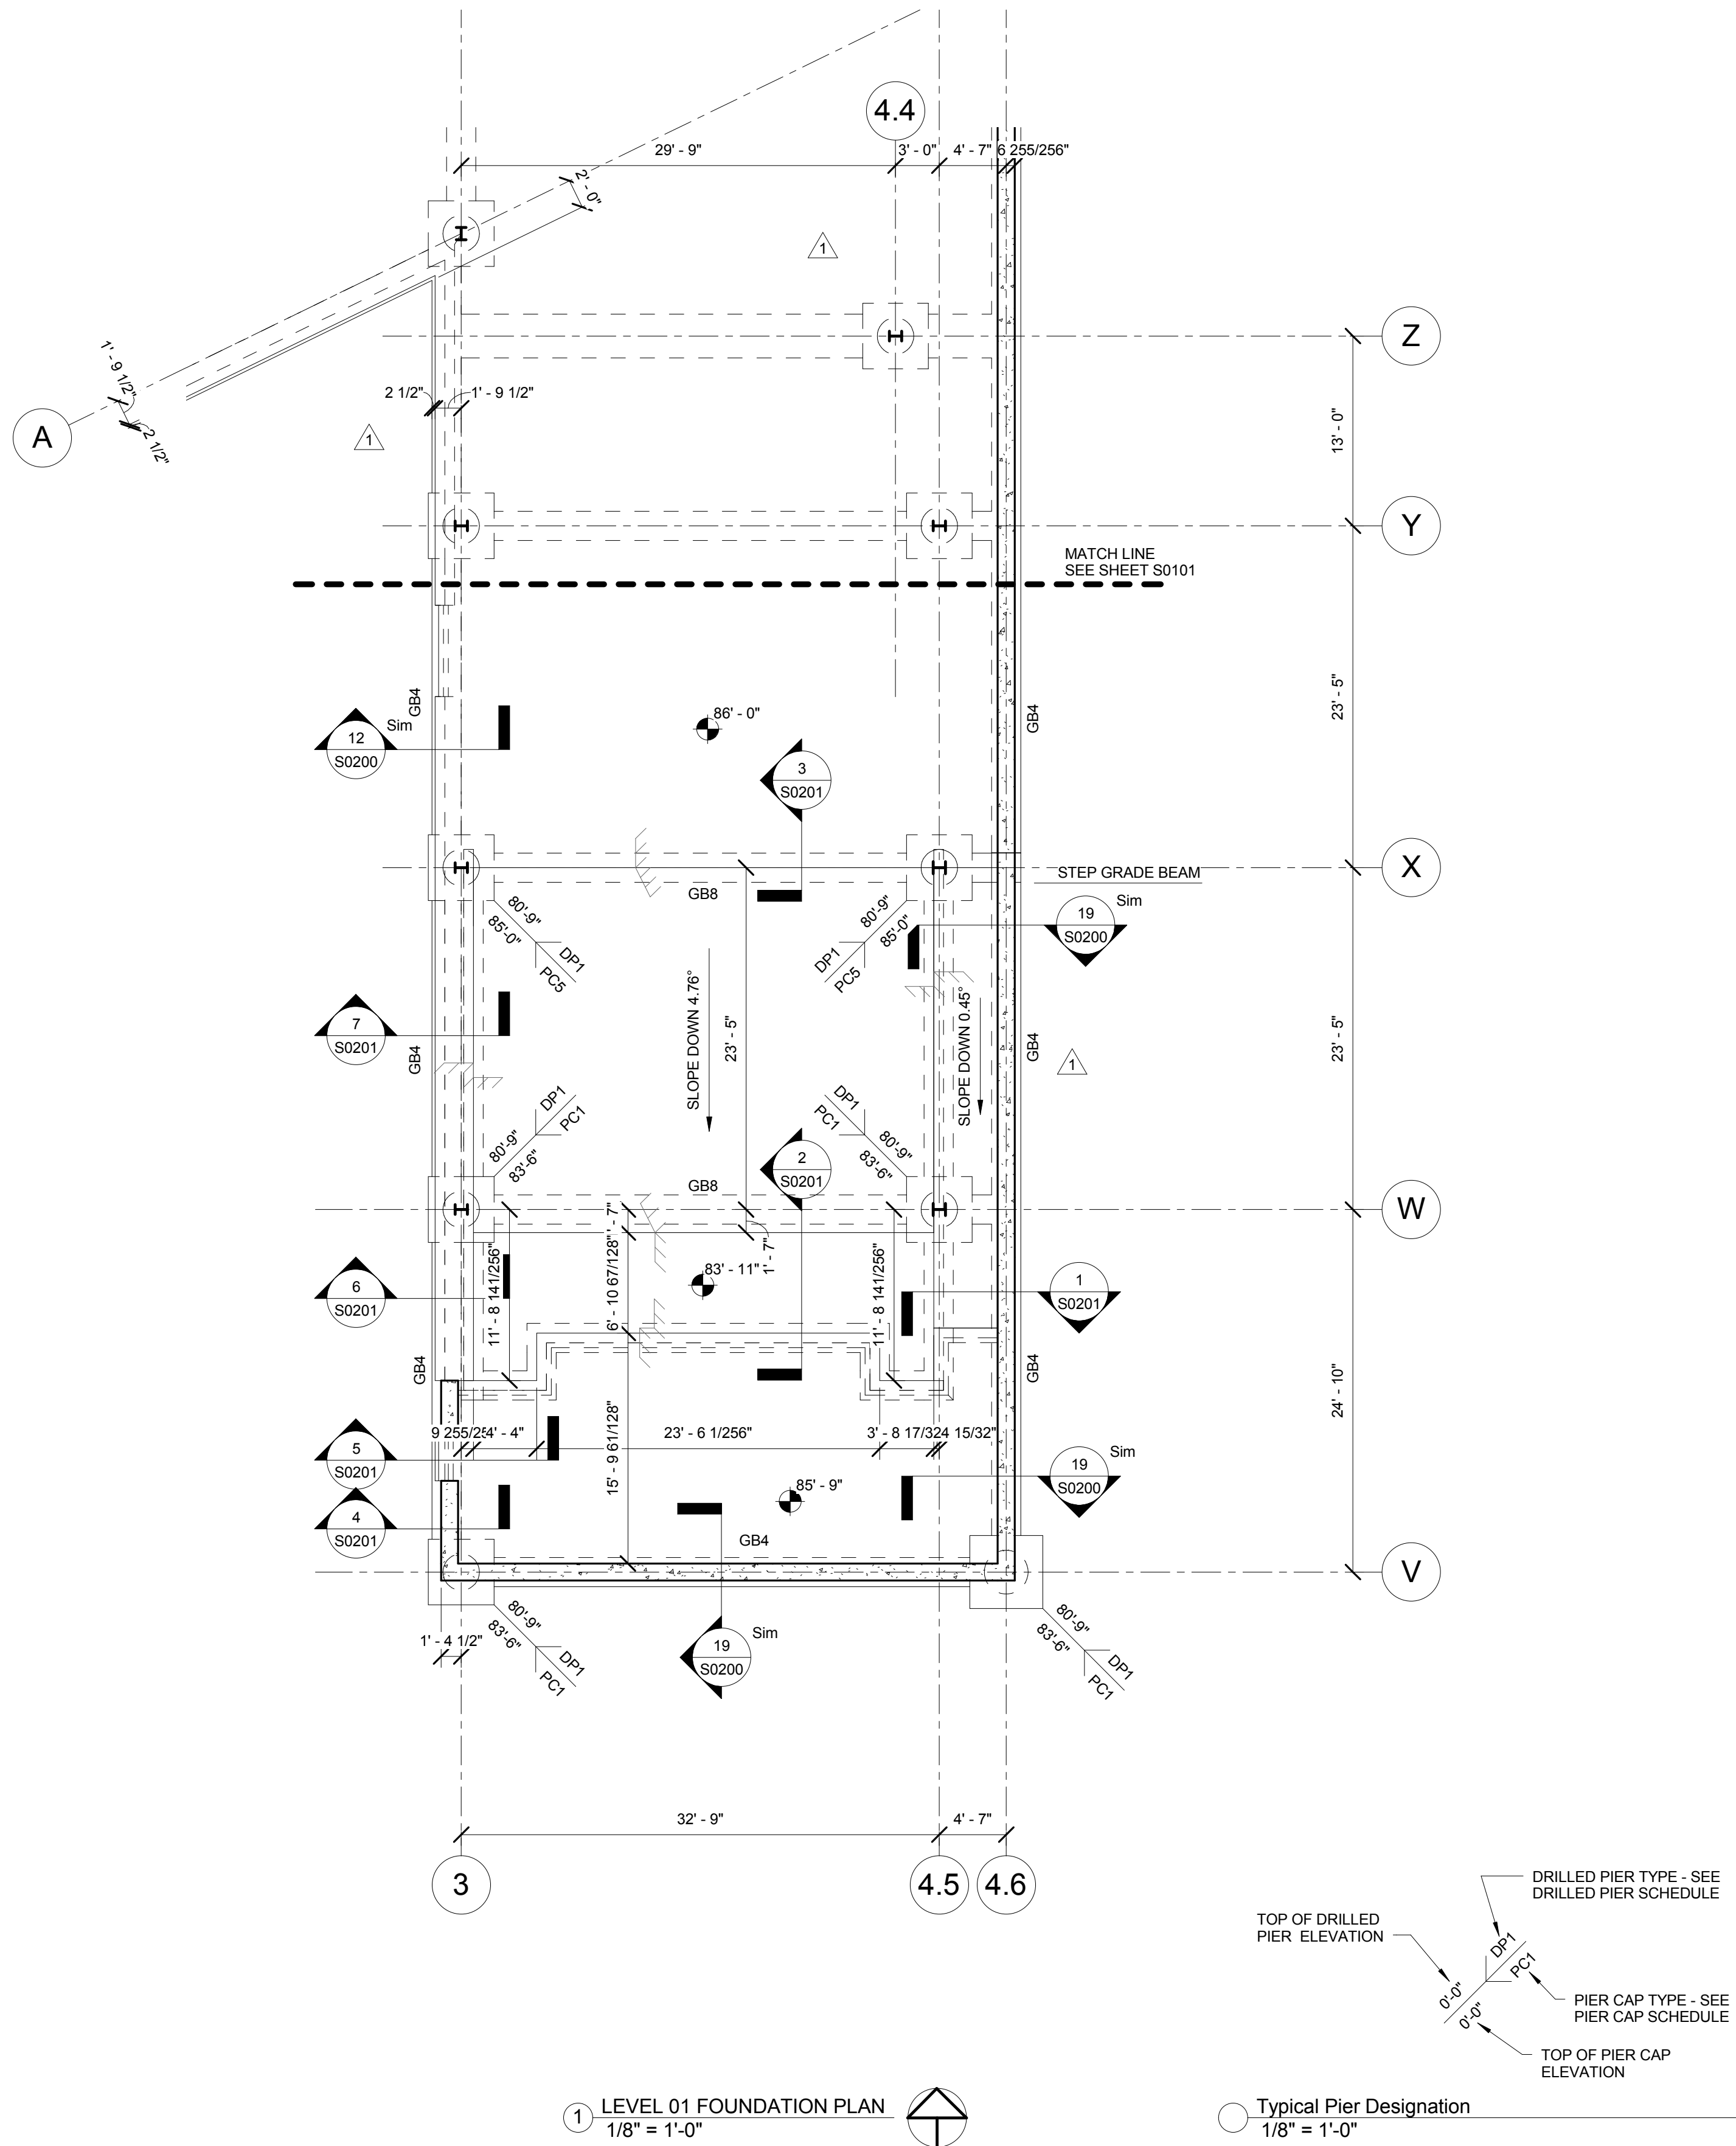

- LEVEL 02 FLOOR FRAMING PLAN NOTES:**
1. FLOOR CONSTRUCTION: 4 1/2" NORMAL WEIGHT CONCRETE SLAB REINFORCED WITH 6x6, W2.9xW2.9 W.W.F. ON 2"x18 GA. GALVANIZED (G90 AT GREEN ROOF AND PAVES SYSTEMS) COMPOSITE METAL DECK BY VULCRAFT OR ENGINEER APPROVED EQUAL WITH THE FOLLOWING MINIMUM PROPERTIES: 1 + 0.558 in./ft. Sp = 0.485 in./ft. fy = 50 ksi. Sn = 0.504 in./ft. LOCATE W.W.F. 1" CLEAR FROM TOP OF CONCRETE. WELD COMPOSITE METAL DECK TO ALL INTERIOR SUPPORTING STEEL. EDGE RIBS OF PANELS AT EACH SUPPORT AND ALONG ALL SUPPORTING PERIMETER EDGE AND SLAB EDGE STEEL WITH 5/8" DIAMETER PUDDLE WELDS @ 12" O.C. MAXIMUM. PROVIDE #10 TEK SCREW SIDE LAP CONNECTIONS AT 36" O.C. MAXIMUM BETWEEN SUPPORTS. (TOTAL SLAB THICKNESS = 6 1/2").
 2. FOR GENERAL NOTES AND TYPICAL DETAILS, SEE SHEETS S0001 THRU S0003.
 3. FOR COLUMN SCHEDULE, SEE SHEETS S0500 THRU S0502.
 4. COORDINATE ALL FLOOR OPENINGS WITH MECHANICAL DRAWINGS.
 5. FINISHED FLOOR ELEVATION = 100'-0", U.N.O..
 6. TOP OF STRUCTURAL STEEL ELEVATION = 99'-5 1/2", U.N.O..
 7. TOP OF STRUCTURAL STEEL ELEVATION = BOTTOM OF METAL DECK ELEVATION, UNLESS NOTED THUS (XX") ON PLAN REFERENCED FROM BOTTOM OF METAL DECK ELEVATION.
 8. FOR COMPOSITE BEAM NOTES AND TYPICAL COMPOSITE BEAM DETAILS, SEE SHEETS S0002 THRU S0003.

DESIGN FLOOR LOADS
SEE SHEET S0103 FOR DESIGN LOADS.

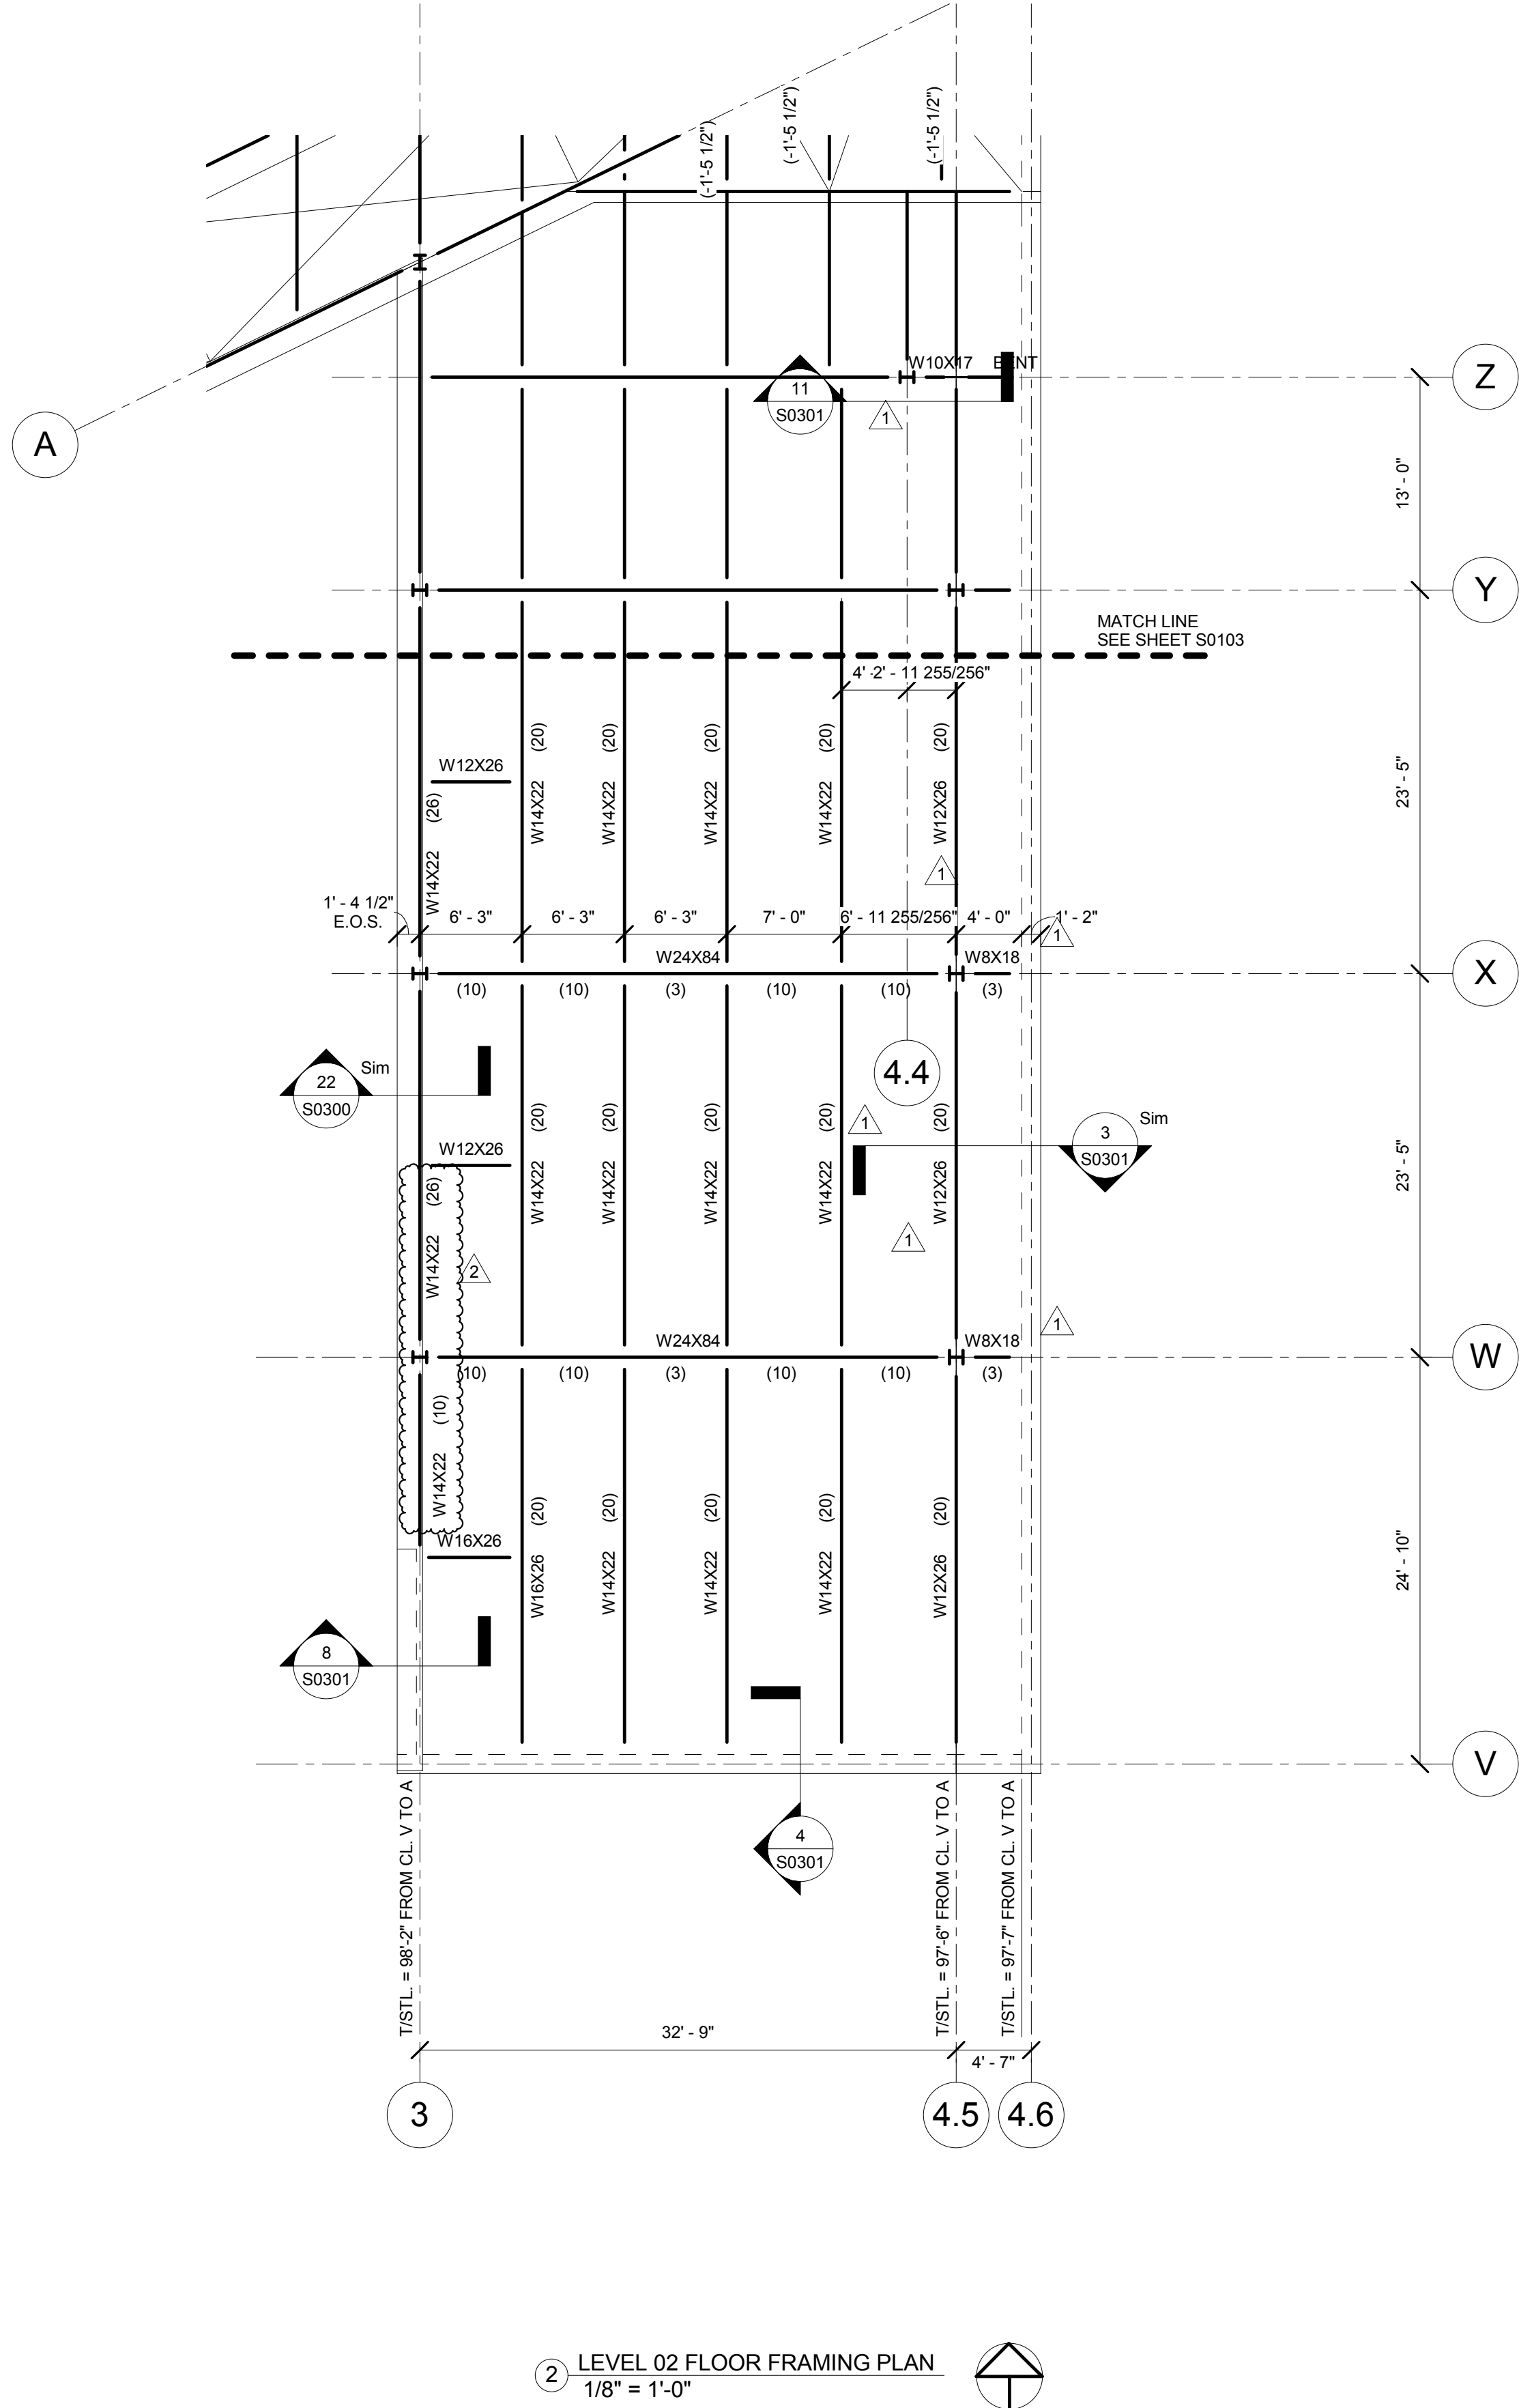

1100 Clark Avenue
St. Louis, Missouri 63102
T: 314.241.6250
F: 314.241.2570

William Tao & Associates, Inc.
ME/PE/PP Engineer
7955 Manchester Road, Suite 125
St. Louis, MO 63143
314-884-7600

David Mason & Associates, Inc.
Structural & Civil Engineer
800 South Vandeventer Avenue
St. Louis, MO 63110
314.534.1053

Faith Group
Technology
3101 S. Hanley Rd., Suite 100
St. Louis, MO 63143
314.591.2229

Kuhmann Leavitt, Inc.
Environmental Graphics & Signage
7400 Pershing Ave.
St. Louis, MO 63130
314.725.6616

KWA Architects
Architecture
9721 Litzinger Road
St. Louis, MO 63124
314.962.2560

Spellman Brady & Company
Interior Designer
8251 Maryland Avenue, Suite 300
St. Louis, MO 63105
314.862.0070

SWT Design
Landscape Architect
7722 Big Bend Blvd.
St. Louis, MO 63119
314.644.5700

Webb Engineering Services, Inc.
Interior Designer
1400 S. 3rd Street, Suite 201
St. Louis, MO 63104
314.588.0600

2	ADDENDUM 1-11	13 MAY 2016
1	ADDENDUM 1-1	29 JAN 2016
-	ISSUED FOR CONSTRUCTION (BP1)	15 JAN 2016
No.	Description	Date

Drawing Title:

LEVEL 01 FOUNDATION
PLAN AND LEVEL 02
FLOOR FRAMING PLAN

Project No.: 04561.01 Checked by:

S0102