

LEVEL 02 FLOOR FRAMING PLAN NOTES:
1. FLOOR CONSTRUCTION: 4 1/2" NORMAL WEIGHT CONCRETE SLAB REINFORCED WITH 6#6, W2.9W2.9 W.F. ON 2'x18 GA. GALVANIZED (G90 AT GREEN ROOF AND PAVER SYSTEMS) COMPOSITE METAL DECK BY VULCRAFT OR ENGINEER APPROVED EQUAL WITH THE FOLLOWING MINIMUM PROPERTIES: $f_y = 0.55 f_{yHSL}$, $f_u = 0.46 f_{uHSL}$, $P_y = 50$ ksi, $S_x = 0.054$ IN⁴/IN² LOCATE W.W.F. 1" CLEAR FROM TOP OF CONCRETE. WELD COMPOSITE METAL DECK TO ALL INTERIOR SUPPORTING STEEL EDGE RISBS OF PANELS AT EACH SUPPORT AND ALONG ALL SUPPORTING PERIMETER EDGE AND SLAB EDGE STEEL WITH 6#8 DIAMETER FUDGE WELDS @ 12" O.C. MAXIMUM. PROVIDE #10 TEK SCREW SIDE LAP CONNECTIONS AT 36" O.C. MAXIMUM BETWEEN SUPPORTS. (TOTAL SLAB THICKNESS = 6 1/2").
2. FOR GENERAL NOTES AND TYPICAL DETAILS, SEE SHEETS S0001 THRU S0003.
3. FOR COLUMN SCHEDULE, SEE SHEETS S0500 THRU S0502.
4. COORDINATE ALL FLOOR OPENINGS WITH MECHANICAL DRAWINGS.
5. FINISHED FLOOR ELEVATION = 100'-0", U.N.O.
6. TOP OF STRUCTURAL STEEL ELEVATION = 99'-5 1/2", U.N.O.
7. TOP OF STRUCTURAL STEEL ELEVATION = BOTTOM OF METAL DECK ELEVATION, UNLESS NOTED THUS (-XX") ON PLAN REFERENCED FROM BOTTOM OF METAL DECK ELEVATION.
8. FOR COMPOSITE BEAM NOTES AND TYPICAL COMPOSITE BEAM DETAILS, SEE SHEETS S0002 THRU S0003.

DESIGN FLOOR LOADS:

FLOOR DEAD LOAD:
4 1/2" NORMAL WEIGHT CONCRETE SLAB ON COMPOSITE DECK (6 1/2" TOTAL THICKNESS) 67 PSF
2" COMPOSITE METAL DECK 2 PSF
CONCRETE OVERRUN ALLOWANCE 5 PSF
MISCELLANEOUS FRAMING 5 PSF
MECHANICAL/ELECTRICAL/PLUMBING/FP ALLOWANCE 8 PSF
CEILING SYSTEM ALLOWANCE 2 PSF
TOTAL DEAD LOAD 89 PSF + STEEL FRAMING WT.

* DEAD LOAD IS INCREASED BY 32 PSF IN AREA AT ENTRIES WHERE CONCRETE PAVERS OCCUR.

LIVE LOAD:

TYPICAL FLOOR 100 PSF
CORRIDOR AT ENTRY LEVELS 80 PSF
STORAGE @ SOUTHEAST CORNER 125 PSF


GREEN ROOF DEAD LOAD:

GREEN ROOF SYSTEM 82 PSF
4 1/2" NORMAL WEIGHT CONCRETE SLAB ON COMPOSITE DECK (6 1/2" TOTAL THICKNESS) 67 PSF
2" COMPOSITE METAL DECK 2 PSF
CONCRETE OVERRUN ALLOWANCE 5 PSF
MISCELLANEOUS FRAMING 3 PSF
MECHANICAL/ELECTRICAL/PLUMBING/FP ALLOWANCE 8 PSF
CEILING SYSTEM ALLOWANCE 2 PSF
TOTAL DEAD LOAD 169 PSF + STEEL FRAMING WT.

GREEN ROOF LIVE LOAD:

ASSEMBLY 100 PSF

2. PARTIAL FOUNDATION ELEVATION ALONG GRID C.3
1/8" = 1'-0"

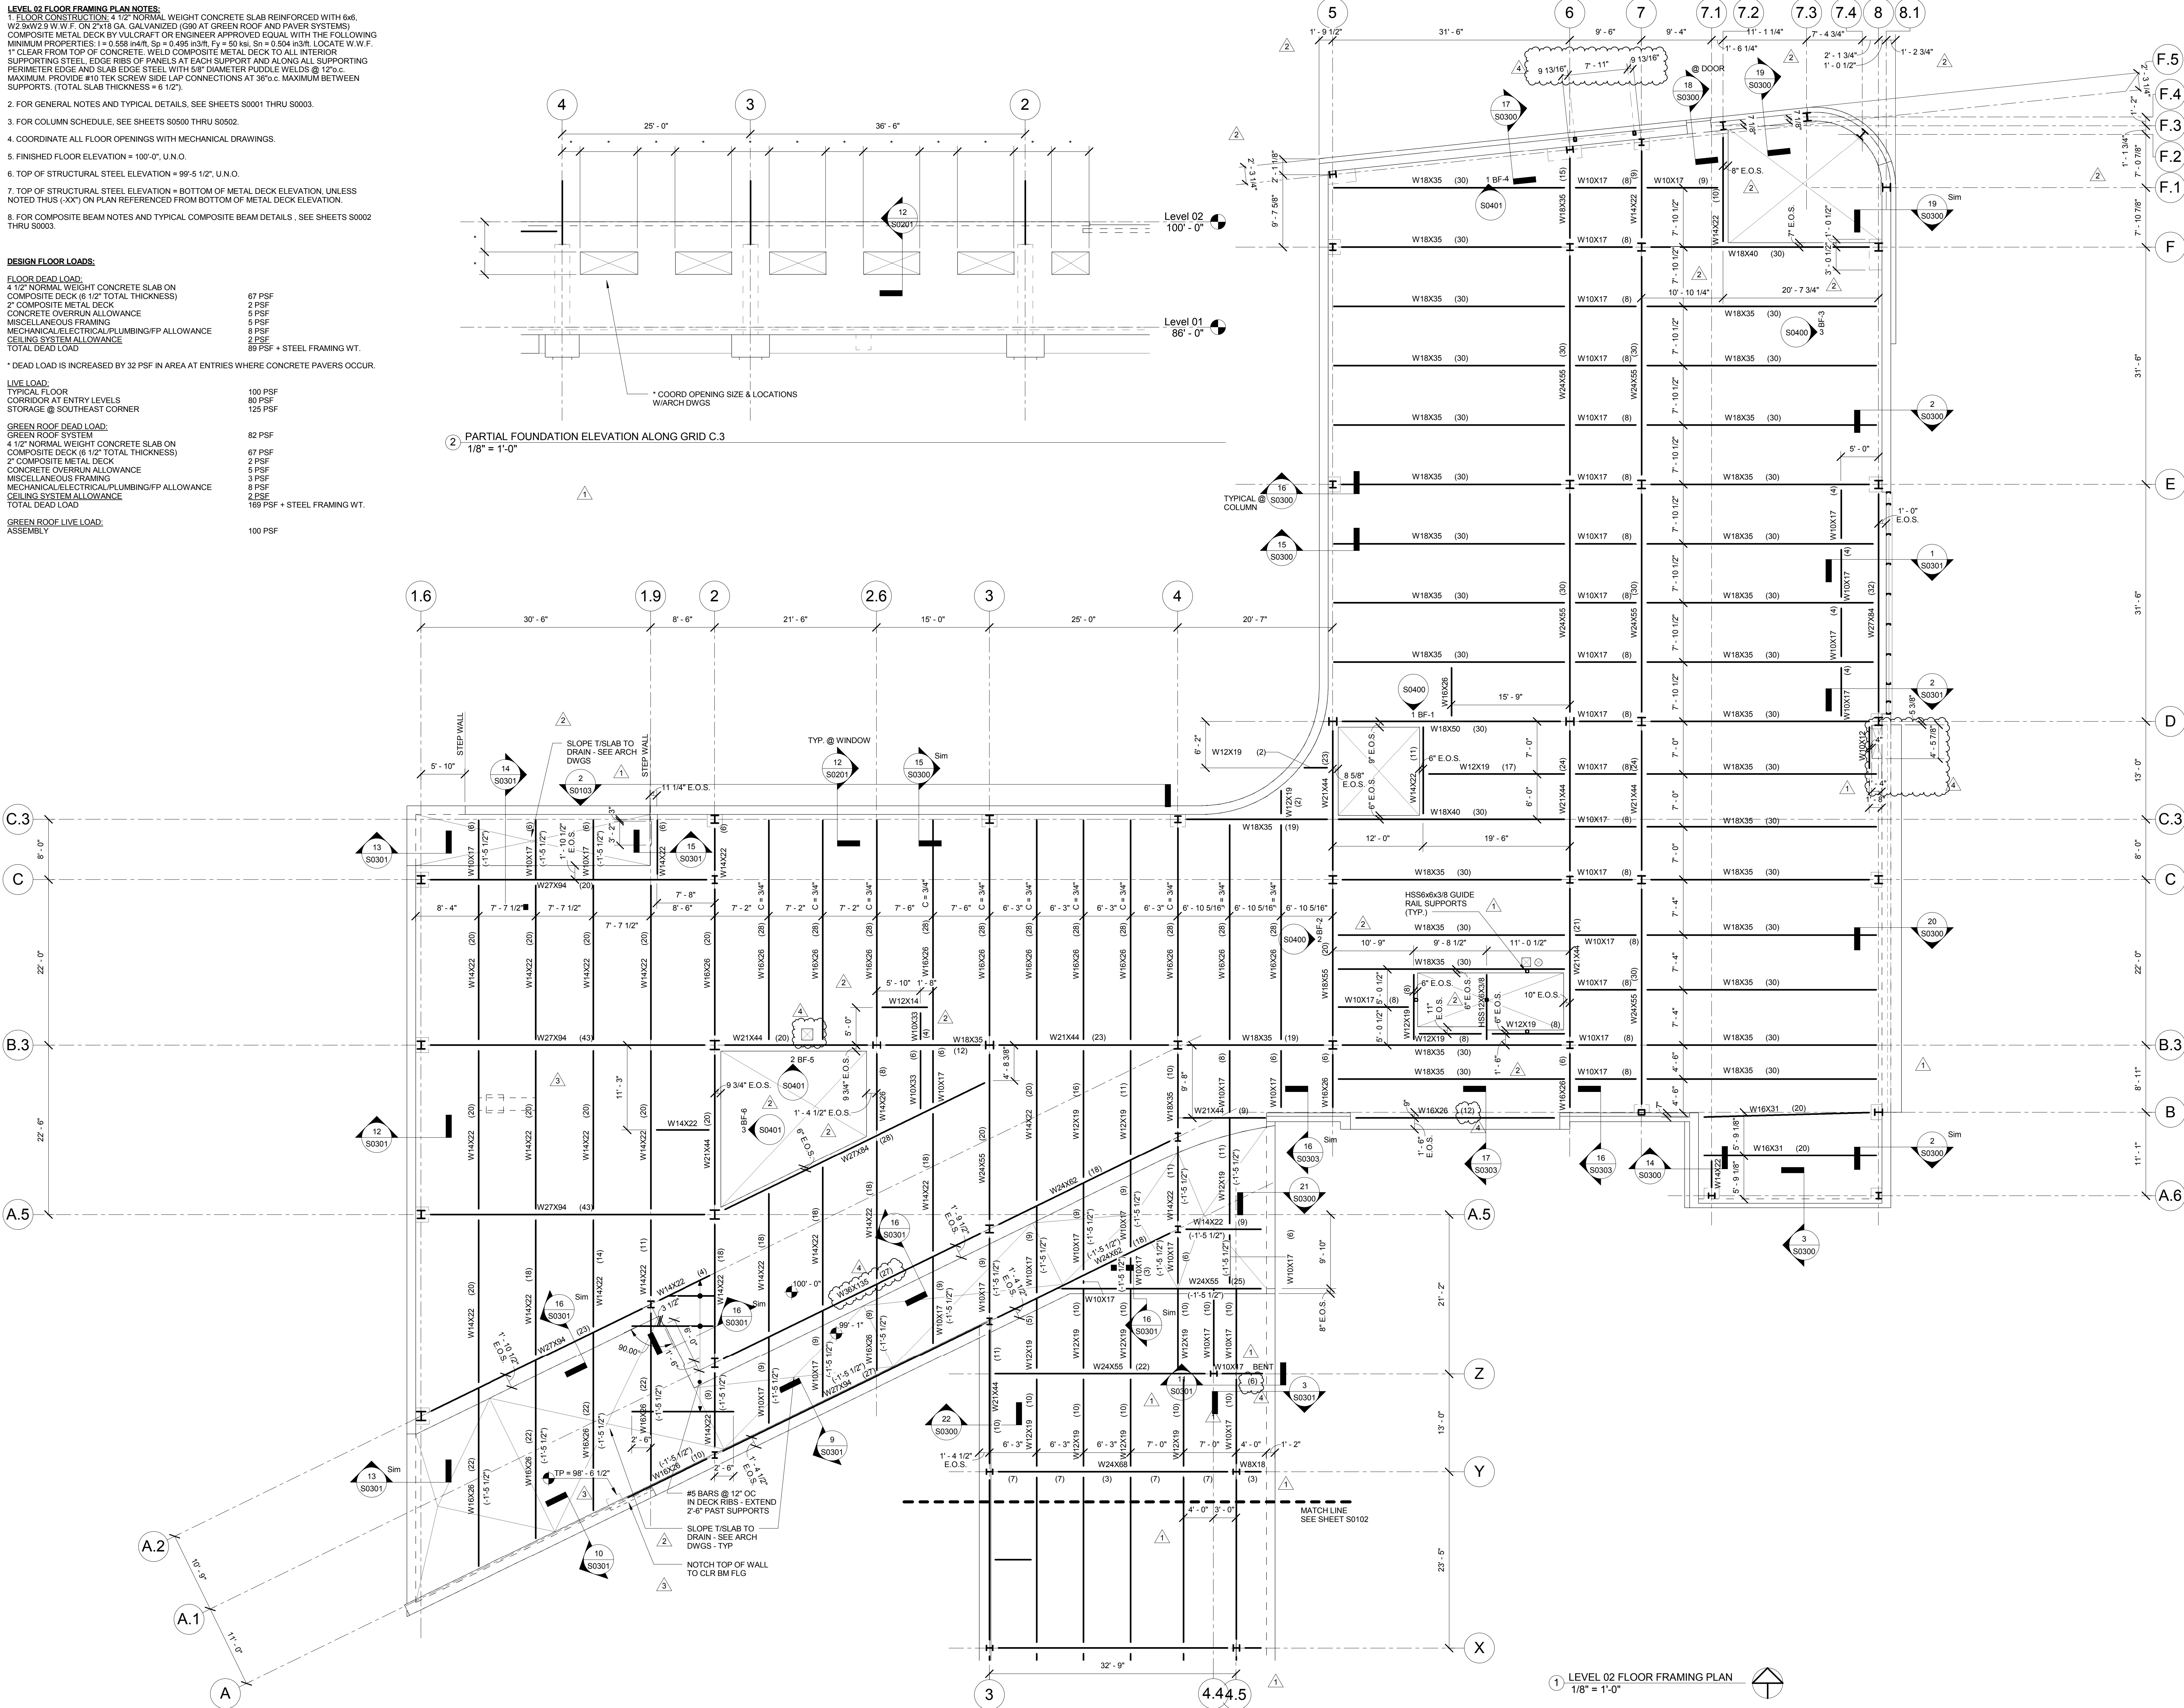

Webster University
Interdisciplinary Science Building

CANNONDESIGN

1100 Clark Avenue
St. Louis, Missouri 63102
T: 314.241.6250
F: 314.241.2570

William Tao & Associates, Inc.
MERFP Engineer
7955 Manchester Road, Suite 125
St. Louis, MO 63143
314.884.7600

David Mason & Associates, Inc.
Structural & Civil Engineer
800 South Vandeventer Avenue
St. Louis, MO 63110
314.534.1053

Faith Group
Technology
3101 S. Hanley Rd., Suite 100
St. Louis, MO 63143
314.591.2223

Kuhnmann Leavitt, Inc.
Environmental Graphics & Signage
7400 Pershing Ave.
St. Louis, MO 63130
314.725.6616

KWA Architects
Architecture
9721 Litzinger Road
St. Louis, MO 63124
314.962.2560

Spellman Brady & Company
Interior Designer
8251 Maryland Avenue, Suite 300
St. Louis, MO 63105
314.862.0070

SWT Design
Landscape Architect
7722 Big Bend Blvd.
St. Louis, MO 63119
314.644.5700

Webb Engineering Services, Inc.
Planning & Fire Protection
1400 S. 3rd Street, Suite 201
St. Louis, MO 63104
314.588.0600

4	ASI 018	19 AUG 2016
3	ADDENDUM 1-11	13 MAY 2016
2	ADDENDUM 1-17	16 MAR 2016
1	ADDENDUM 1-1	29 JAN 2016
ISSUED FOR CONSTRUCTION (BPT)		15 JAN 2016
No.	Description	Date

Drawing Title:

**LEVEL 02 FLOOR
FRAMING PLAN**

Project No.: 04561.01 Checked by:

S0103