

5	ASI 018	19 AUG 2016
4	ADDENDUM 1-11	13 MAY 2016
3	ADDENDUM 1-17	16 MAR 2016
2	ADDENDUM 1-12	01 FEB 2016
1	ADDENDUM 1-1	29 JAN 2016
	ISSUED FOR CONSTRUCTION (BPT)	15 JAN 2016
No.	Description	Date


Drawing Title:

LEVEL 03 FLOOR
FRAMING PLAN

Project No.: 04561.01

Checked by:

S0104

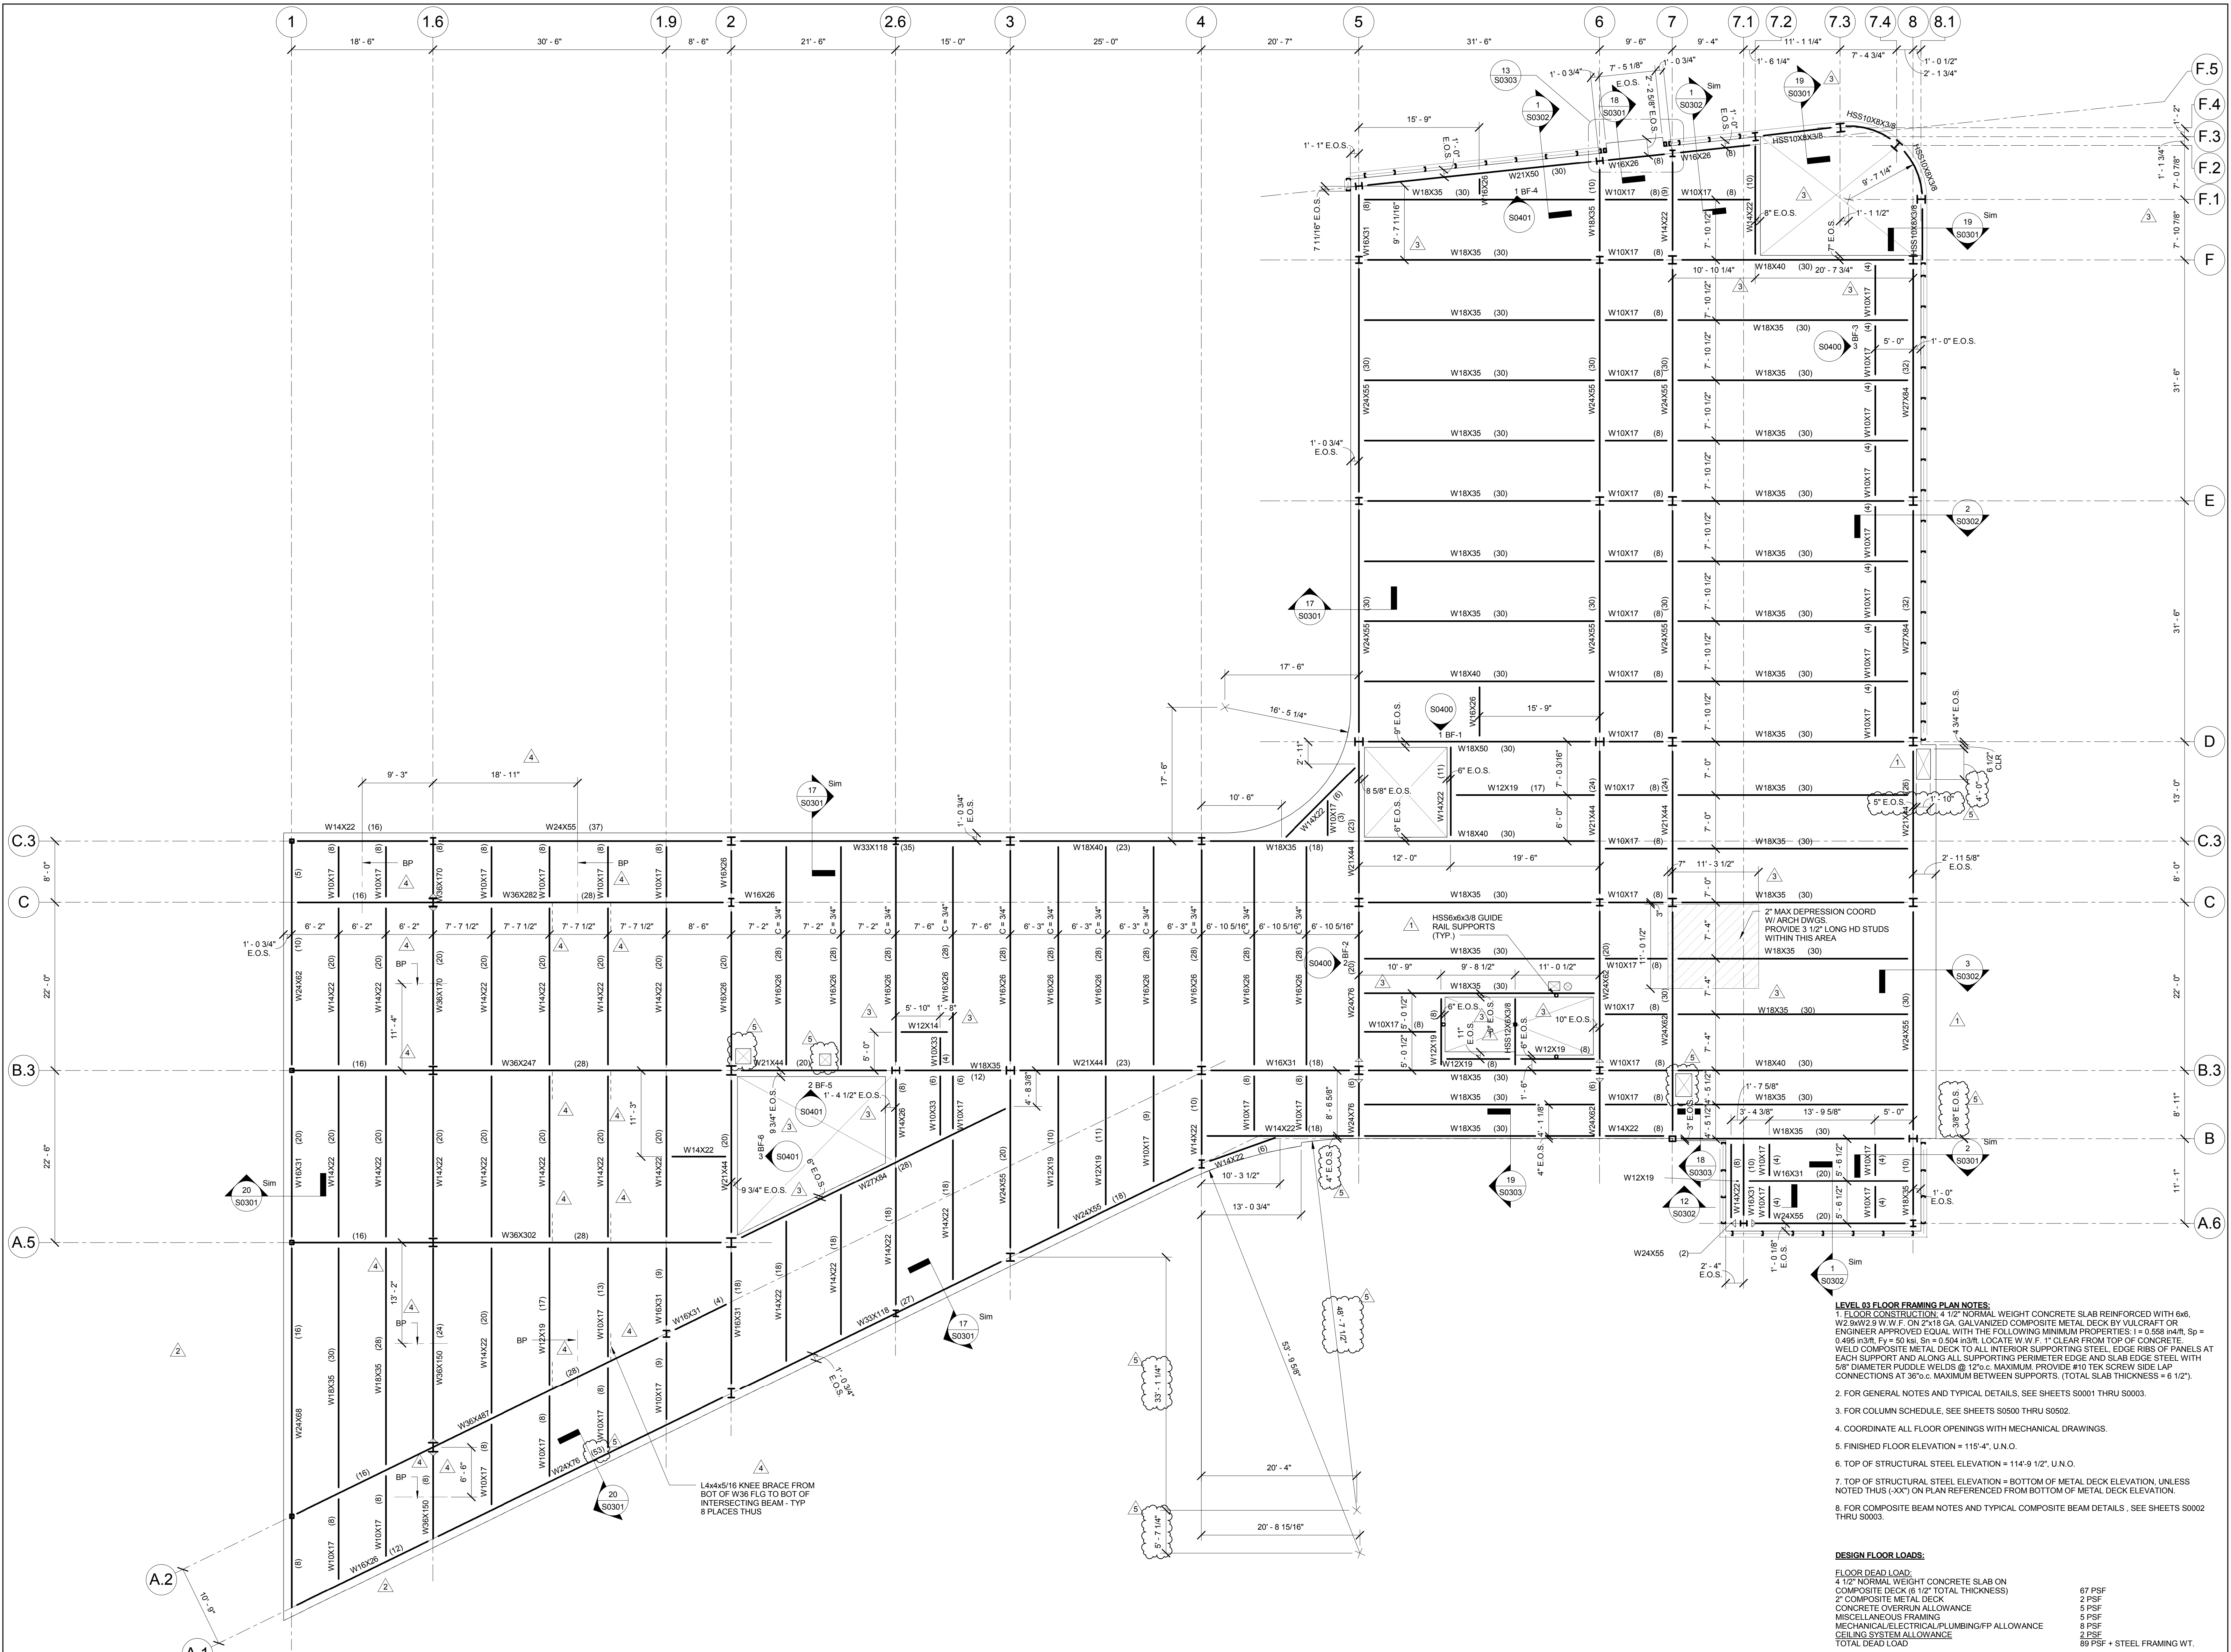

1 LEVEL 03 FLOOR FRAMING PLAN
1/8" = 1'-0"