


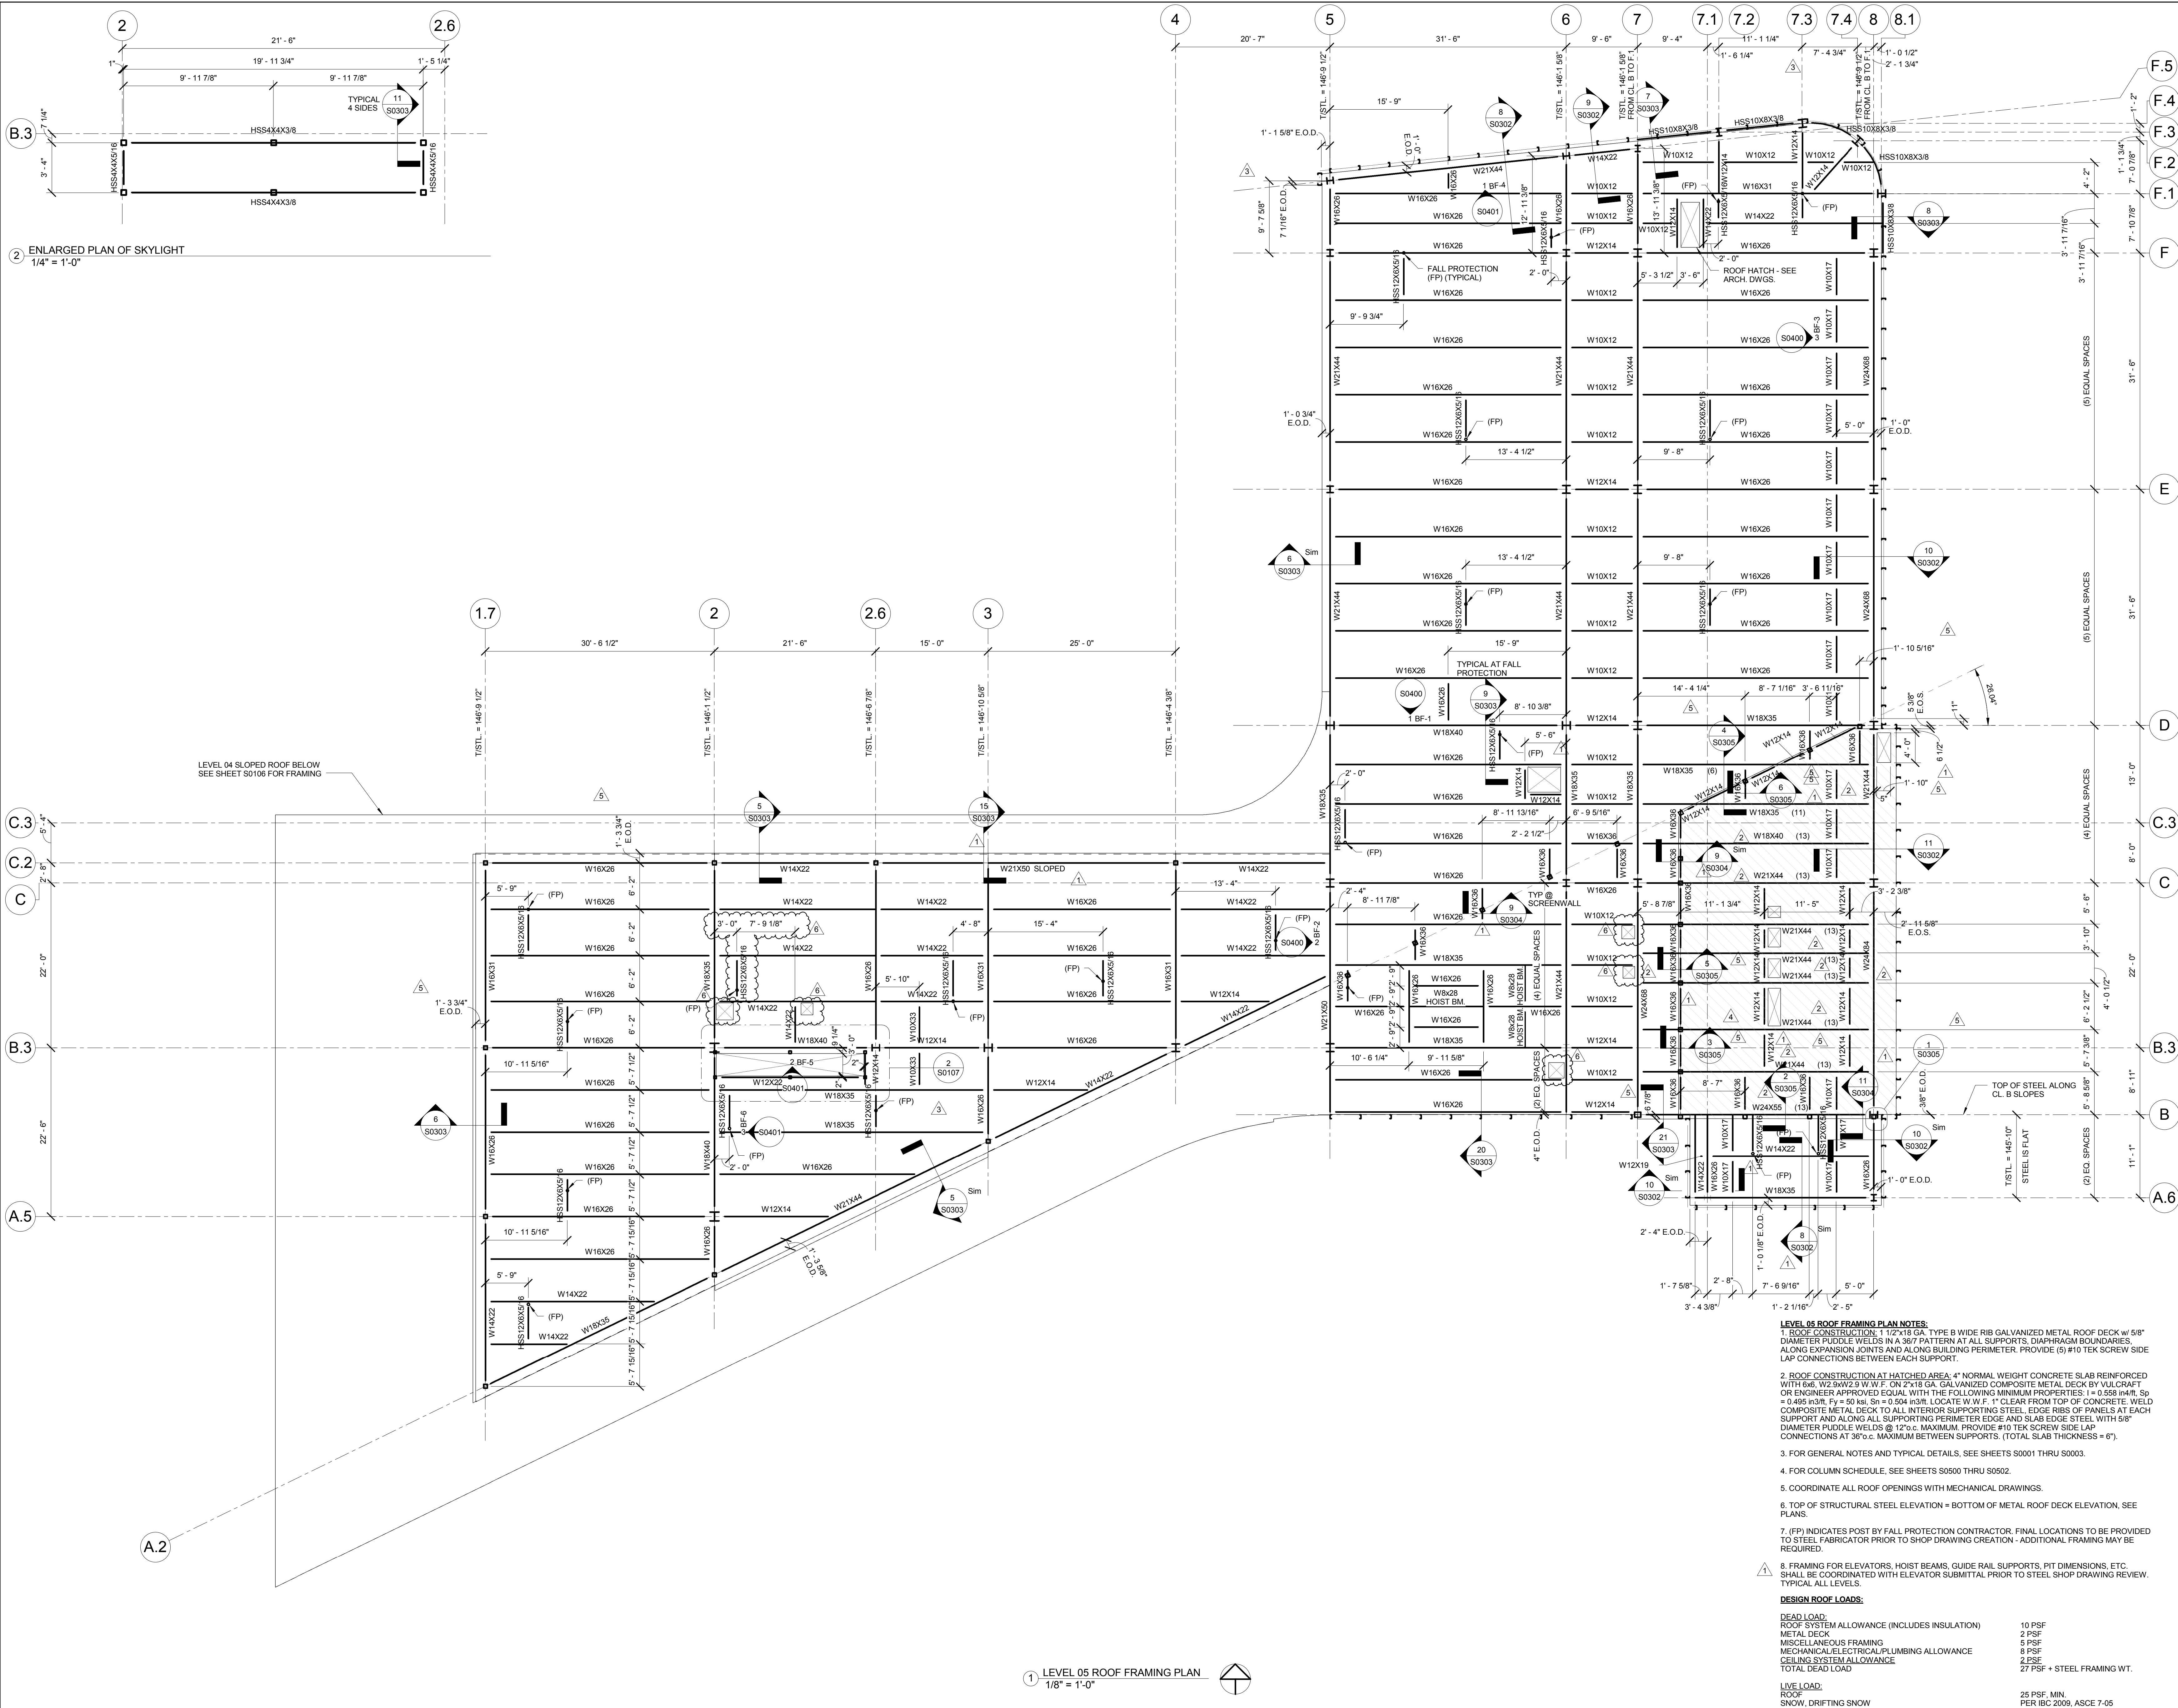

6	ASI 018	19 AUG 2016
5	ASI 021	19 AUG 2016
4	ADDENDUM 1-11	13 MAY 2016
3	ADDENDUM 1-7	16 MAR 2016
2	ADDENDUM 1-3	02 FEB 2016
1	ADDENDUM 1-1	29 JAN 2016
-	ISSUED FOR CONSTRUCTION (BPT)	15 JAN 2016
No.	Description	Date

Drawing Title:

LEVEL 05 ROOF FRAMING
PLAN

Project No.: 04561.01

Checked by:

S0107