




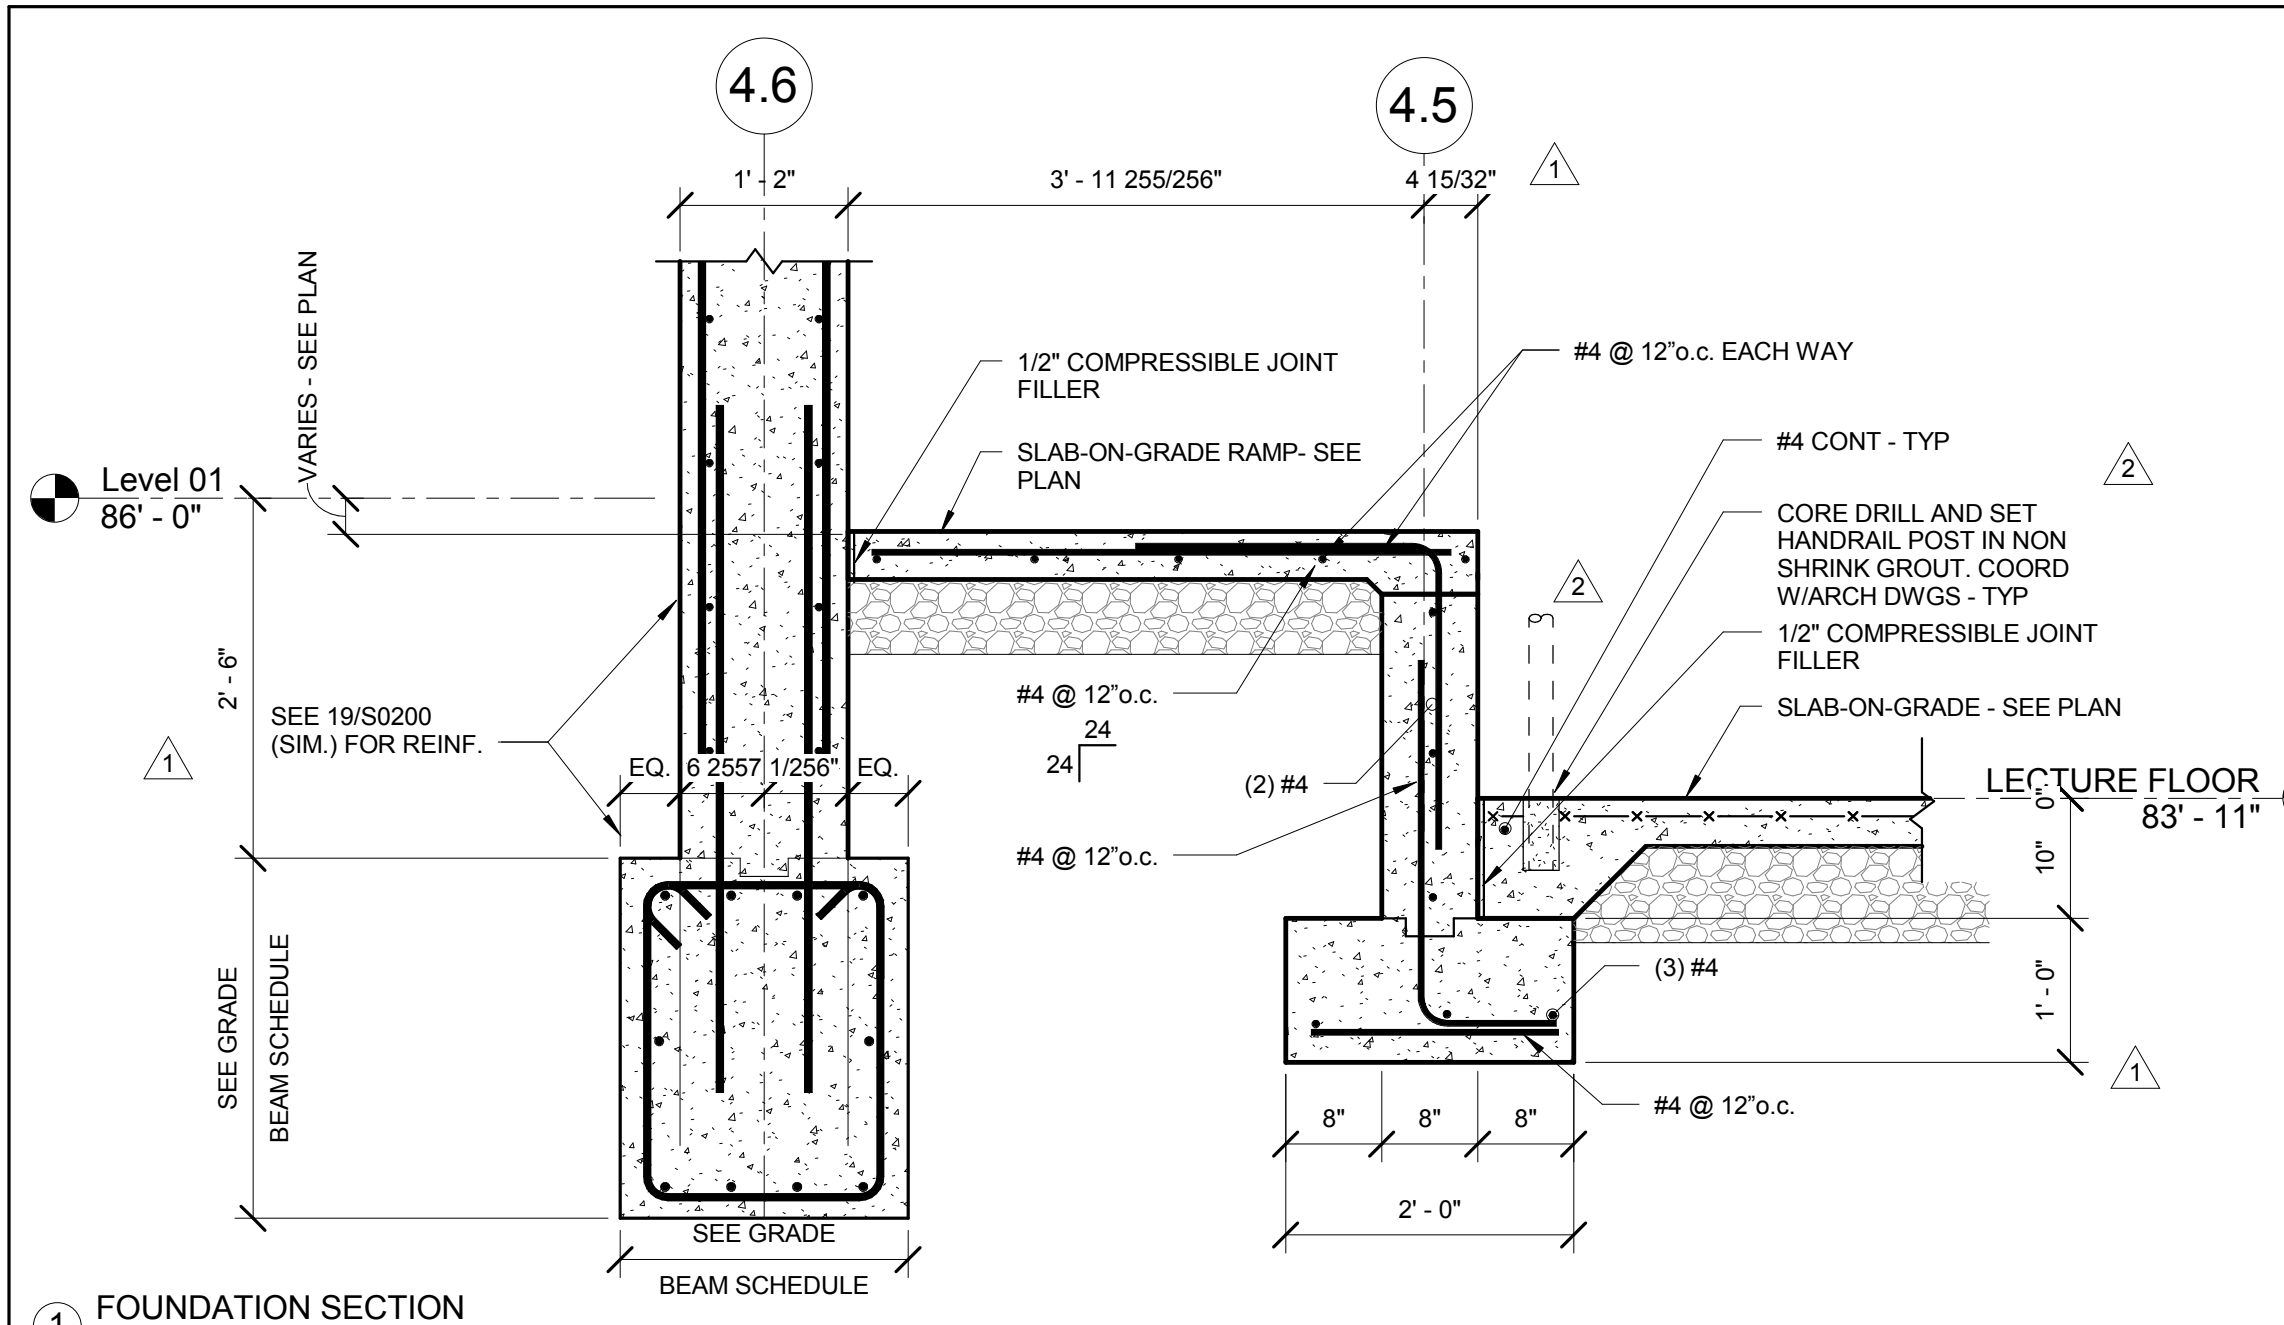


1 FOUNDATION SECTION
3/4" = 1'-0"

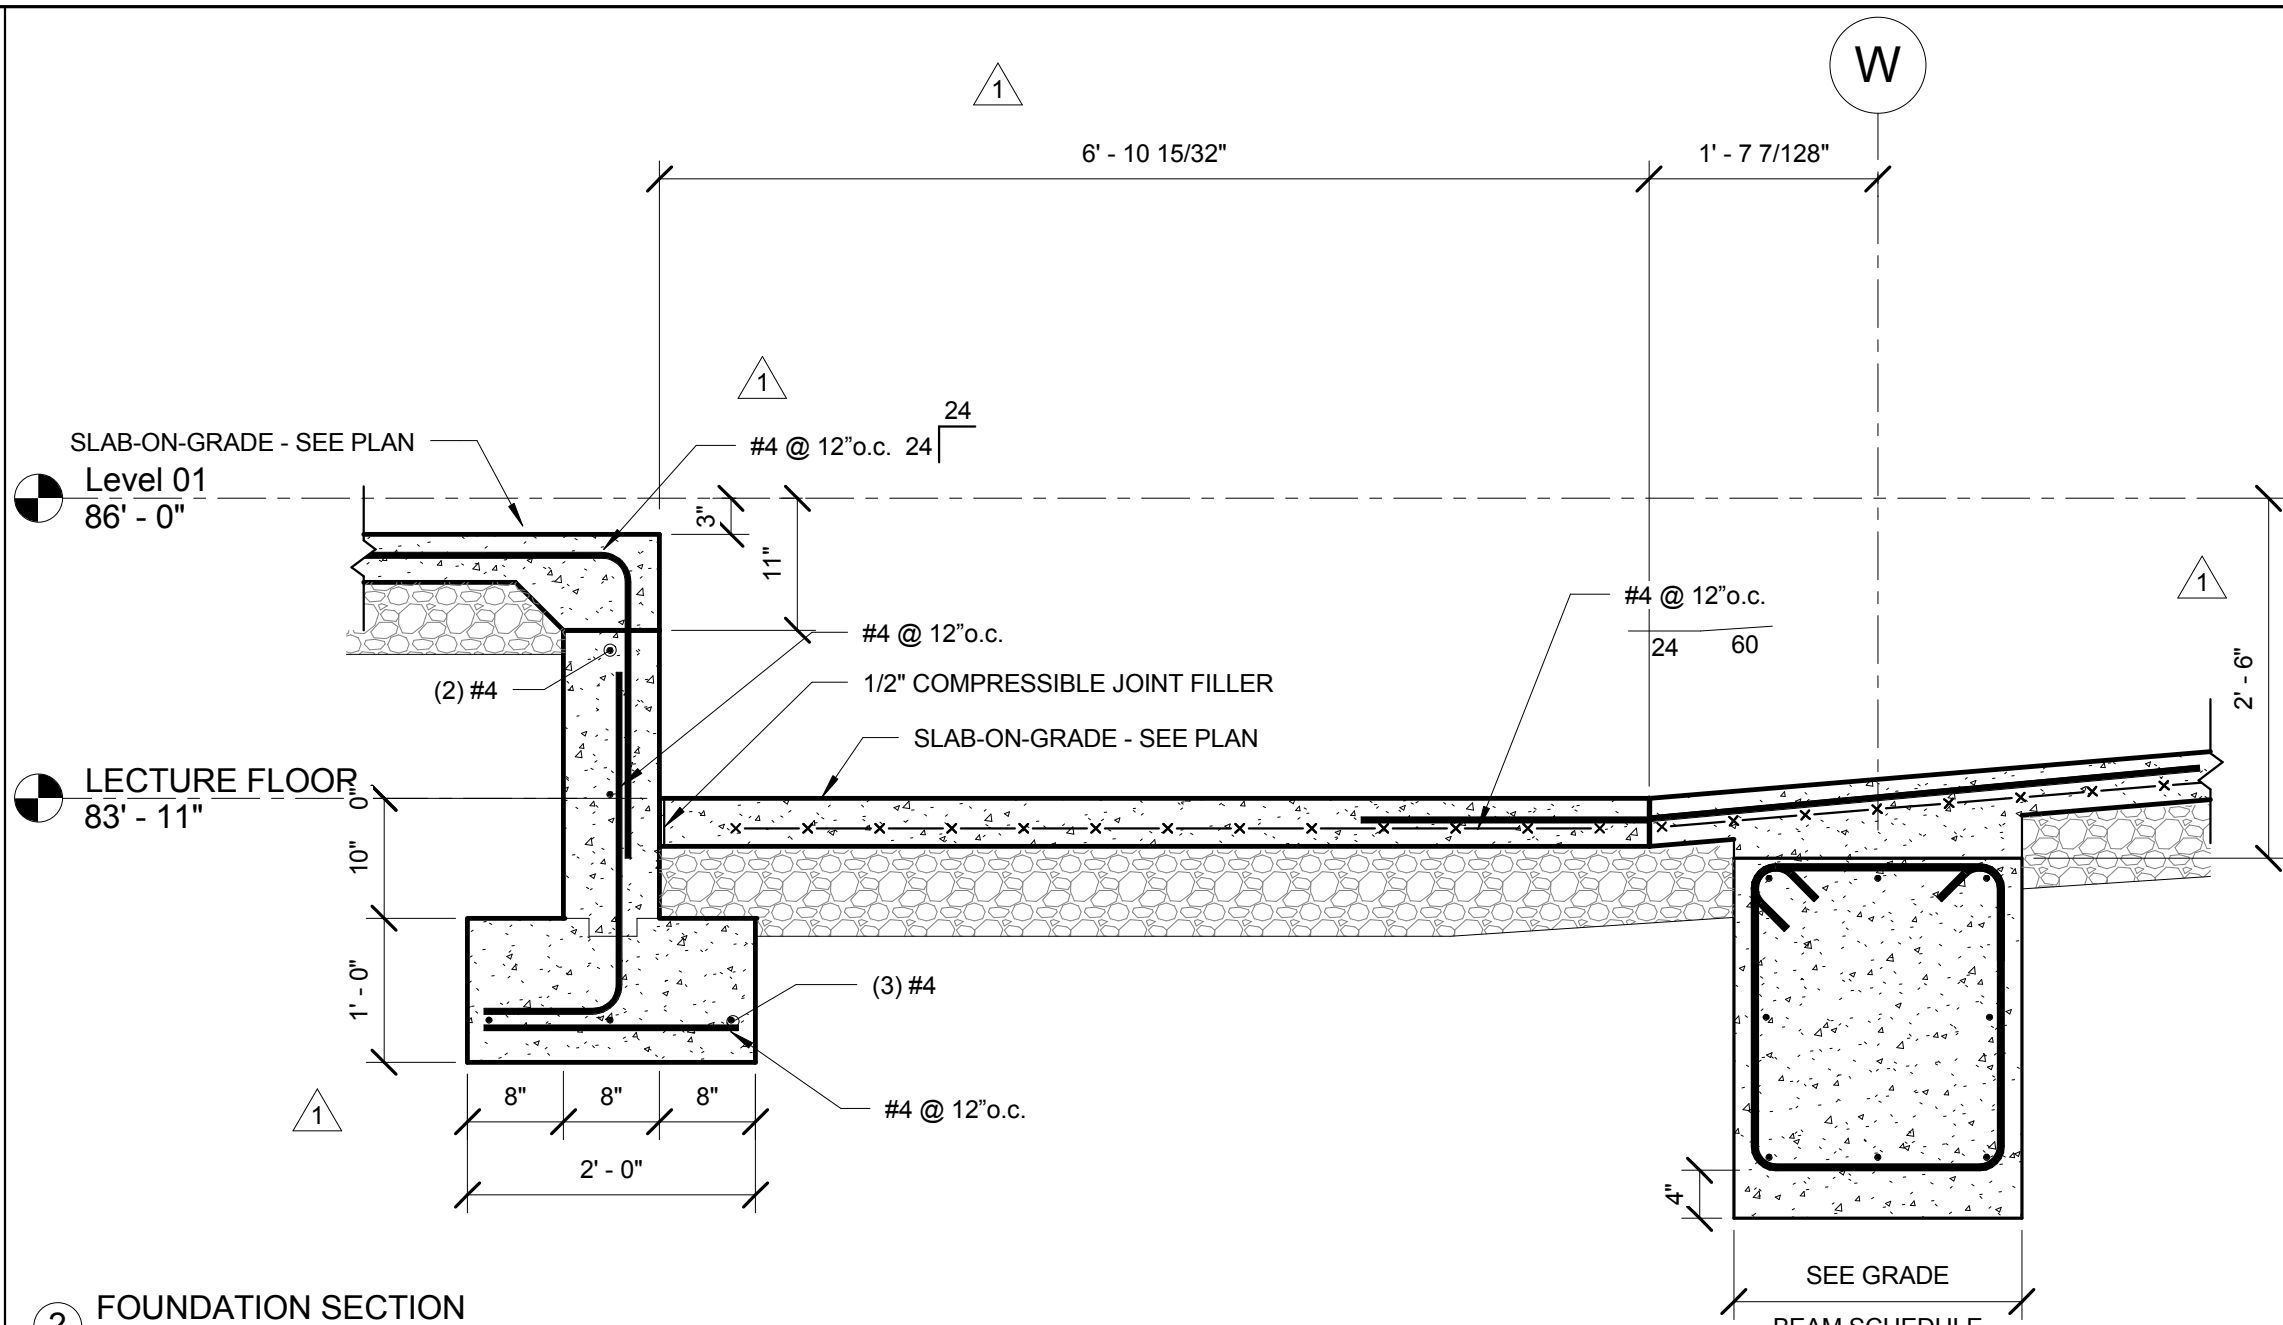


2 FOUNDATION SECTION
3/4" = 1'-0"

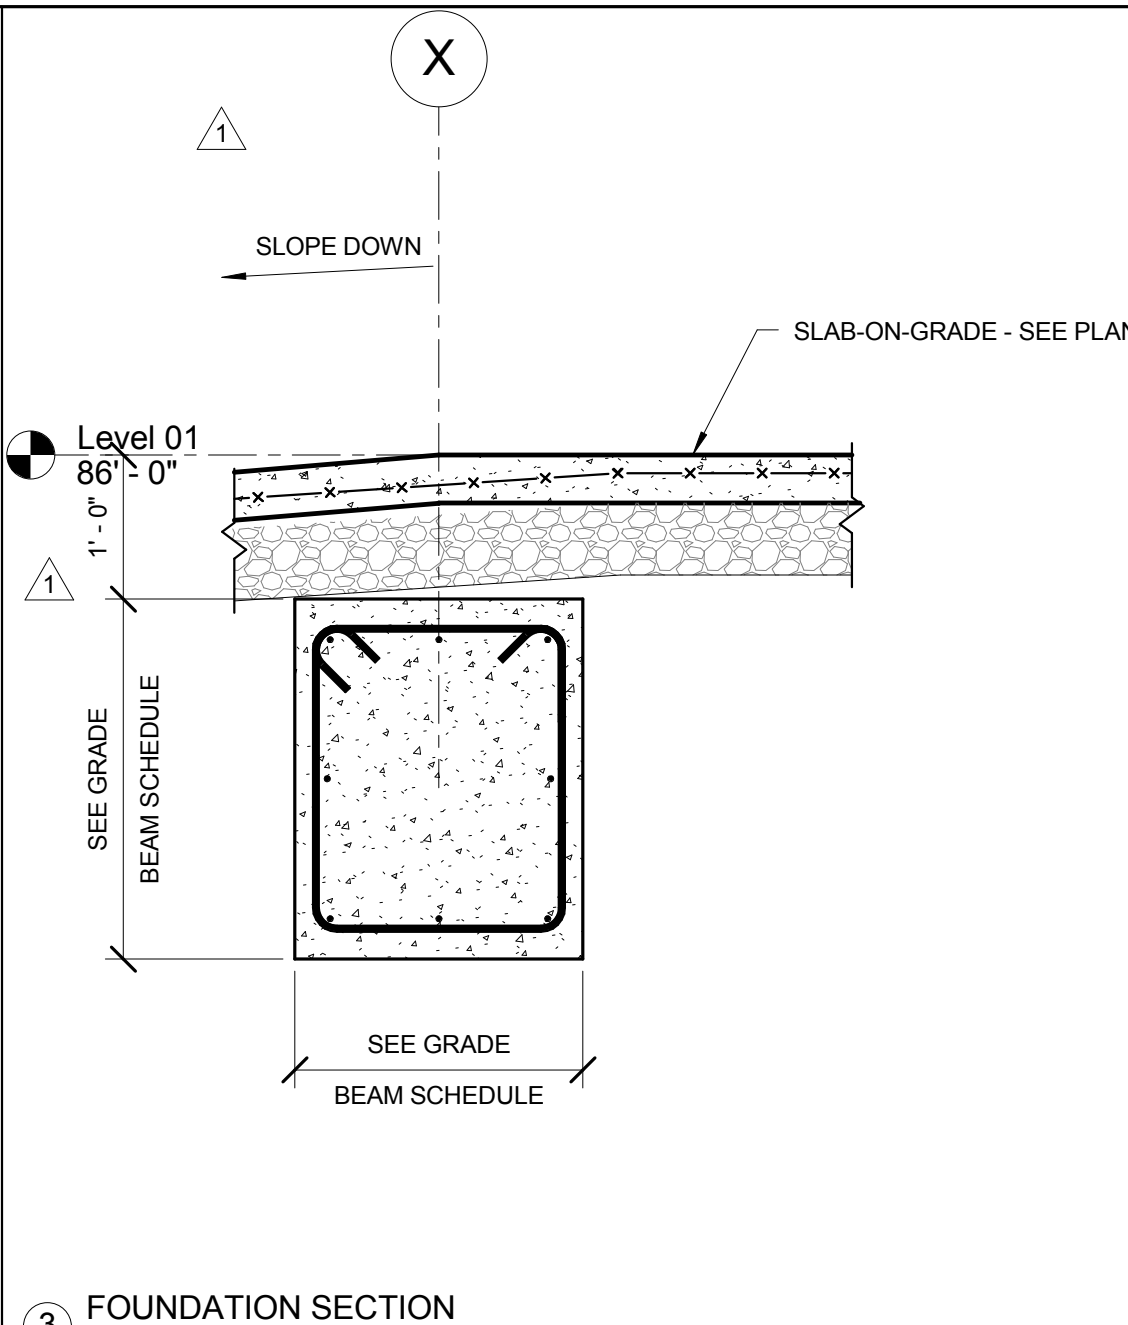


3 FOUNDATION SECTION
3/4" = 1'-0"

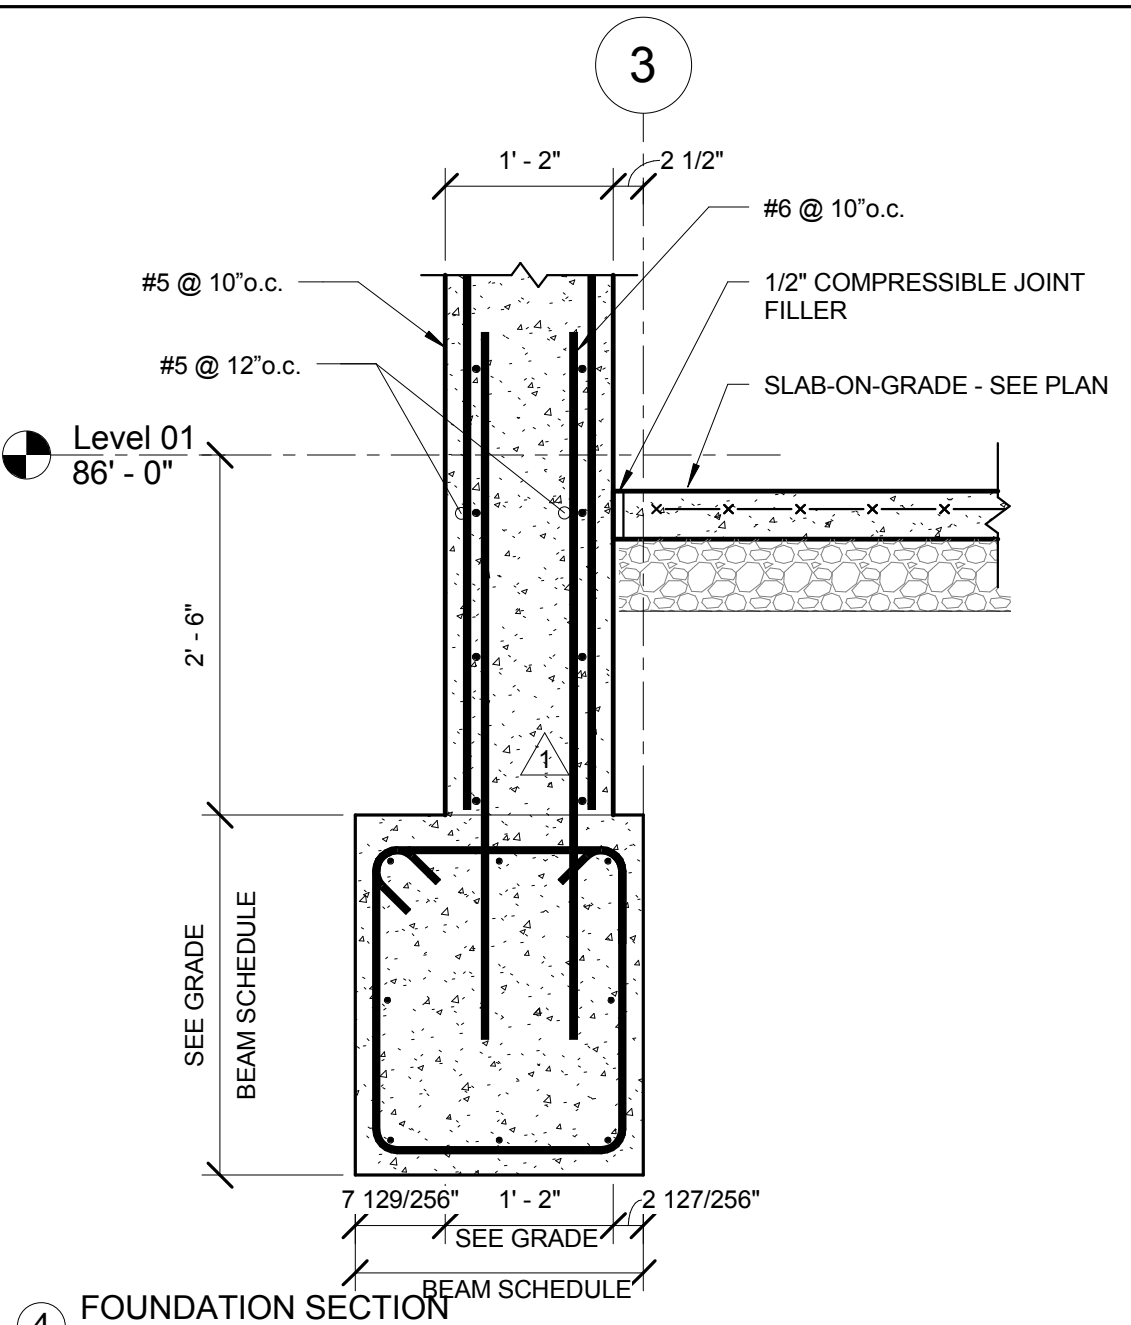


4 FOUNDATION SECTION
3/4" = 1'-0"

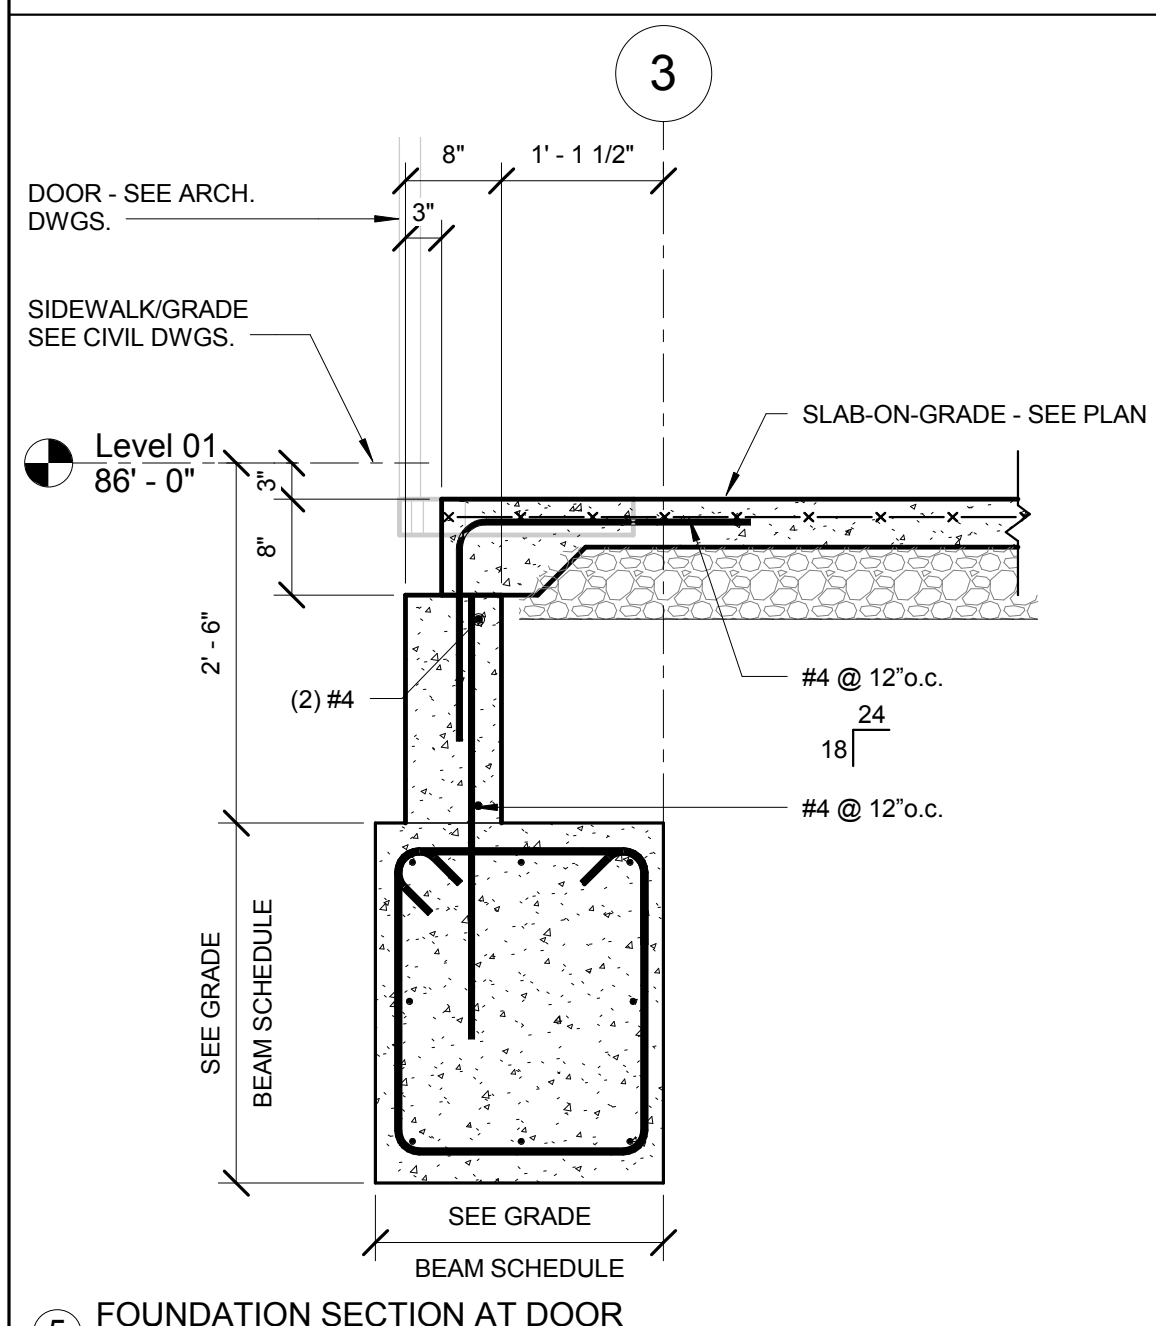


5 FOUNDATION SECTION AT DOOR
3/4" = 1'-0"

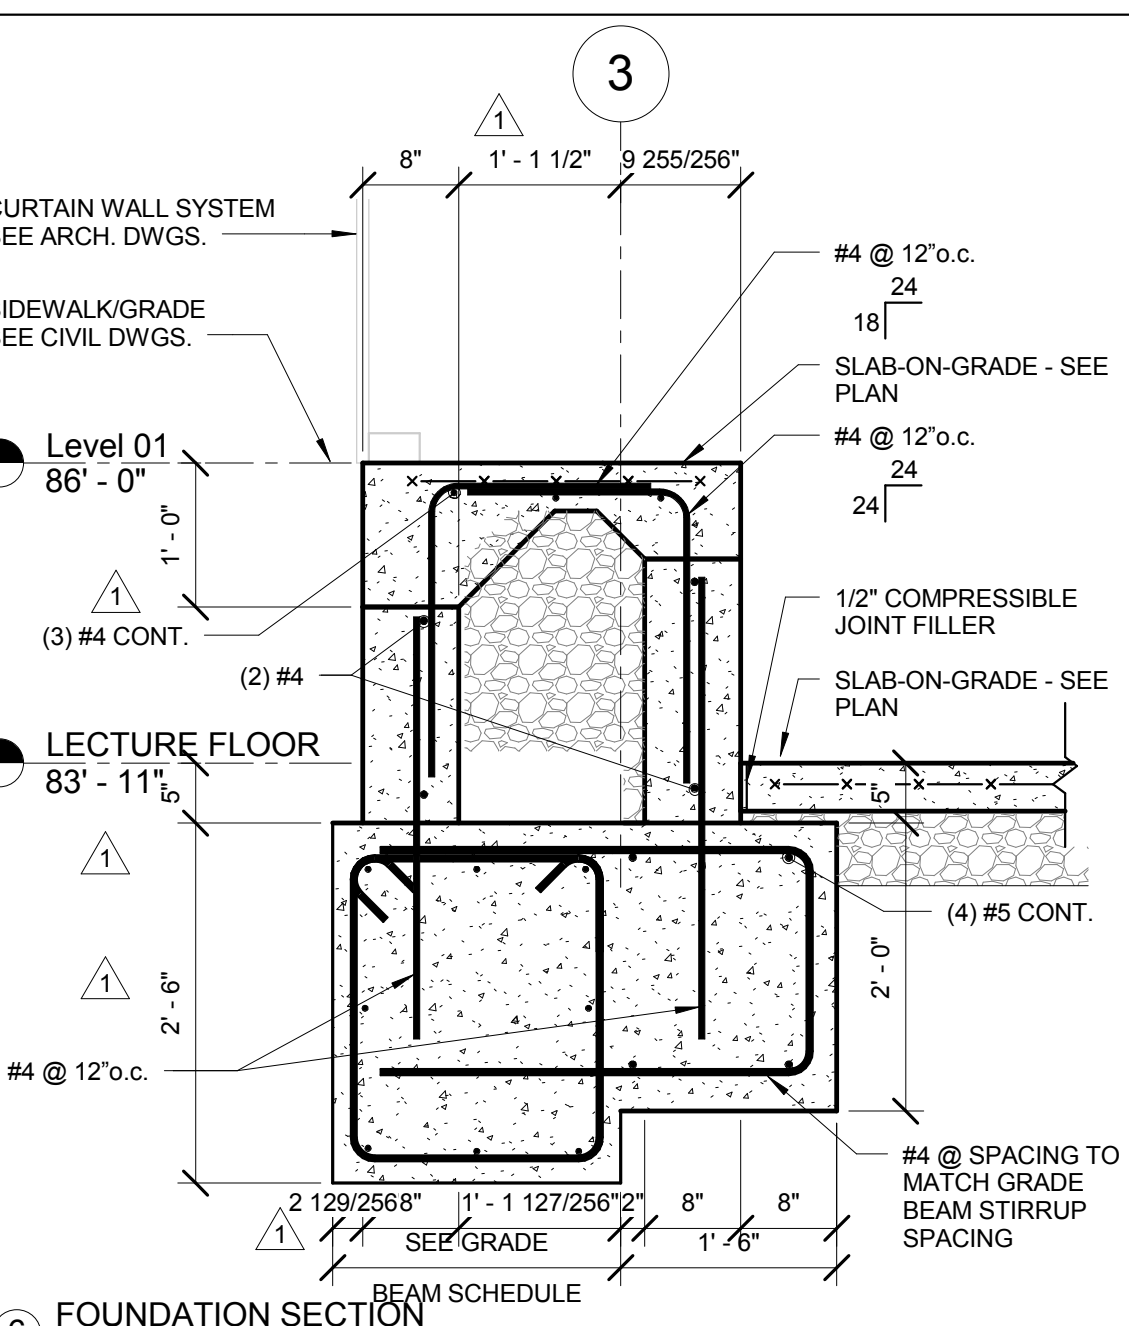


6 FOUNDATION SECTION
3/4" = 1'-0"

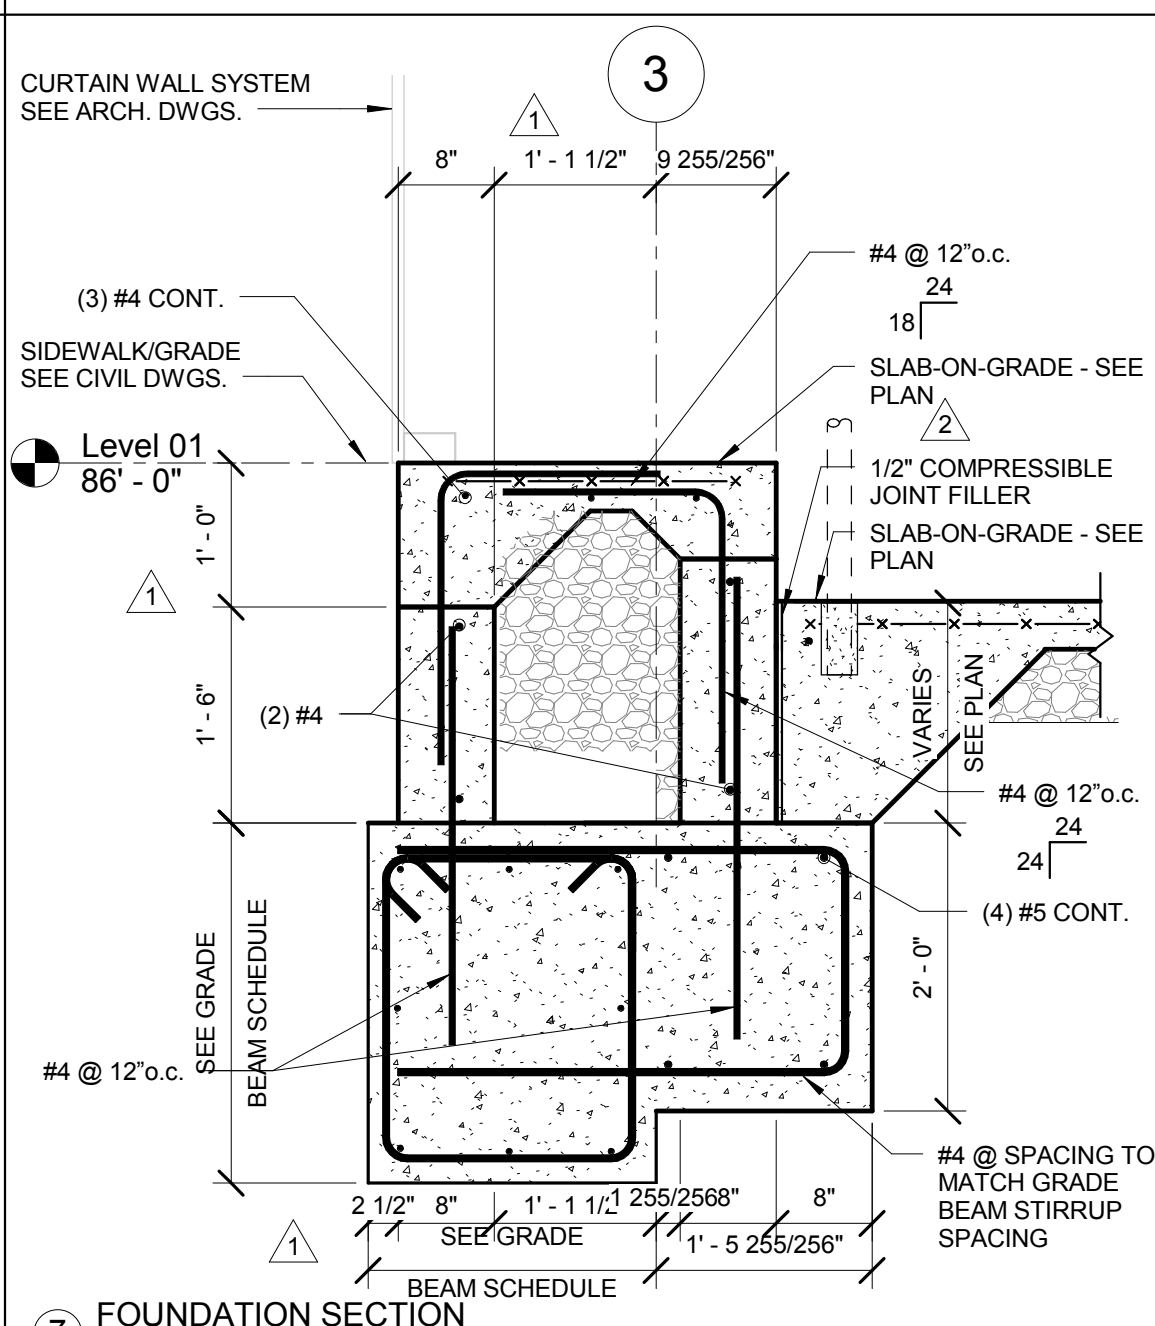


7 FOUNDATION SECTION
3/4" = 1'-0"

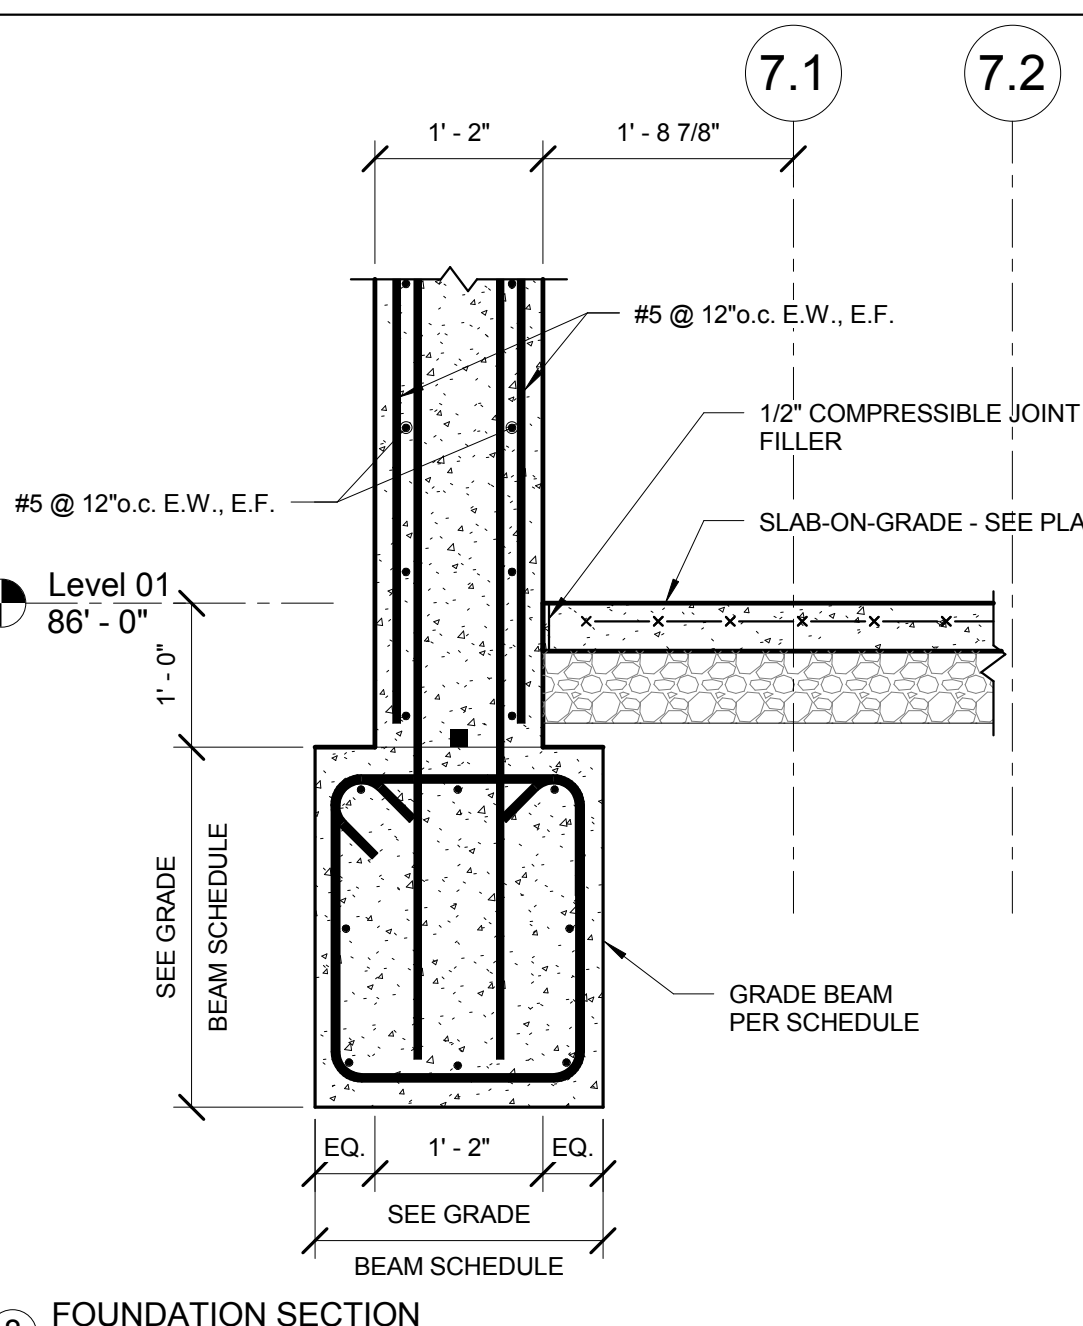


8 FOUNDATION SECTION
3/4" = 1'-0"

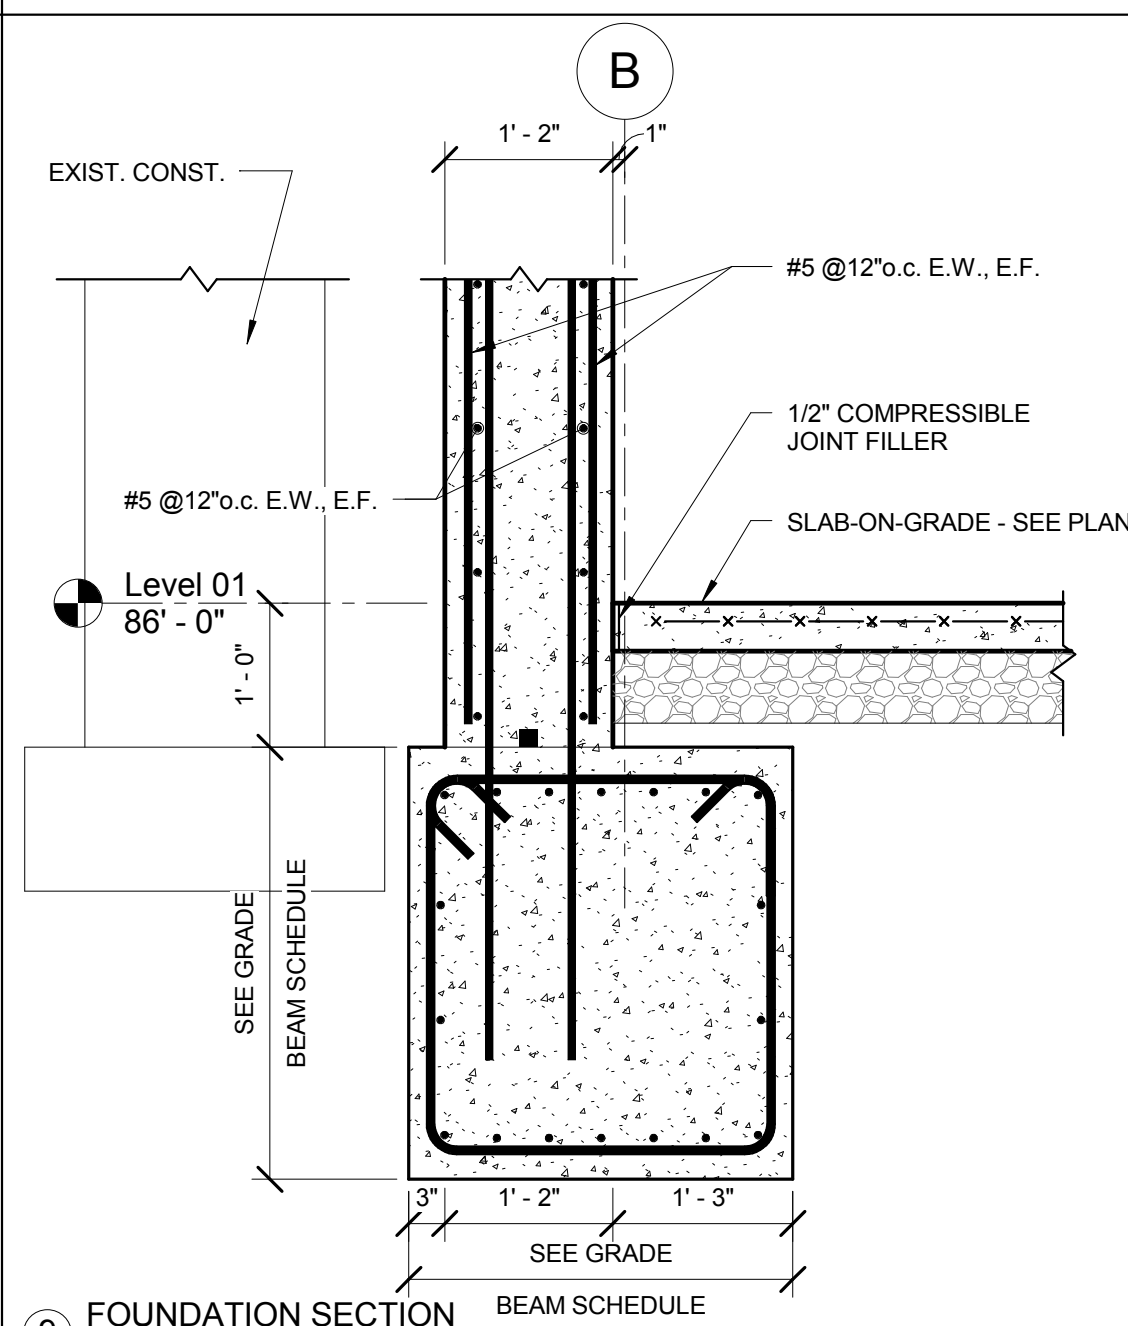


9 FOUNDATION SECTION
3/4" = 1'-0"

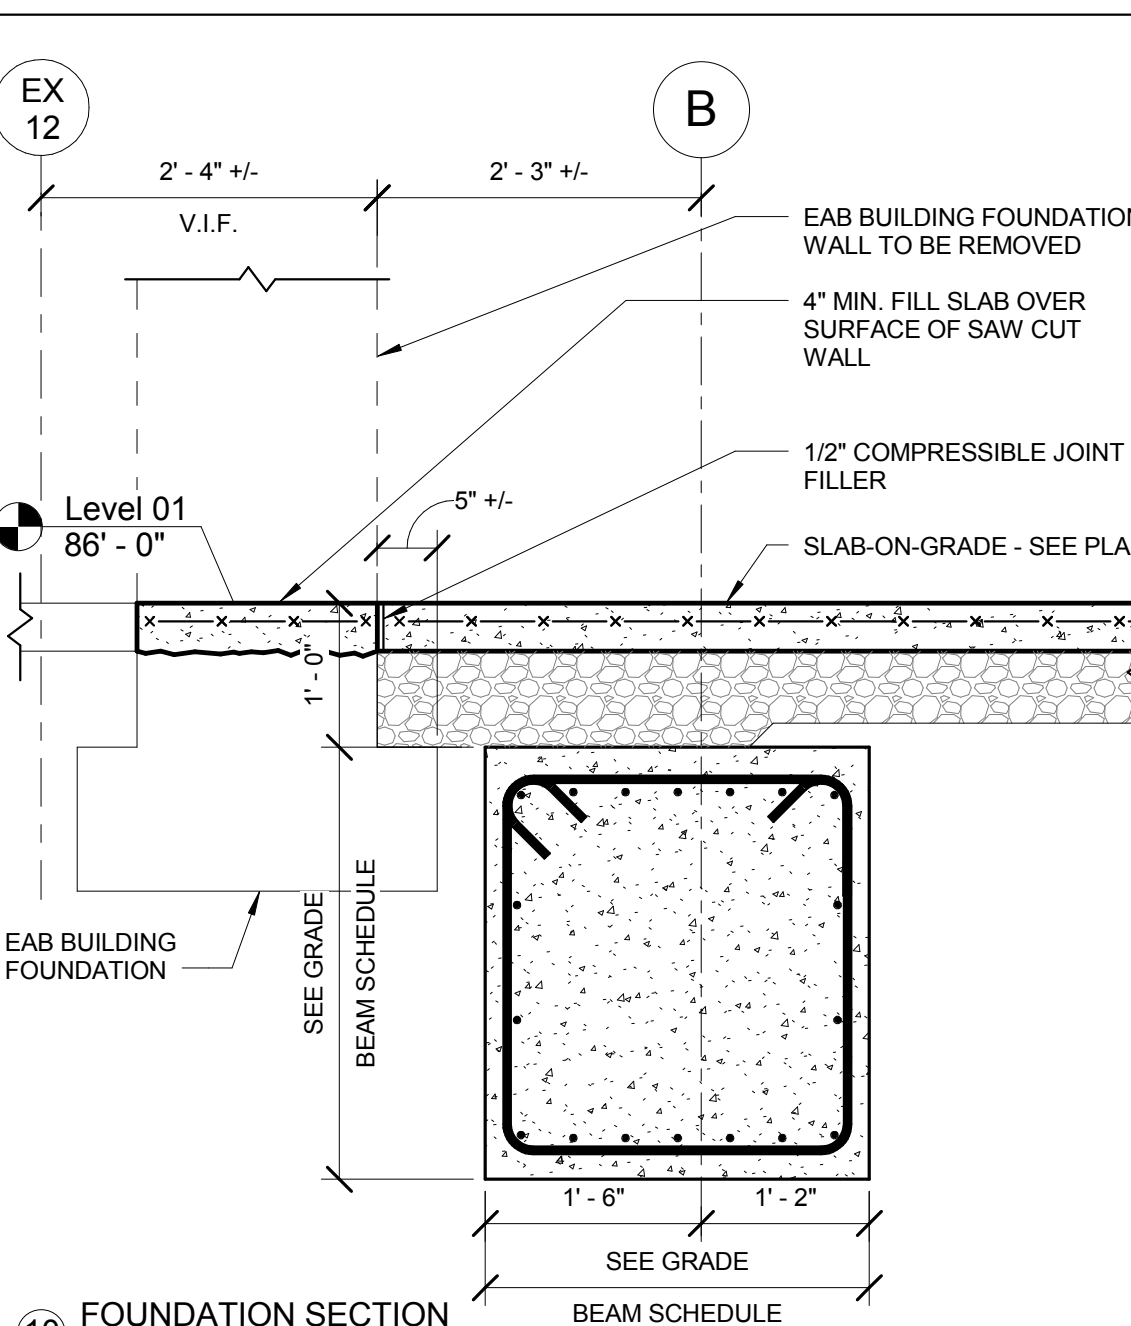


10 FOUNDATION SECTION
3/4" = 1'-0"

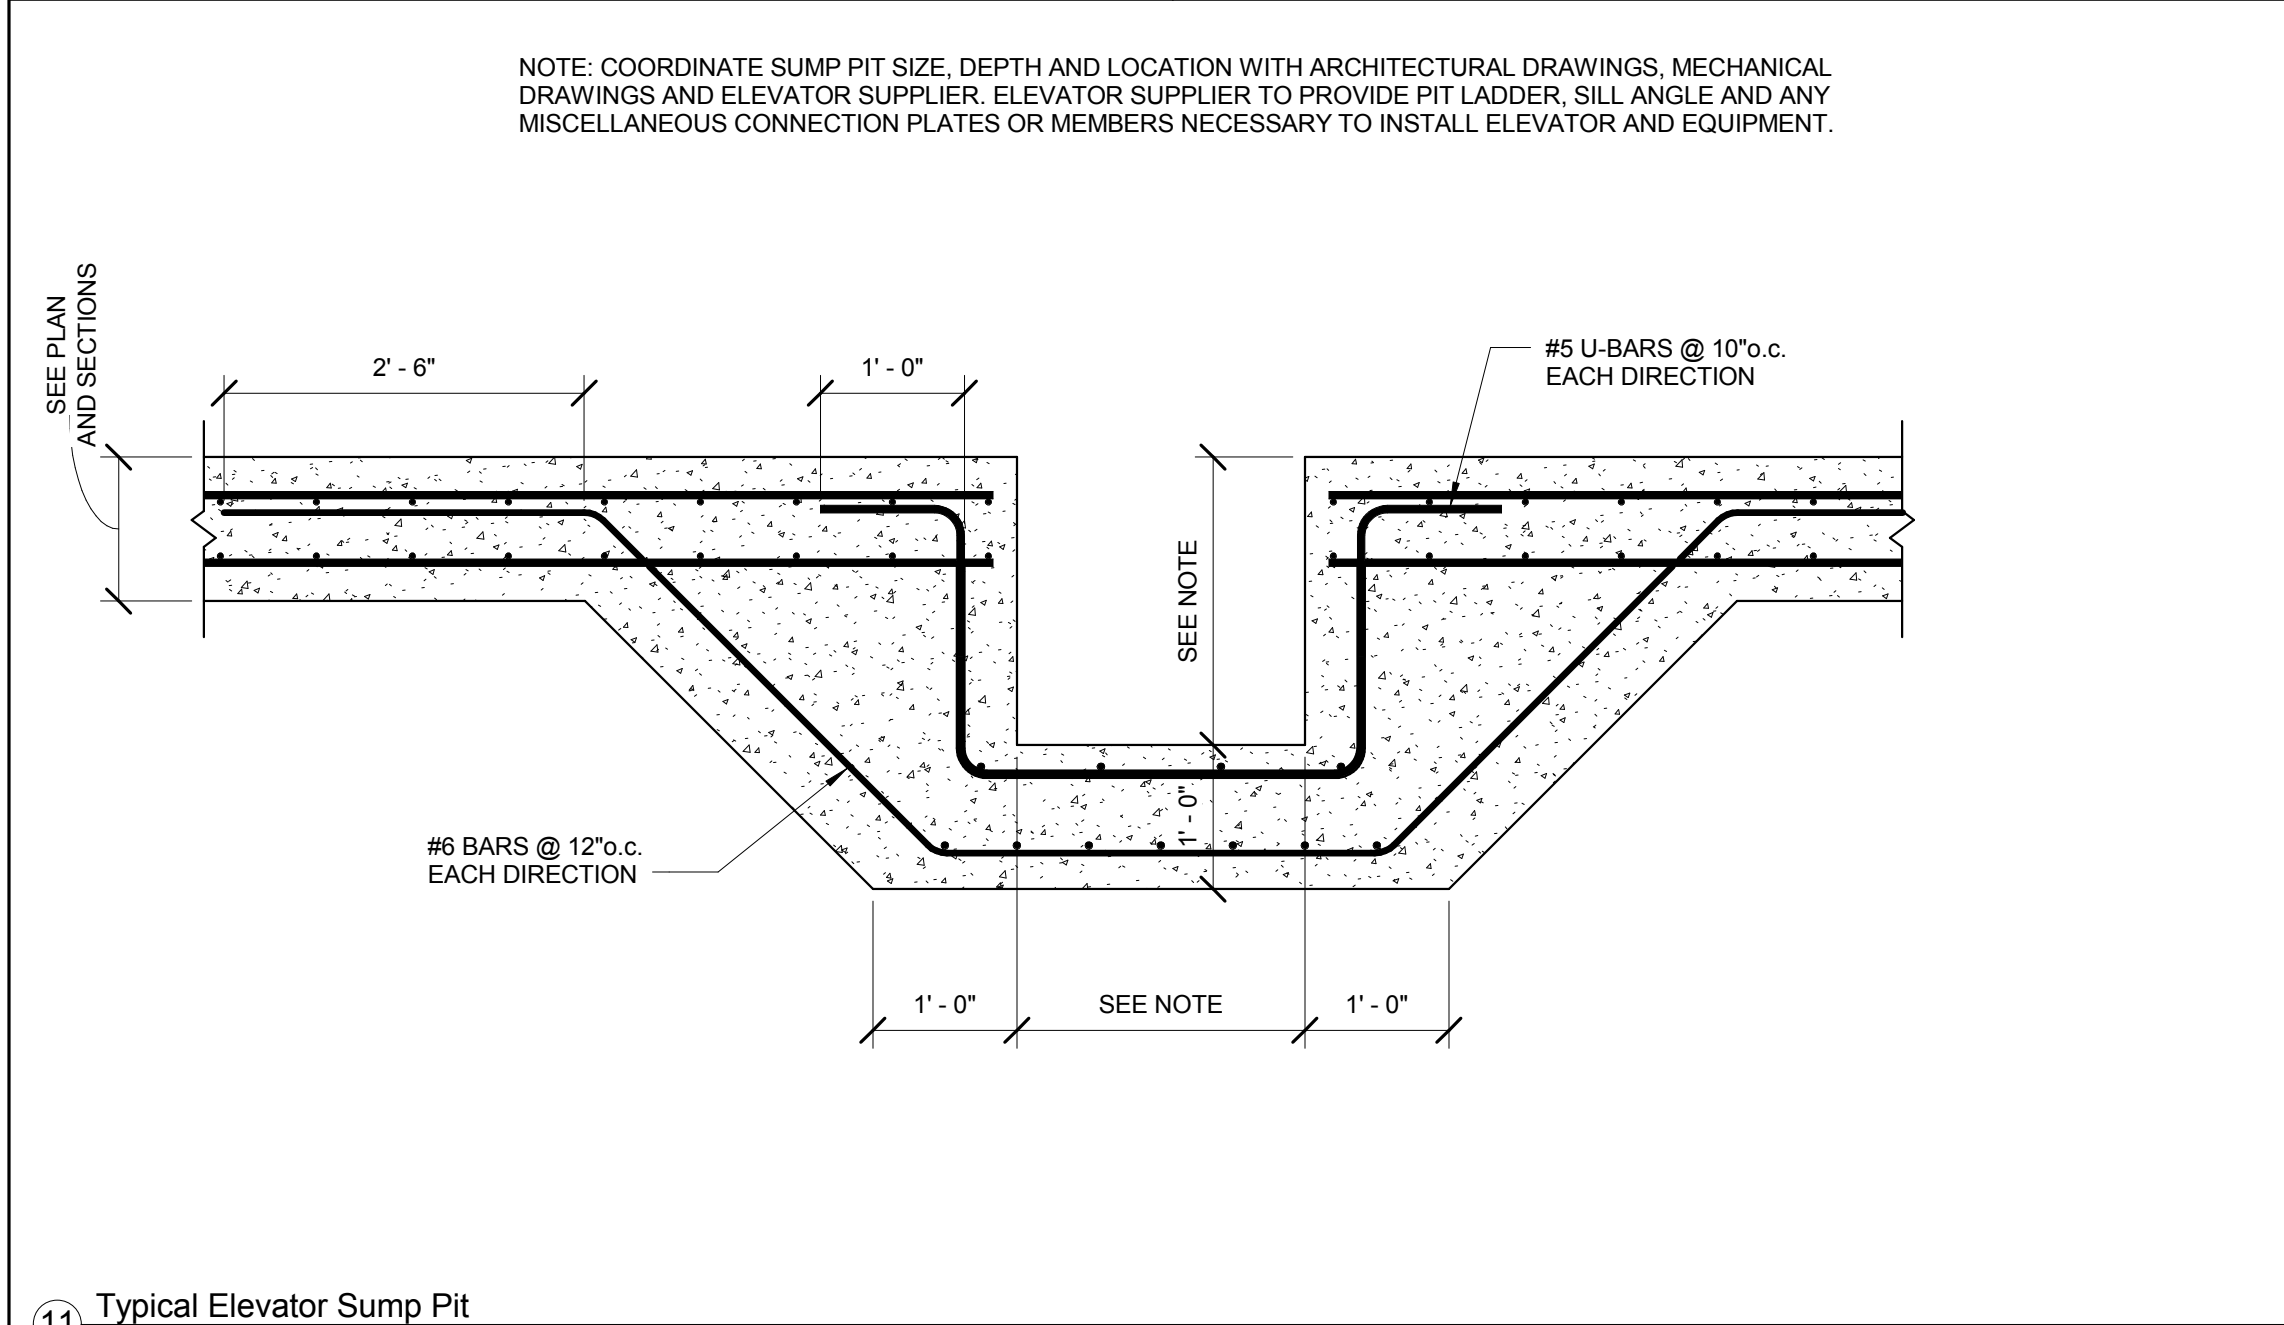

11 Typical Elevator Sump Pit
3/4" = 1'-0"

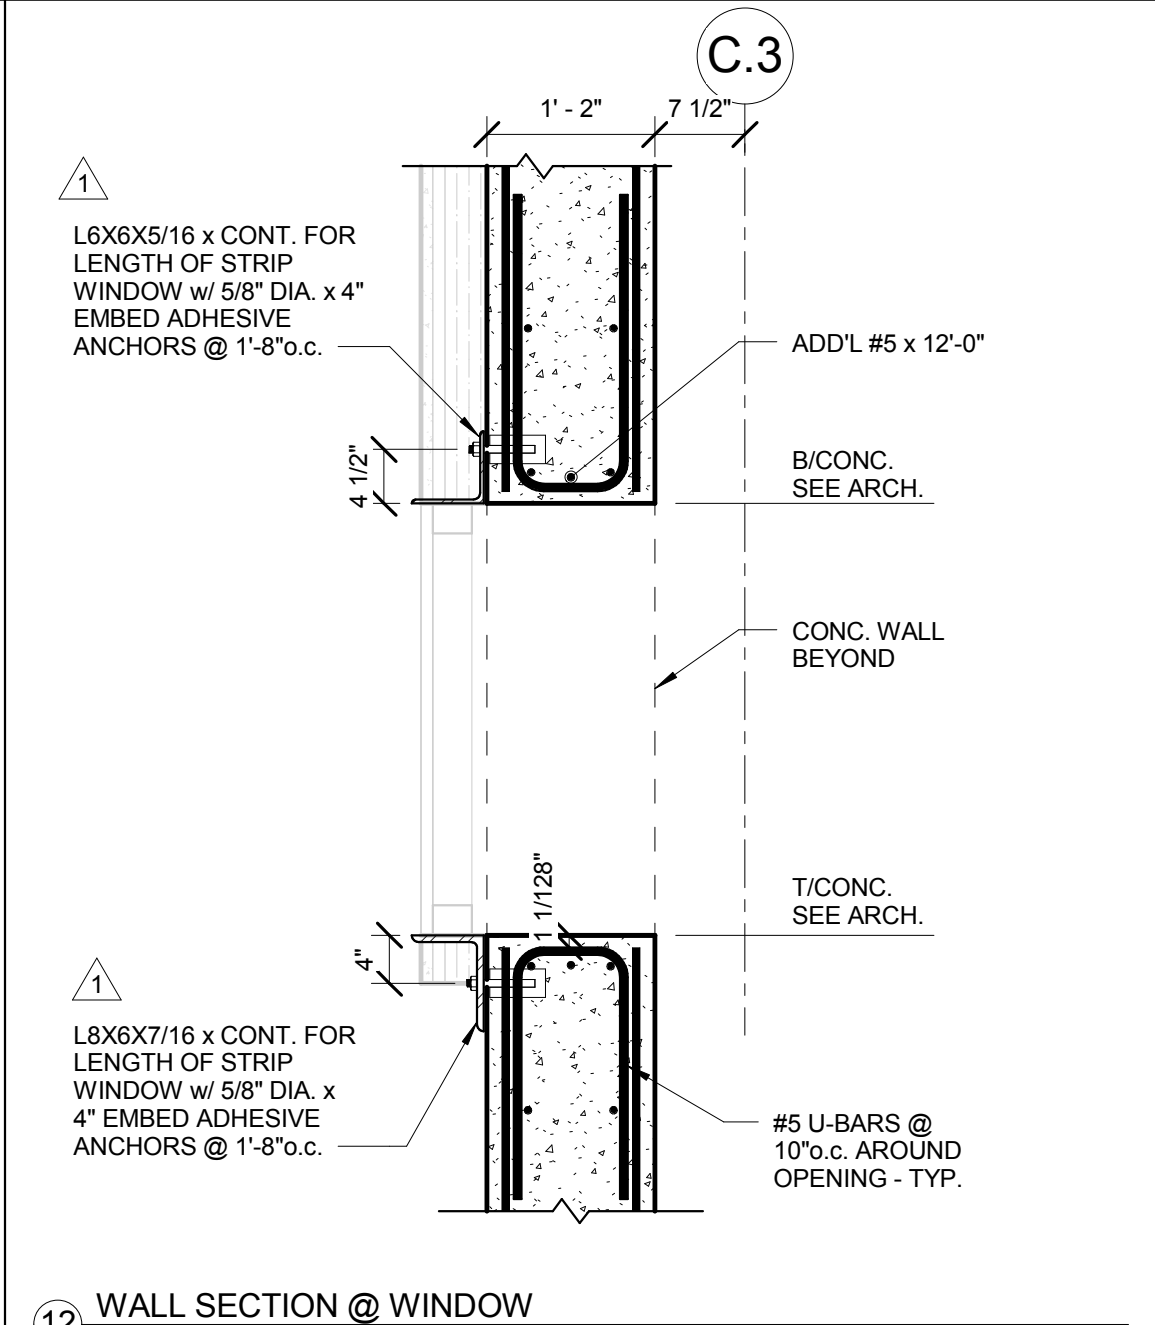

12 WALL SECTION @ WINDOW
3/4" = 1'-0"

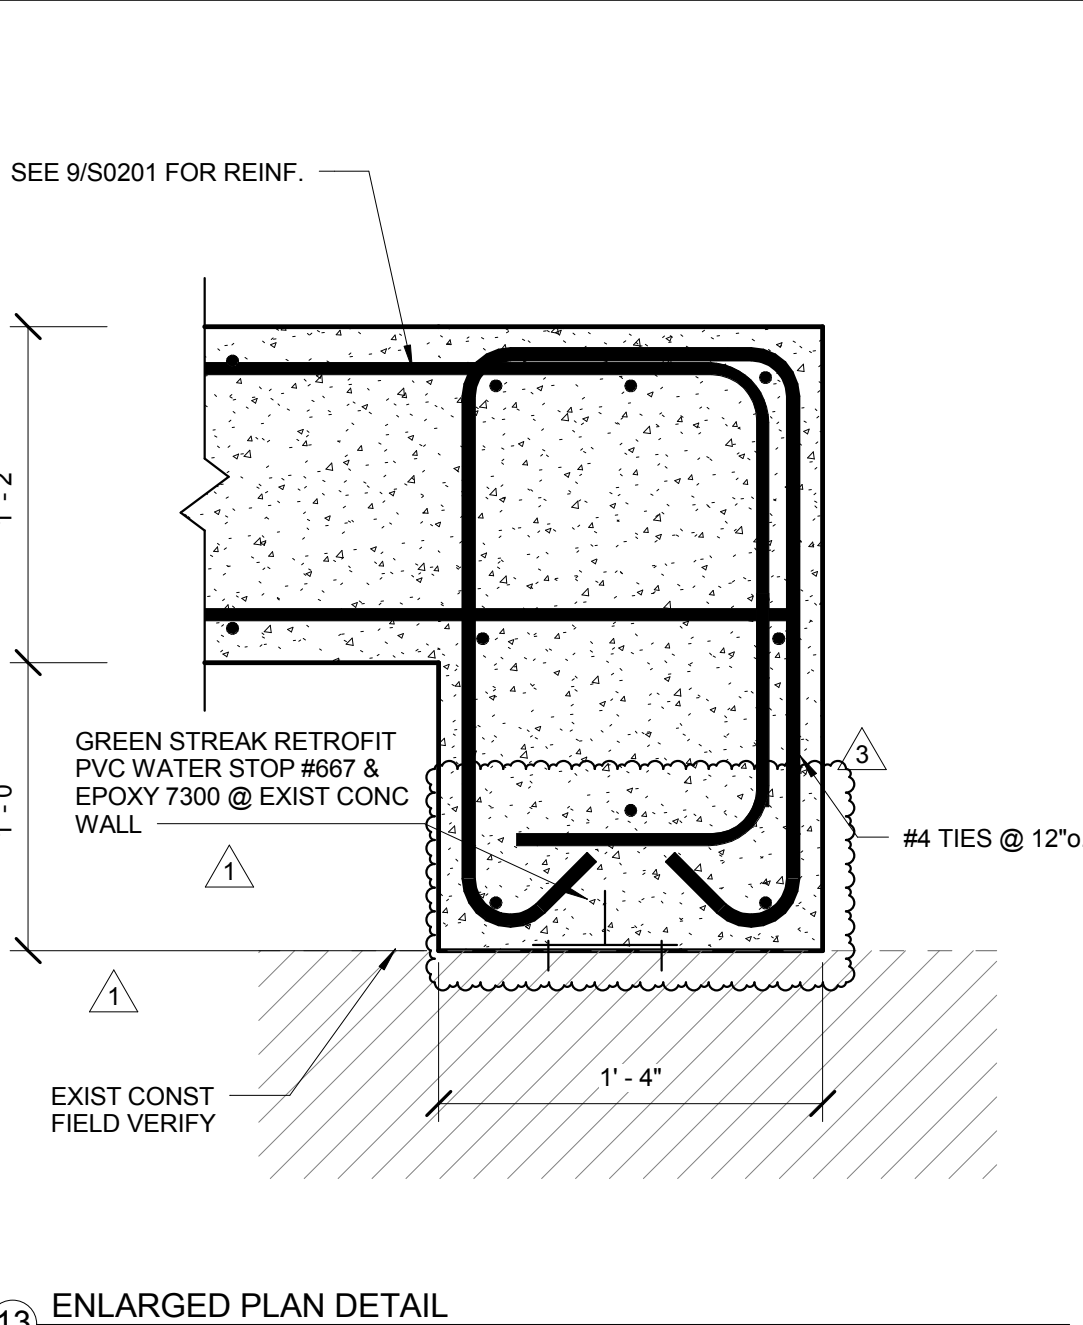

13 ENLARGED PLAN DETAIL
1 1/2" = 1'-0"

3	ADDENDUM 1-11	13 MAY 2016
2	ADDENDUM 1-7	16 MAR 2016
1	ADDENDUM 1-1	29 JAN 2016
-	ISSUED FOR CONSTRUCTION (BP1)	15 JAN 2016
No.	Description	Date

Drawing Title:

FOUNDATION SECTIONS
AND DETAILS

Project No.: 04561.01

Checked by:

S0201