
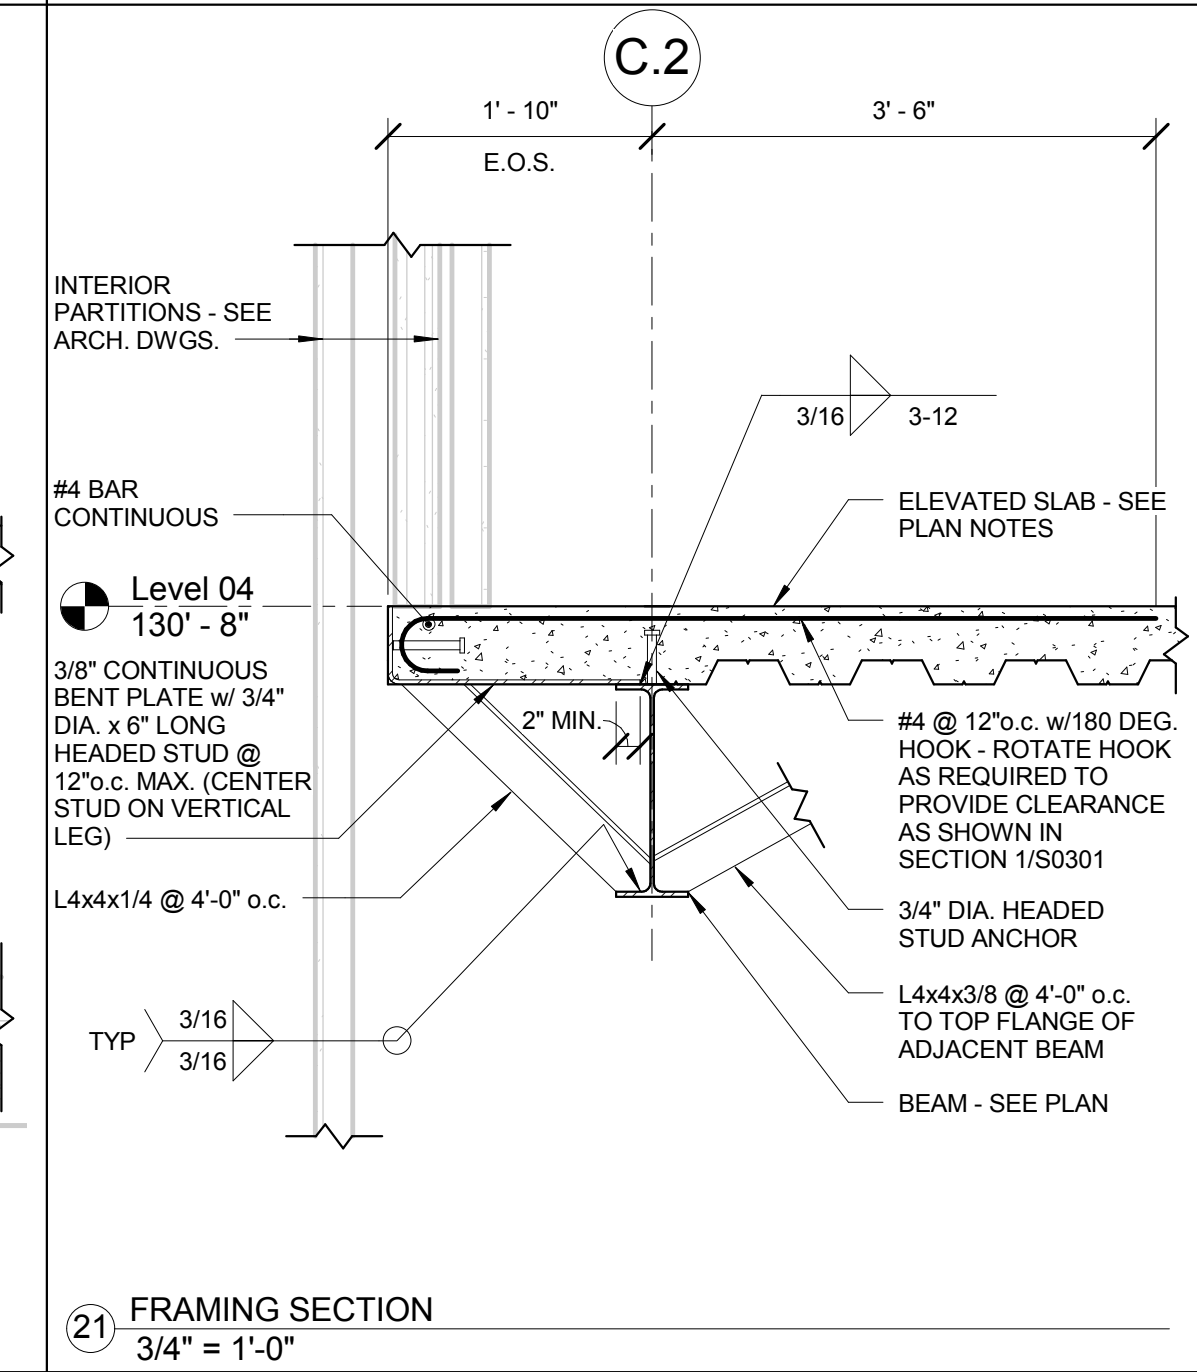
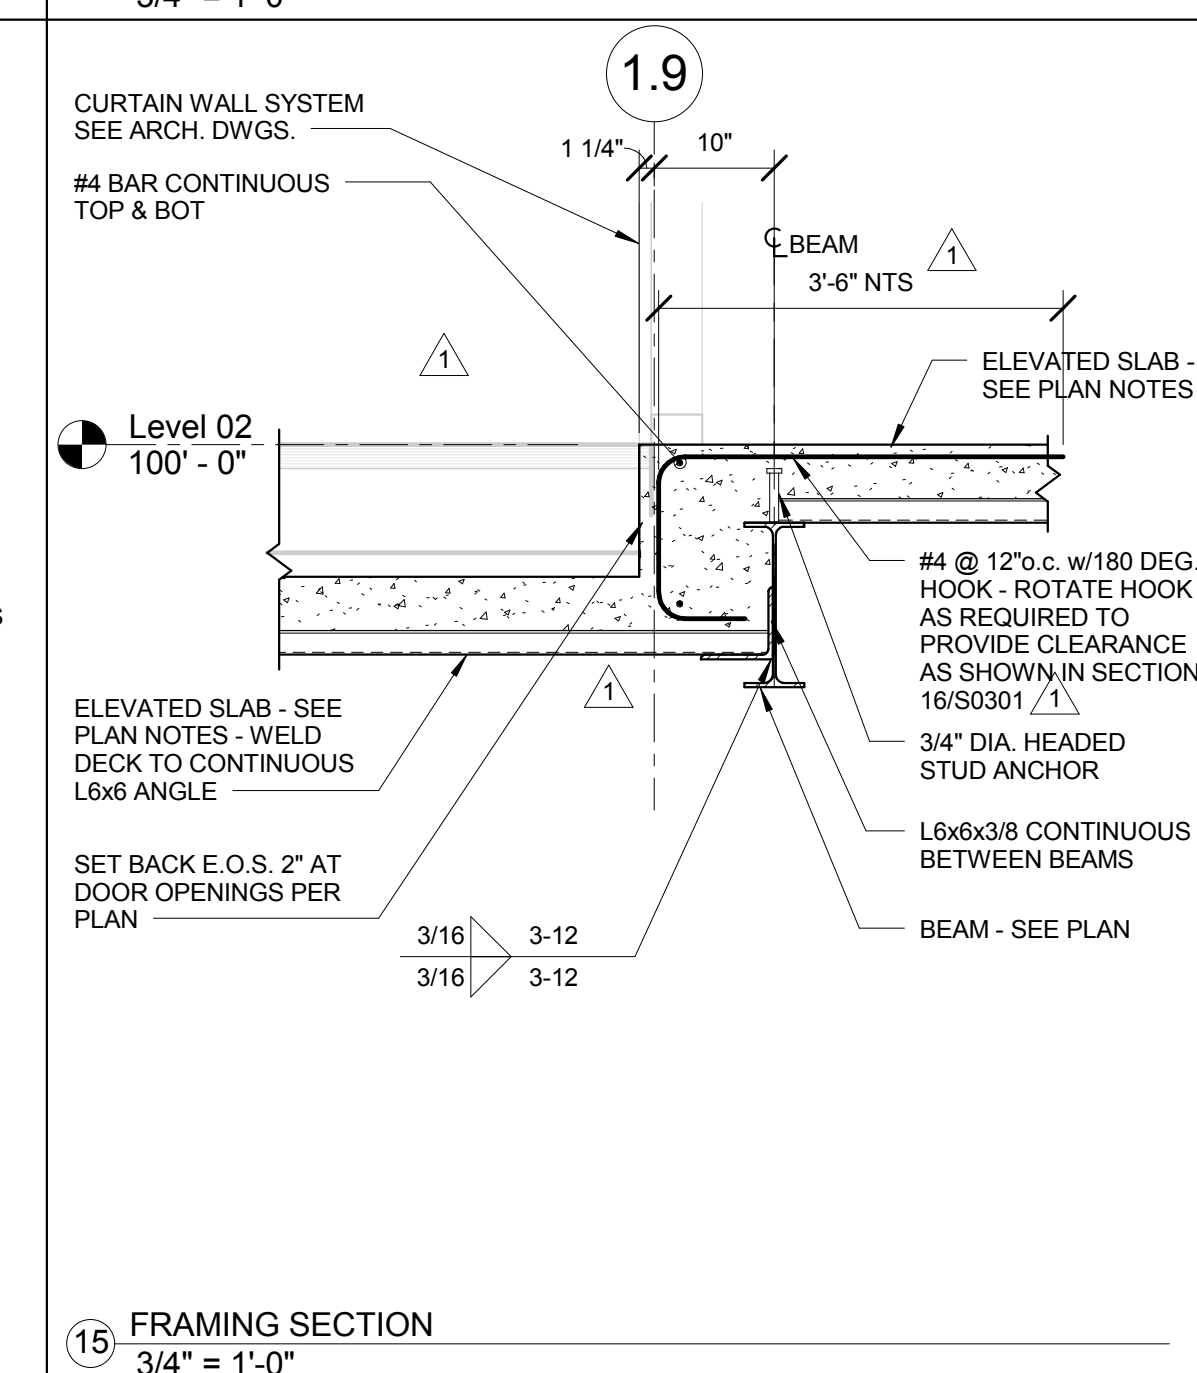
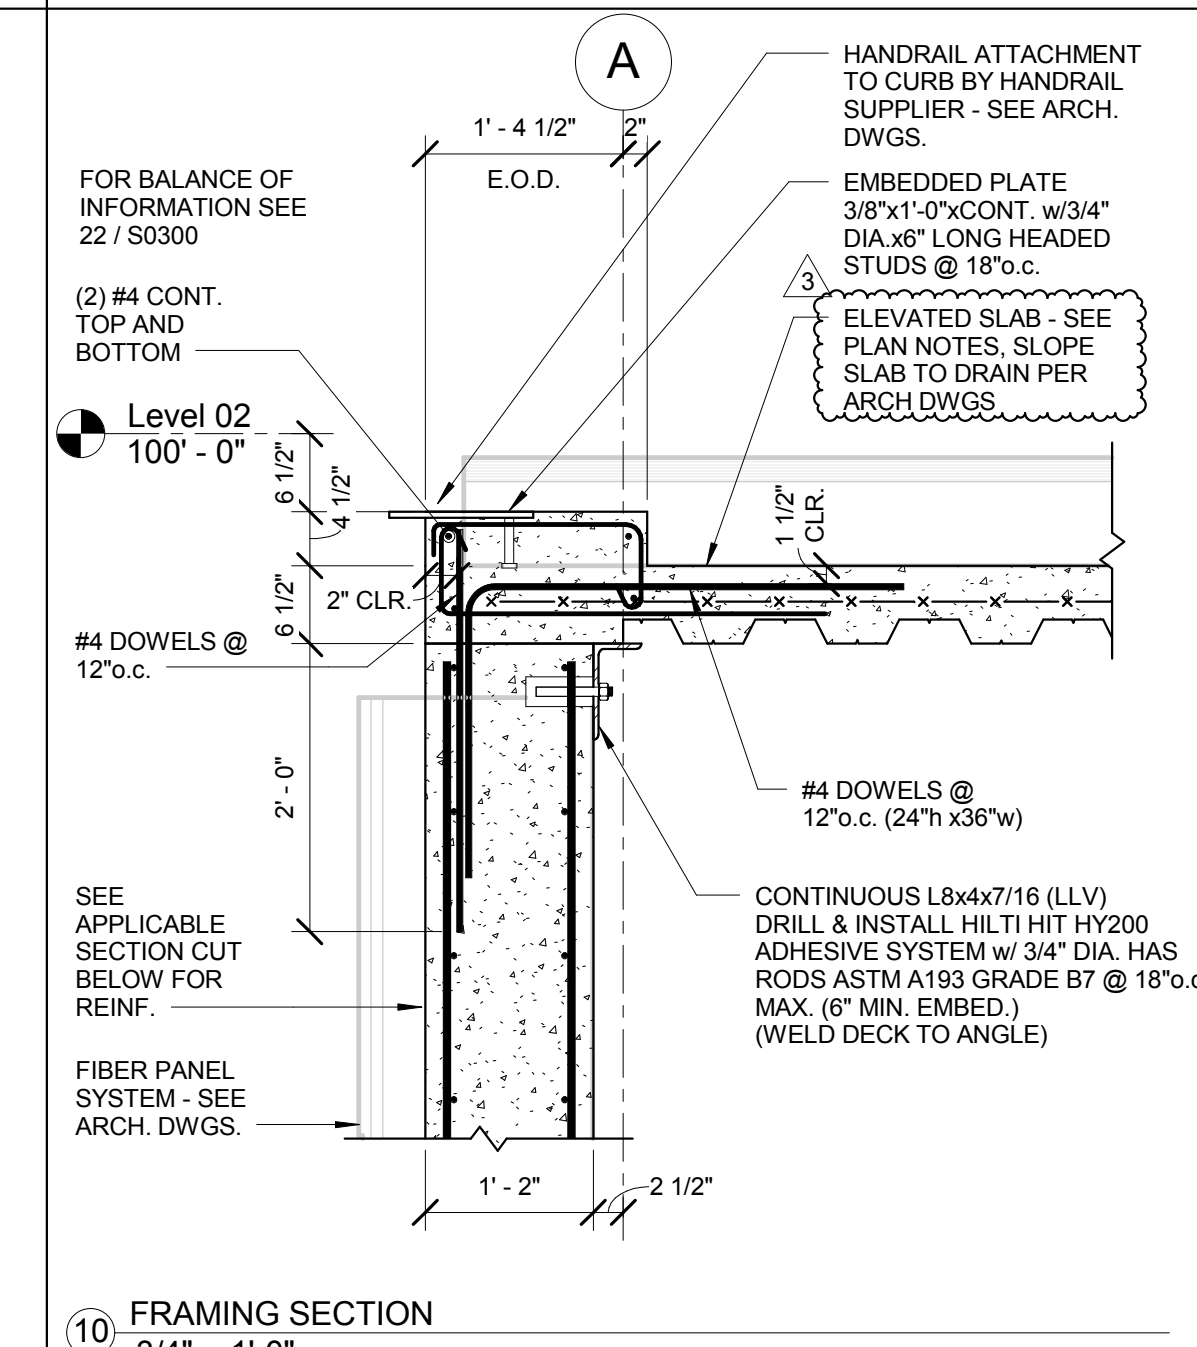
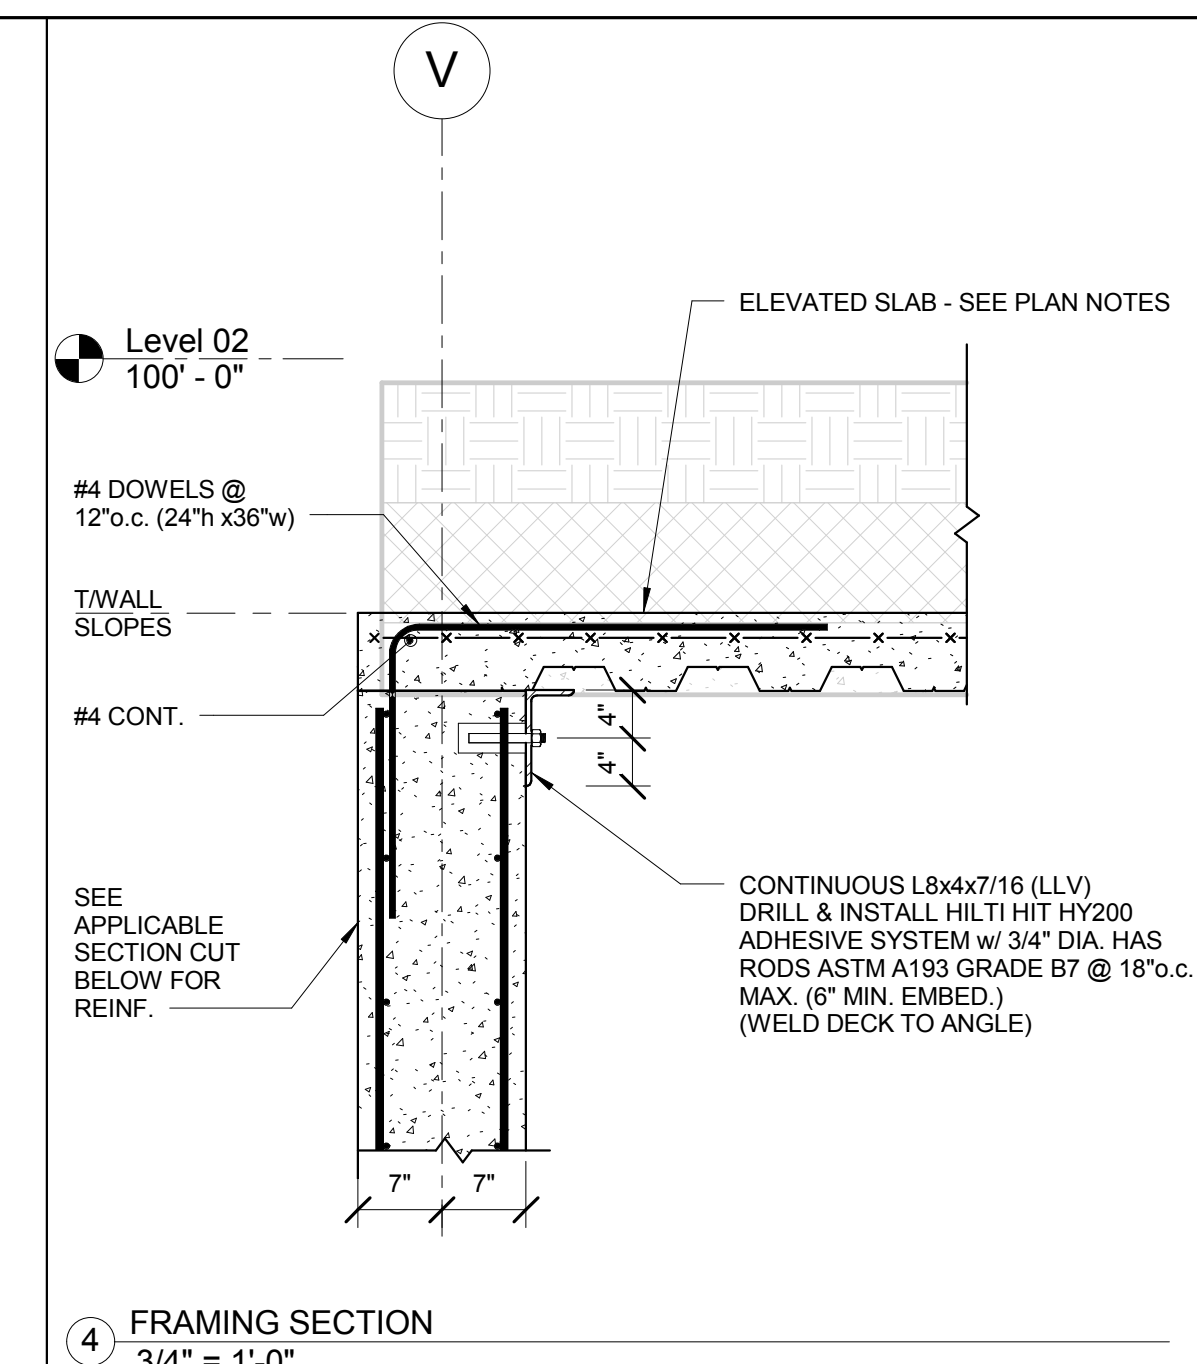
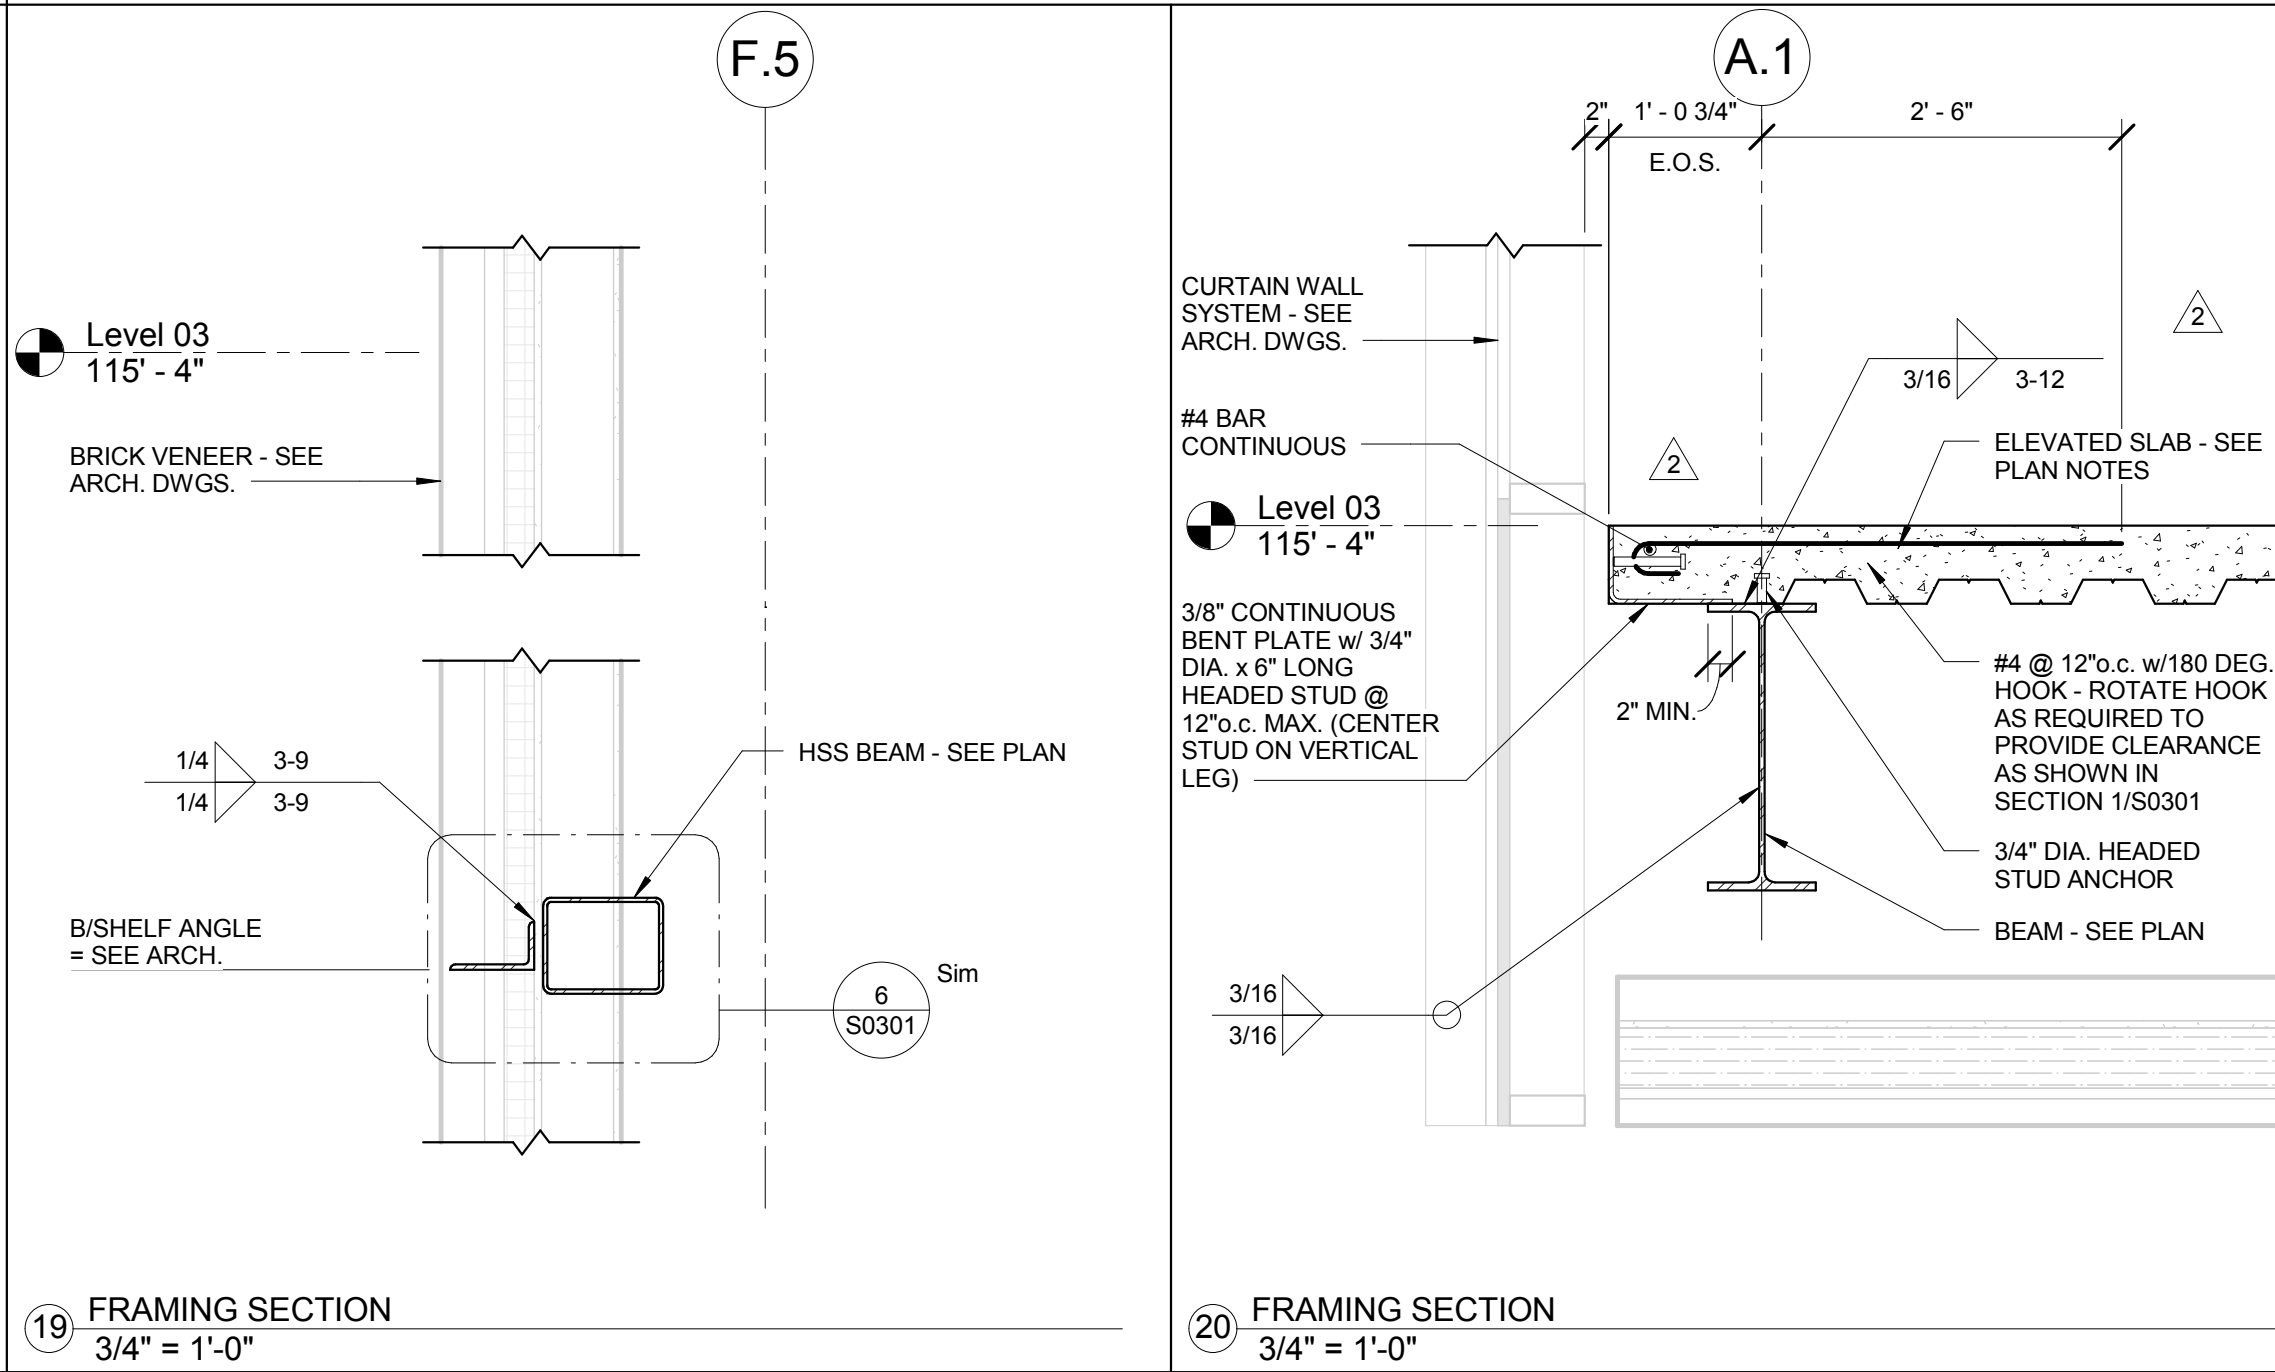
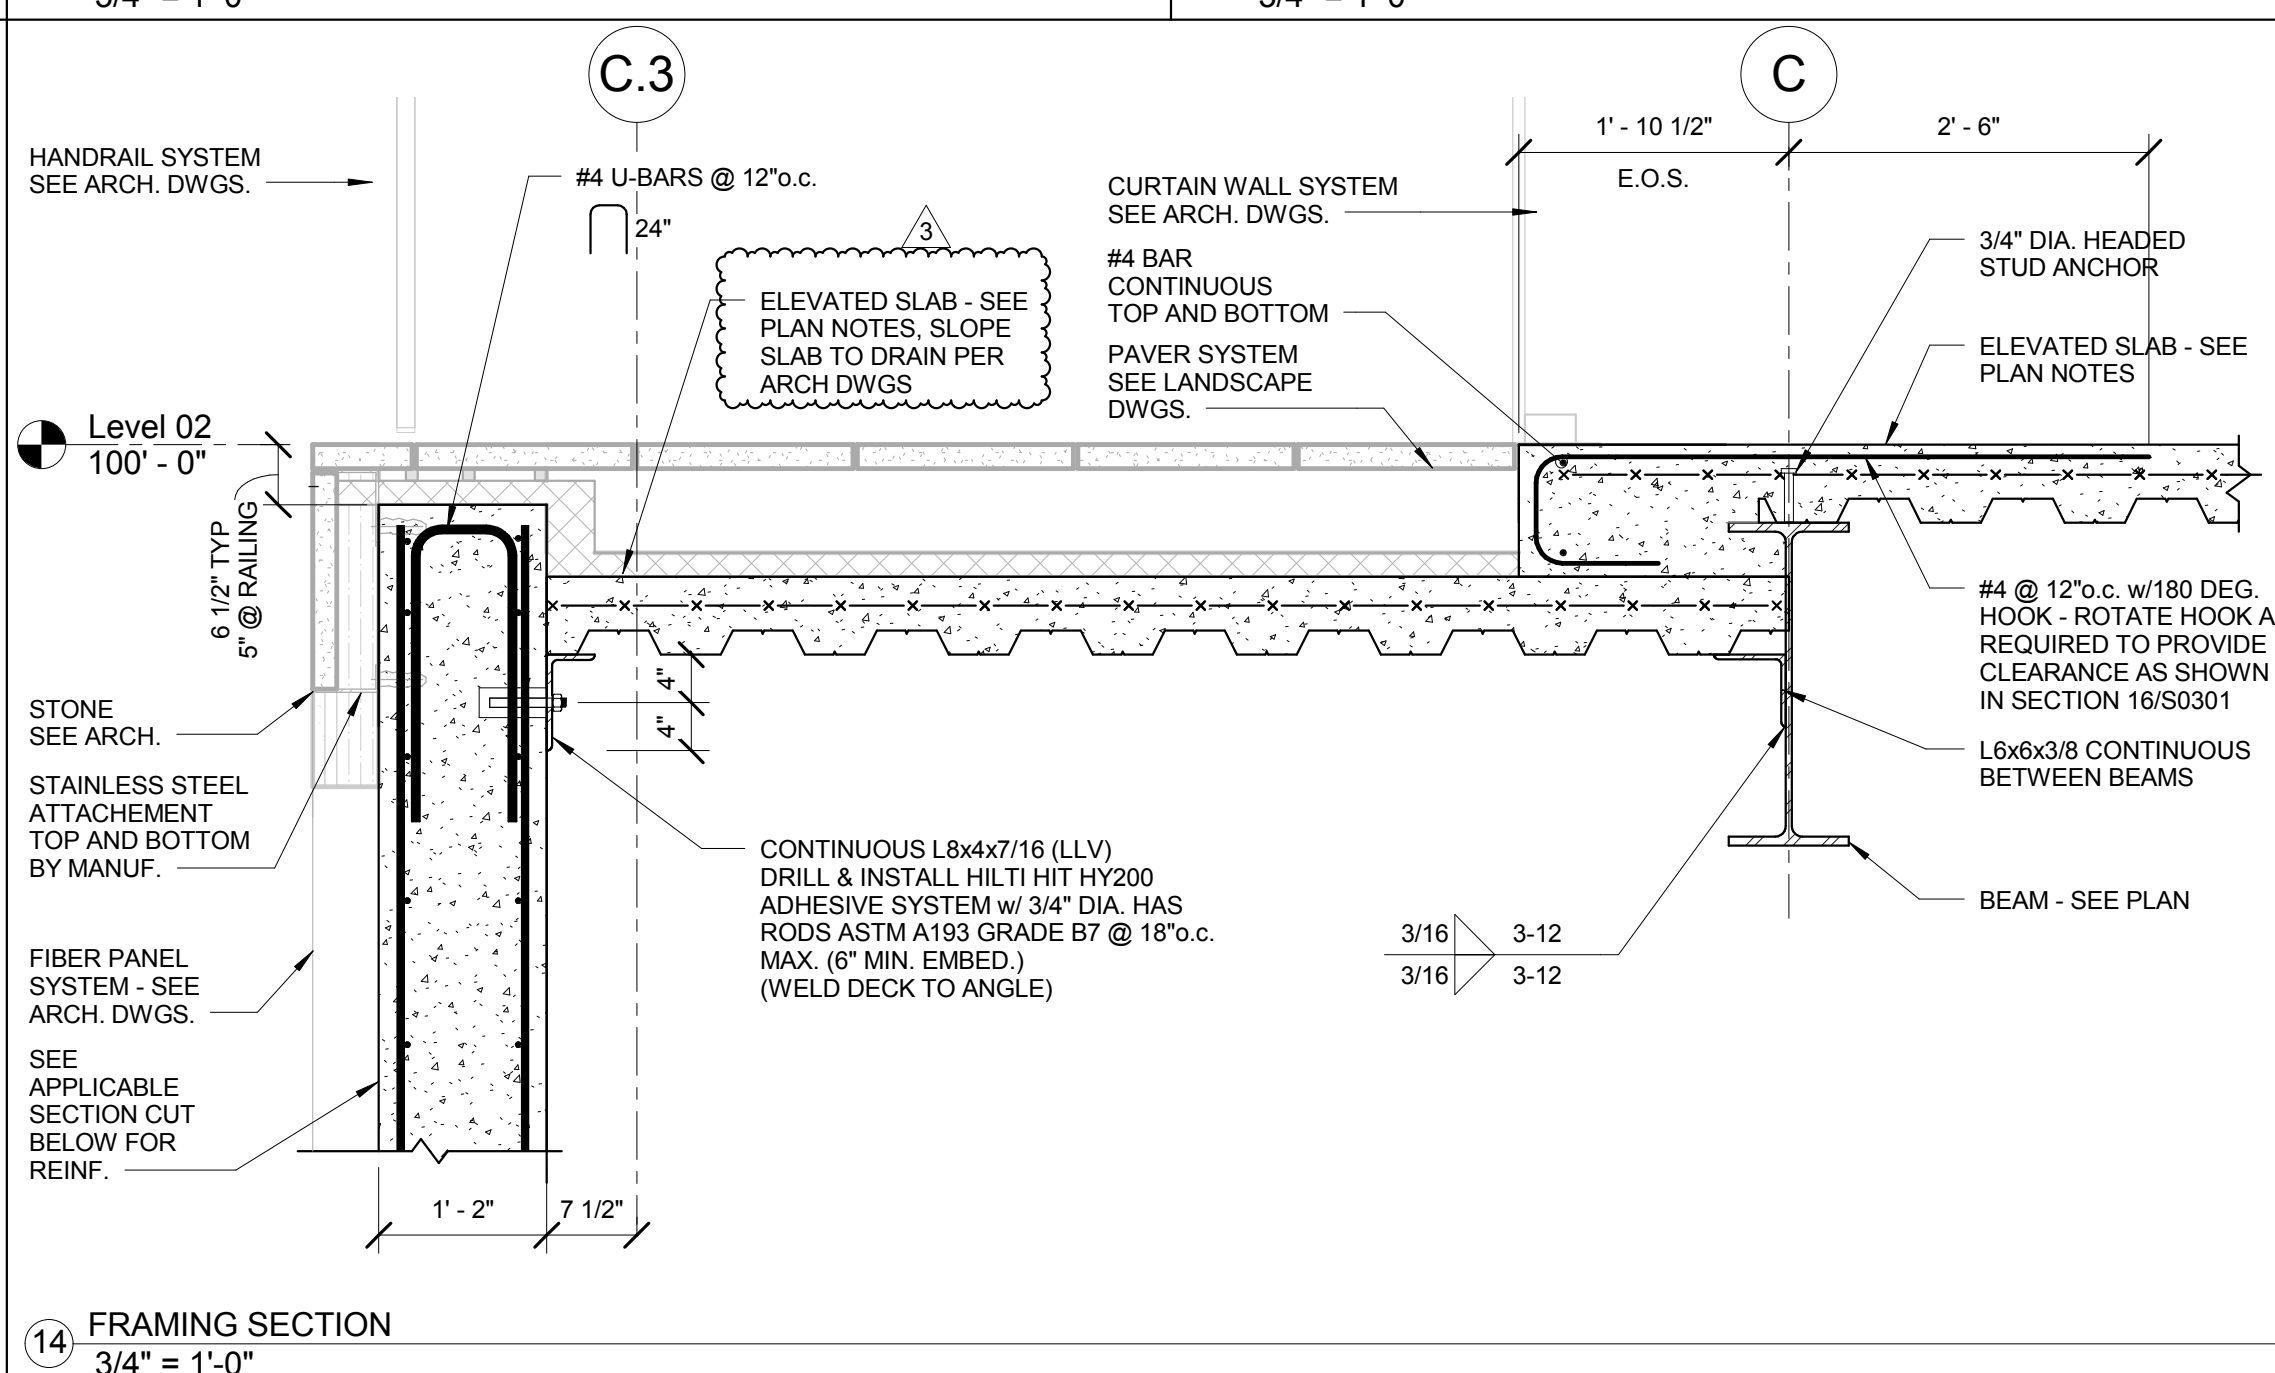
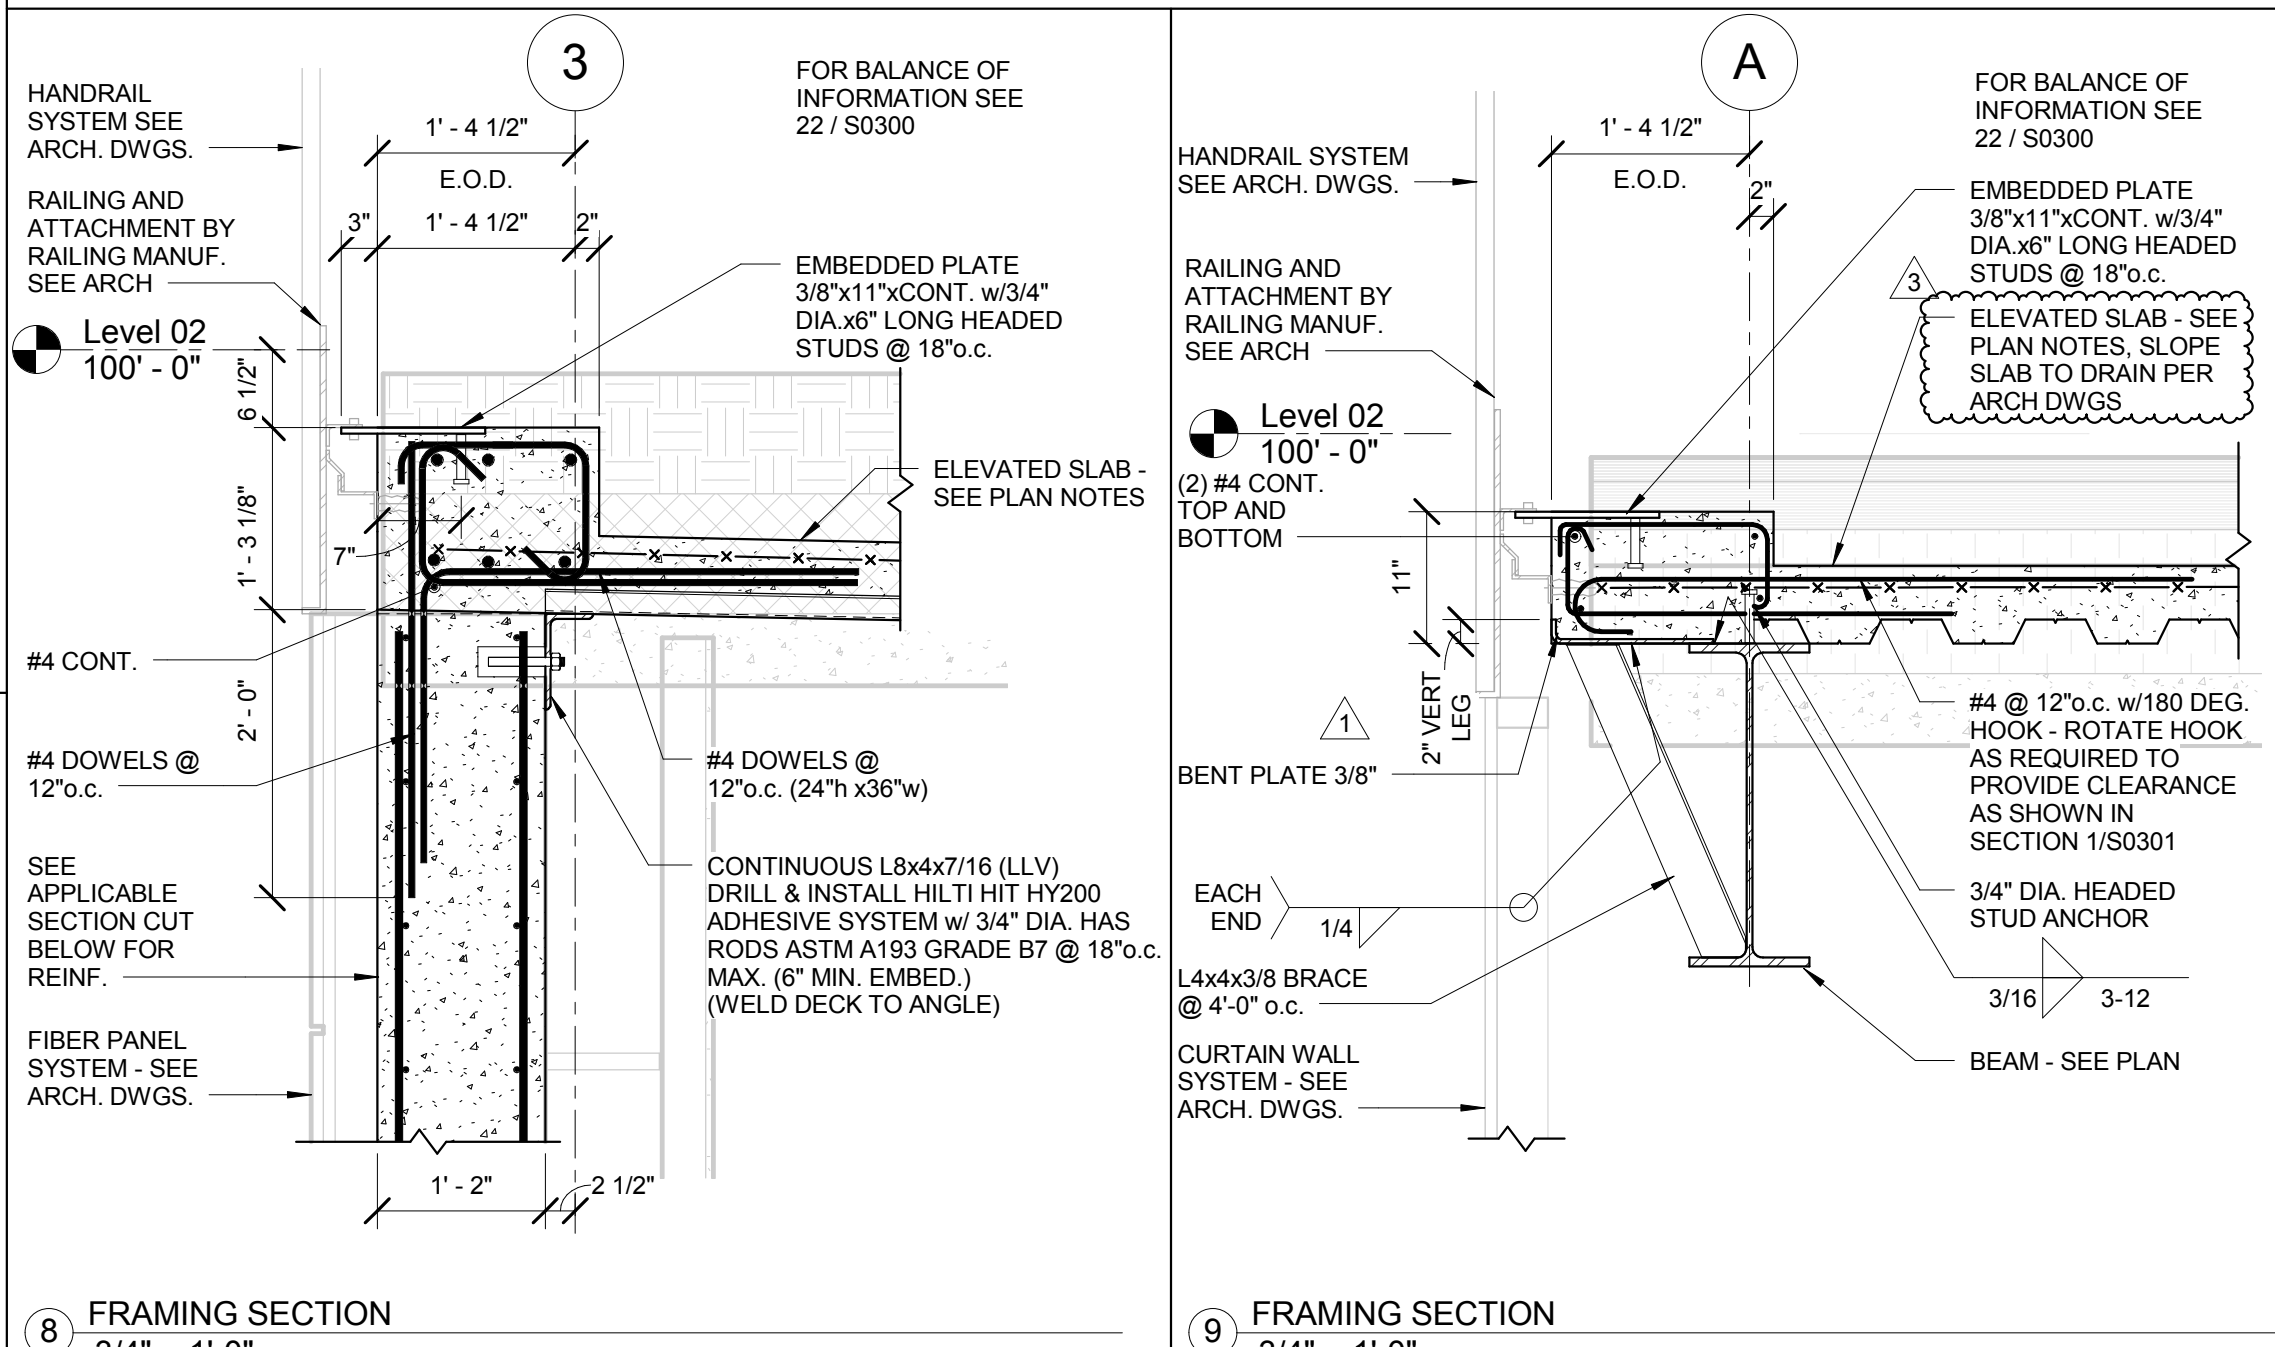
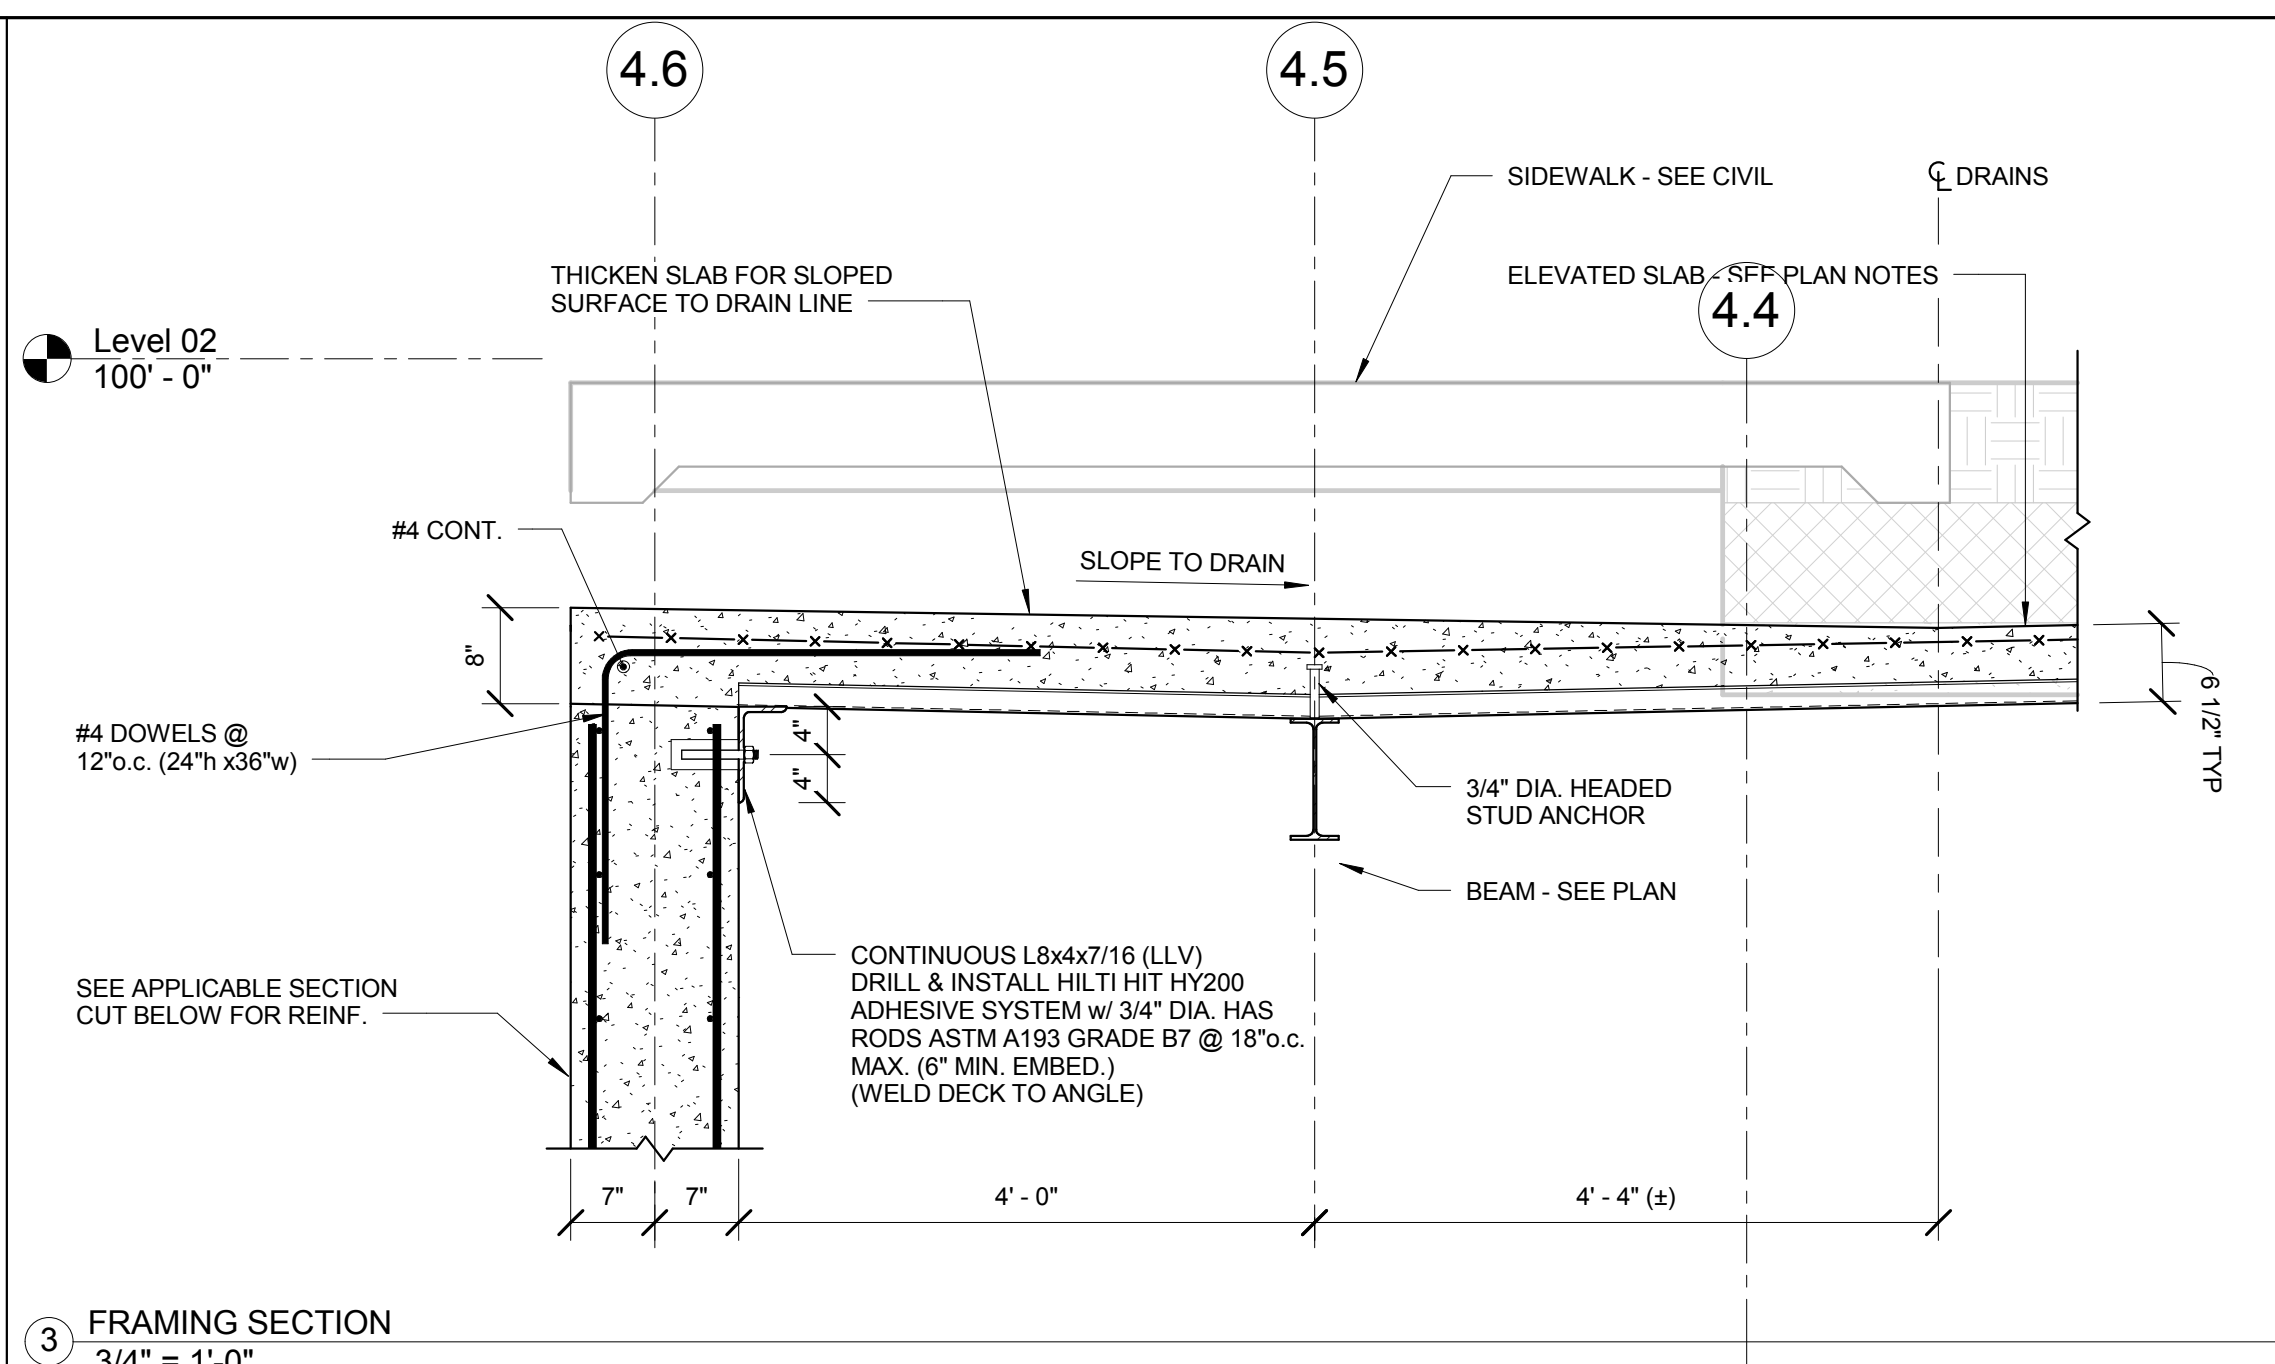
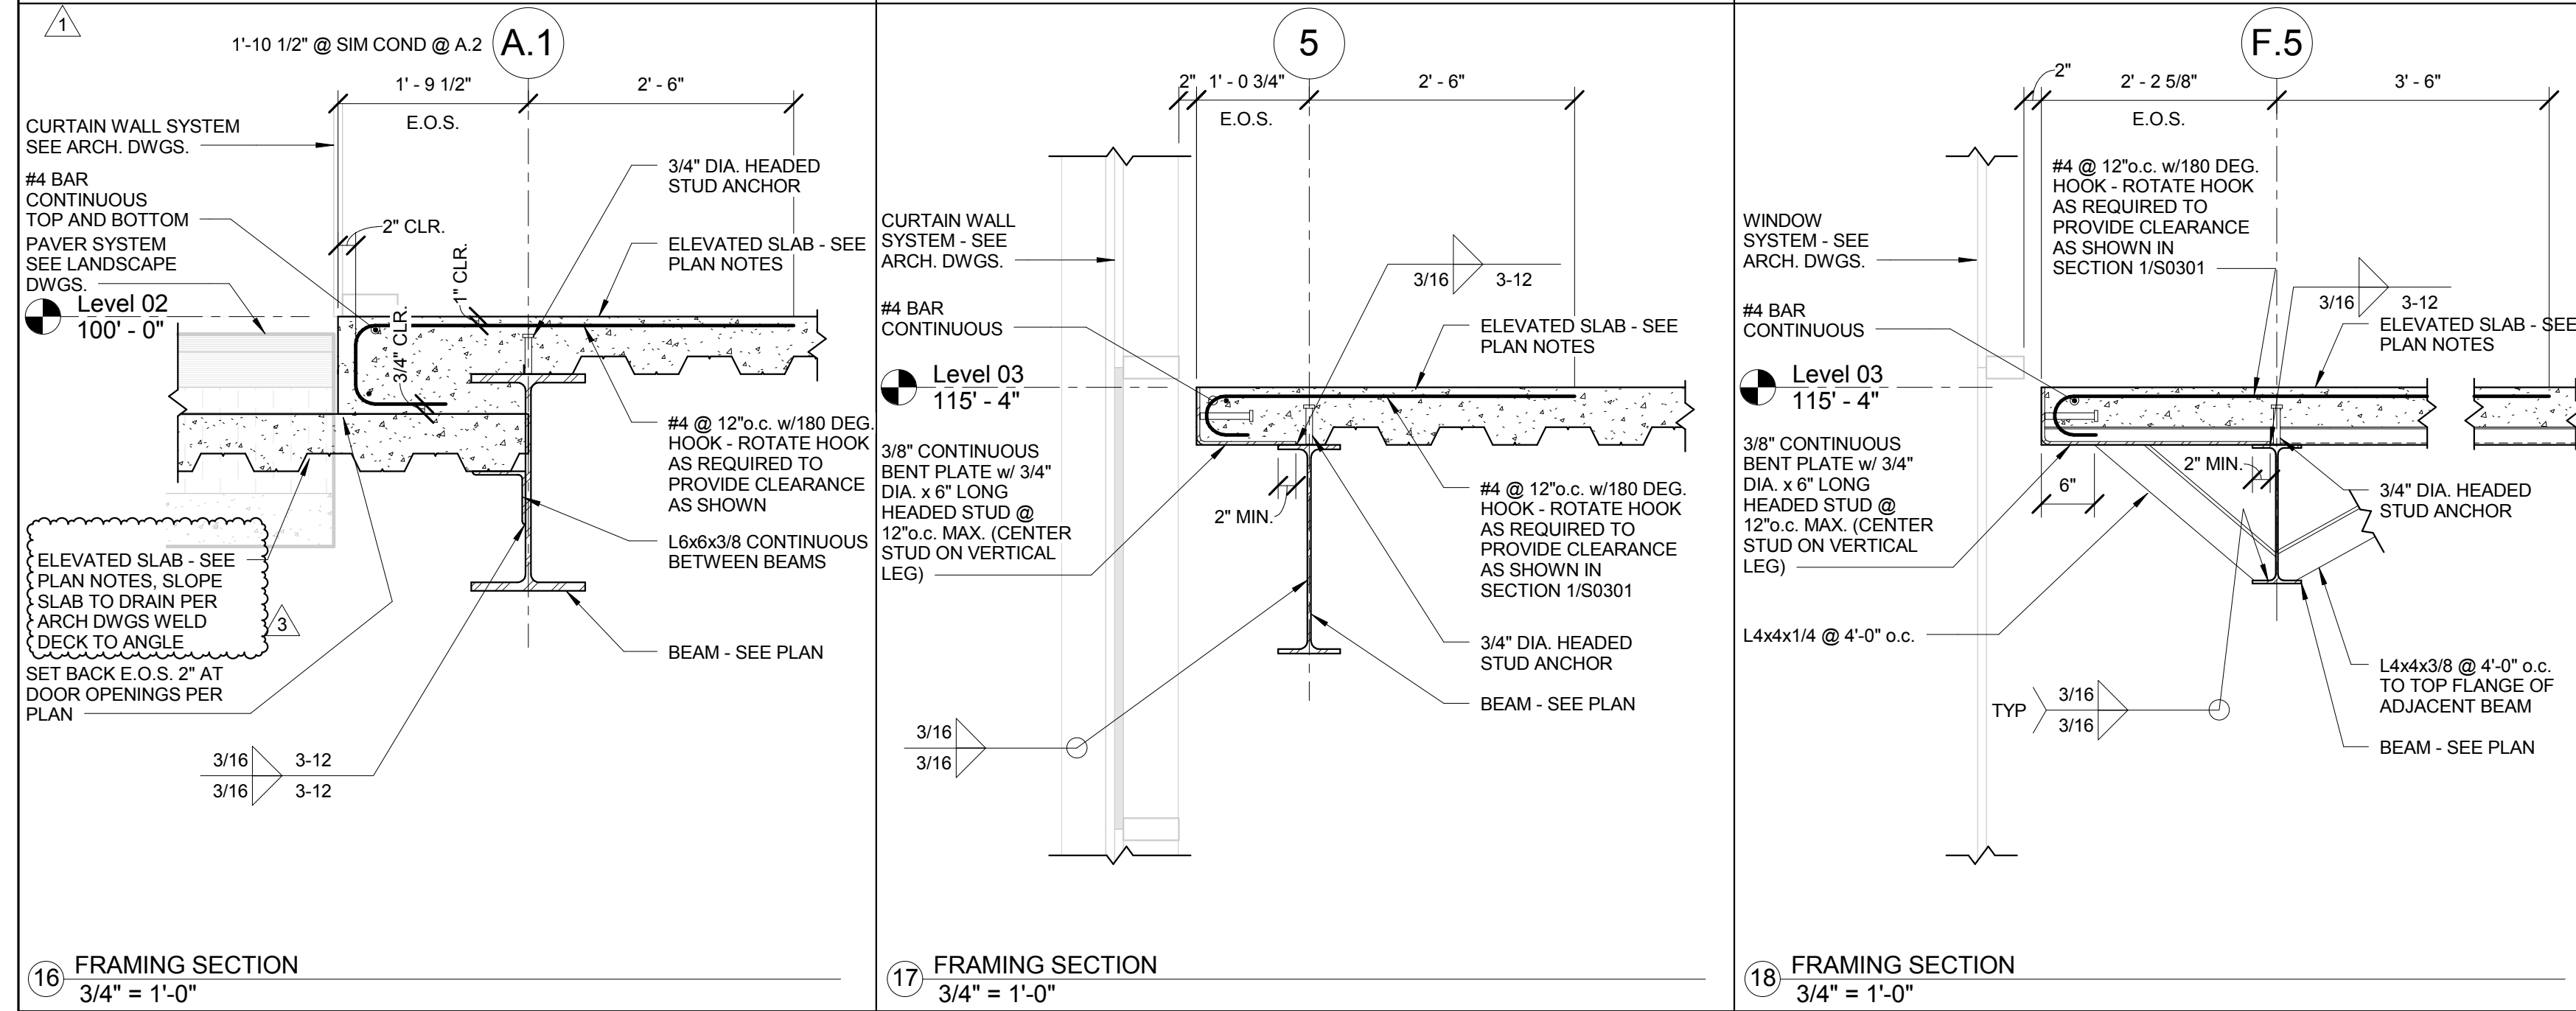
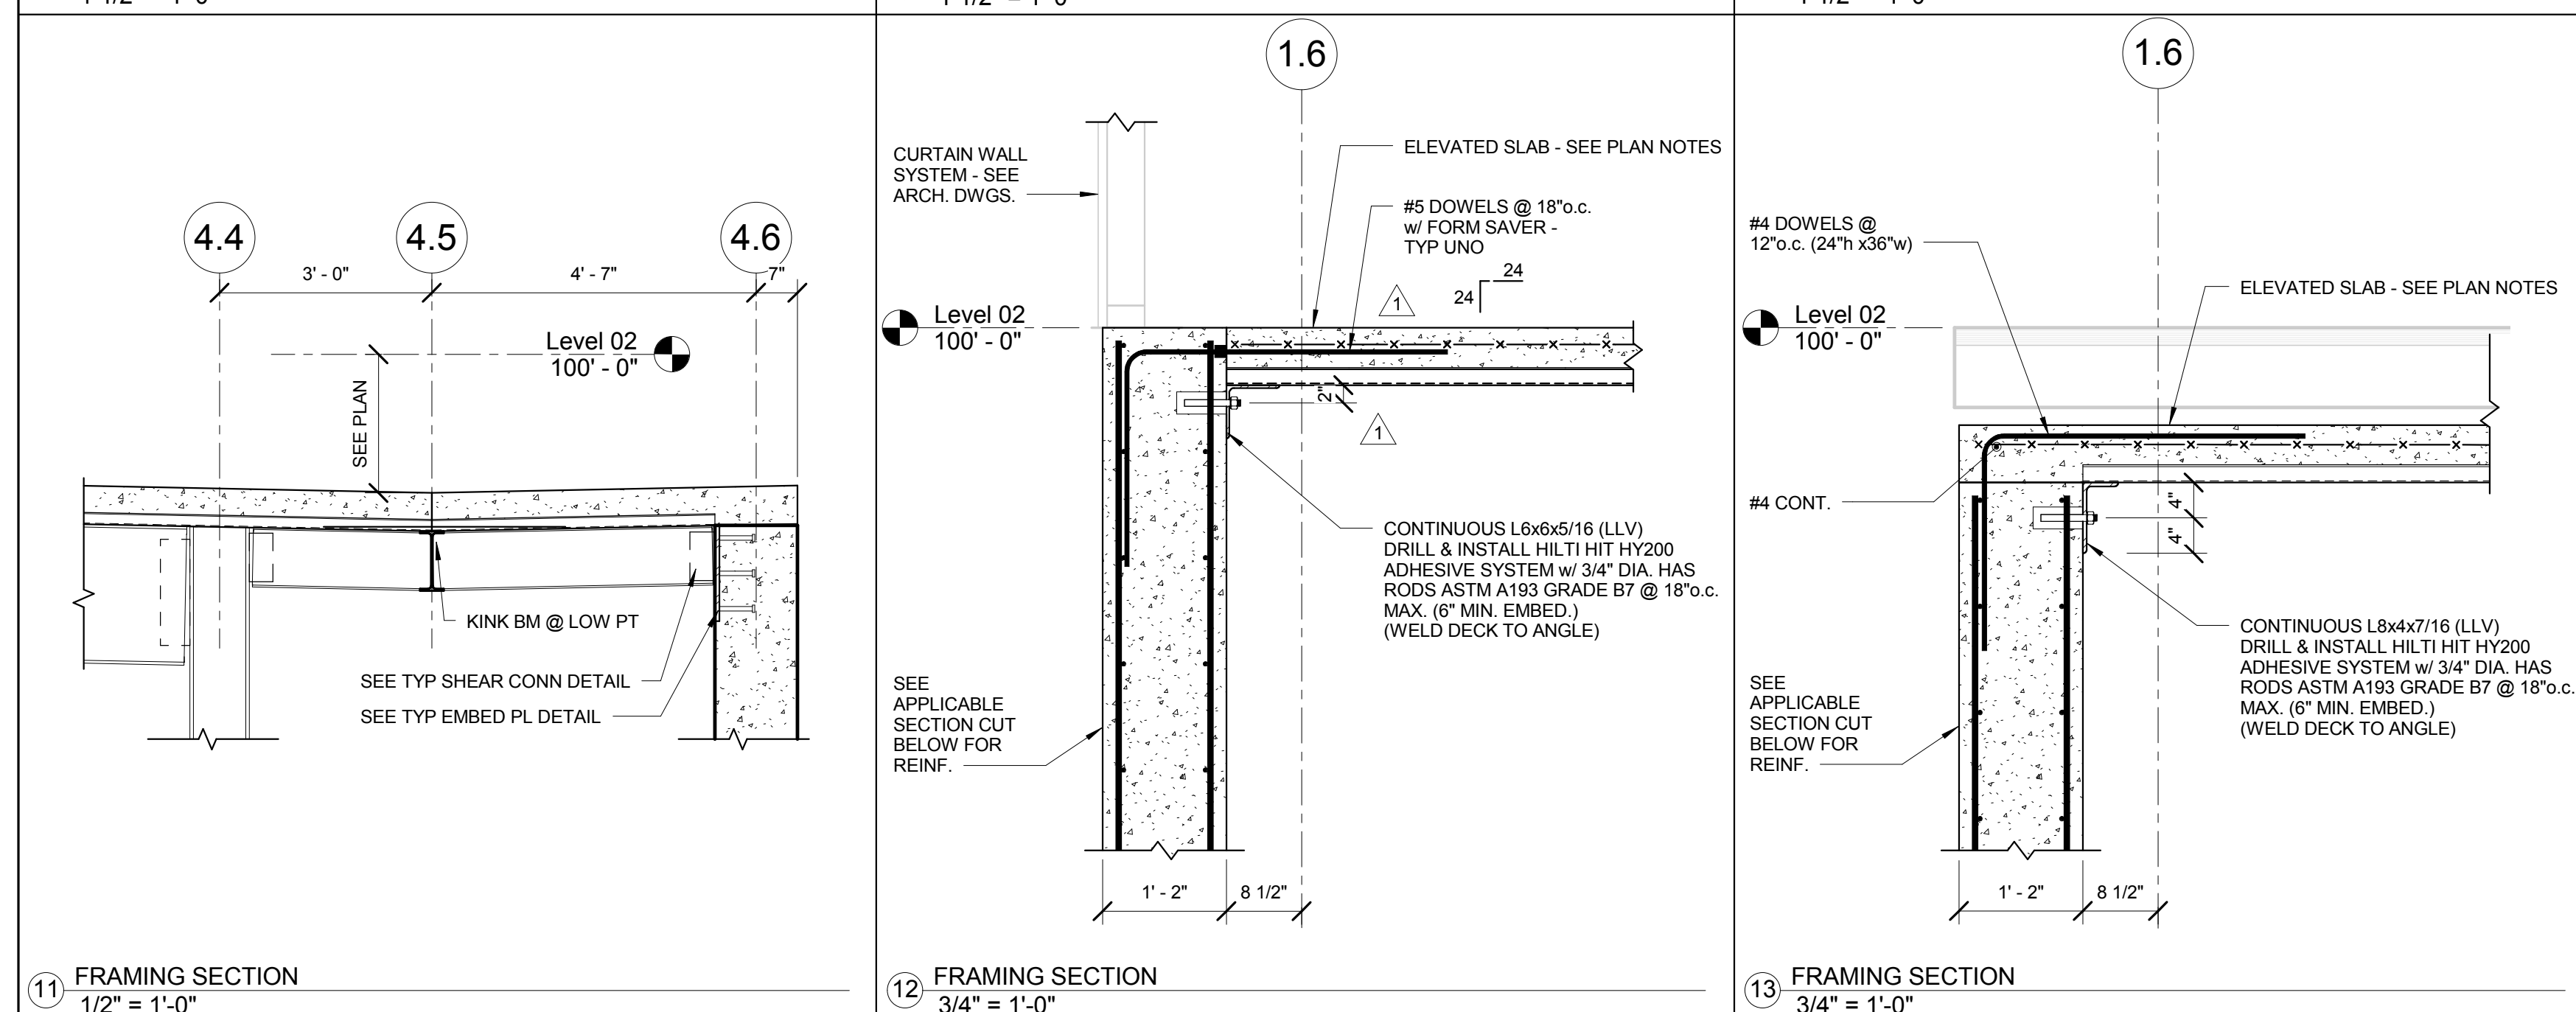
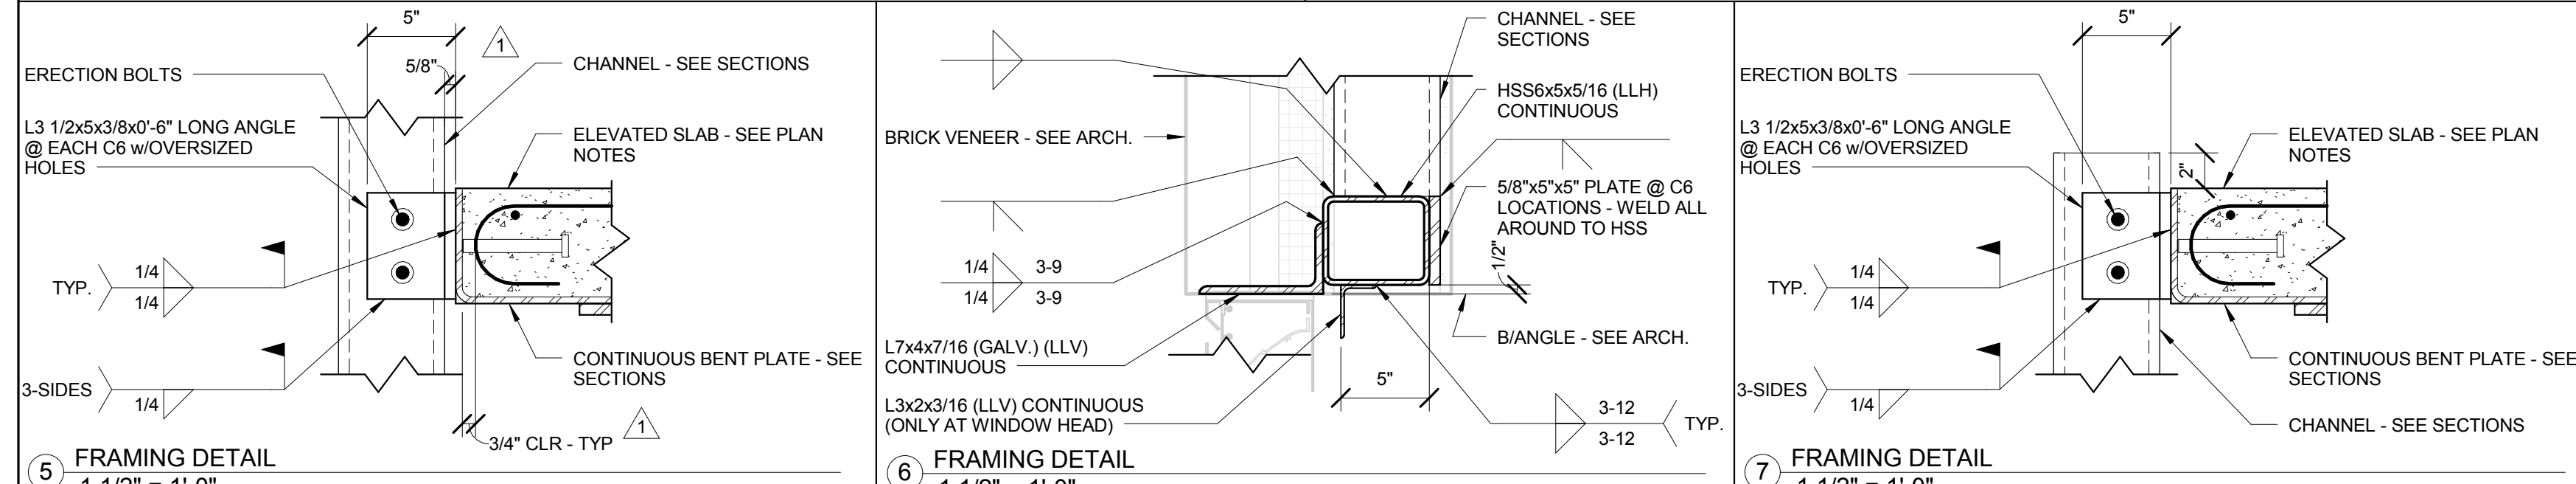


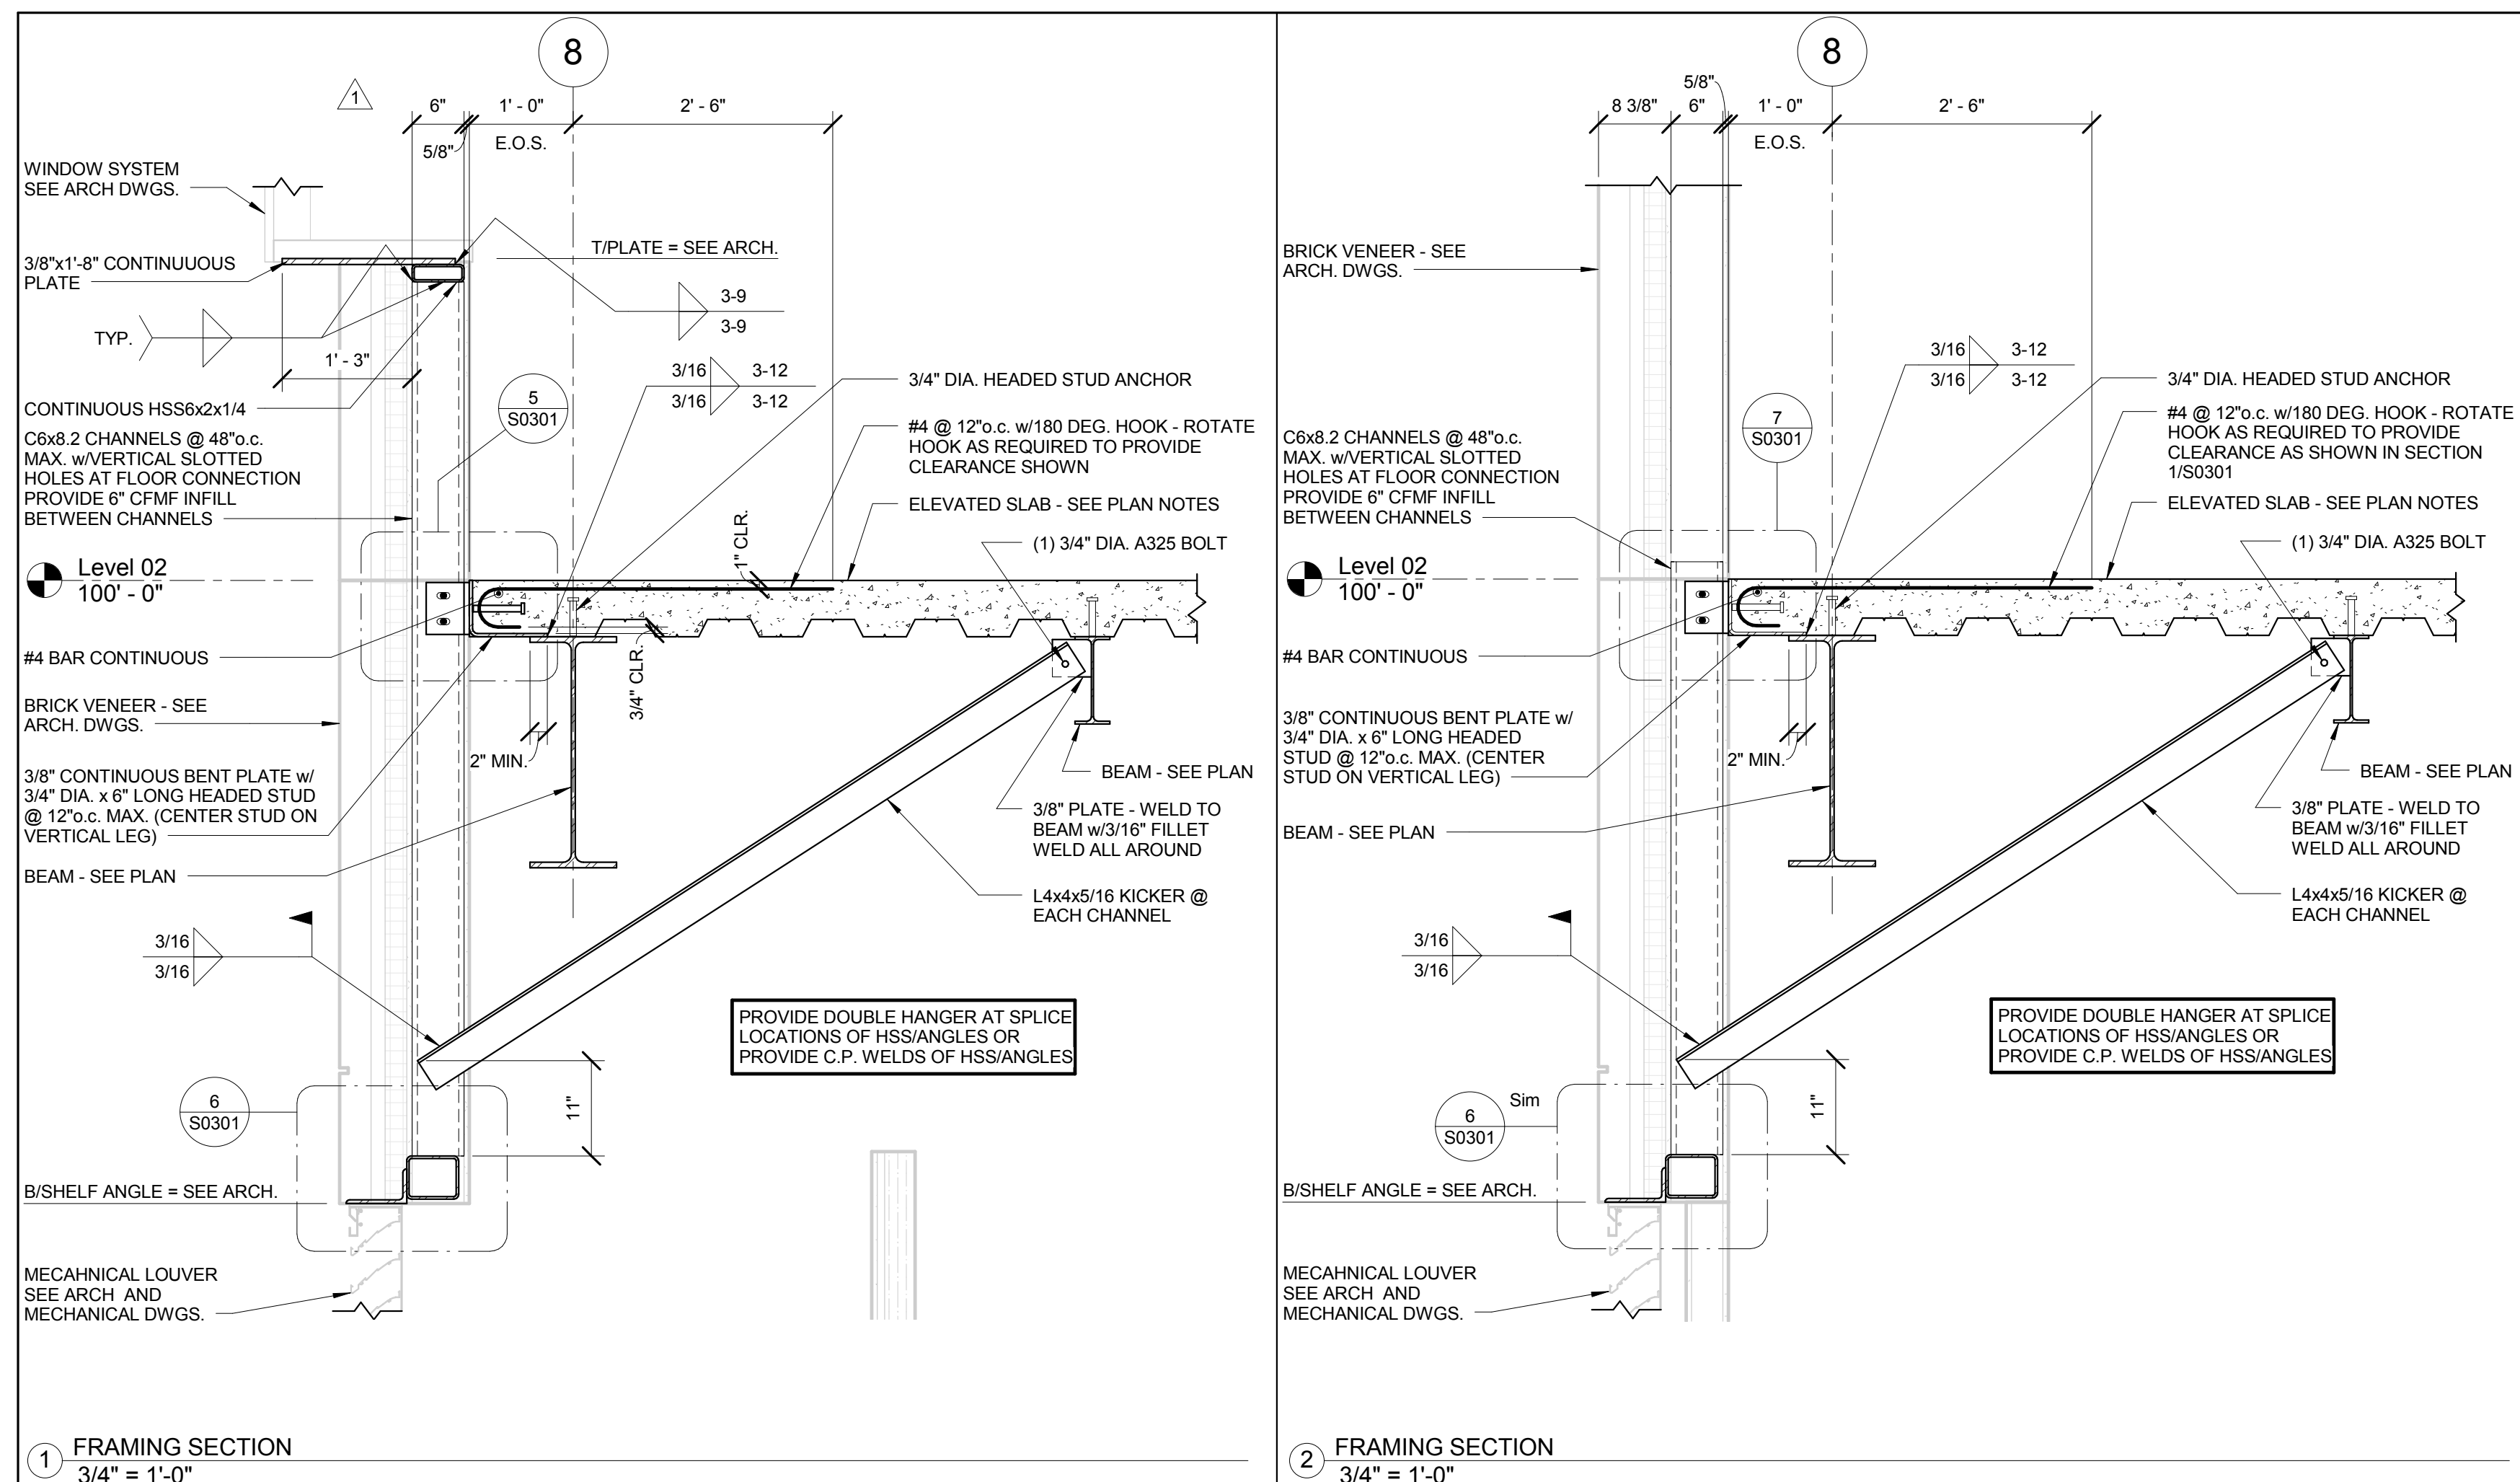

3	ADDENDUM 1-7	16 MAR 2016
2	ADDENDUM 1-2	01 FEB 2016
1	ADDENDUM 1-1	29 JAN 2016
-	ISSUED FOR CONSTRUCTION (BPT)	15 JAN 2016
No.	Description	Date

Drawing Title:

**FRAMING SECTIONS AND
DETAILS**

Project No.: 04561.01

Checked by:

S0301