


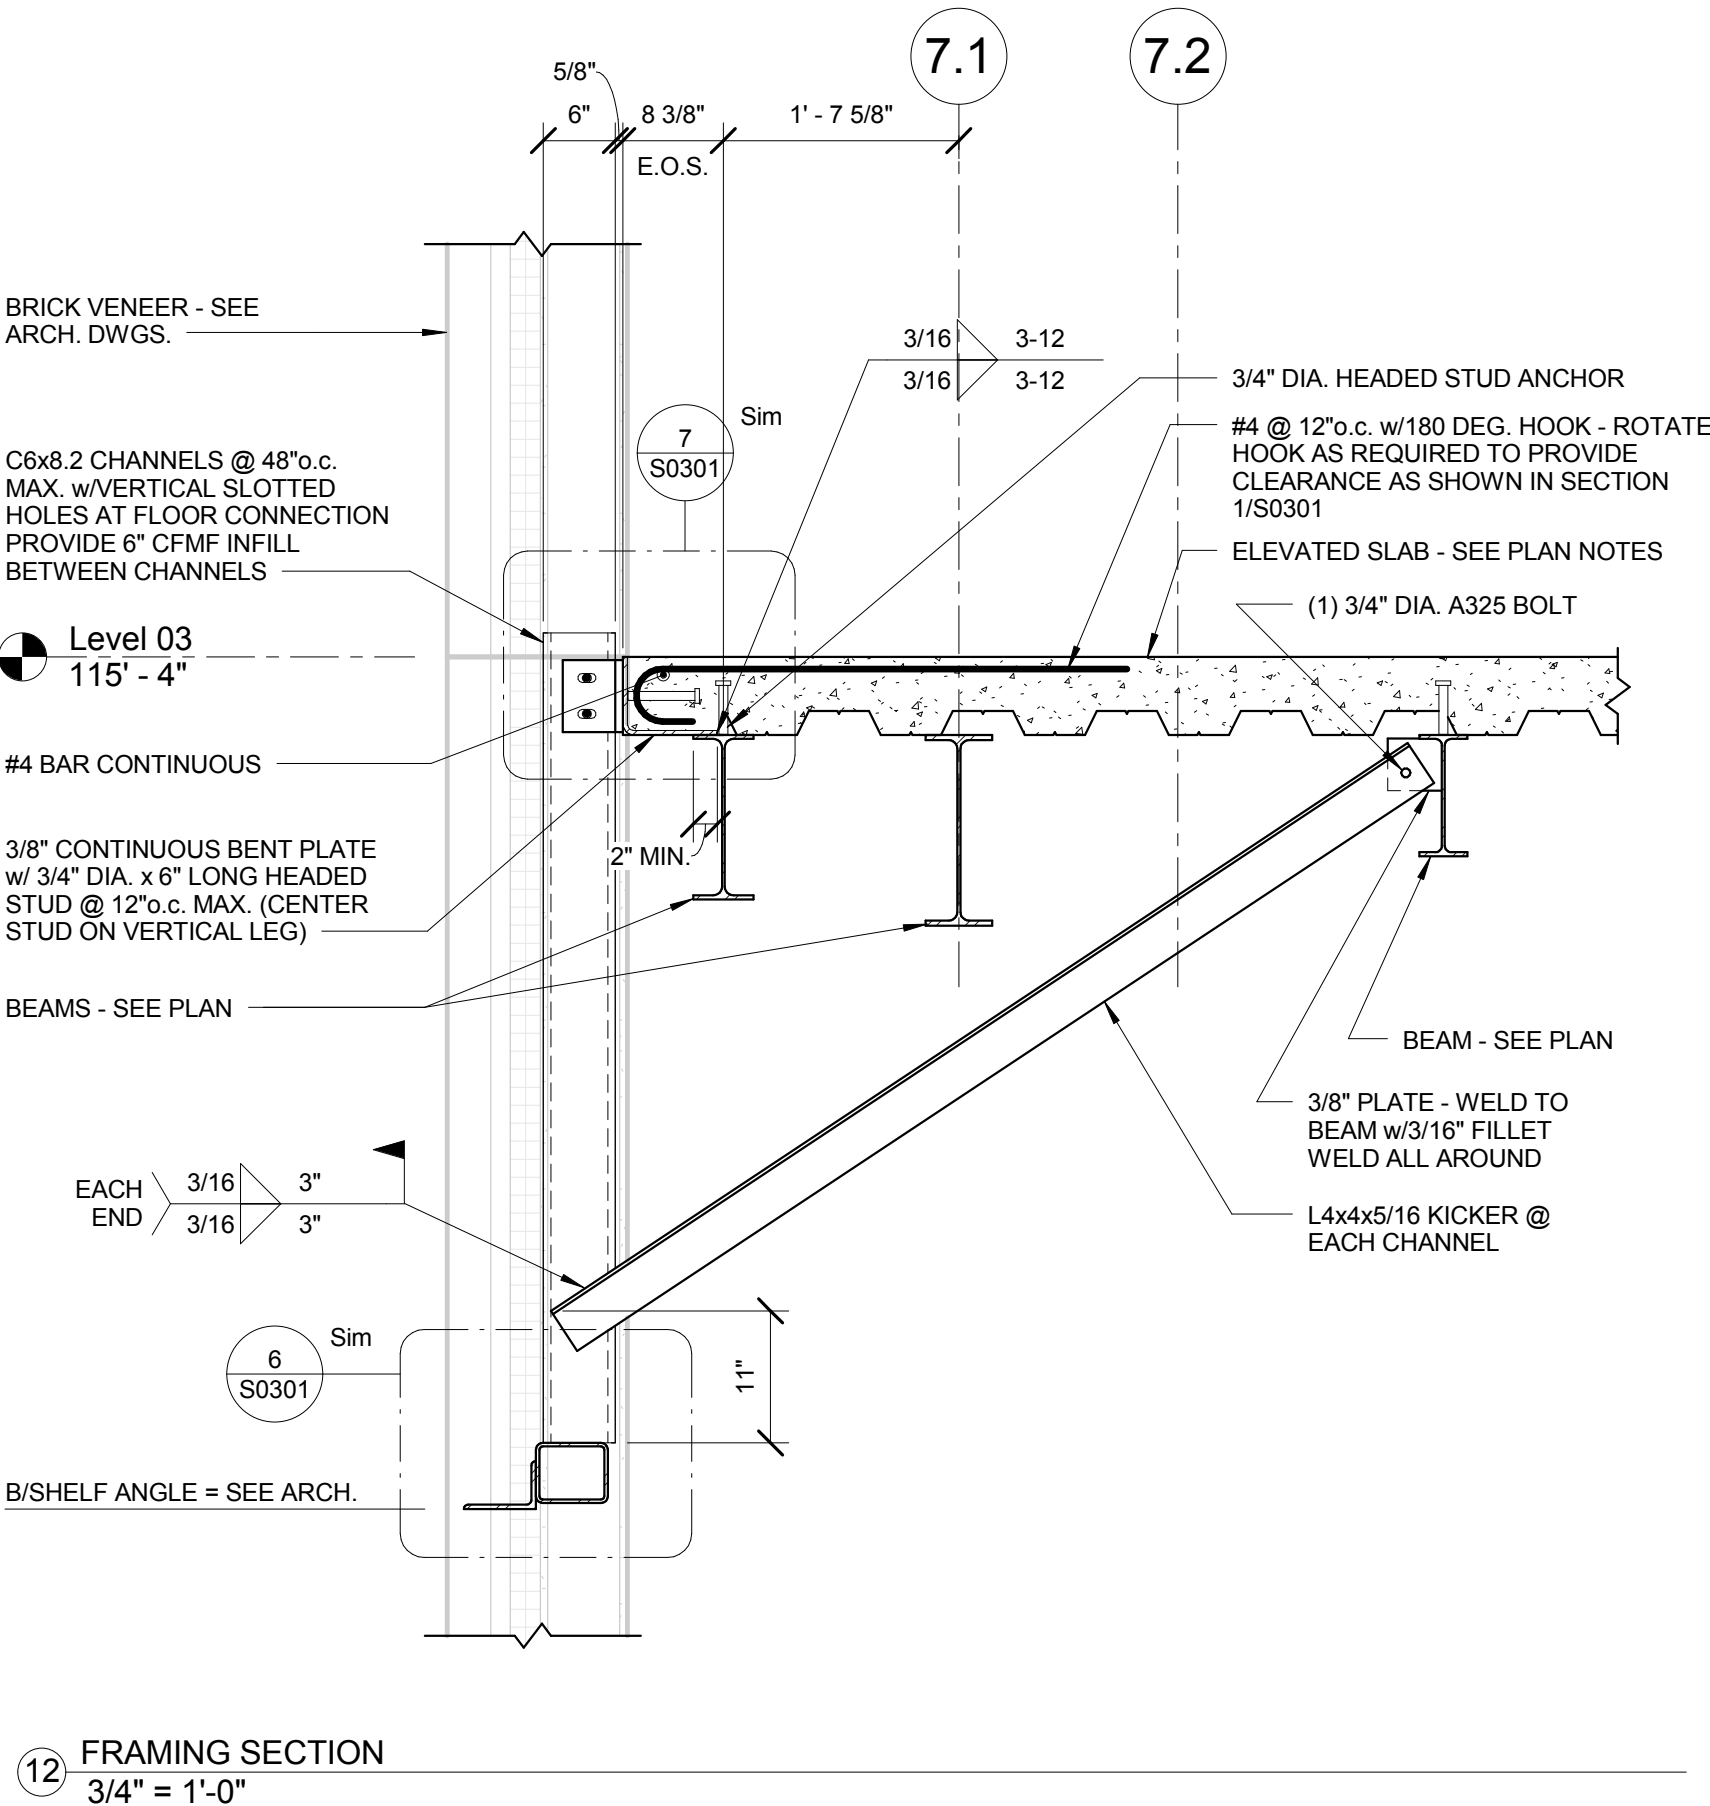

© Cannon Design 2015

© Cannon Design 2015
All rights reserved. No part of this document may
be reproduced or utilized in any form, without prior
written authorization by The Cannon Corporation.
8/23/2016 2:40:37 PM