




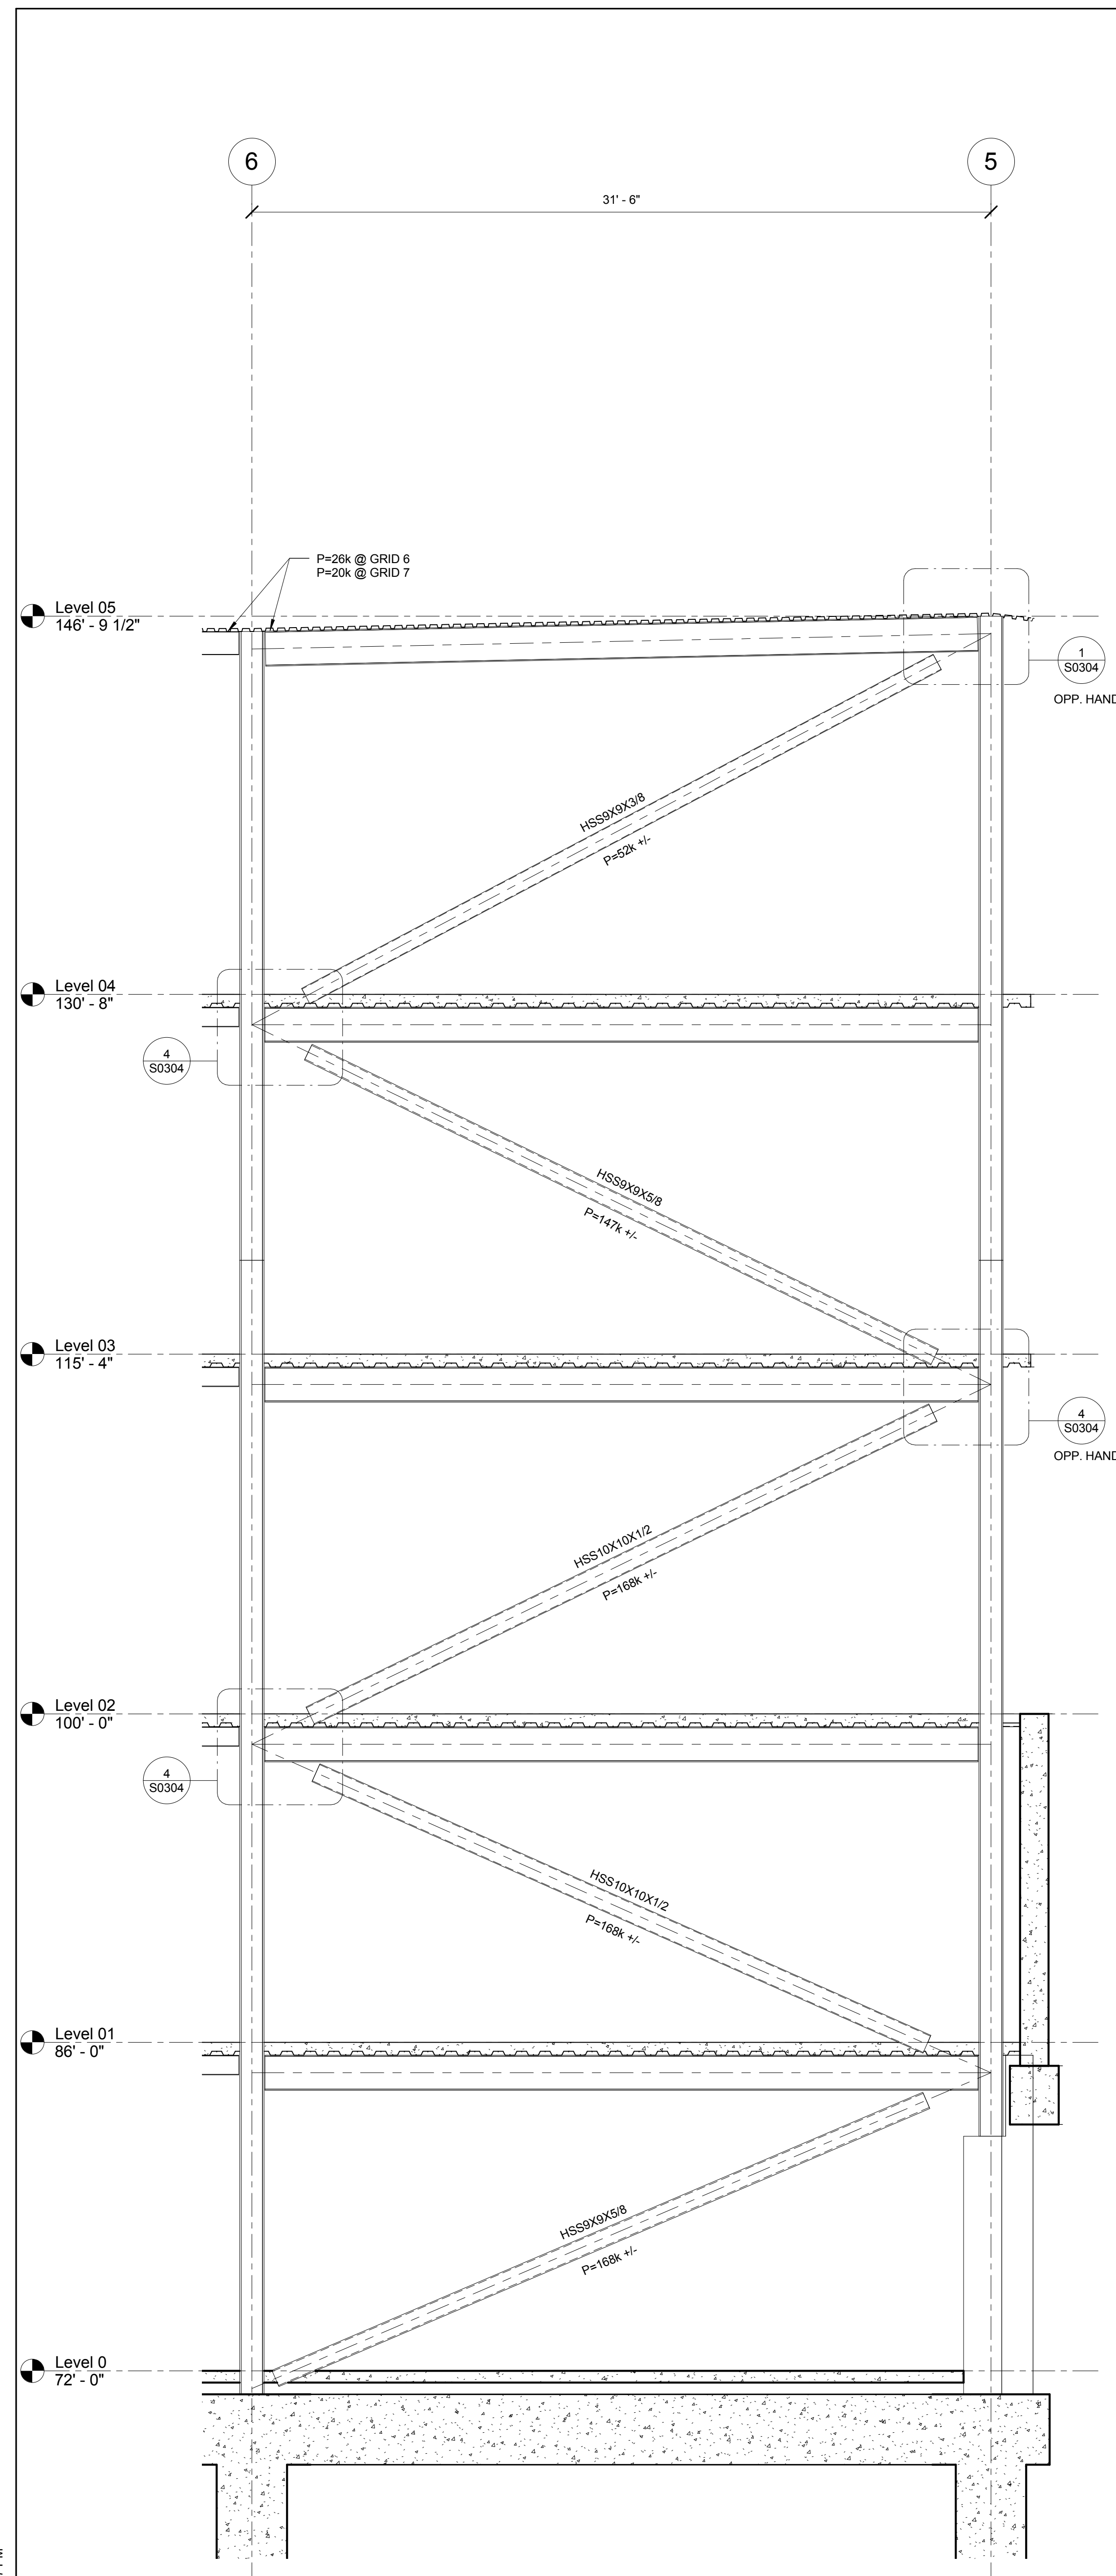

1 BRACED FRAME ELEVATION - BF-1
1/4" = 1'-0"

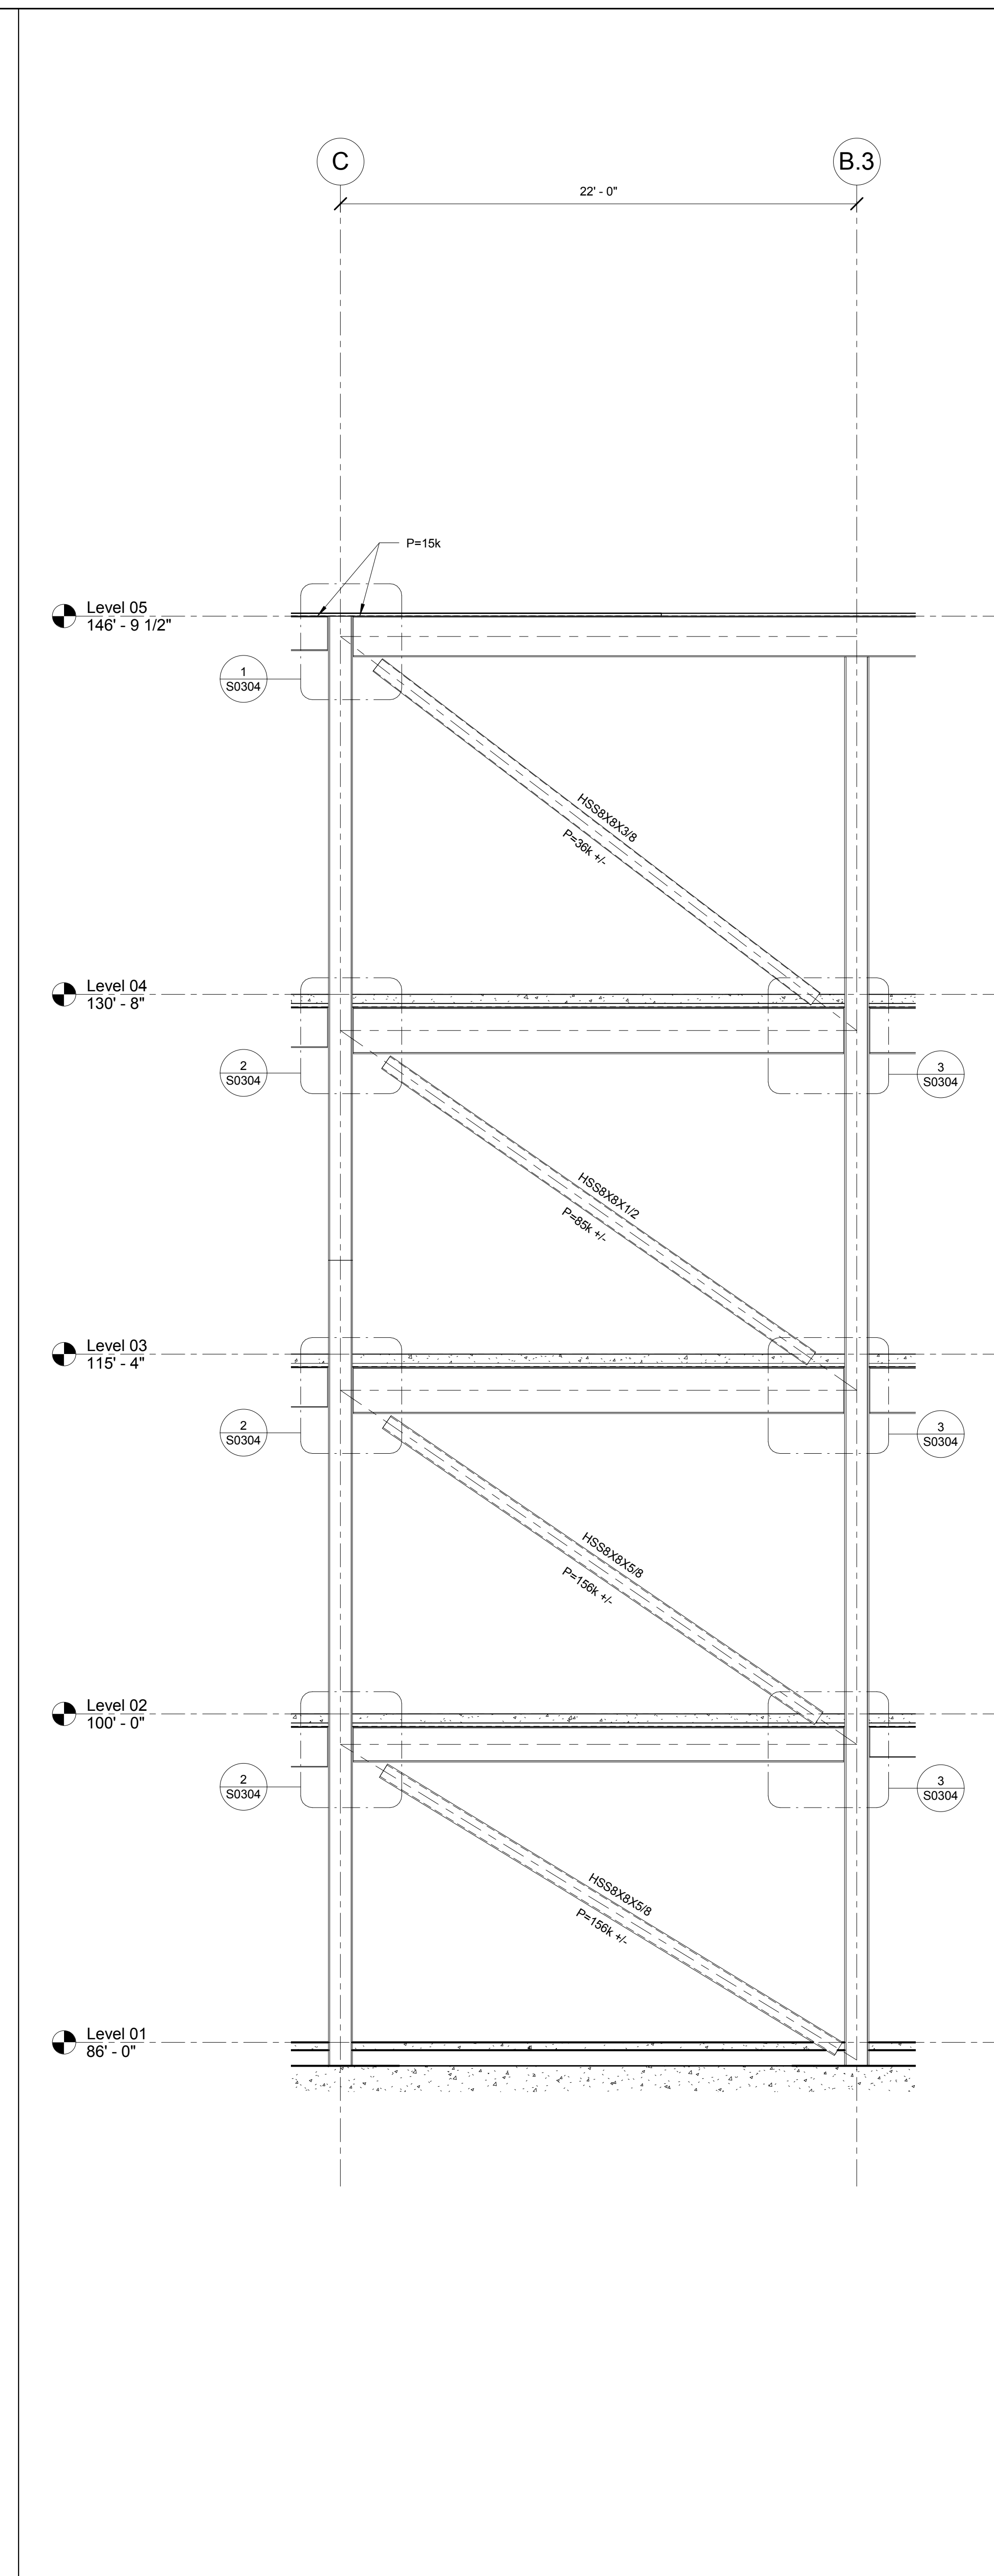

2 BRACED FRAME ELEVATION - BF-2
1/4" = 1'-0"

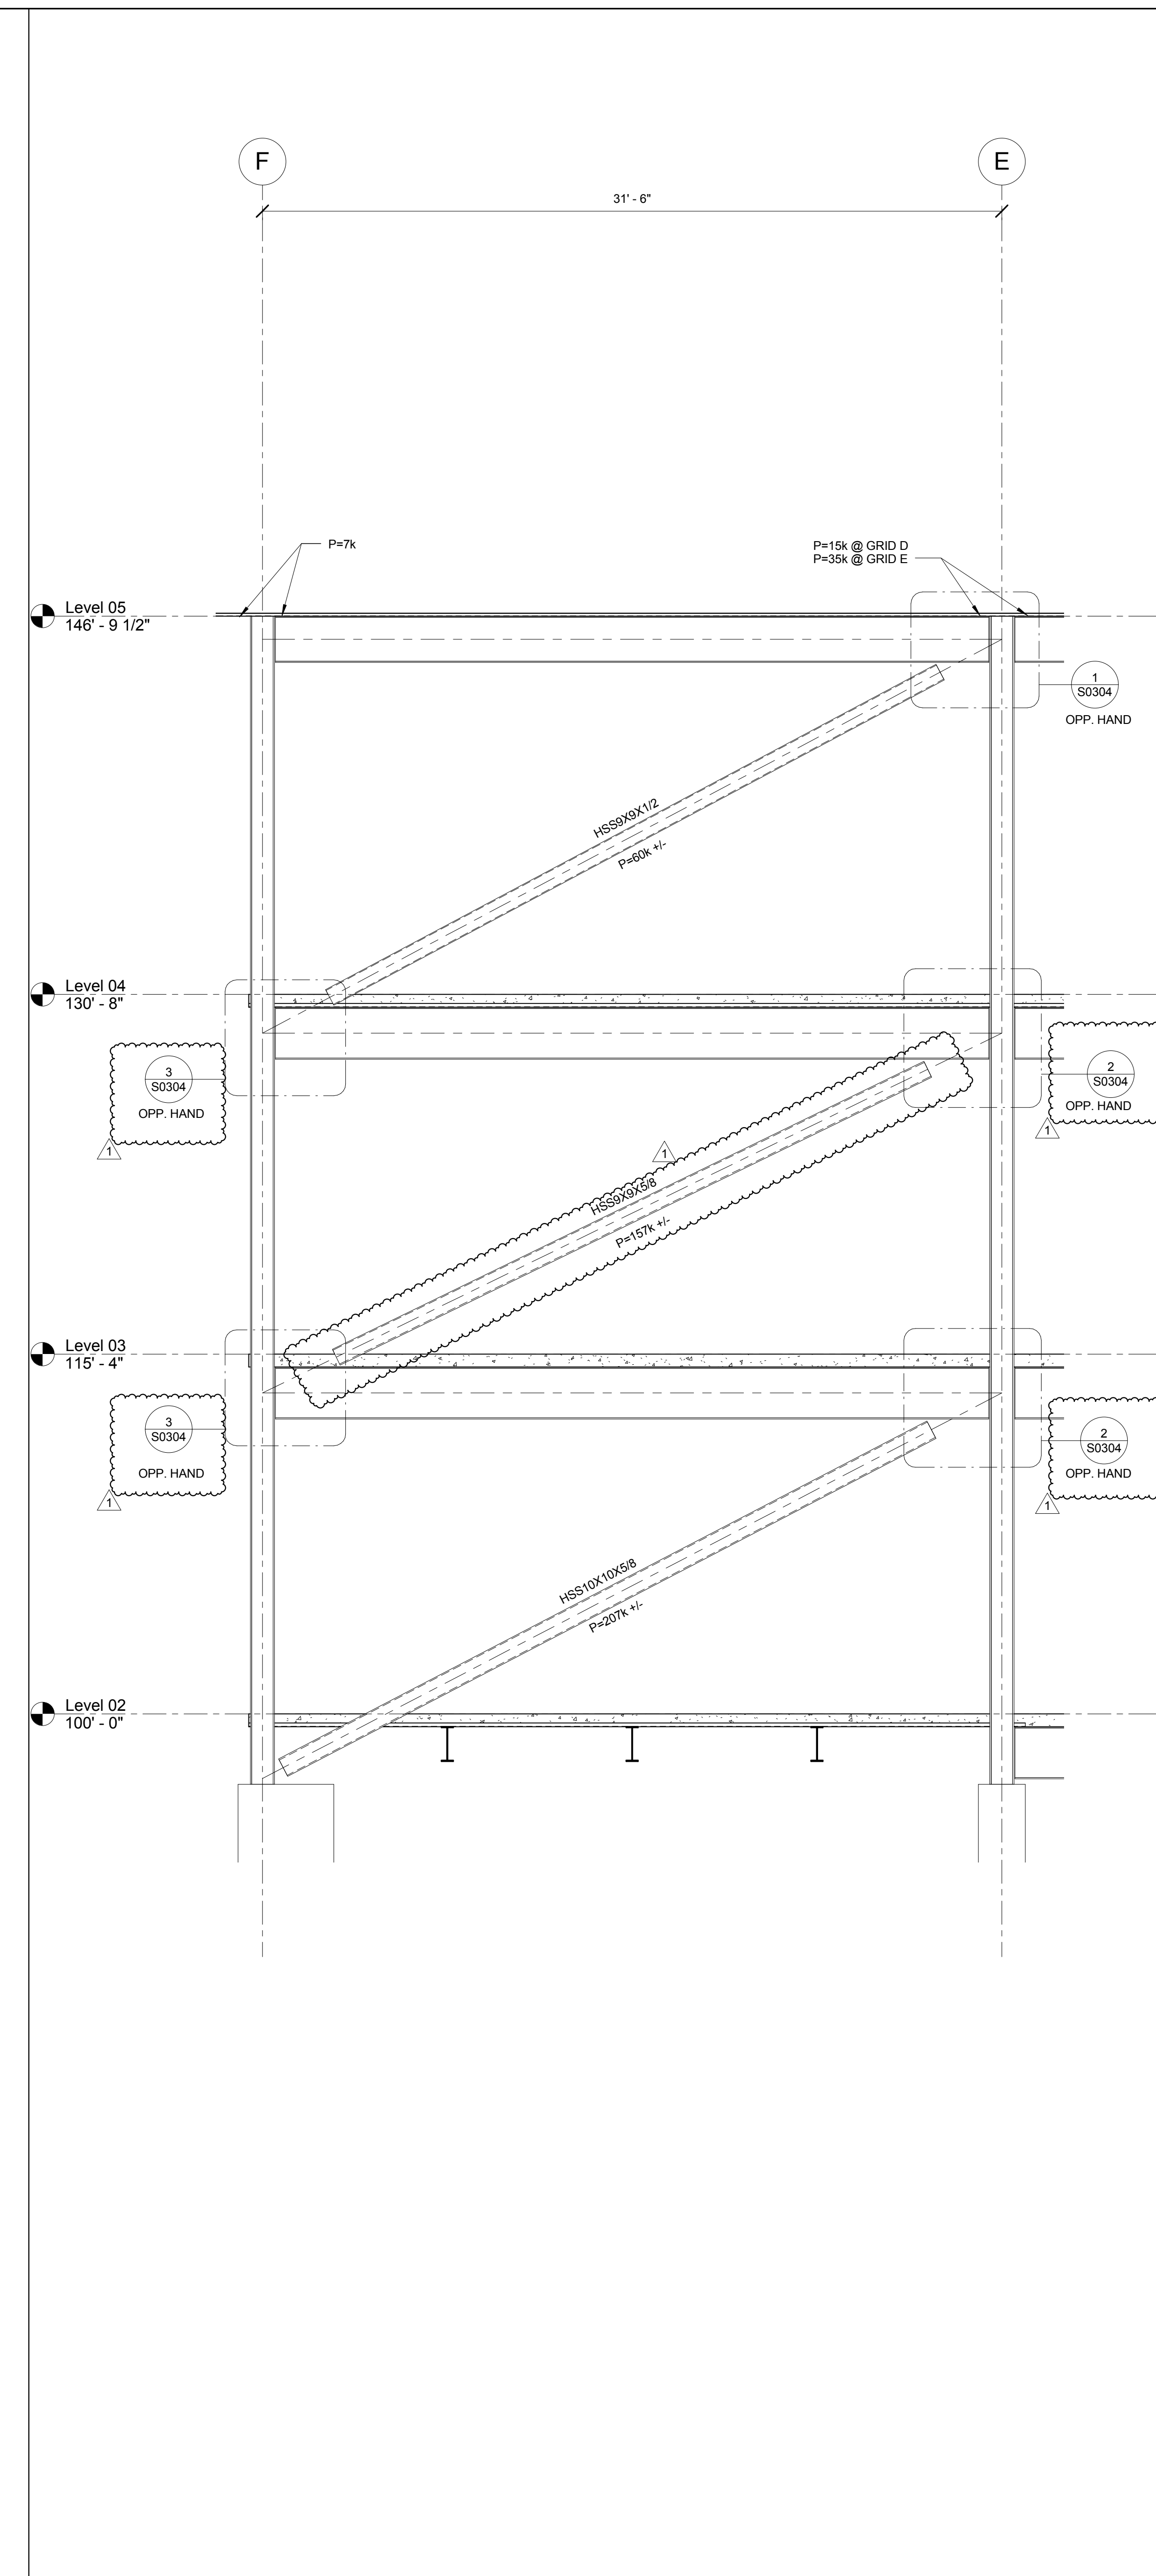

③ BRACED FRAME ELEVATION - BF-3
1/4" = 1'-0"