



© Cannon Design 2015
All rights reserved. No part of this document may be reproduced or transmitted in any form or by any means, electronic or mechanical, including photocopying and recording, or by any information storage or retrieval system, without written authorization by The Cannon Corporation.
1/15/2016 10:49:04 AM

1 BRACED FRAME ELEVATION - BF-4
1/4" = 1'-0"

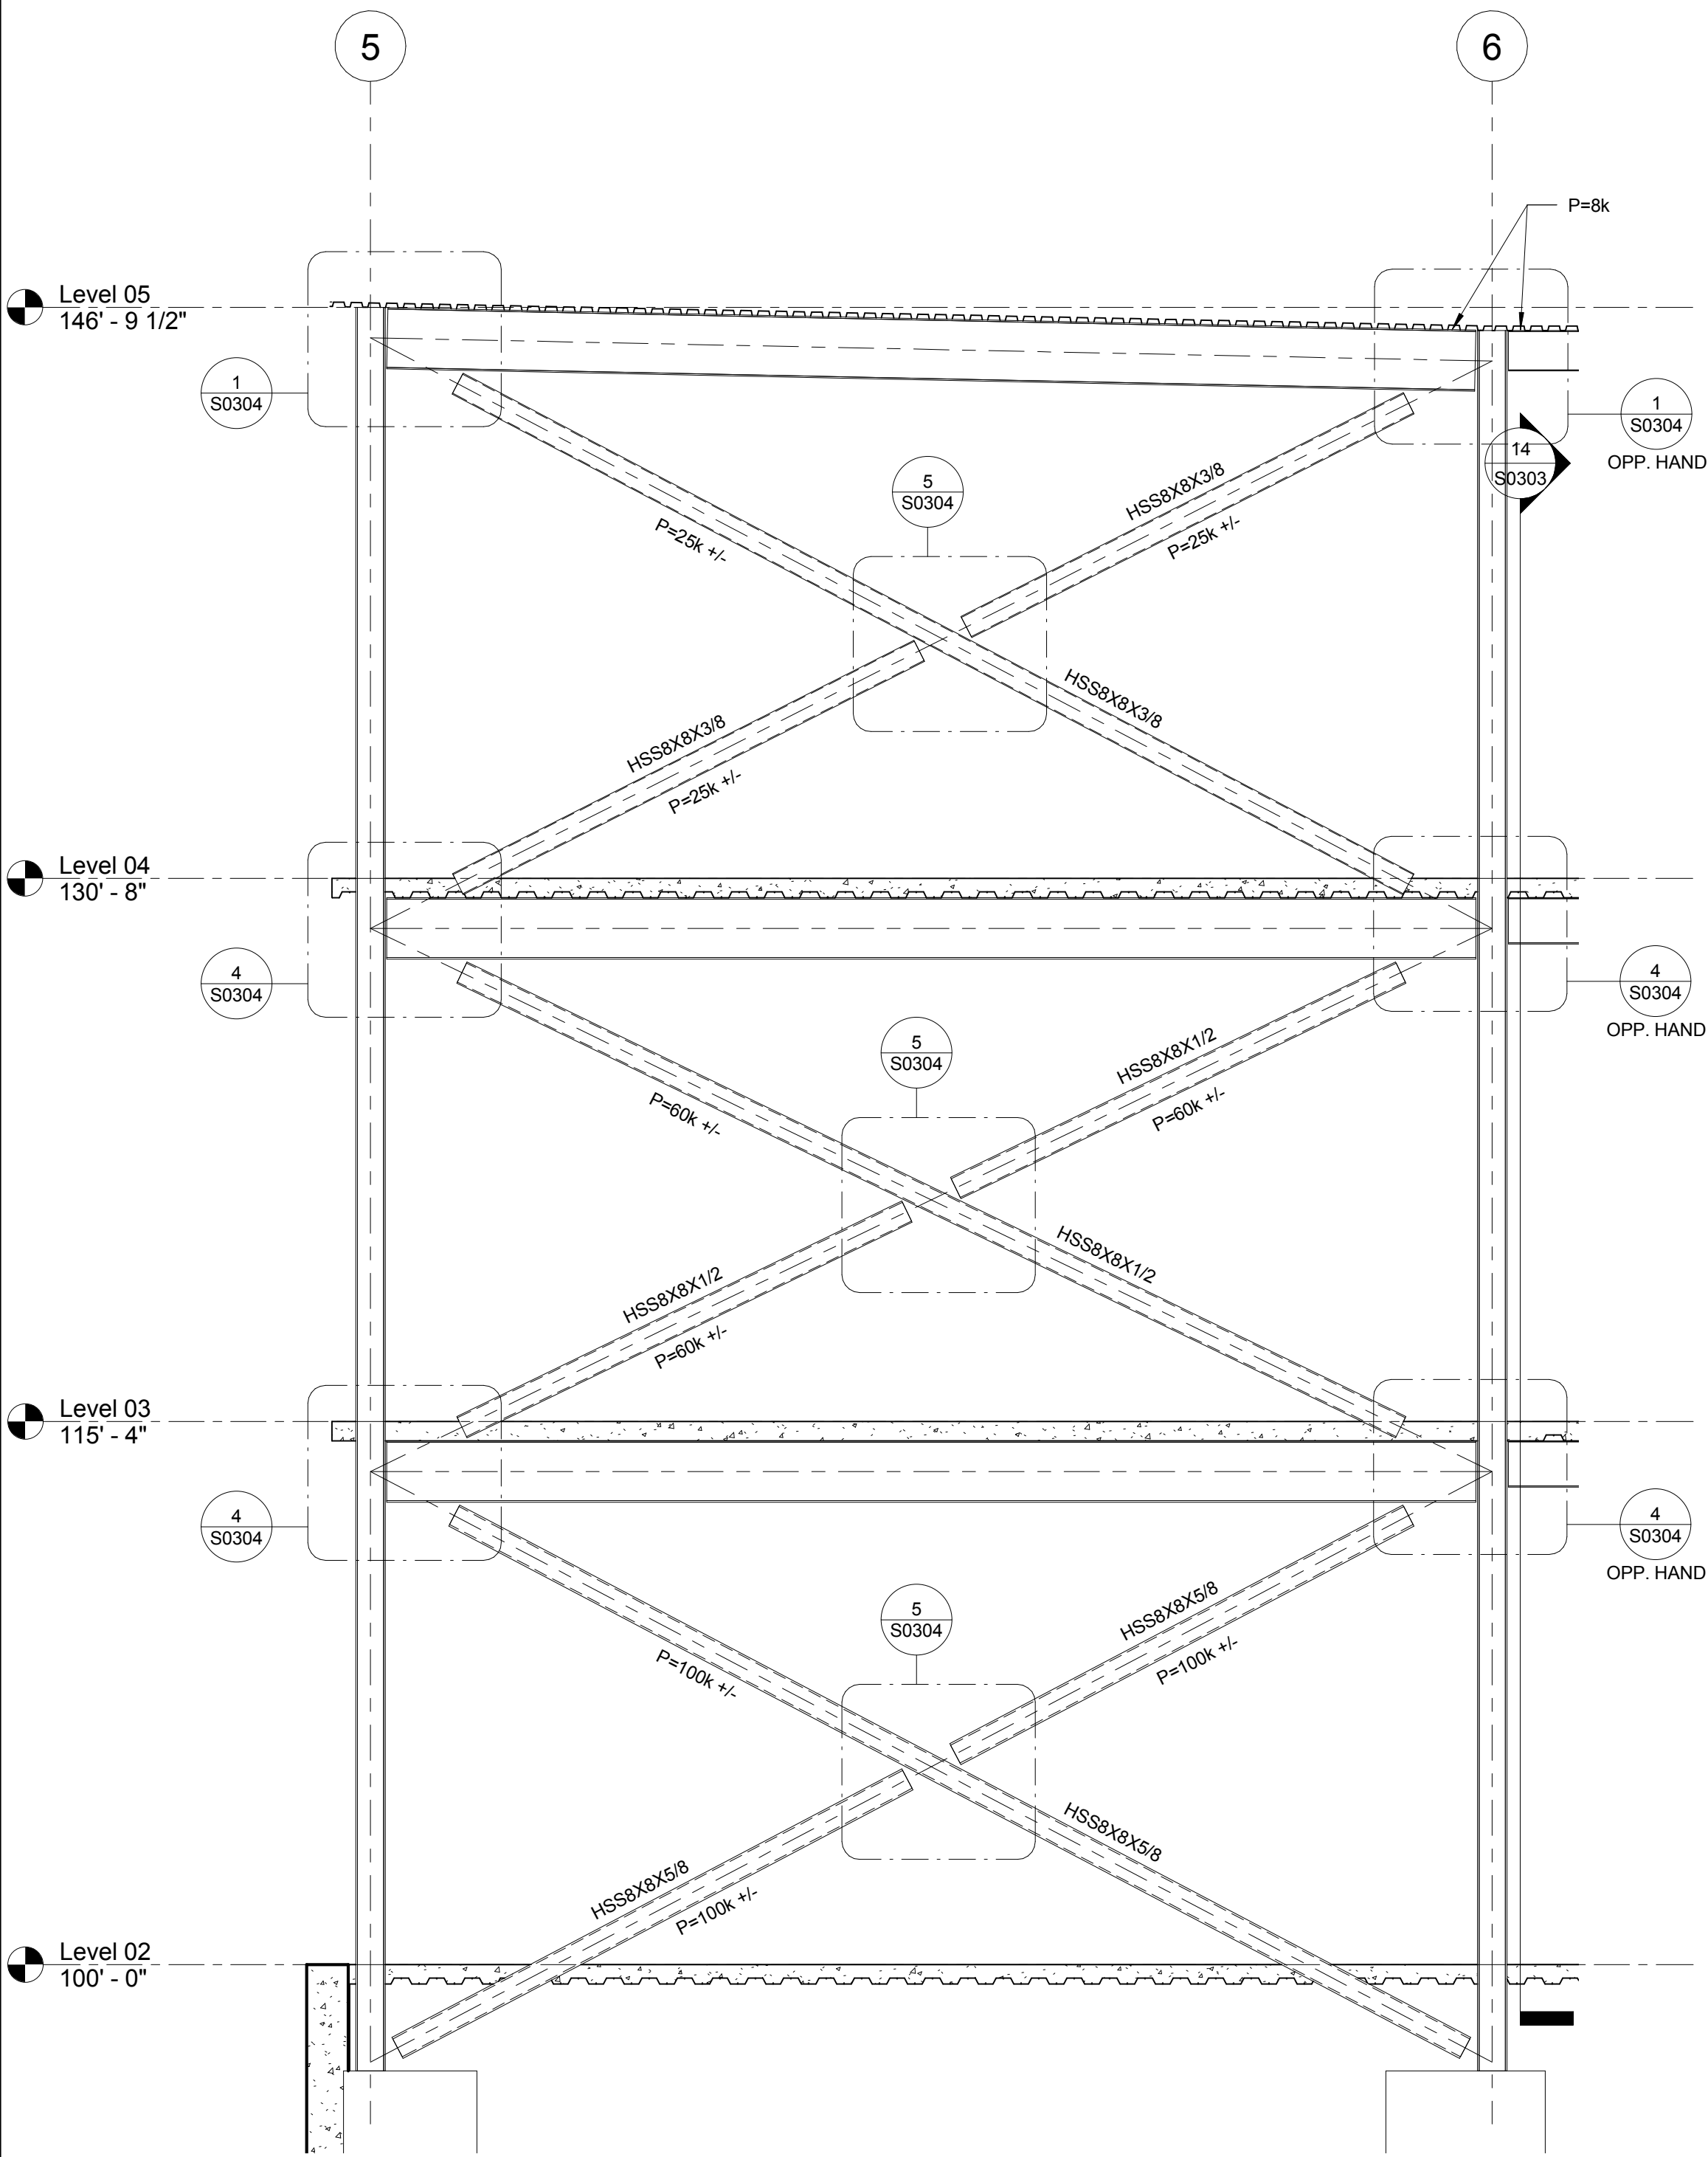

2 BRACED FRAME ELEVATION - BF-5
1/4" = 1'-0"

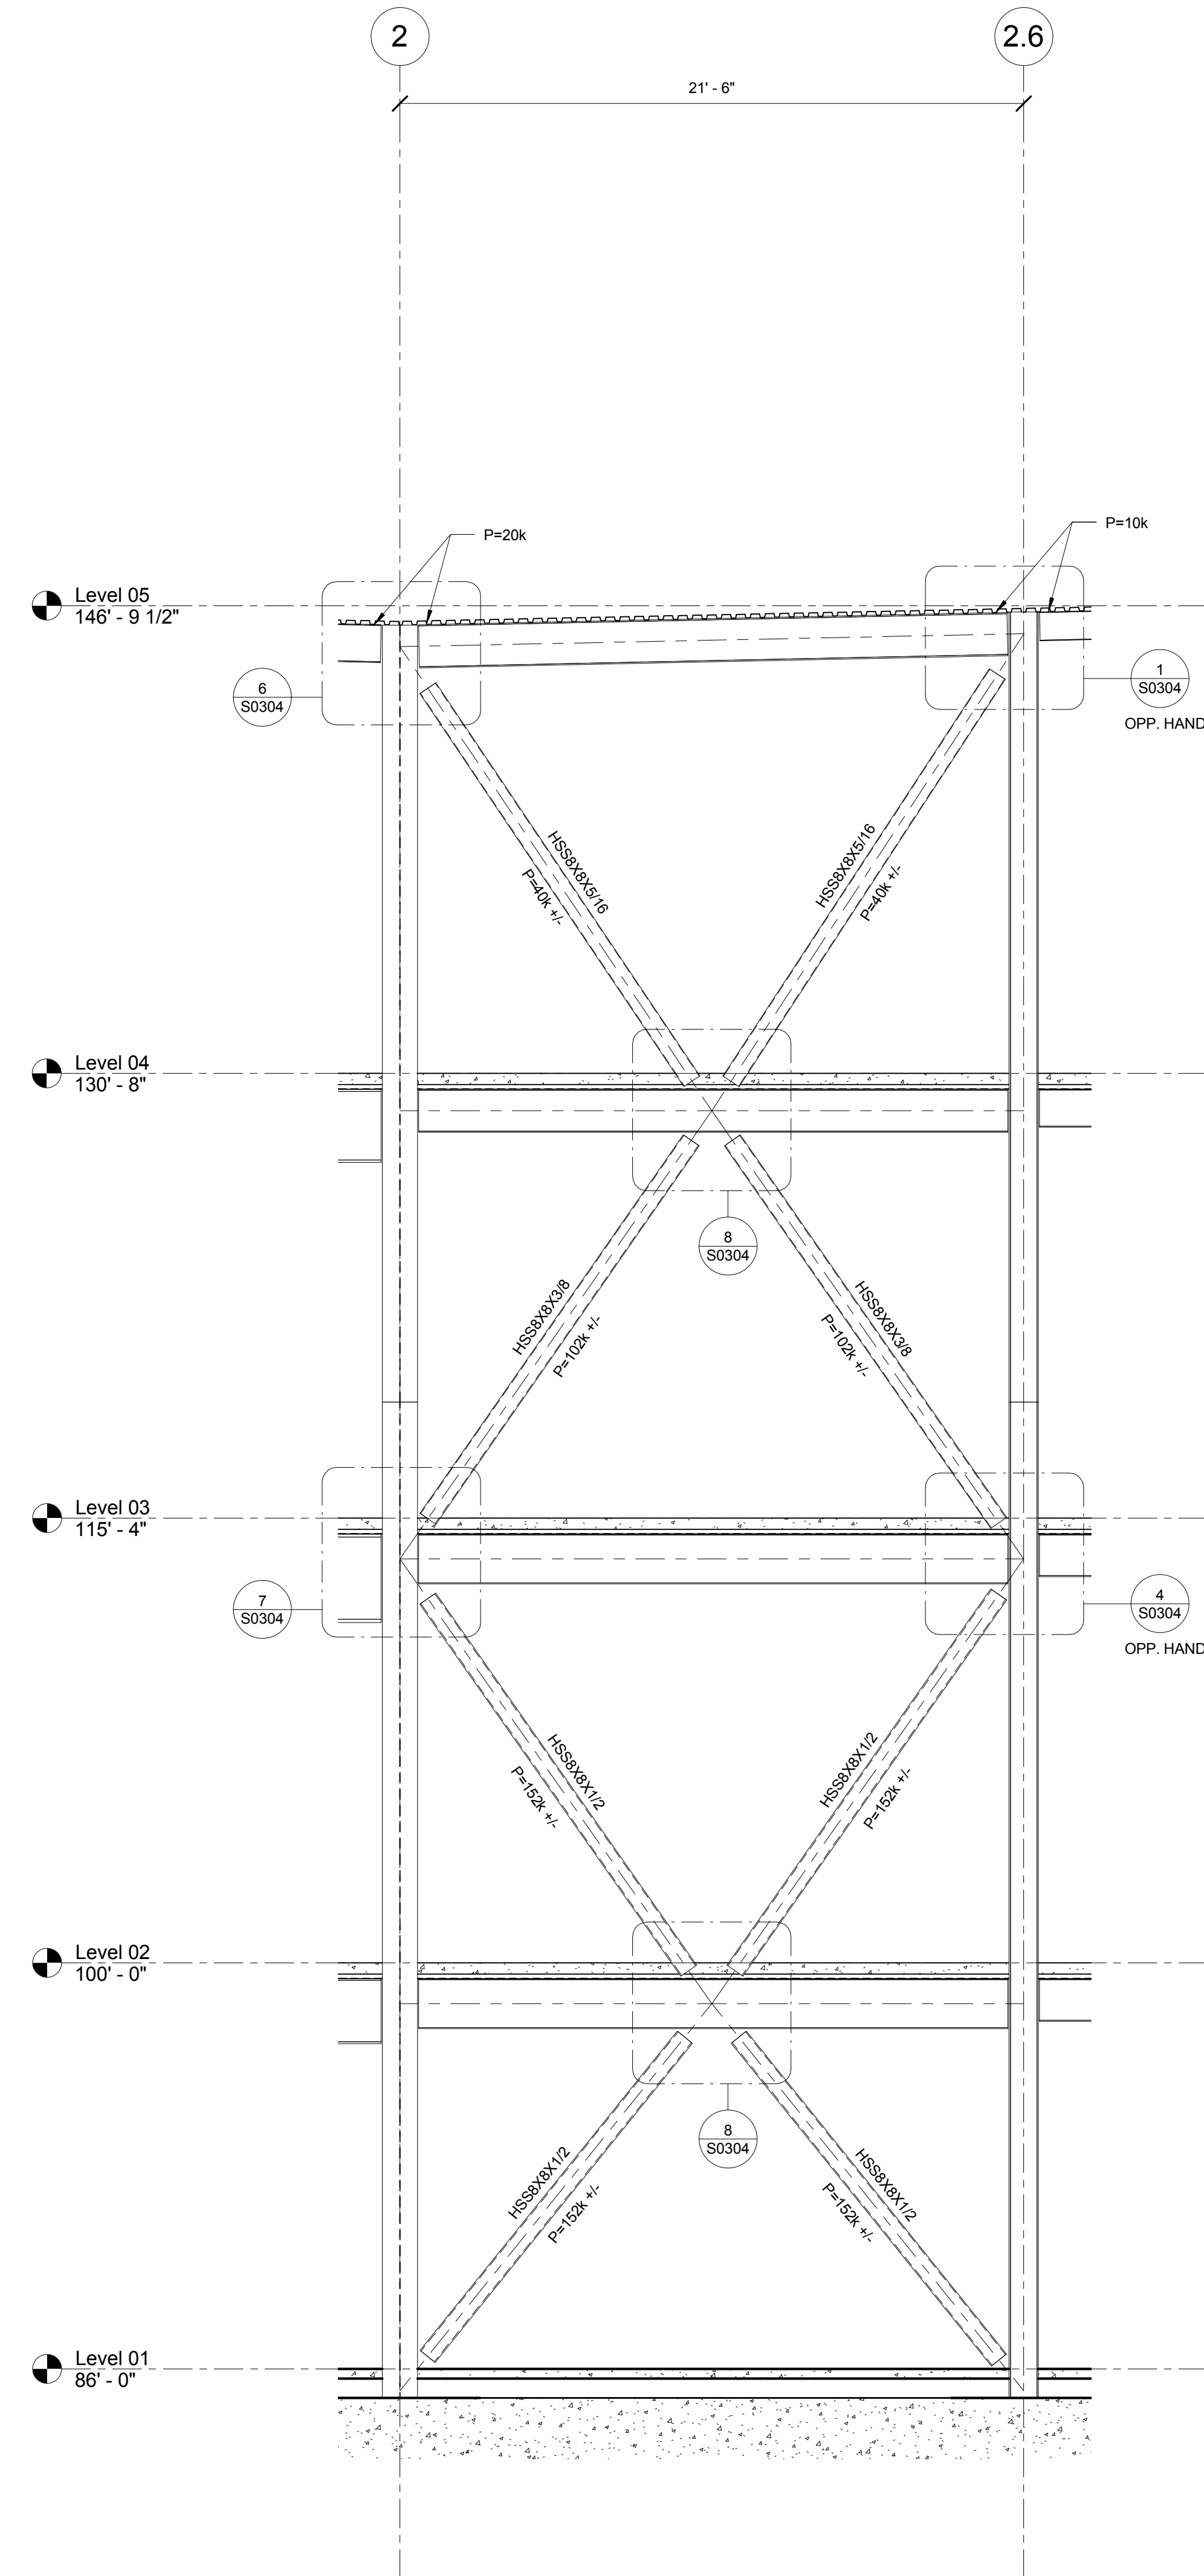

3 BRACED FRAME ELEVATION - BF-6
1/4" = 1'-0"

