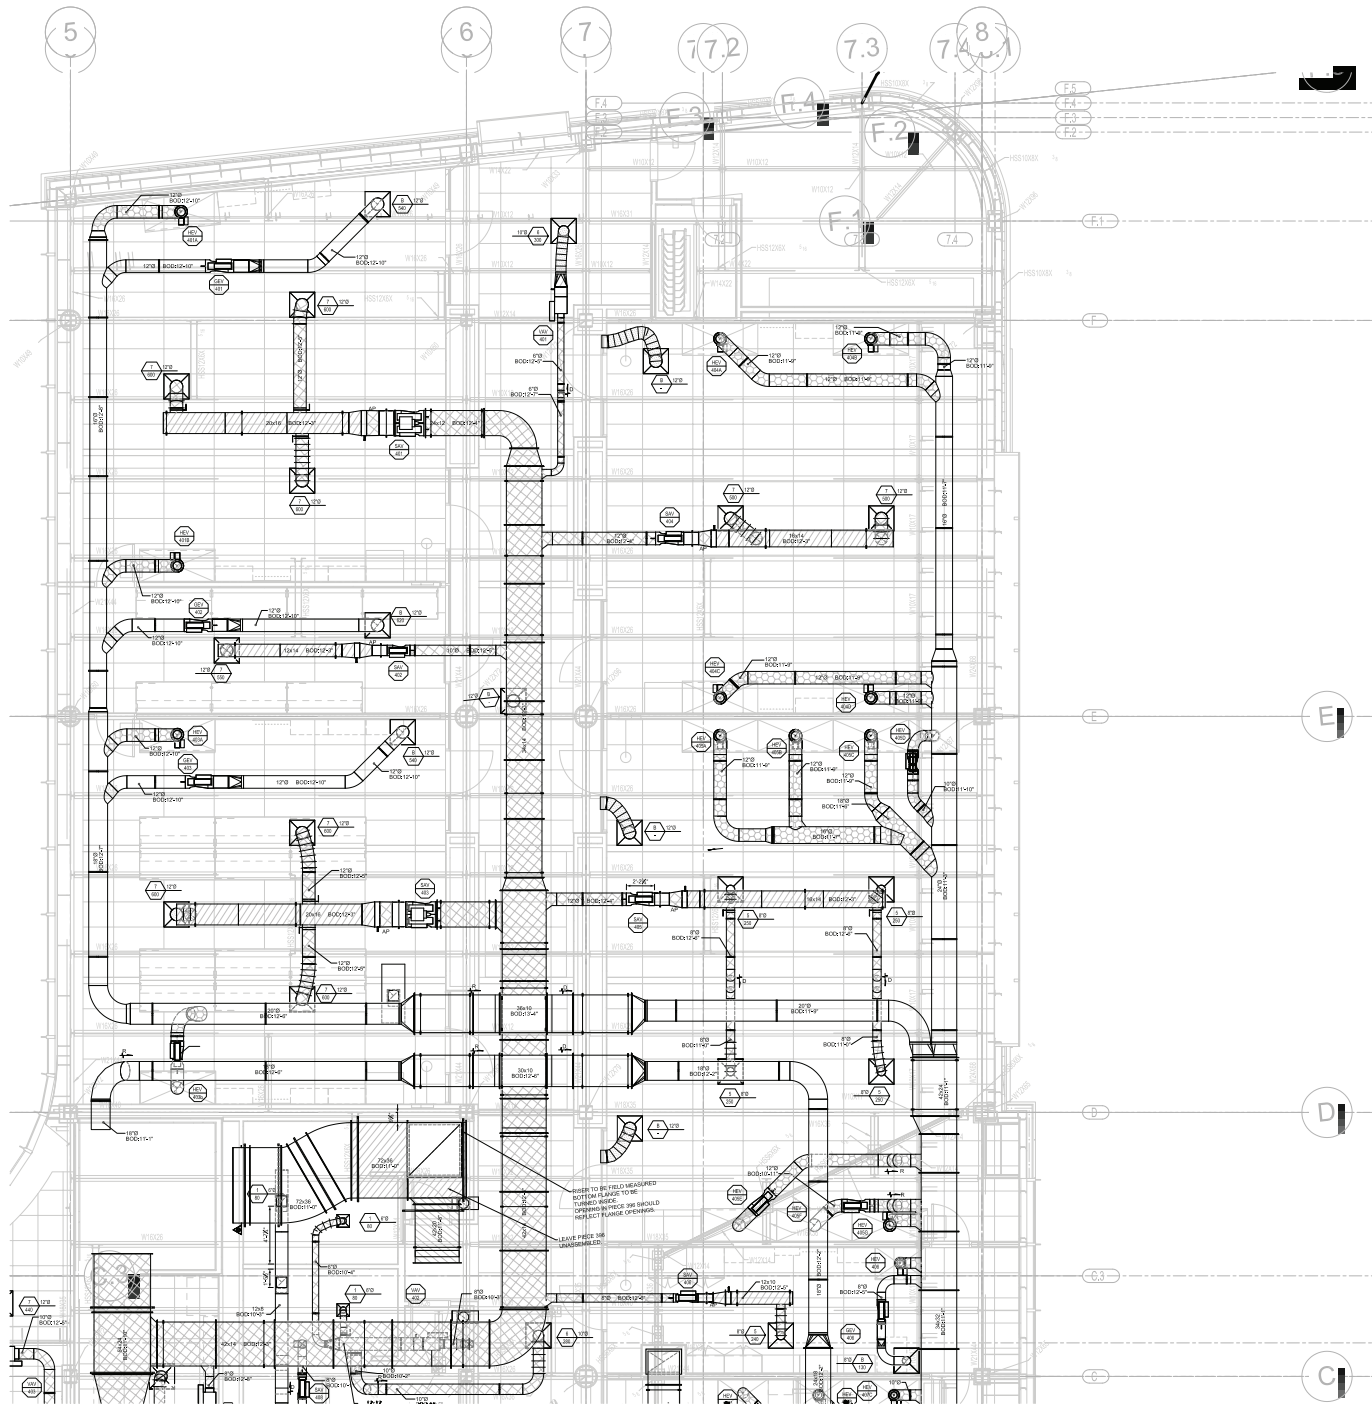


RECORD DRAWING
DATE: 6/30/17 DRAWN BY: J

WEBSTER UNIVERSITY - ISB
WEBSTER GROVES, MISSOURI
ICON MECHANICAL CONTRACTORS AND ENGINEERS

NOT VALID FOR PERMITS
UNLESS SEALED BY
ENGINEER

Revision: _____
 Issue Date: 01/03/17
 Sheet Title: SM104A1
 Project Number: 5768
 Sheet Number: 1 of 1