

© Cannon Design 2015
All rights reserved. No part of this document may be reproduced or transmitted in any form or by any means, electronic or mechanical, including photocopying, recording, or by any information storage and retrieval system, without written authorization by The Cannon Corporation.
12/12/2016 4:18:43 PM

1 LEVEL 01 - AREA A
1/8" = 1'-0"



GENERAL NOTES:

THIS SHEET ONLY

1. DATA OUTLETS IN OFFICE SHALL BE LOCATED ADJACENT TO AND AT THE SAME MOUNTING HEIGHT AS THE POWER RECEPTACLES UNLESS OTHERWISE NOTED. COORDINATE LOCATION WITH THE ELECTRICAL CONTRACTOR.
2. SEE TELECOMMUNICATIONS CABLING DEMARCATION LINE ON THIS SHEET FOR ROUTING OF CABLING TO SPECIFIC DATA ROOMS.

KEYED NOTES:

THIS SHEET ONLY

1. CABINET MOUNTED AV EQUIPMENT (OFVI).
2. CONFIRM EXACT LOCATION OF DATA OUTLET AND MONITOR BOX WITH ARCHITECTURAL DRAWINGS PRIOR TO INSTALLATION.
3. WALL MOUNT BLUE LIGHT EMERGENCY INTERCOM STATION WITH WIRELESS RADIO COMMUNICATION. SHALL BE FURNISHED BY OWNER AND INSTALLED BY SECURITY CONTRACTOR. UNIT SHALL BE MOUNTED SO INTERCOM STATION IS 48" ABOVE GRADE. SEE ELECTRICAL DRAWINGS FOR POWER REQUIREMENTS.
4. INSTALL COMMUNICATION OUTLET IN THE COMMUNICATIONS SIDE OF THE 2-CHANNEL RACEWAY. SEE ELECTRICAL DRAWINGS FOR RACEWAY INFORMATION.
5. CONFIRM EXACT LOCATION AND TERMINATION REQUIREMENTS WITH ELECTRICAL CONTRACTOR PRIOR TO INSTALLATION.
6. PROVIDE A 4" FIRE RATED CABLE PATHWAY THROUGH FLOOR FOR TELECOM CABLING TO LEVEL 0. SEE SPECIFICATION SECTION 078413 FOR PATHWAY INFORMATION.
7. PROVIDE A 4 11/16" SQUARE 2 1/8" DEEP WALL MOUNTED BOX WITH A 2 GANG MUD RING FOR PTZ CAMERA WITH A 1" CONDUIT WITH PULL STRING STUBBED INTO ACCESSIBLE CEILING SPACE. COORDINATE MOUNTING HEIGHT AND LOCATION WITH PTZ CAMERA INSTALLER.
8. NOT USED.
9. CONFIRM EXACT LOCATION AND TERMINATION REQUIREMENTS WITH ELEVATOR EQUIPMENT INSTALLER PRIOR TO INSTALLATION.
10. PROVIDE A 1" CONDUIT IN SLAB FROM AV EQUIPMENT CABINET TO THE LAPTOP LOCATION. VERIFY STUB-UP LOCATION.
11. DATA OUTLET FOR LAPTOP. COORDINATE BOX LOCATION WITH CASEWORK INSTALLER PRIOR TO ROUGH-IN.
12. PROVIDE (1) 1" PVC CONDUIT IN THE SLAB FOR DATA CABLES. STUB-UP INSIDE WALL CAVITY TO ABOVE ACCESSIBLE CEILING.
13. COORDINATE EXACT LOCATION WITH PA INSTALLER.
14. MOUNT AT LIGHT SWITCH HEIGHT.
15. MOUNT AT RECEPTACLE HEIGHT. PROVIDE (1) 1" CONDUIT UP TO "IP" BOX (SEE KEYED NOTE 14). CENTER DIRECTLY BELOW "IP" BOX.



Webster University
Interdisciplinary Science
Building

CANNONDESIGN

1100 Clark Avenue
St. Louis, Missouri 63102
T: 314.241.6290
F: 314.241.2570

William Tao & Associates, Inc.
MEP/FP Engineer
7955 Manchester Road, Suite 125
St. Louis, MO 63143
314-884-7600

David Mason & Associates, Inc.
Structural & Civil Engineer
800 South Vandeventer Avenue
St. Louis, MO 63110
314.534.1053

Faith Group
Technology
3101 S. Hanley Rd., Suite 100
St. Louis, MO 63143
314.991.2229

Kuhnmann Leavitt, Inc.
Environmental Graphics & Signage
7400 Pershing Ave.
St. Louis, MO 63130
314.725.6616

KWA Architects
Architecture
9721 Litzinger Road
St. Louis, MO 63124
314.962.2560


Spelman Brady & Company
Interior Designer
8251 Maryland Avenue, Suite 300
St. Louis, MO 63105
314.862.0070

SWT Design
Landscape Architect
7722 Big Bend Blvd
St. Louis, MO 63119
314.644.5700

Webb Engineering Services, Inc.
Planning & Fire Protection
1400 S. 3rd Street, Suite 201
St. Louis, MO 63104
314.588.0600

4	ASI-041	13 DEC 2016
3	ASI-040	09 DEC 2016
2	ASI-035	10 NOV 2016
1	ADDENDUM 2-2	19 APR 2016
-	ISSUED FOR CONSTRUCTION (BP2)	01 MAR 2016

No.	Description	Date
-----	-------------	------

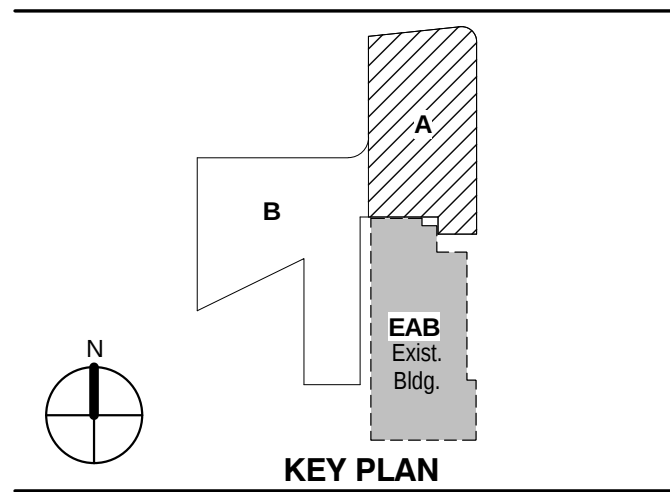

Drawing Title:

**LEVEL 01 FLOOR PLAN -
AREA A**

Project No.: 04561.01 Checked by:

T0101.A

© Cannon Design 2015