


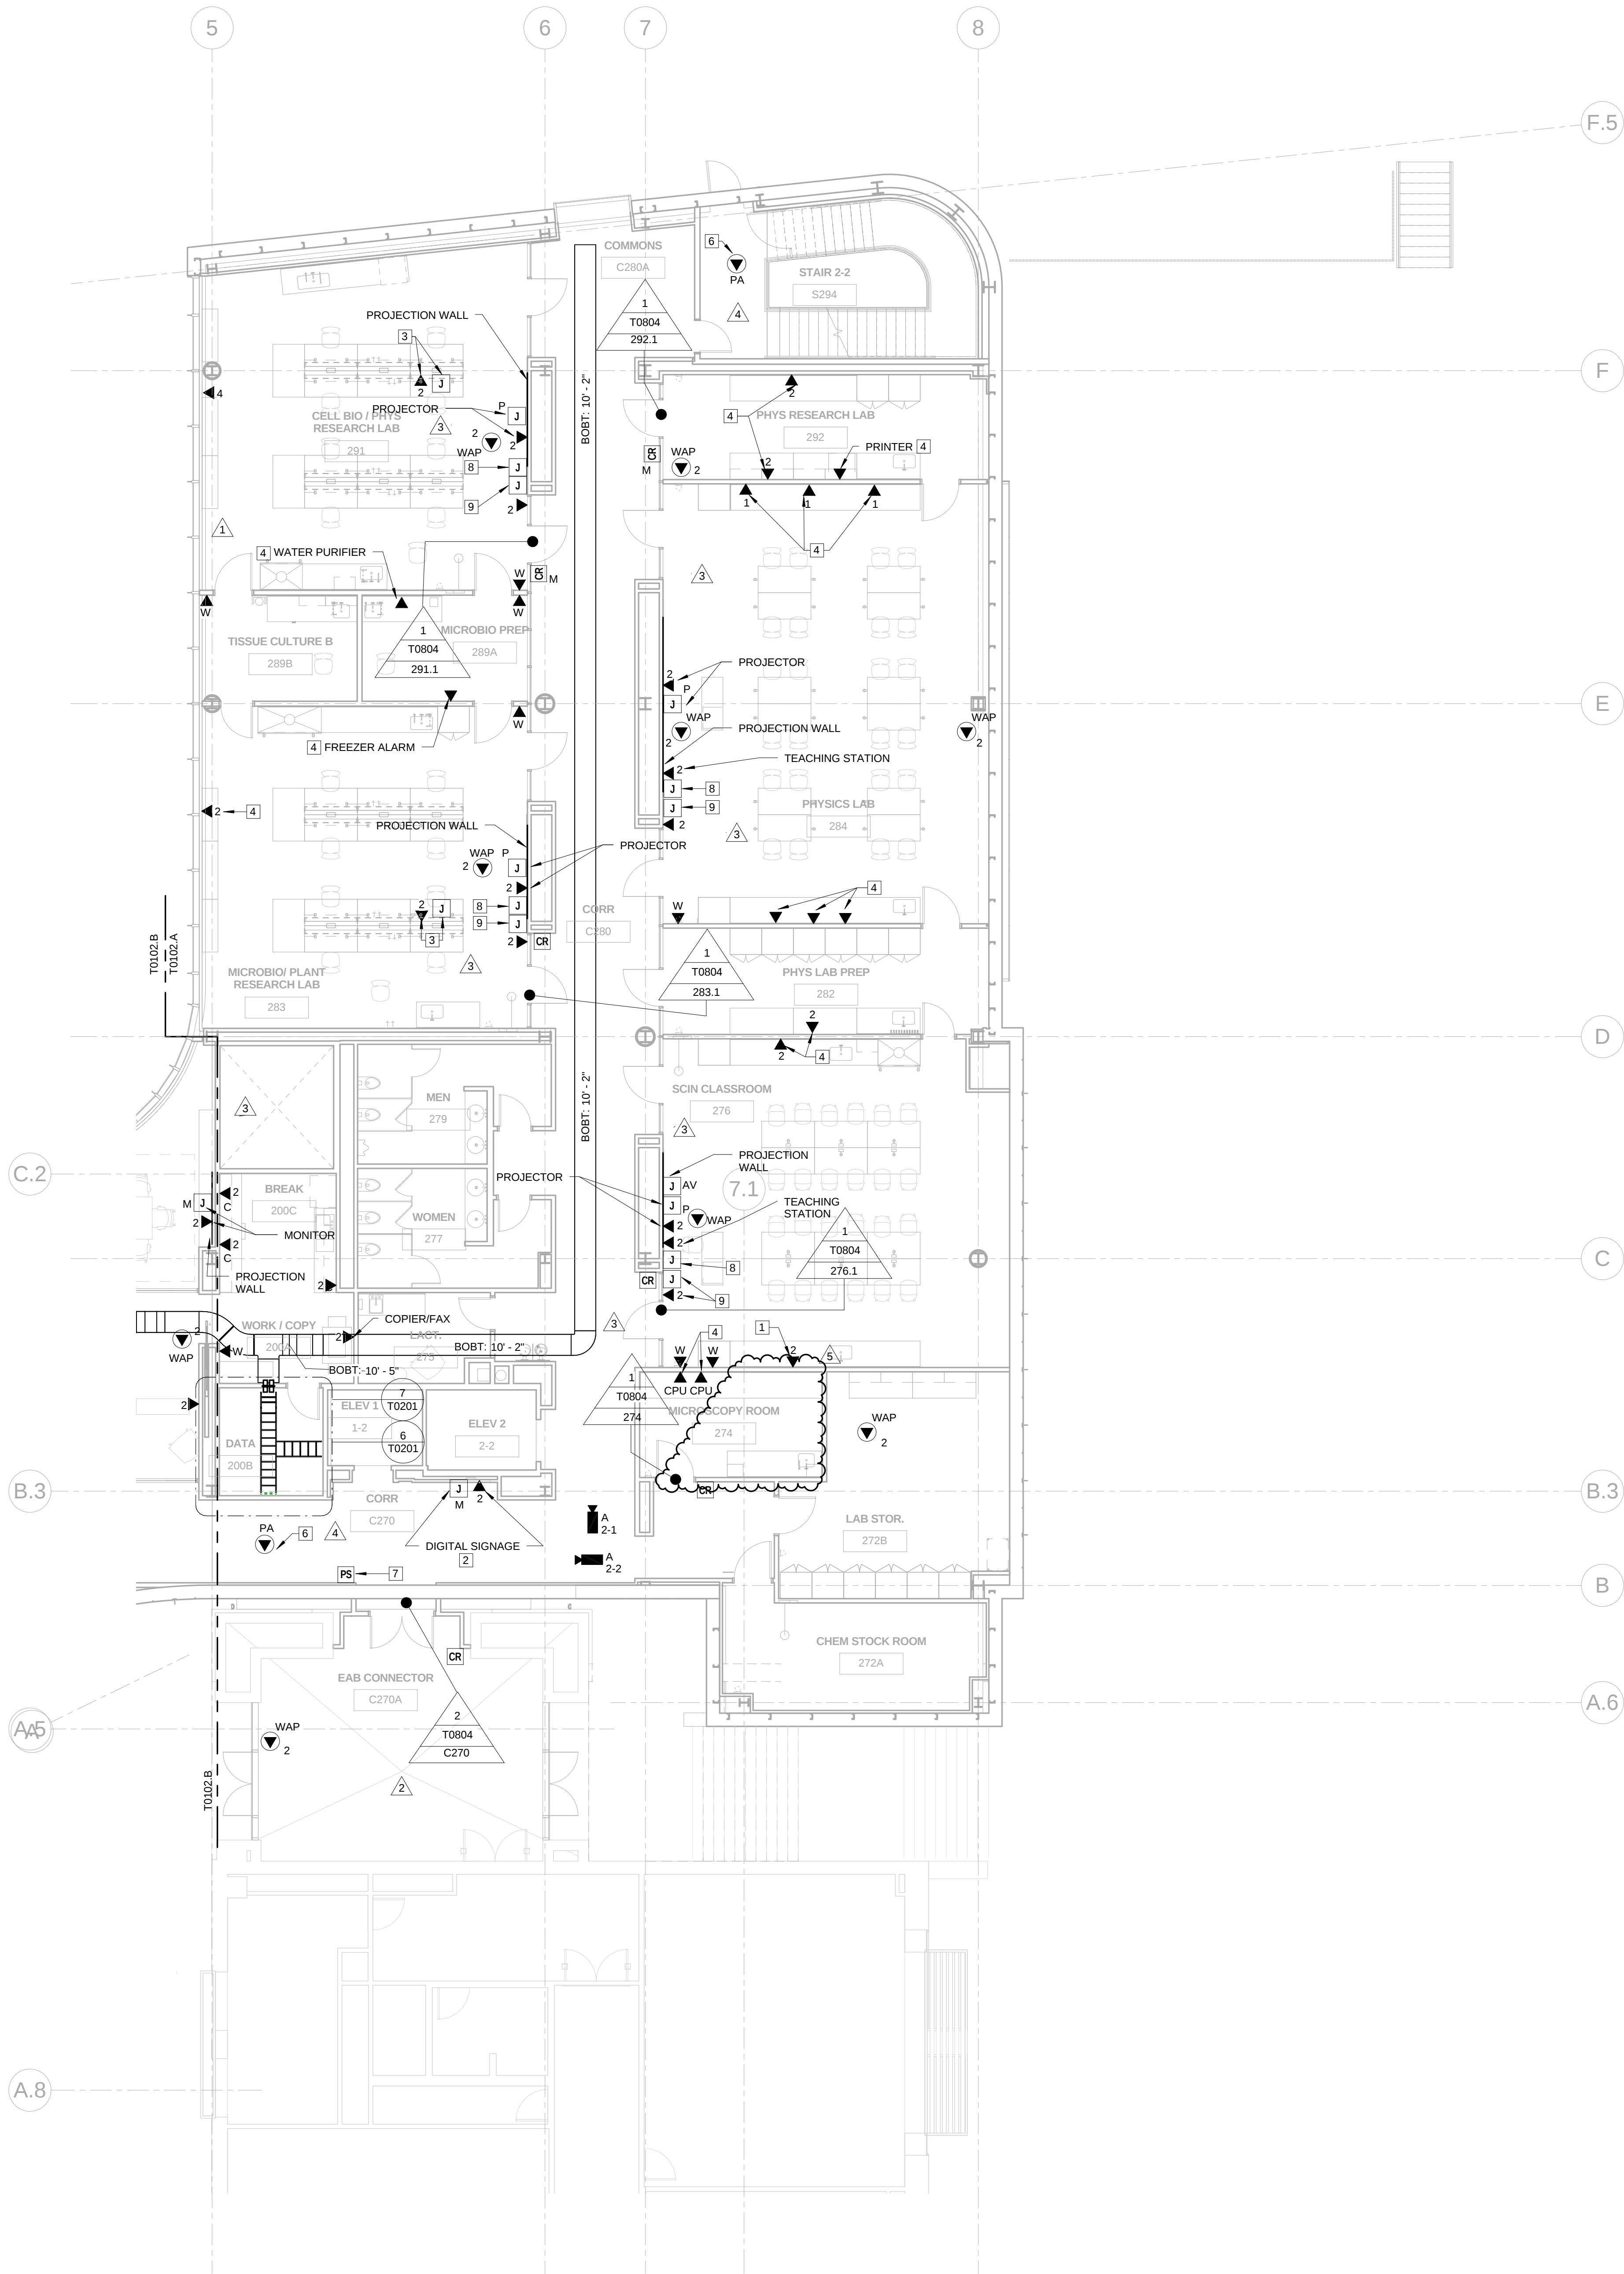

GENERAL NOTES: THIS SHEET ONLY

1. DATA OUTLETS IN OFFICE SHALL BE LOCATED ADJACENT TO AND AT THE SAME MOUNTING HEIGHT AS THE POWER RECEPTACLES. COORDINATE LOCATION WITH THE ELECTRICAL CONTRACTOR.
2. TELECOMMUNICATIONS CABLEING ON THIS SHEET SHALL BE RUN TO LEVEL 02 DATA ROOM 200B.

KEYED NOTES: THIS SHEET ONLY

- 1 CABINET MOUNTED AV EQUIPMENT (OFVI)
- 2 CONFIRM EXACT LOCATION OF DATA OUTLET AND MONITOR BOX WITH AV VENDOR PRIOR TO INSTALLATION.
- 3 MOUNT DEVICES IN THE OVERHEAD SERVICE CARRIER SYSTEM. PROVIDE AN EMPTY 1" CONDUIT WITH PULL STRING FROM EACH DEVICE TO CEILING SPACE. COORDINATE DEVICE LOCATION AND MOUNTING REQUIREMENTS WITH CARRIER SYSTEM INSTALLER.
- 4 MOUNT IN COMMUNICATION CHANNEL OF 2 SECTION RACEWAY. SEE ELECTRICAL DRAWINGS FOR RACEWAY INFORMATION.
- 5 NOT USED.
- 6 COORDINATE EXACT LOCATION WITH PA INSTALLER.
- 7 LOCAL DOOR LOCK POWER SUPPLY.
- 8 PROVIDE (1) 4-11/16" SQUARE X 2-1/8" DEEP BOX WITH 2 GANG RING AND (1) 1" CONDUIT STUBBED INTO ACCESSIBLE CEILING SPACE FOR AV KEYPAD. PROVIDE (1) CAT 6A CABLE TO DATA ROOM IDENTIFIED ON PLANS. MOUNT AT LIGHT SWITCH HEIGHT.
- 9 PROVIDE (1) 4-11/16" SQUARE X 2-1/8" DEEP BOX WITH 2 GANG RING FOR THE AV INPUT PLATE. MOUNT AT RECEPTACLE HEIGHT. PROVIDE (1) 1" CONDUIT UP TO THE AV KEYPAD J BOX. (SEE KEYED NOTE 8)



Webster University
Interdisciplinary Science
Building

CANNONDESIGN

1100 Clark Avenue
St. Louis, Missouri 63102
T: 314.241.6250
F: 314.241.2570

William Tao & Associates, Inc.
MEP/FP Engineer
7955 Manchester Road, Suite 125
St. Louis, MO 63143
314.884.7600

David Mason & Associates, Inc.
Structural & Civil Engineer
800 South Vandeventer Avenue
St. Louis, MO 63110
314.534.1053

Faith Group
Technology
3101 S. Hanley Rd. Suite 100
St. Louis, MO 63143
314.991.2229

Kuhmann Leavitt, Inc.
Environmental Graphics & Signage
7400 Pershing Ave.
St. Louis, MO 63130
314.725.6616

KWA Architects
Architecture
9721 Litzinger Road
St. Louis, MO 63124
314.962.2560


Spellman Brady & Company
Interior Designer
8251 Maryland Avenue, Suite 300
St. Louis, MO 63105
314.862.0070

SWT Design
Landscape Architect
7722 Big Bend Blvd
St. Louis, MO 63119
314.644.5700

Webb Engineering Services, Inc.
Planning & Fire Protection
1400 S. 3rd Street, Suite 201
St. Louis, MO 63104
314.588.0600

5	ASI-053	24 FEB 2017
4	ASI-040	09 DEC 2016
3	ASI-035	10 NOV 2016
2	ADDENDUM 2-2	19 APR 2016
1	ADDENDUM 2-1	17 MAR 2016
-	ISSUED FOR CONSTRUCTION (BP2)	01 MAR 2016

No.	Description	Date
-----	-------------	------

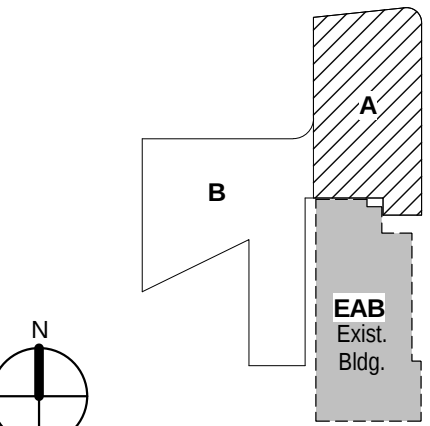

KEY PLAN

Drawing Title:

LEVEL 02 FLOOR PLAN -
AREA A

Project No.: 04561.01 Checked by:

T0102.A