


© Cannon Design 2015
All rights reserved. No part of this document may be reproduced or transmitted in any form without written authorization by The Cannon Corporation.
2/23/2017 9:05:53 AM

1 LEVEL 02 - AREA B
1/8" = 1'-0"

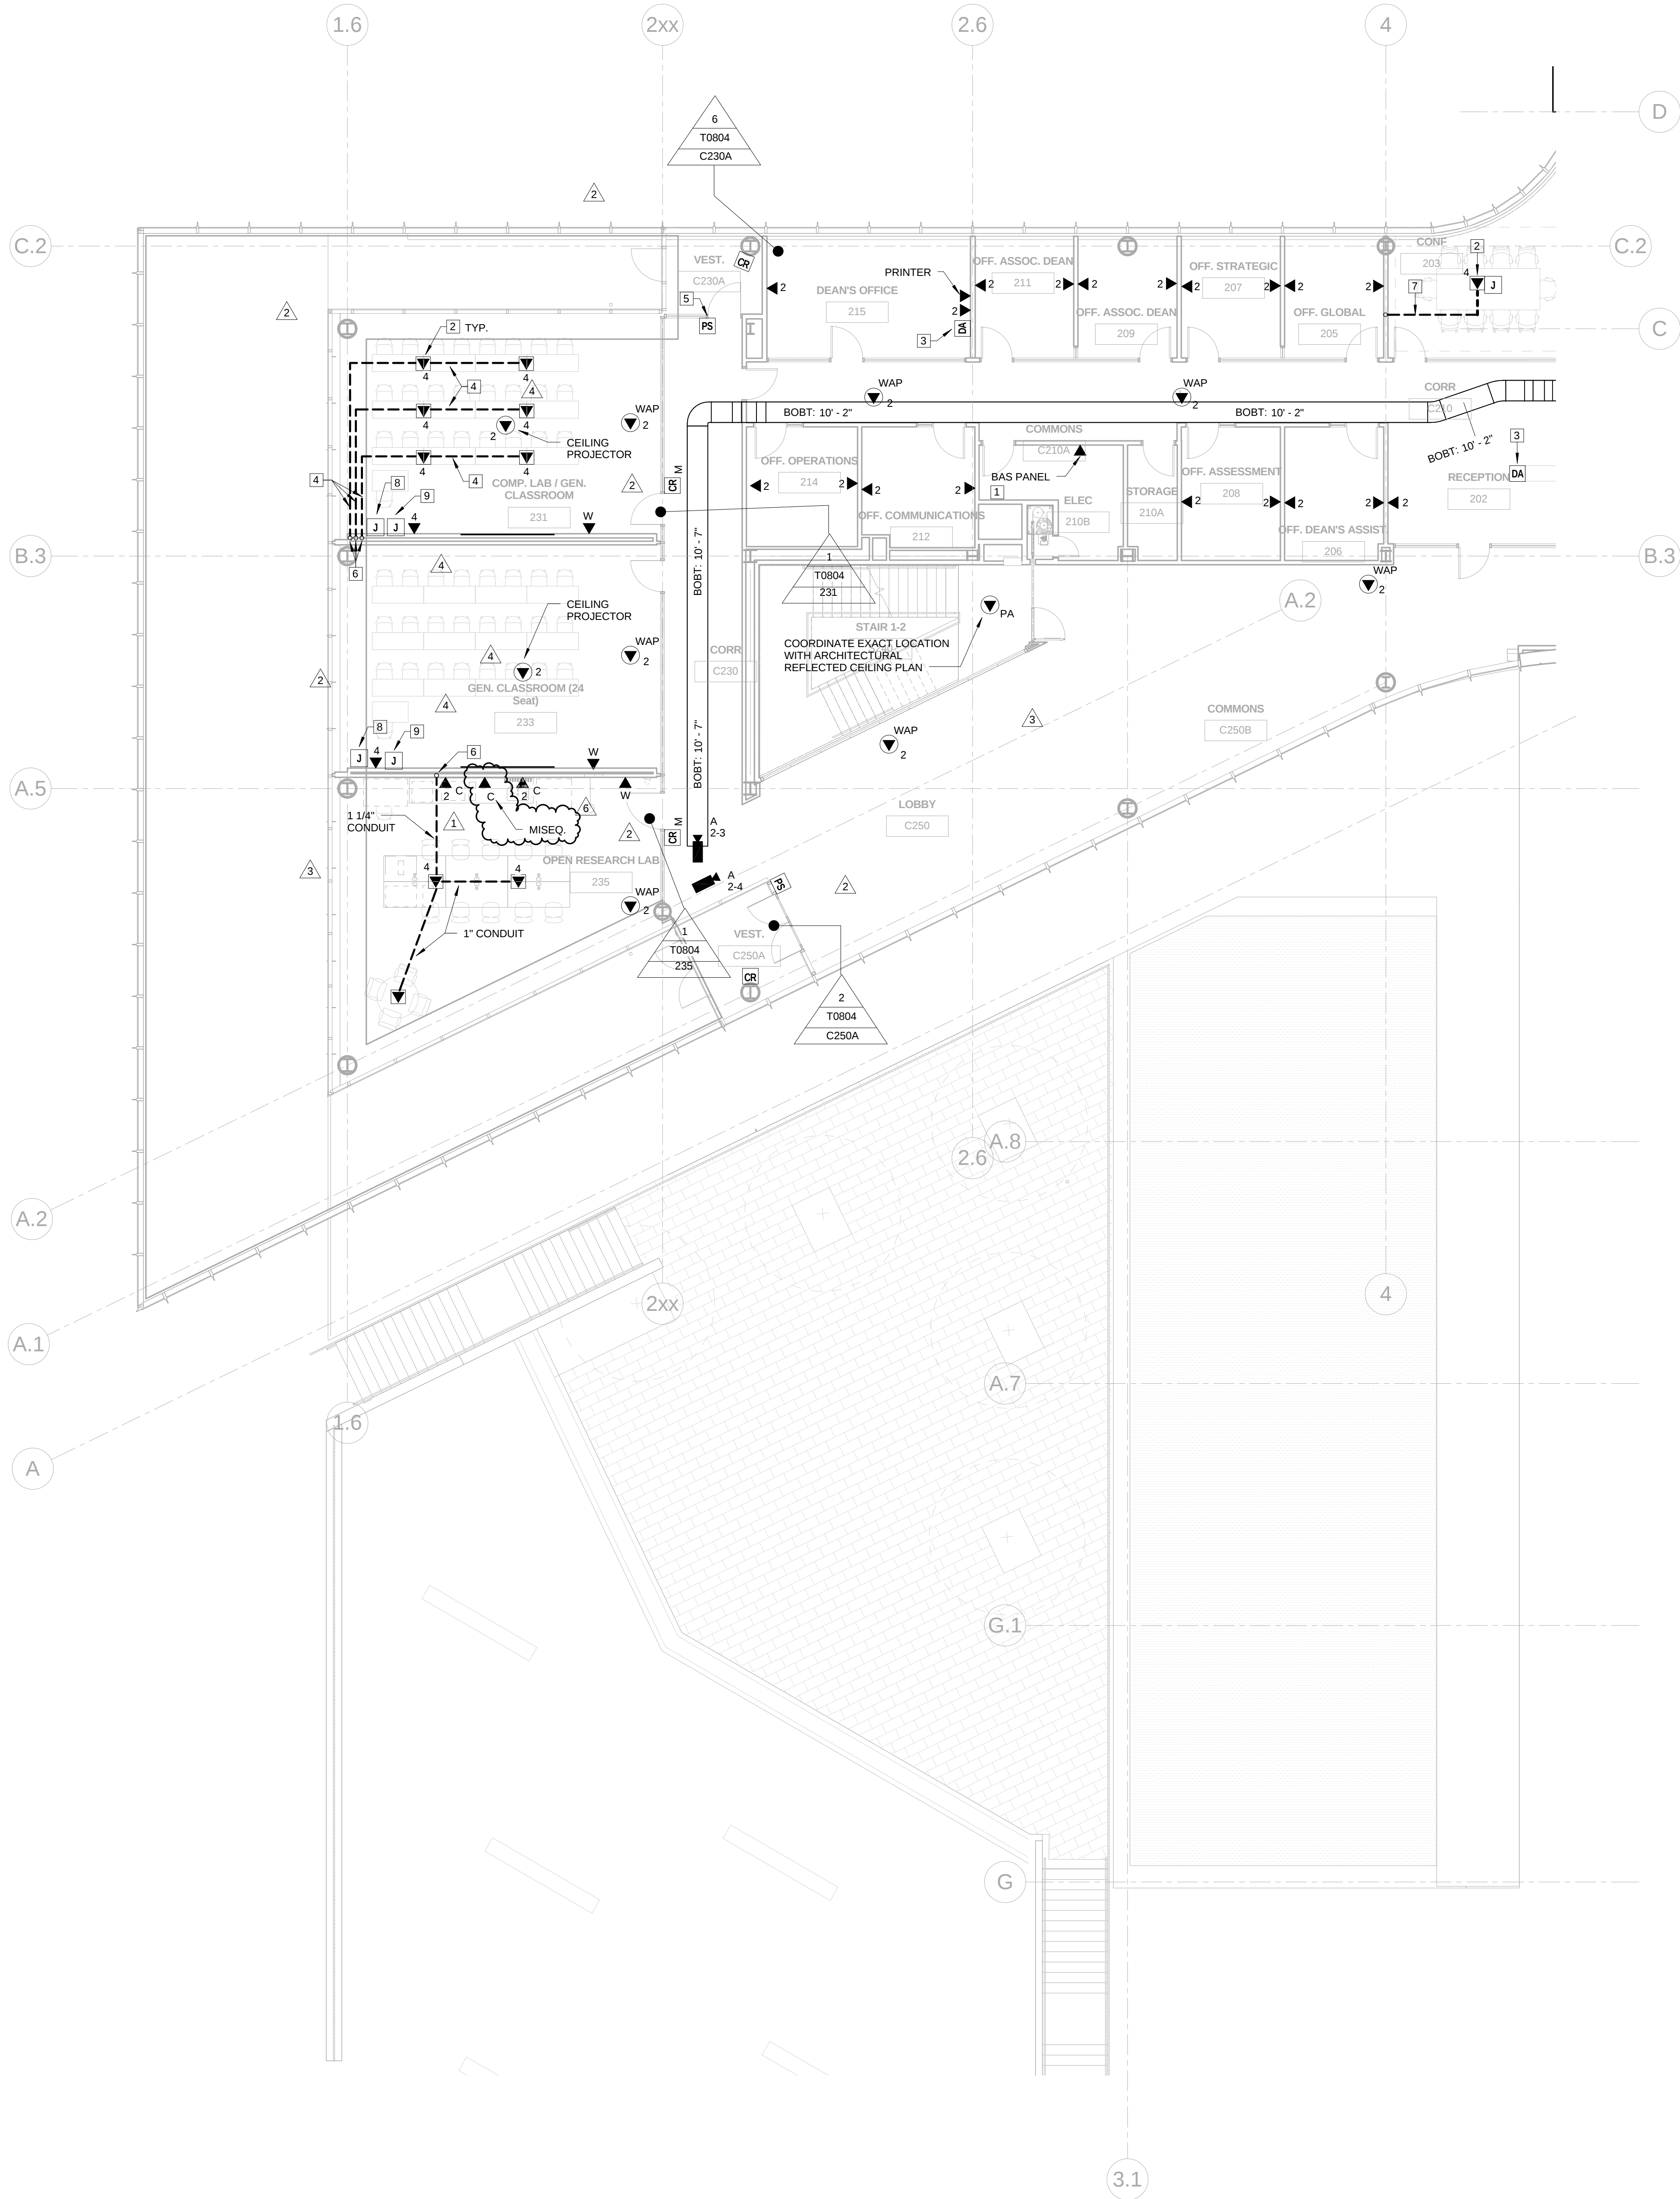

GENERAL NOTES: THIS SHEET ONLY

1. DATA OUTLETS IN OFFICE SHALL BE LOCATED ADJACENT TO AND AT THE SAME MOUNTING HEIGHT AS THE POWER RECEPTACLES. COORDINATE LOCATION WITH THE ELECTRICAL CONTRACTOR.
2. TELECOMMUNICATIONS CABLEING ON THIS SHEET SHALL BE RUN TO LEVEL 02 DATA ROOM 200B

KEYED NOTES: THIS SHEET ONLY

- 1 CONFIRM EXACT LOCATION AND TERMINATION REQUIREMENTS WITH MECHANICAL CONTRACTOR PRIOR TO INSTALLATION.
- 2 SEE ELECTRICAL DRAWINGS FOR FLOOR BOX INFORMATION.
- 3 SECURITY SYSTEM DURESS ALARM. INSTALL ON THE BOTTOM SIDE OF THE DESK SURFACE. COORDINATE EXACT LOCATION WITH FURNITURE INSTALLER. COORDINATE WIRING REQUIREMENTS WITH THE SECURITY SYSTEM INSTALLER.
- 4 PROVIDE A 1-1/4" PVC CONDUIT IN SLAB FOR NETWORK CABLEING SERVING DESKTOP COMPUTERS.
- 5 DOOR LOCK POWER SUPPLY
- 6 STUB CONCEALED CONDUITS UP INTO ACCESSIBLE CEILING SPACE.
- 7 PROVIDE (2) 1" CONDUITS IN SLAB FOR AV AND DATA CABLES. STUB-UP IN WALL CAVITY TO ACCESSIBLE CEILING SPACE.
- 8 PROVIDE (1) 4 11/16" SQUARE X 2 1/8" DEEP BOX WITH 2-GANG RINGAND (1) 1" CONDUIT STUBBED INTO ACCESSIBLE CEILING SPACE. PROVIDE (1) CAT 6A CABLE TO DATA ROOM IDENTIFIED ON PLANS. MOUNT AT LIGHT SWITCH HEIGHT.
- 9 PROVIDE (1) 4 11/16" SQUARE X 2 1/8" DEEP BOX WITH 2-GANG RINGAND (1) 1" CONDUIT UP TO THE AV KEYPAD J-BOX(SEE KEYED NOTE 8). MOUNT AT RECEPTACLE HEIGHT.



Webster University
Interdisciplinary Science
Building

CANNONDESIGN

1100 Clark Avenue
St. Louis, Missouri 63102
T: 314.241.6250
F: 314.241.2570

William Tao & Associates, Inc.
MEP/FP Engineer
7955 Manchester Road, Suite 125
St. Louis, MO 63143
314-884-7600

David Mason & Associates, Inc.
Structural & Civil Engineer
800 South Vandeventer Avenue
St. Louis, MO 63110
314.534.1053

Faith Group
Technology
3101 S. Hanley Rd., Suite 100
St. Louis, MO 63143
314.991.2229

Kuhnmann Leavitt, Inc.
Environmental Graphics & Signage
7400 Pershing Ave.
St. Louis, MO 63130
314.725.6616

KWA Architects
Architecture
9721 Litzinger Road
St. Louis, MO 63124
314.962.2560


Spellman Brady & Company
Interior Designer
8251 Maryland Avenue, Suite 300
St. Louis, MO 63105
314.862.0070

SWT Design
Landscape Architect
7722 Big Bend Blvd
St. Louis, MO 63119
314.644.5700

Webb Engineering Services, Inc.
Planning & Fire Protection
1400 S. 3rd Street, Suite 201
St. Louis, MO 63104
314.588.0600

6	ASI-053	24 FEB 2017
5	ASI-035	10 NOV 2016
4	ASI-030	14 OCT 2016
3	ADDENDUM 2-4	24 MAY 2016
2	ADDENDUM 2-2	19 APR 2016
1	ADDENDUM 2-1	17 MAR 2016
-	ISSUED FOR CONSTRUCTION (BP2)	01 MAR 2016

No.	Description	Date
-----	-------------	------

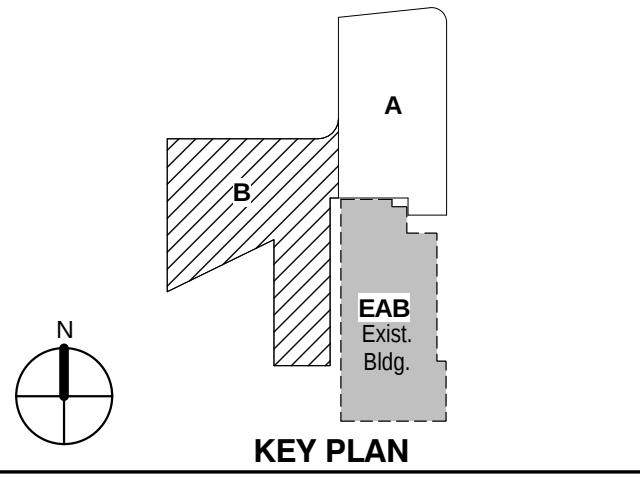

KEY PLAN

LEVEL 02 FLOOR PLAN -
AREA B

Project No.: 04561.01 Checked by:

T0102.B