


© Cannon Design 2015
All rights reserved. No part of this document may be reproduced or transmitted in any form without written authorization by The Cannon Corporation.
12/9/2016 9:55:32 AM

1 LEVEL 03 - AREA A
1/8" = 1'-0"

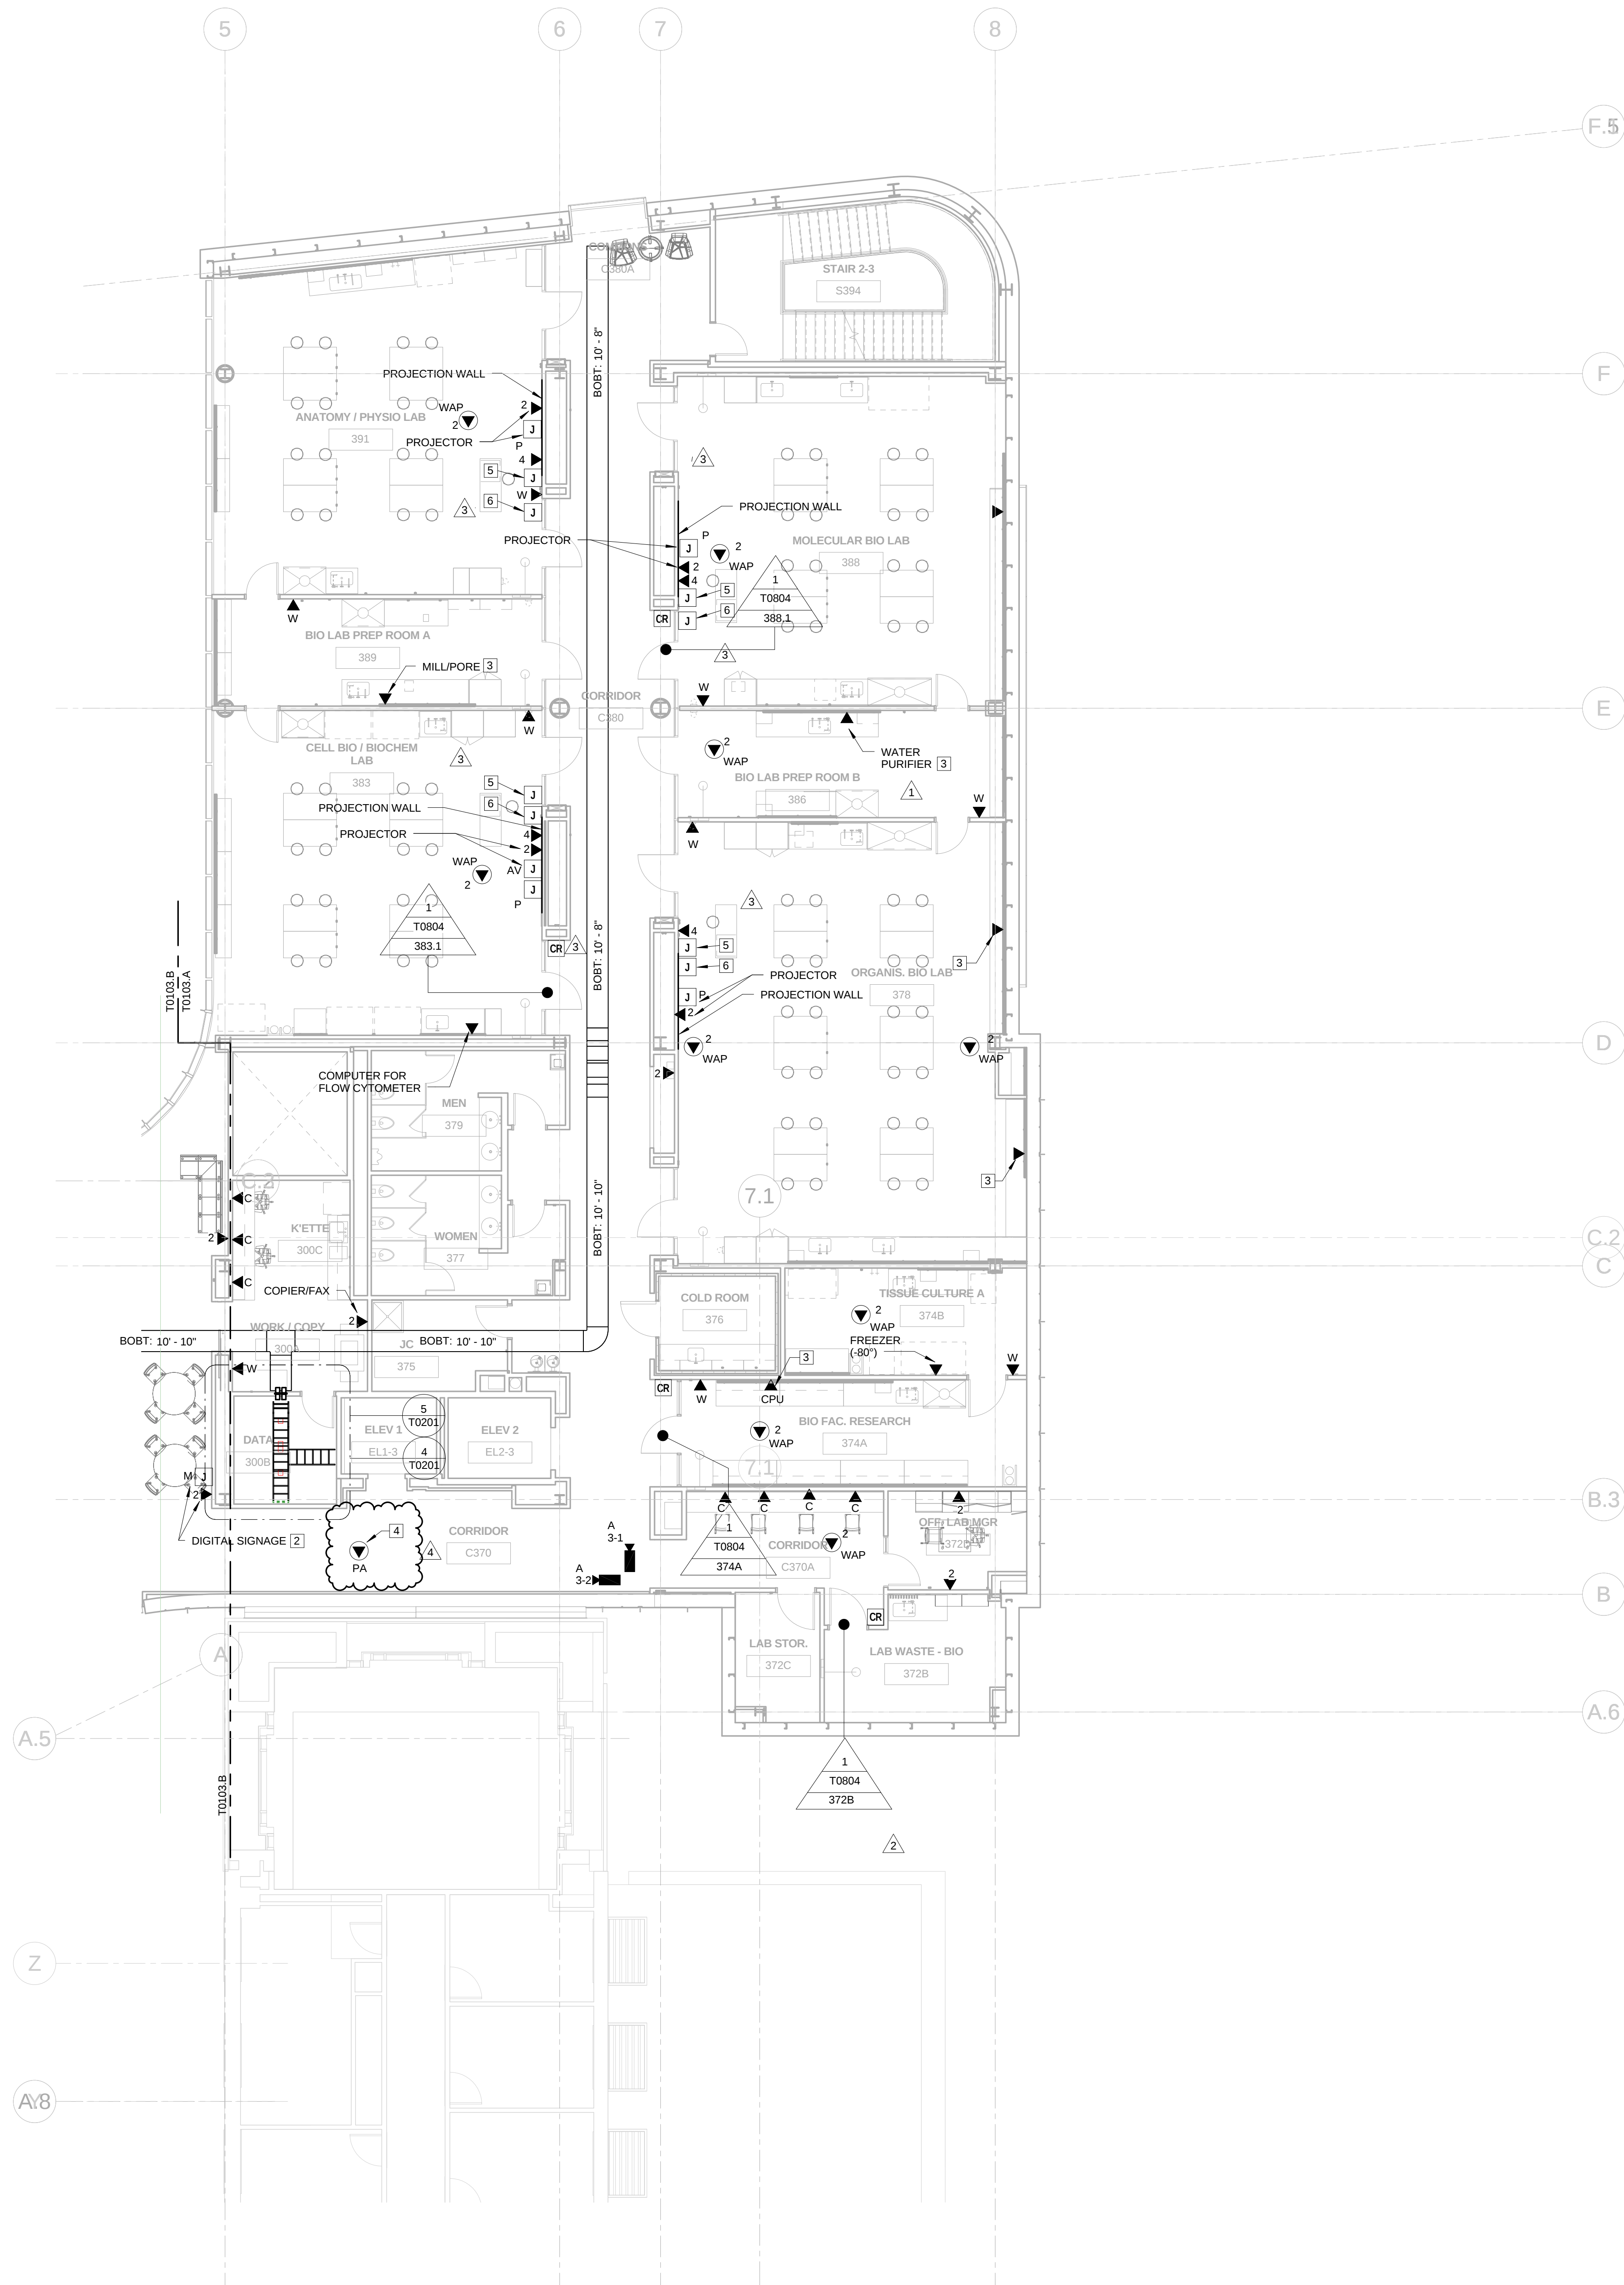

GENERAL NOTES: THIS SHEET ONLY

1. DATA OUTLETS IN OFFICE SHALL BE LOCATED ADJACENT TO AND AT THE SAME MOUNTING HEIGHT AS THE POWER RECEPTACLES. COORDINATE LOCATION WITH THE ELECTRICAL CONTRACTOR.
2. TELECOMMUNICATION CABLING ON THIS SHEET SHALL BE RUN TO LEVEL 03 DATA ROOM 300B.

KEYED NOTES: THIS SHEET ONLY

- 1 CABINET MOUNTED AV EQUIPMENT (OFVI)
- 2 CONFIRM EXACT LOCATION OF DATA OUTLET AND MONITOR WITH AV VENDOR PRIOR TO INSTALLATION.
- 3 INSTALL COMMUNICATION OUTLET IN THE COMMUNICATIONS SIDE OF THE 2 CHANNEL RACEWAY. SEE ELECTRICAL DRAWINGS FOR RACEWAY INFORMATION.
- 4 COORDINATE EXACT LOCATION WITH PA INSTALLER.
- 5 PROVIDE (1) 4-11/16" SQUARE X 2-1/8" DEEP BOX WITH 2 GANG RING AND (1) 1" CONDUIT STUBBED INTO ACCESSIBLE CEILING SPACE FOR AV KEYPAD. PROVIDE (1) CAT 6A CABLE TO DATA ROOM IDENTIFIED ON PLANS. MOUNT AT LIGHT SWITCH HEIGHT.
- 6 PROVIDE (1) 4-11/16" SQUARE X 2-1/8" DEEP BOX WITH 2 GANG RING FOR THE AV INPUT PLATE. MOUNT AT RECEPTACLE HEIGHT. PROVIDE (1) 1" CONDUIT UP TO THE AV KEYPAD J-BOX. (SEE KEYED NOTE 5).



Webster University
Interdisciplinary Science
Building

CANNONDESIGN

1100 Clark Avenue
St. Louis, Missouri 63102
T: 314.241.6250
F: 314.241.2570

William Tao & Associates, Inc.
MEP/FP Engineer
7955 Manchester Road, Suite 125
St. Louis, MO 63143
314-884-7600

David Mason & Associates, Inc.
Structural & Civil Engineer
800 South Vandeventer Avenue
St. Louis, MO 63110
314.534.1053

Faith Group
Technology
3101 S. Hanley Rd. Suite 100
St. Louis, MO 63143
314.991.2229

Kuhmann Leavitt, Inc.
Environmental Graphics & Signage
7400 Pershing Ave.
St. Louis, MO 63130
314.725.6616


KWA Architects
Architecture
9721 Litzinger Road
St. Louis, MO 63124
314.962.2560

Spellman Brady & Company
Interior Designer
8251 Maryland Avenue, Suite 300
St. Louis, MO 63105
314.862.0070

SWT Design
Landscape Architect
7722 Big Bend Blvd
St. Louis, MO 63119
314.644.5700

Webb Engineering Services, Inc.
Planning & Fire Protection
1400 S. 3rd Street, Suite 201
St. Louis, MO 63104
314.588.0600

4	ASI-040	09 DEC 2016
3	ASI-035	10 NOV 2016
2	ADDENDUM 2-2	19 APR 2016
1	ADDENDUM 2-1	17 MAR 2016
-	ISSUED FOR CONSTRUCTION (BP2)	01 MAR 2016

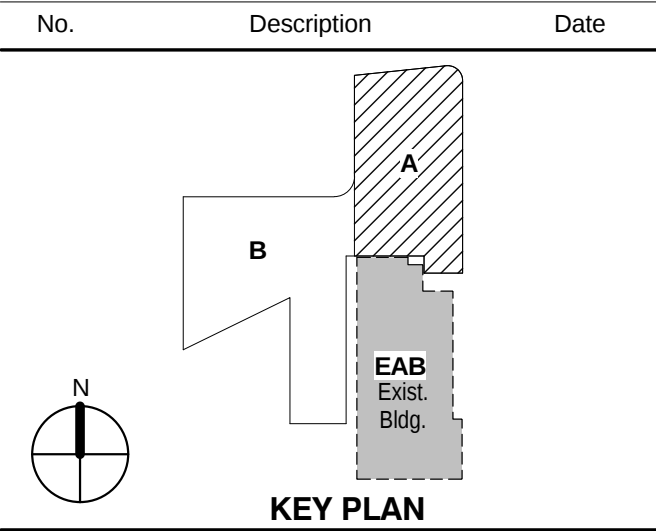

Drawing Title:

LEVEL 03 FLOOR PLAN -
AREA A

Project No.: 04561.01 Checked by:

T0103.A