



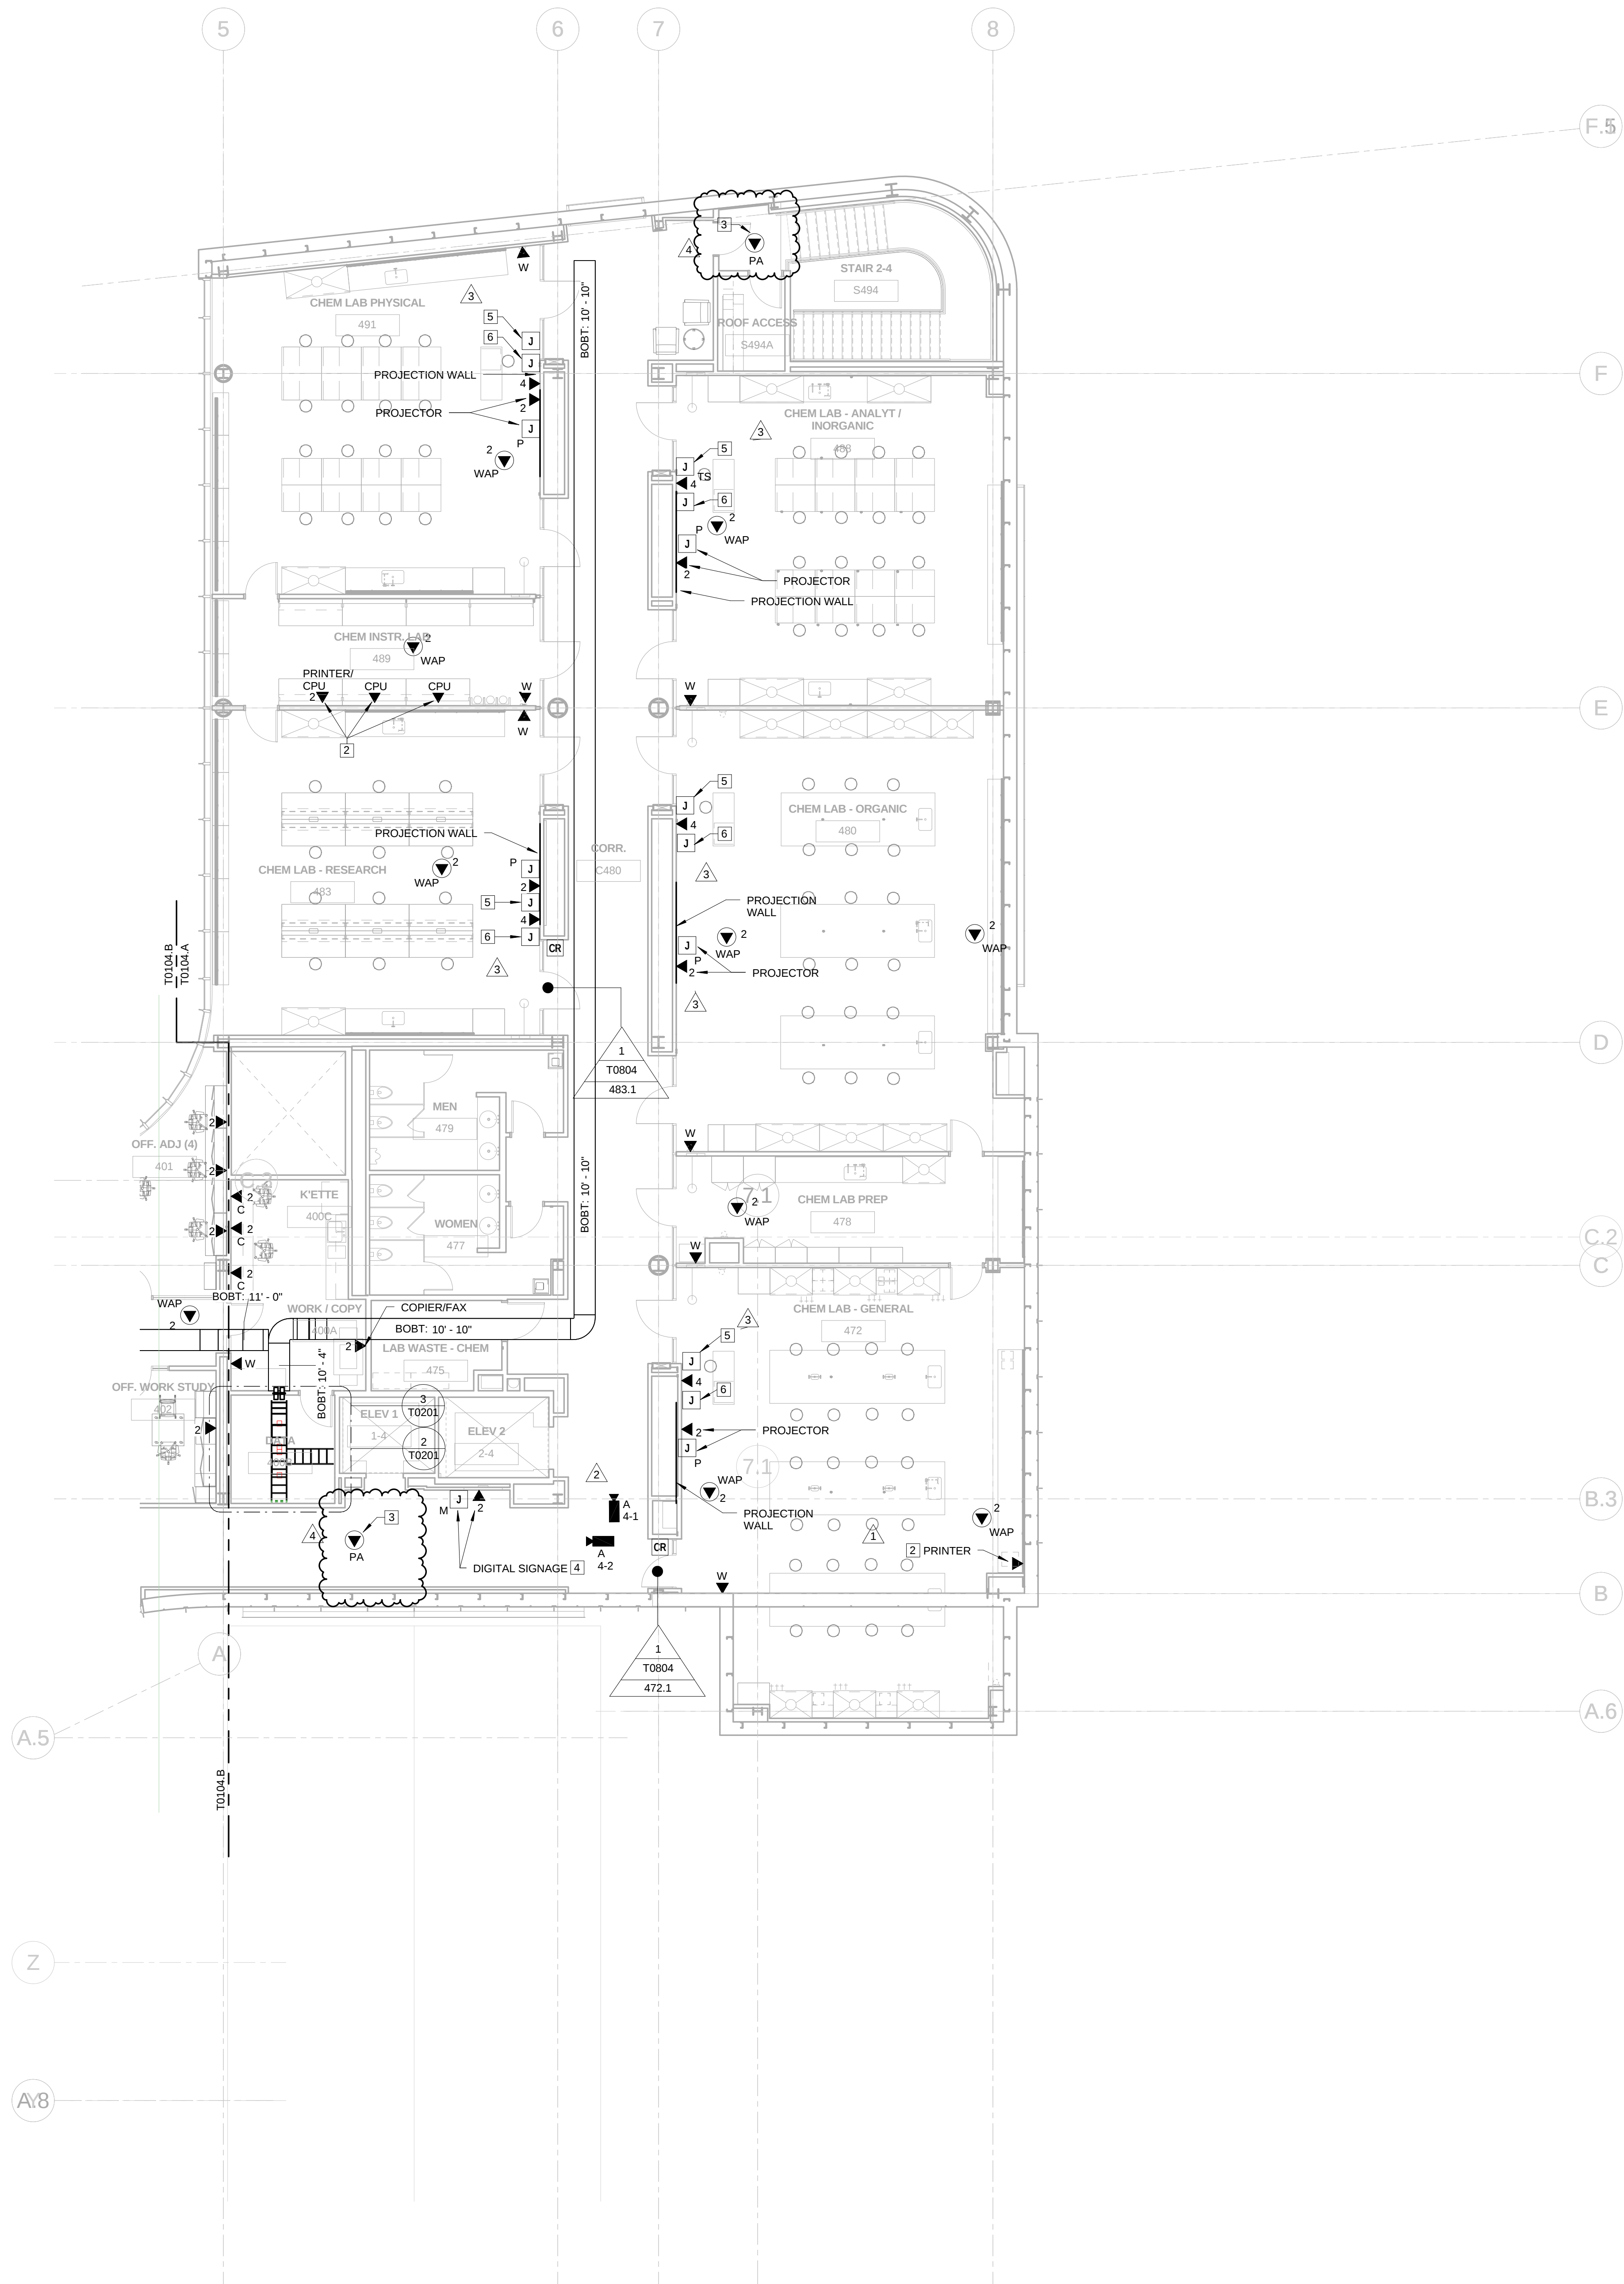

- GENERAL NOTES:** THIS SHEET ONLY
- DATA OUTLETS IN OFFICE SHALL BE LOCATED ADJACENT TO AND AT THE SAME MOUNTING HEIGHT AS THE POWER RECEPTACLES. COORDINATE LOCATION WITH THE ELECTRICAL CONTRACTOR.
 - TELECOMMUNICATION CABLEING ON THIS SHEET SHALL BE RUN TO LEVEL 04 DATA ROOM 400B.

- KEYED NOTES:** THIS SHEET ONLY
- CABINET MOUNTED AV EQUIPMENT (OPVI)
 - INSTALL COMMUNICATION OUTLET IN THE COMMUNICATION SIDE OF THE 2 CHANNEL RACEWAY. SEE ELECTRICAL DRAWINGS FOR DETAILS.
 - COORDINATE EXACT LOCATION WITH PA INSTALLER.
 - CONFIRM EXACT LOCATION OF DATA OUTLET AND MONITOR WITH AV VENDOR PRIOR TO INSTALLATION.
 - PROVIDE (1) 4-11/16" SQUARE X 2-1/8" DEEP BOX WITH 2 GANG RING AND (1) 1" CONDUIT STUBBED INTO ACCESSIBLE CEILING SPACE FOR AV KEYPAD. PROVIDE (1) CAT 6A CABLE TO DATA ROOM IDENTIFIED ON PLANS. MOUNT AT LIGHT SWITCH HEIGHT.
 - PROVIDE (1) 4-11/16" SQUARE X 2-1/8" DEEP BOX WITH 2 GANG RING FOR THE AV INPUT PLATE. MOUNT AT RECEPTACLE HEIGHT. PROVIDE (1) 1" CONDUIT UP TO THE AV KEYPAD J-BOX (SEE KEYED NOTE 5).

4	ASI-040	09 DEC 2016
3	ASI-035	10 NOV 2016
2	ADDENDUM 2-4	24 MAY 2016
1	ADDENDUM 2-1	17 MAR 2016
-	ISSUED FOR CONSTRUCTION (BP2)	01 MAR 2016

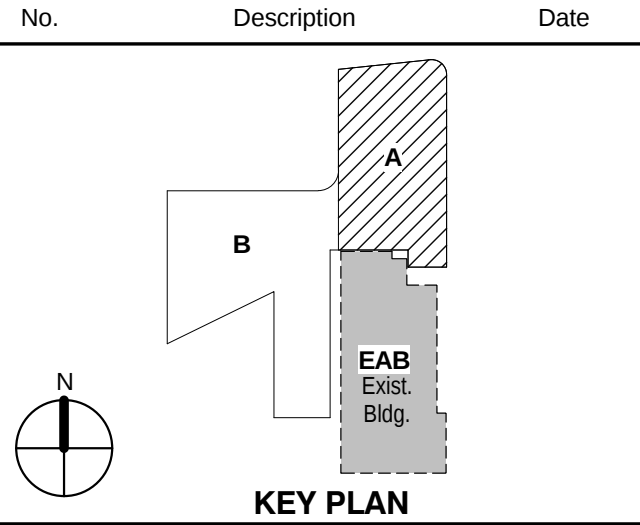

**LEVEL 04 FLOOR PLAN -
AREA A**

Project No.: 04561.01 Checked by:

T0104.A