
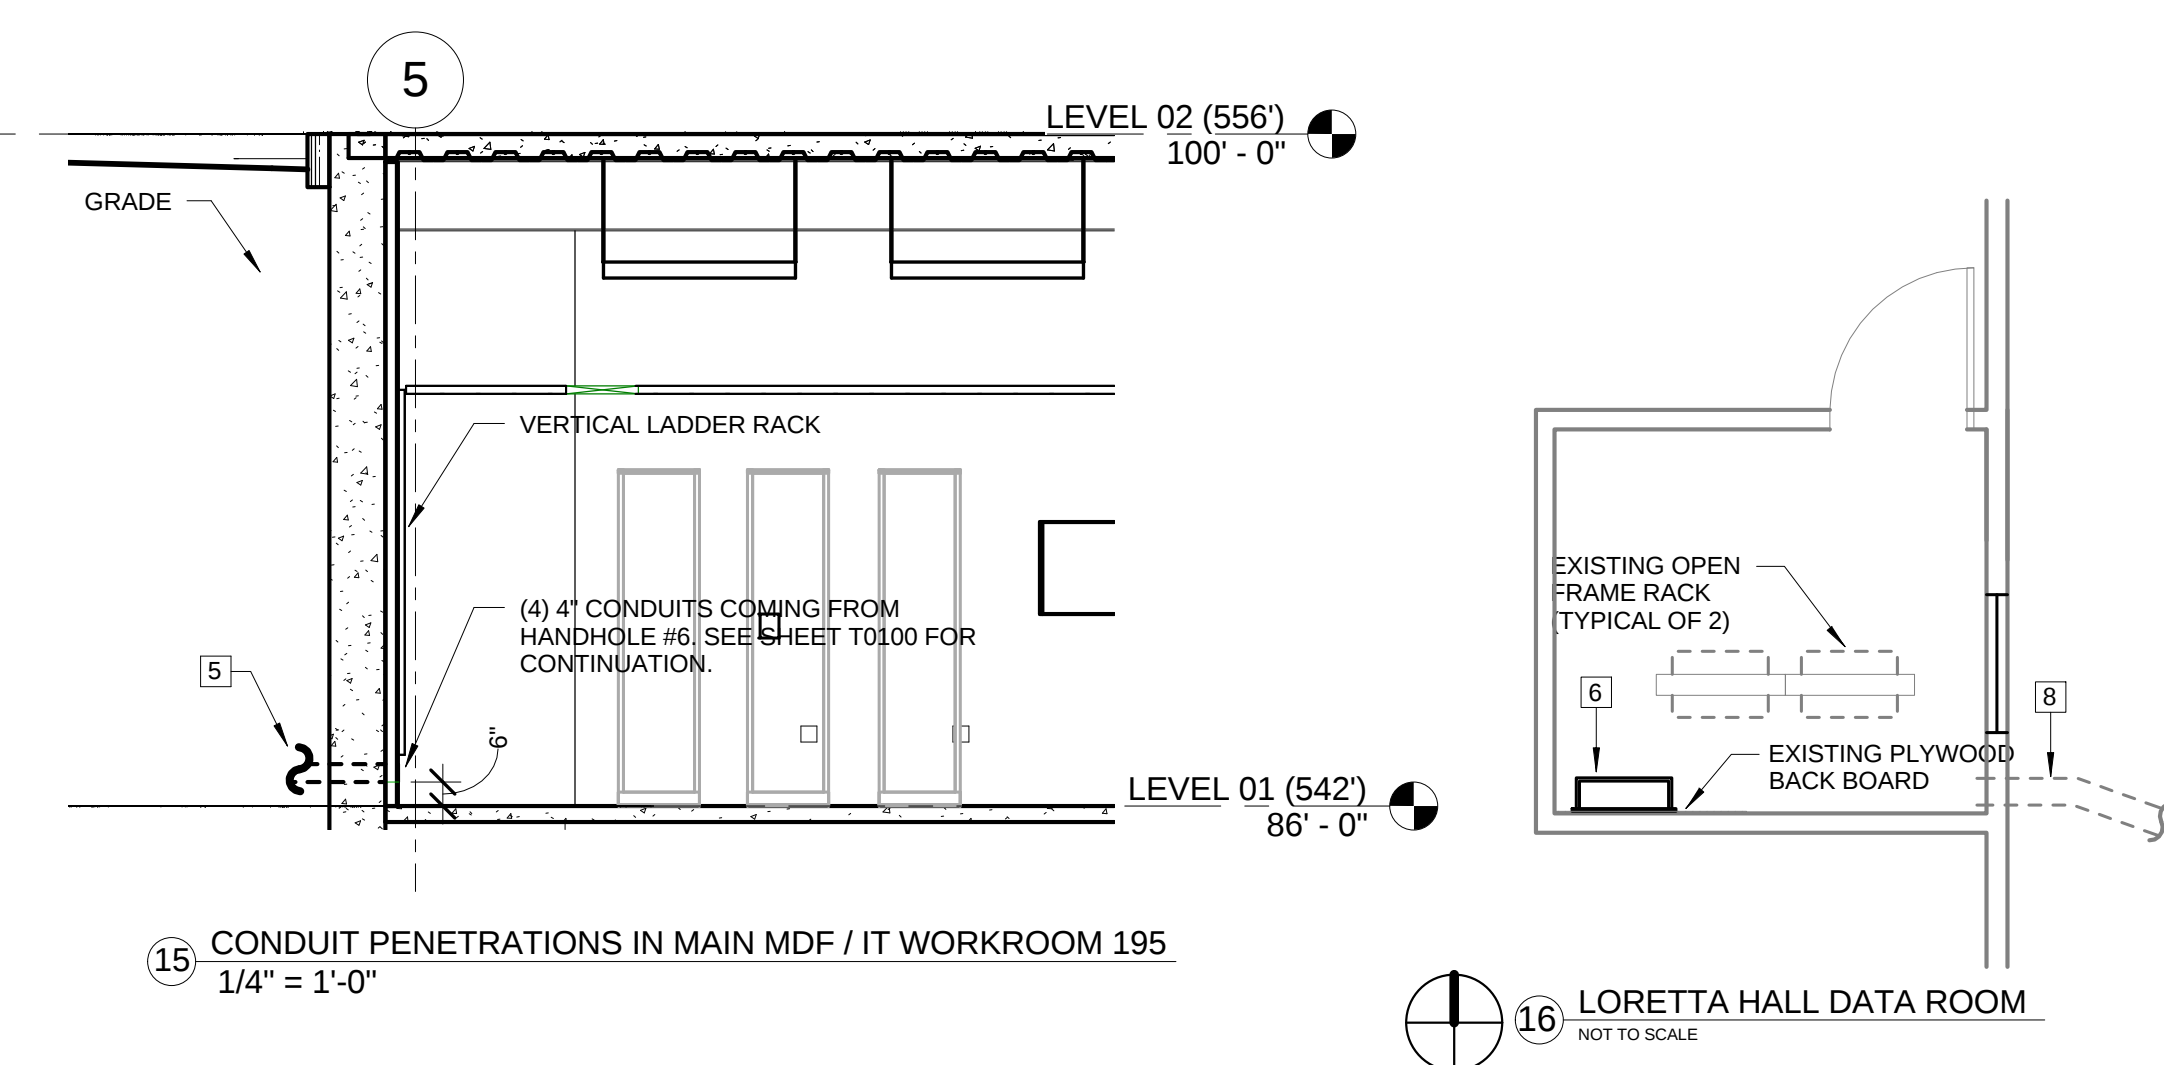
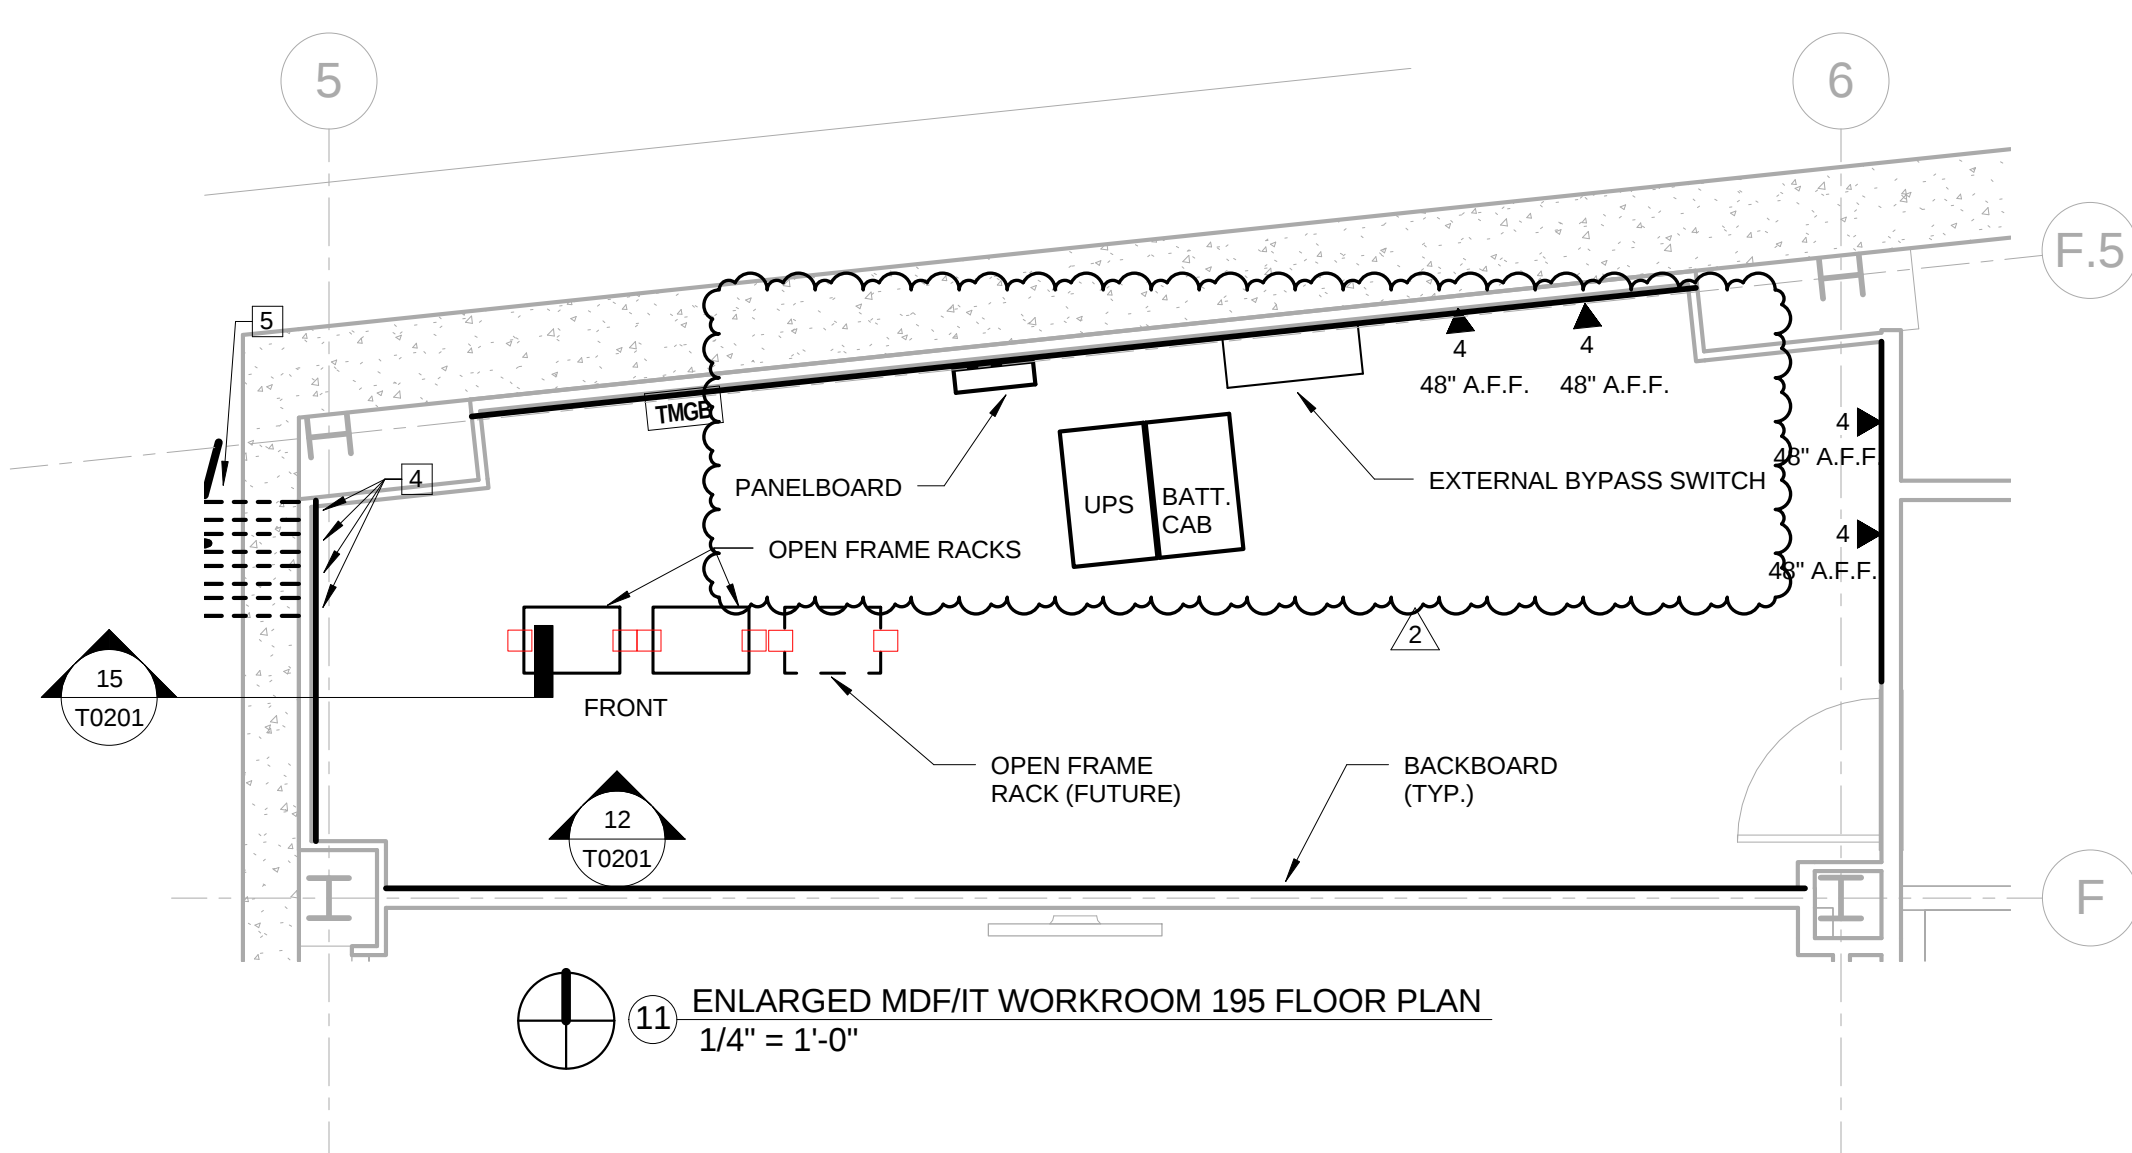
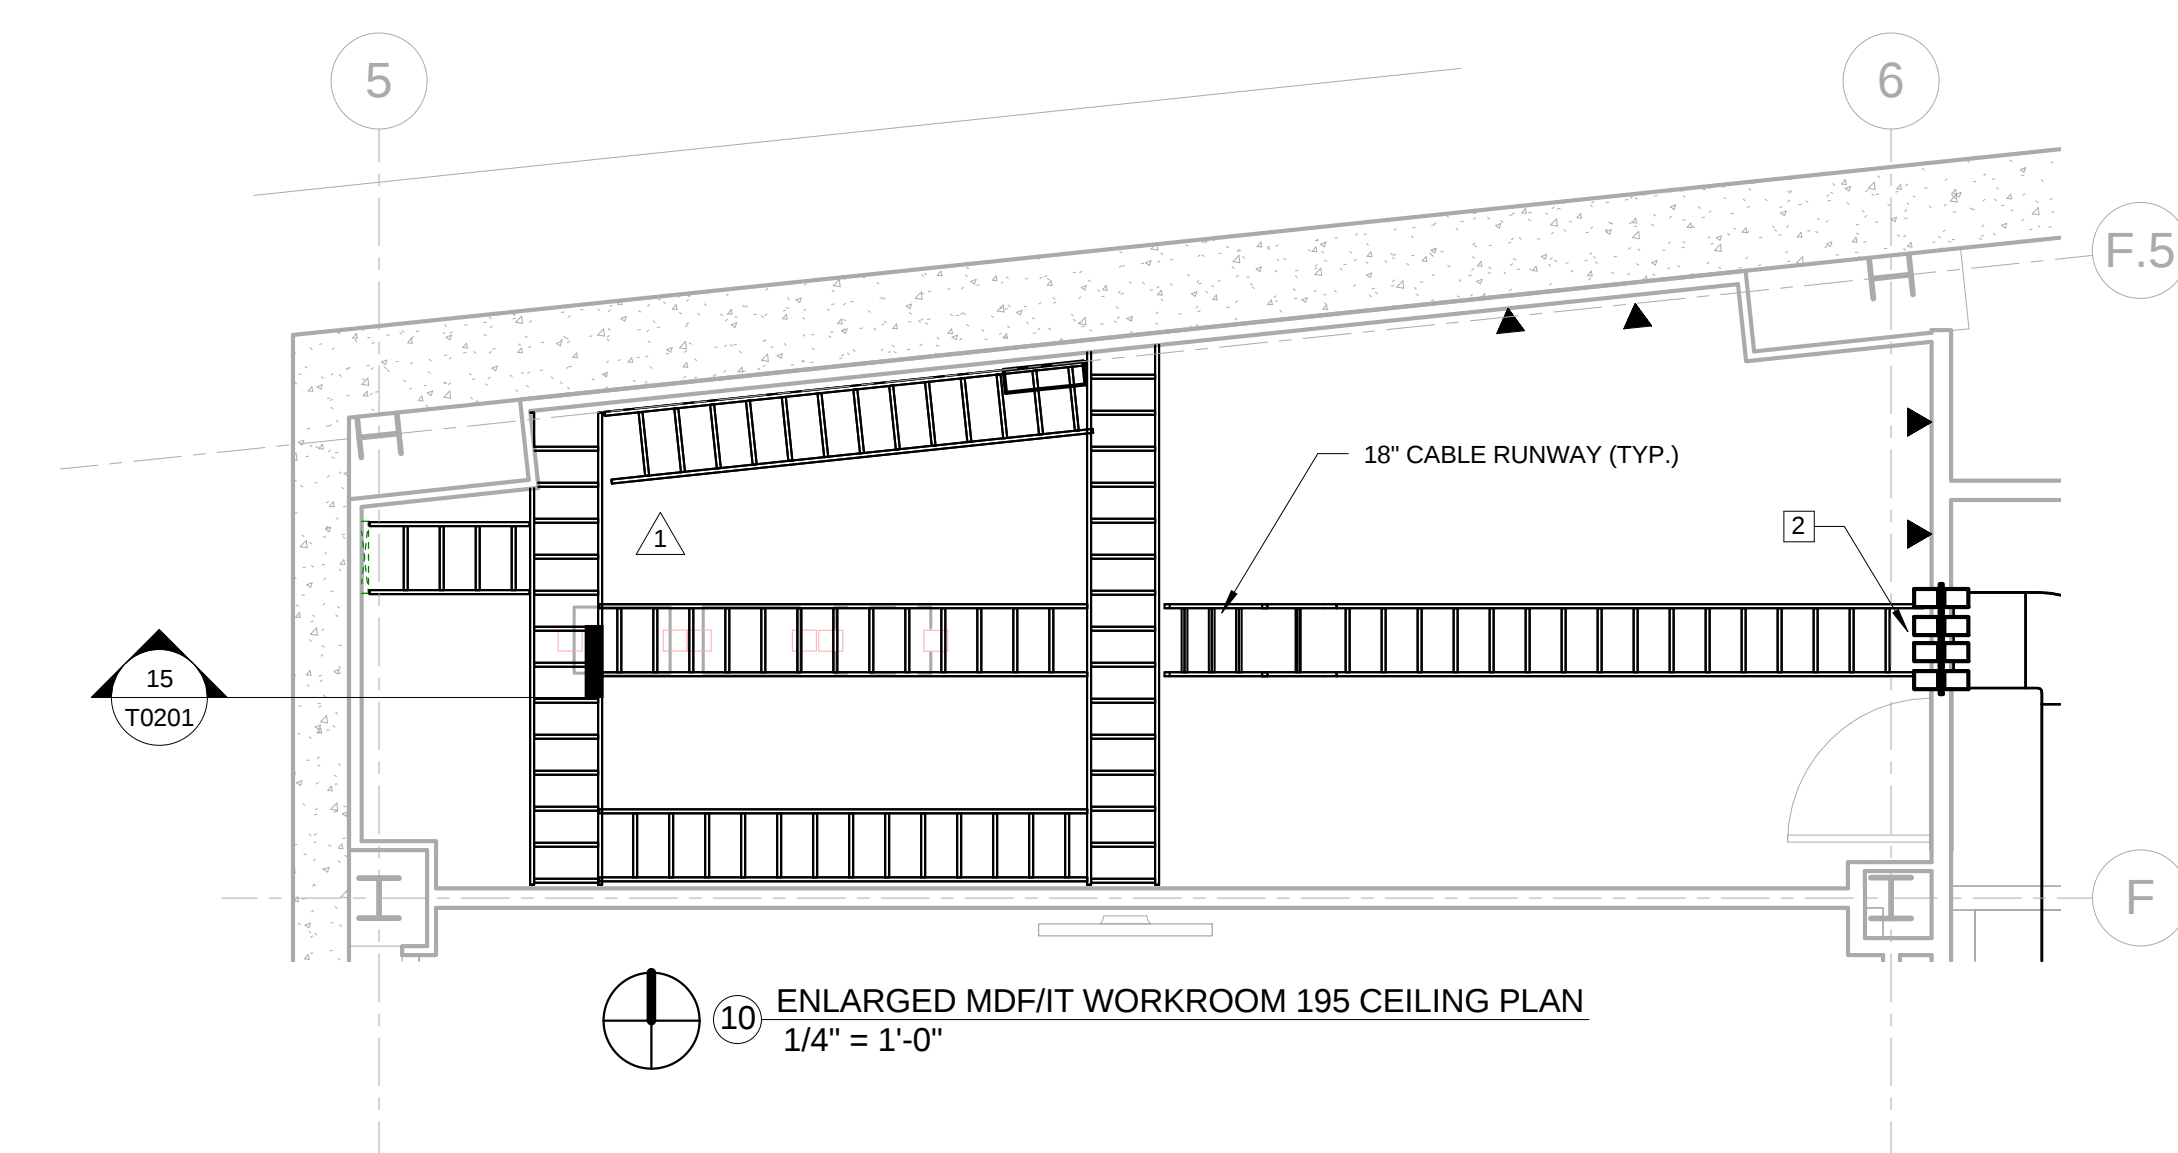
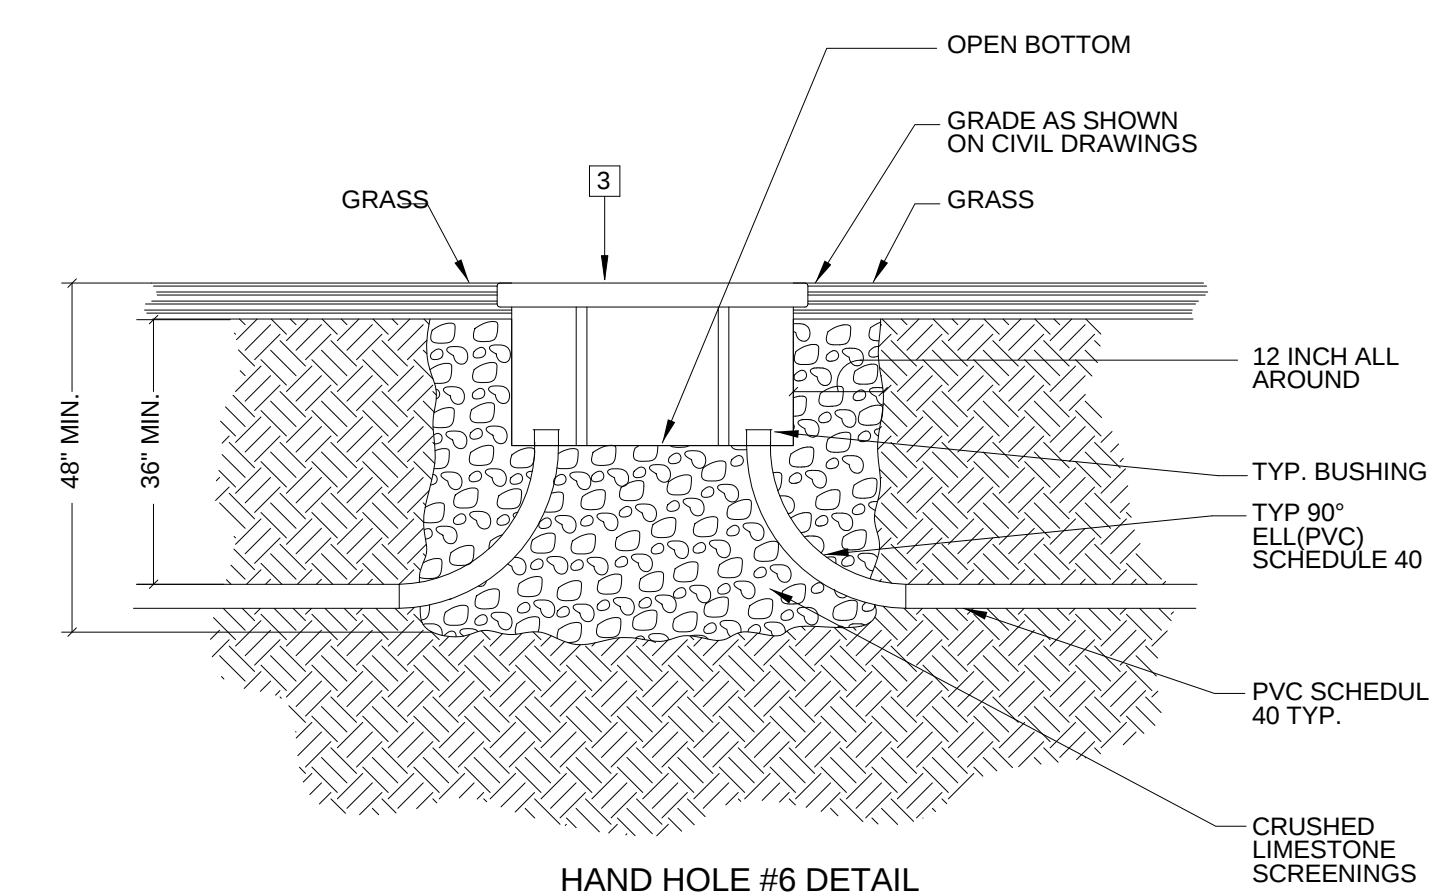
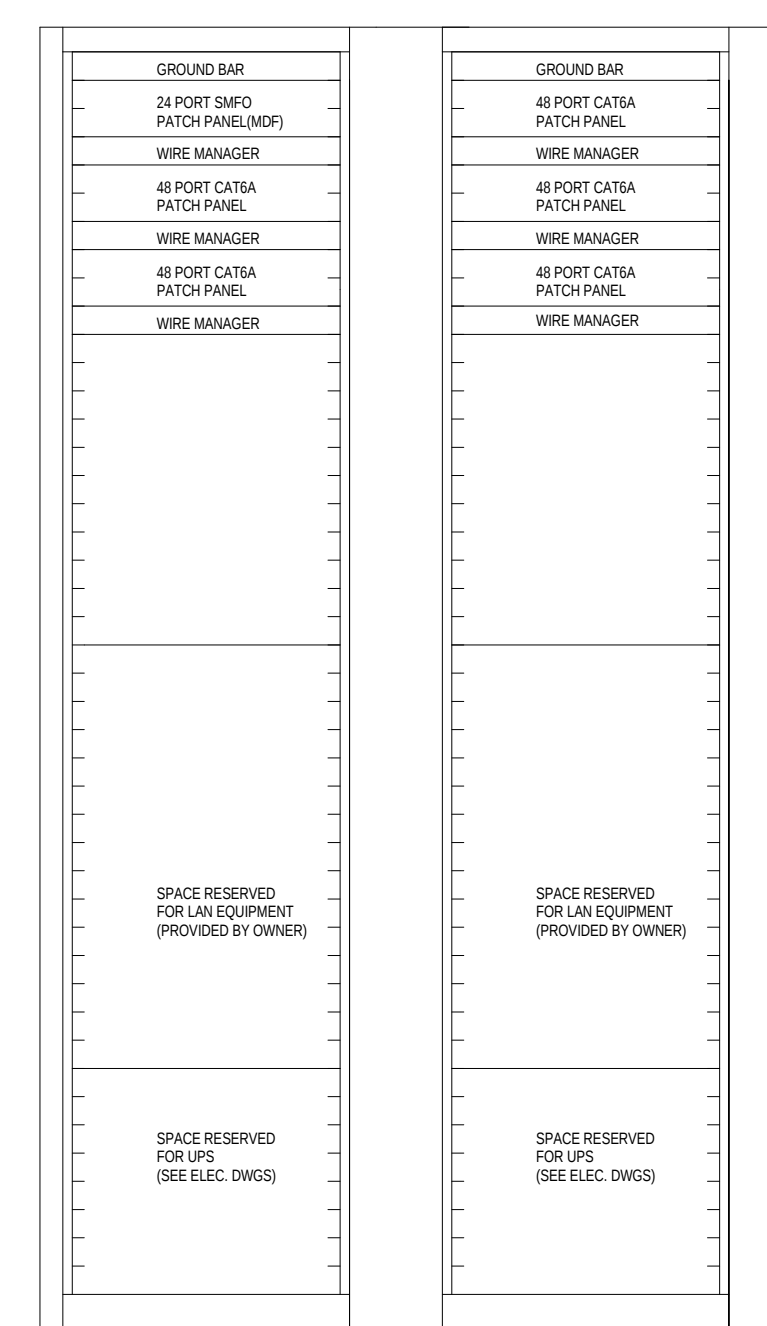
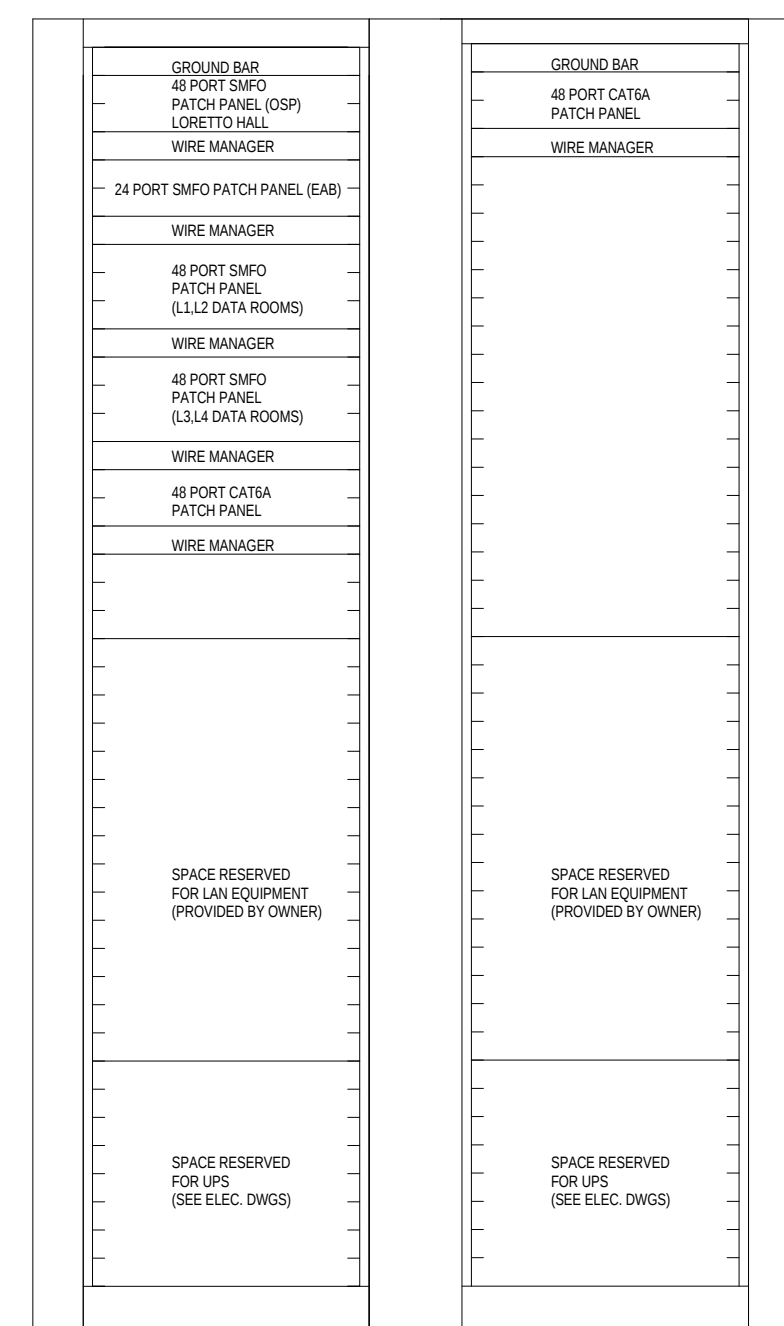
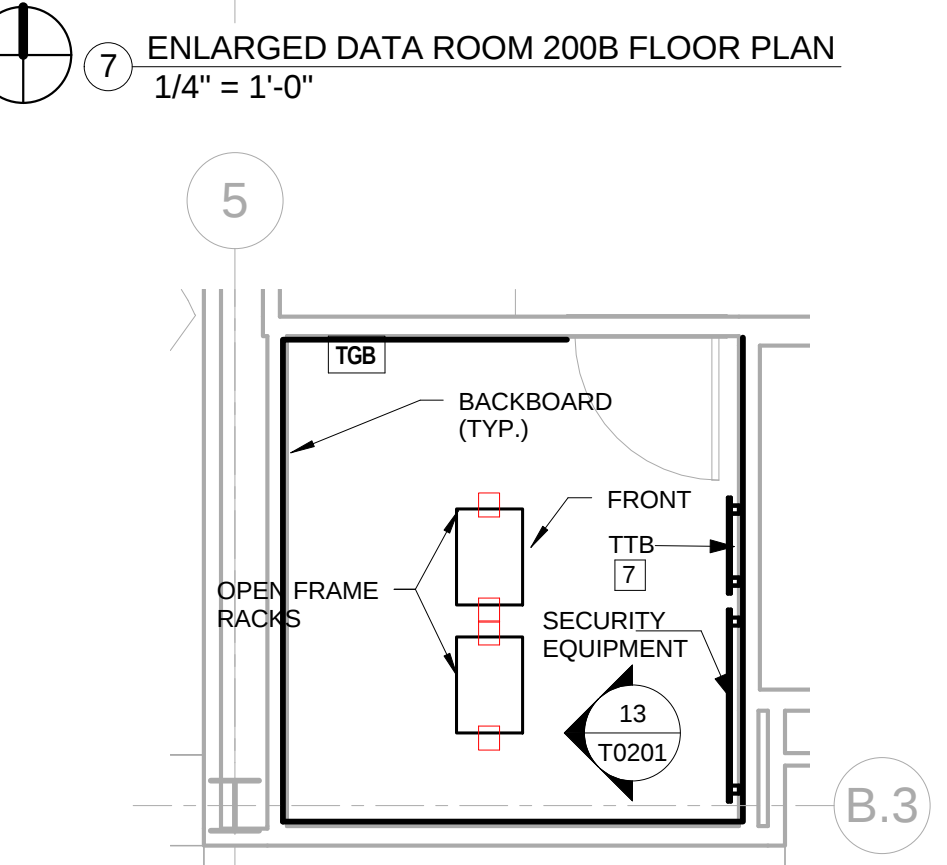
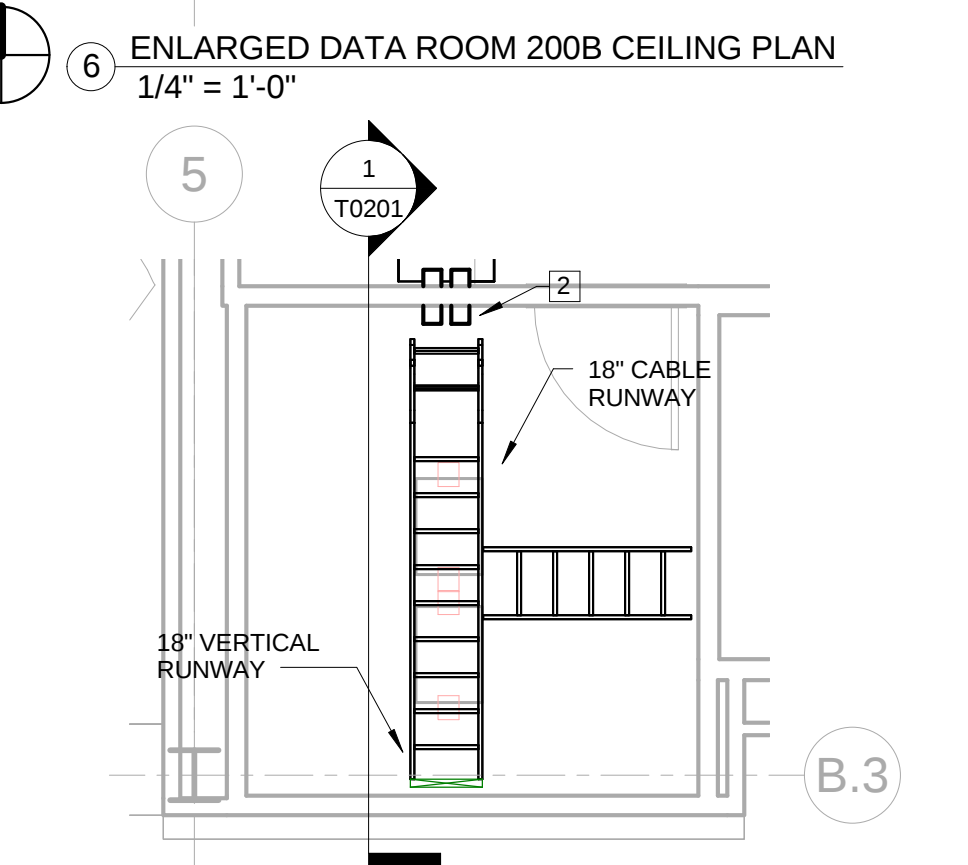
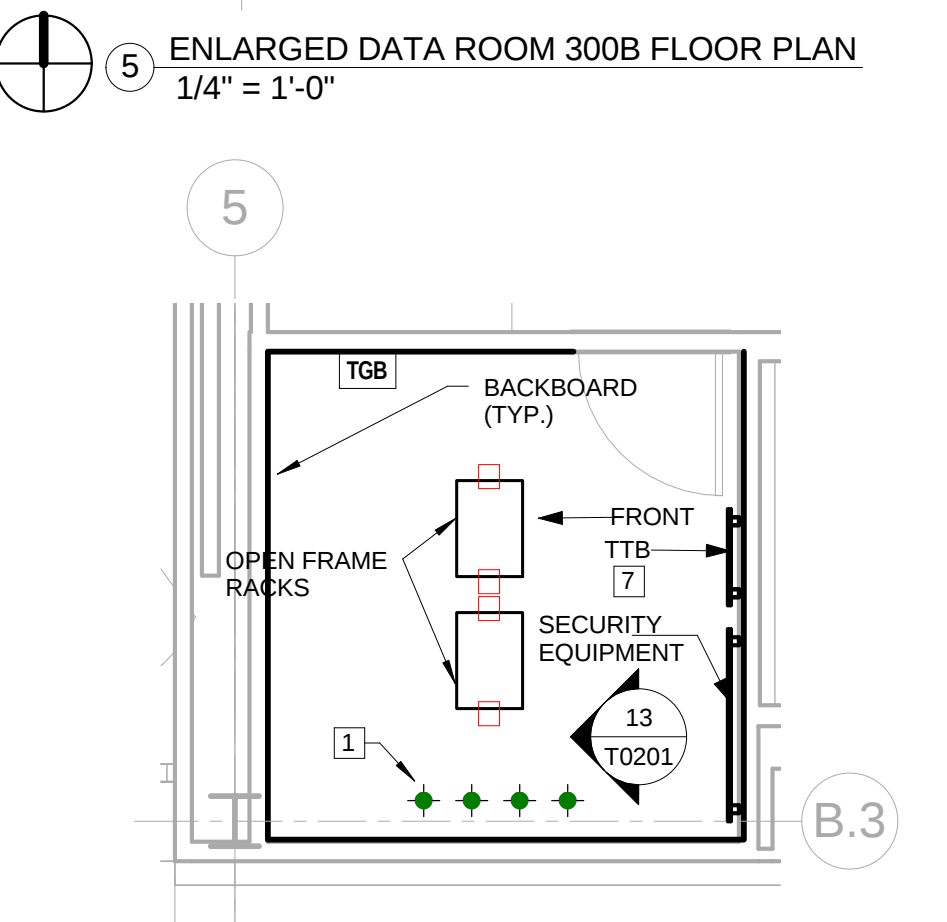
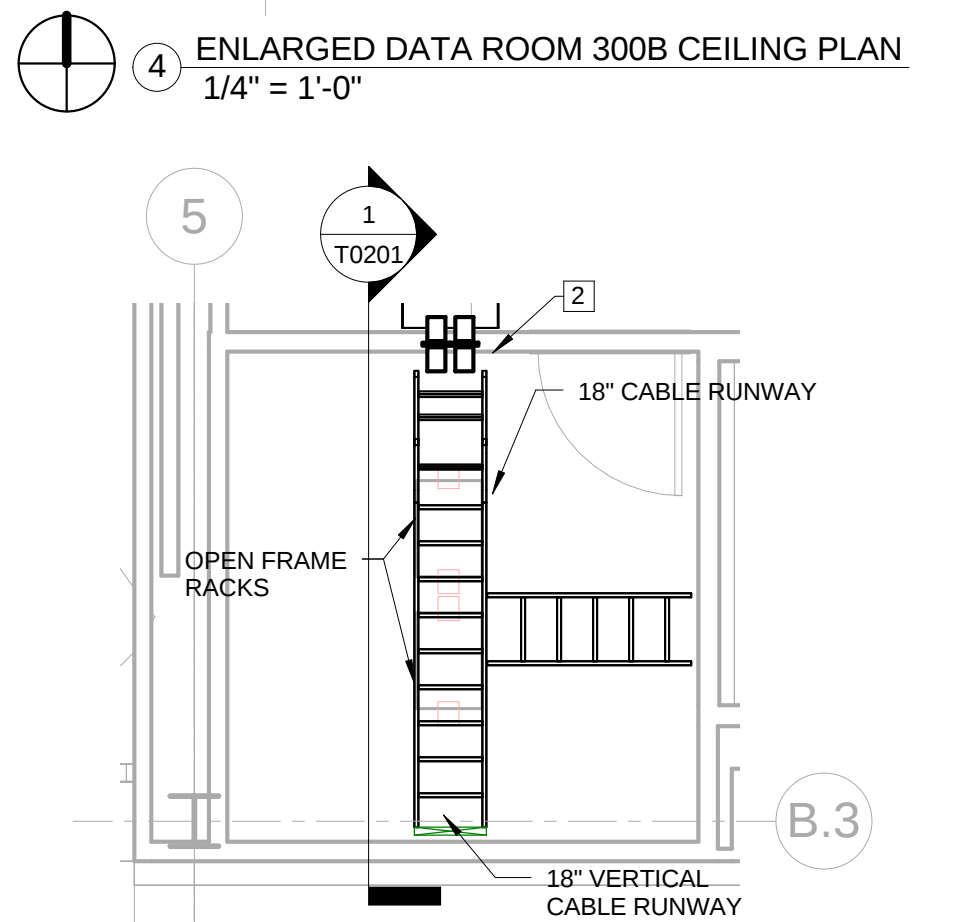
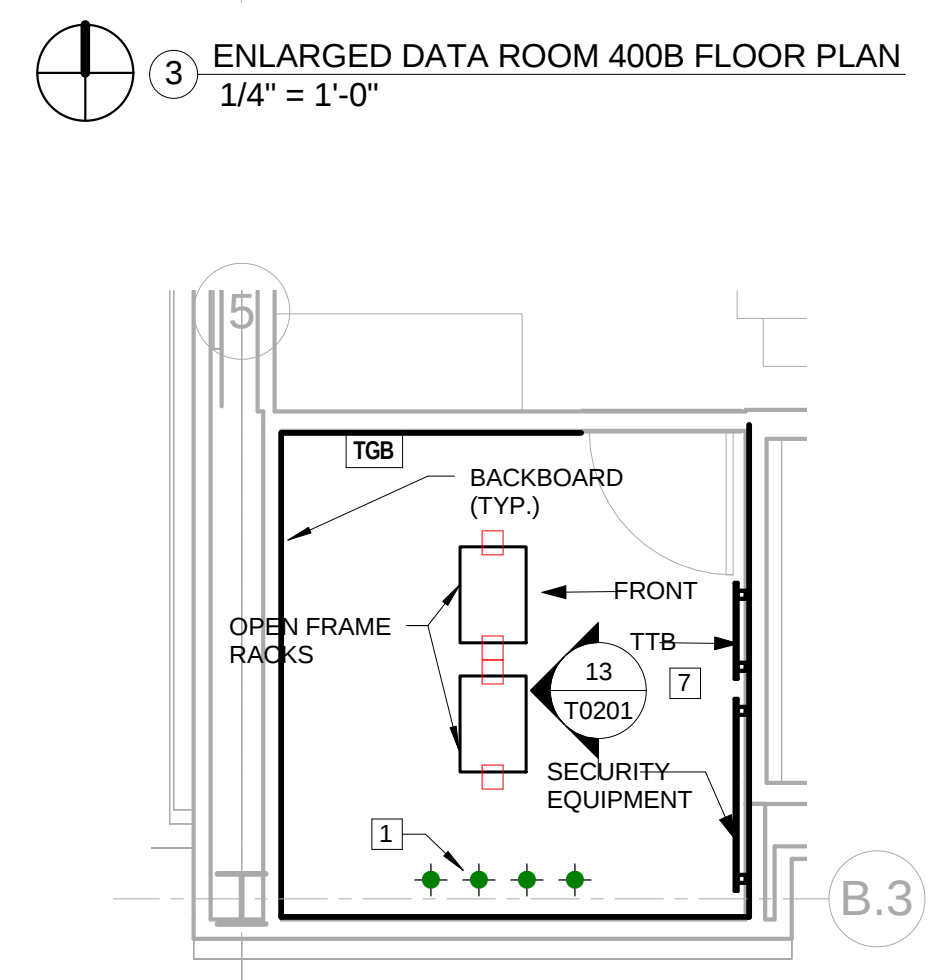
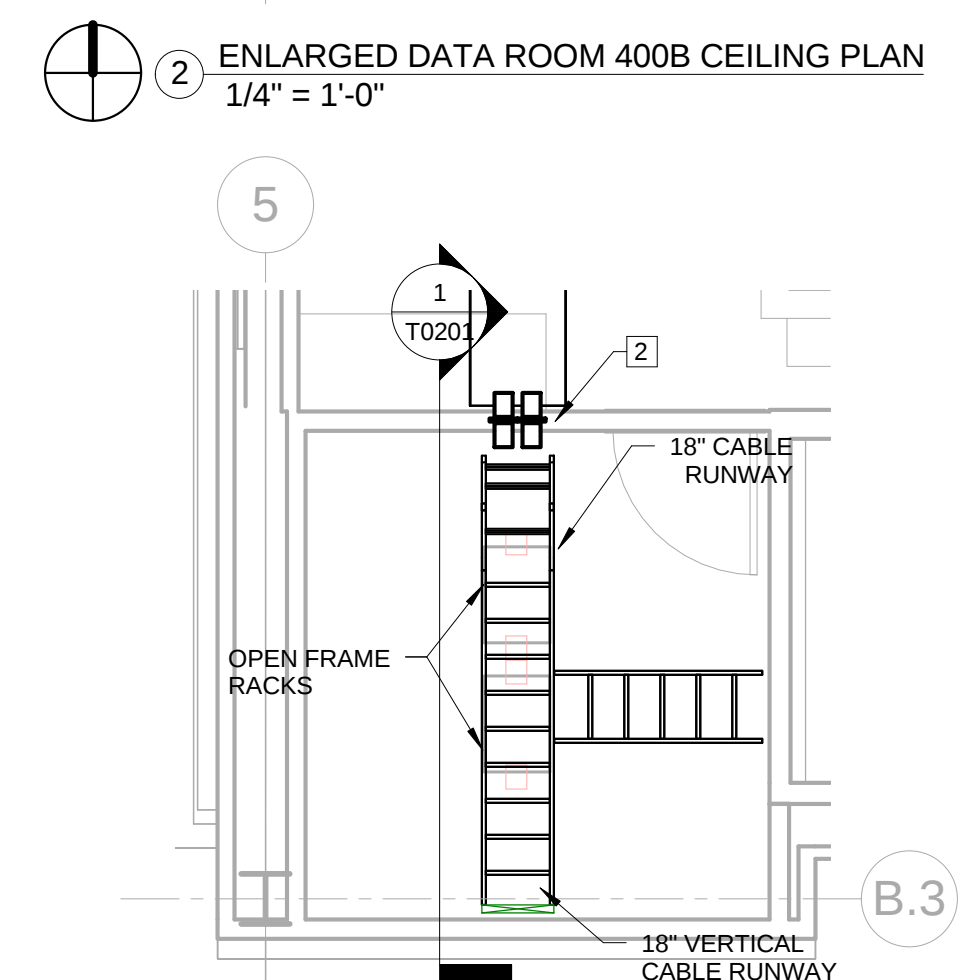
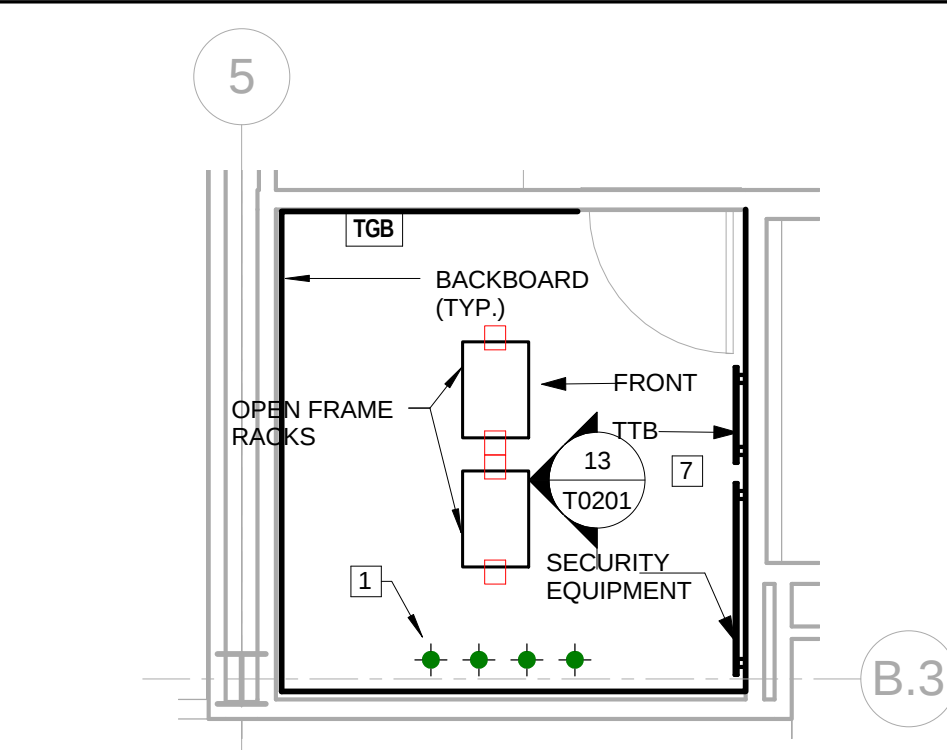
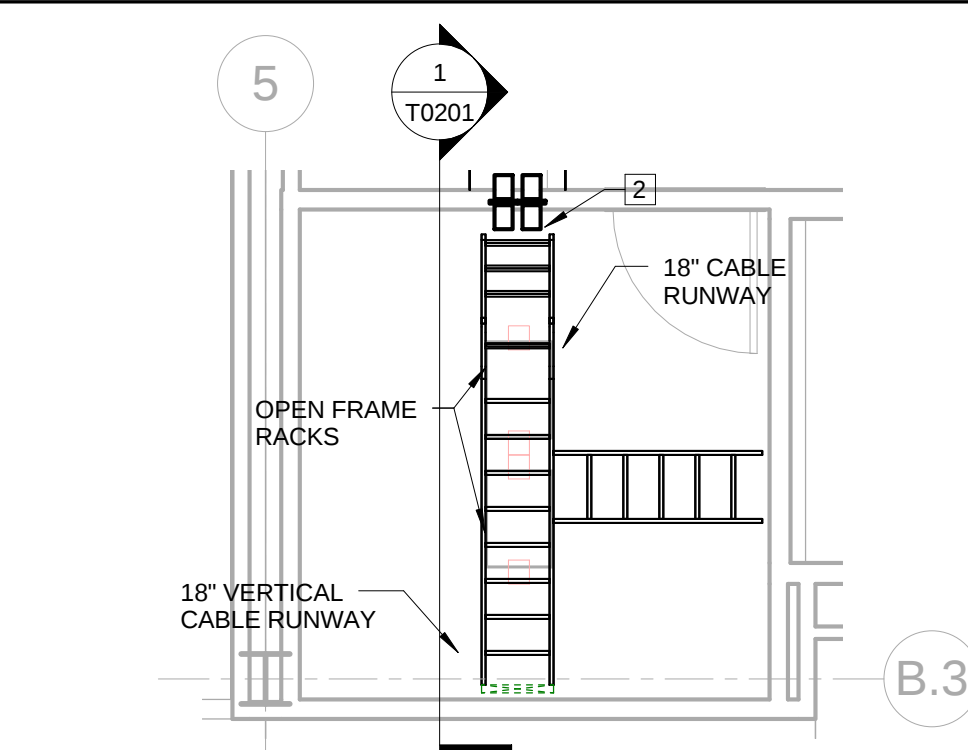


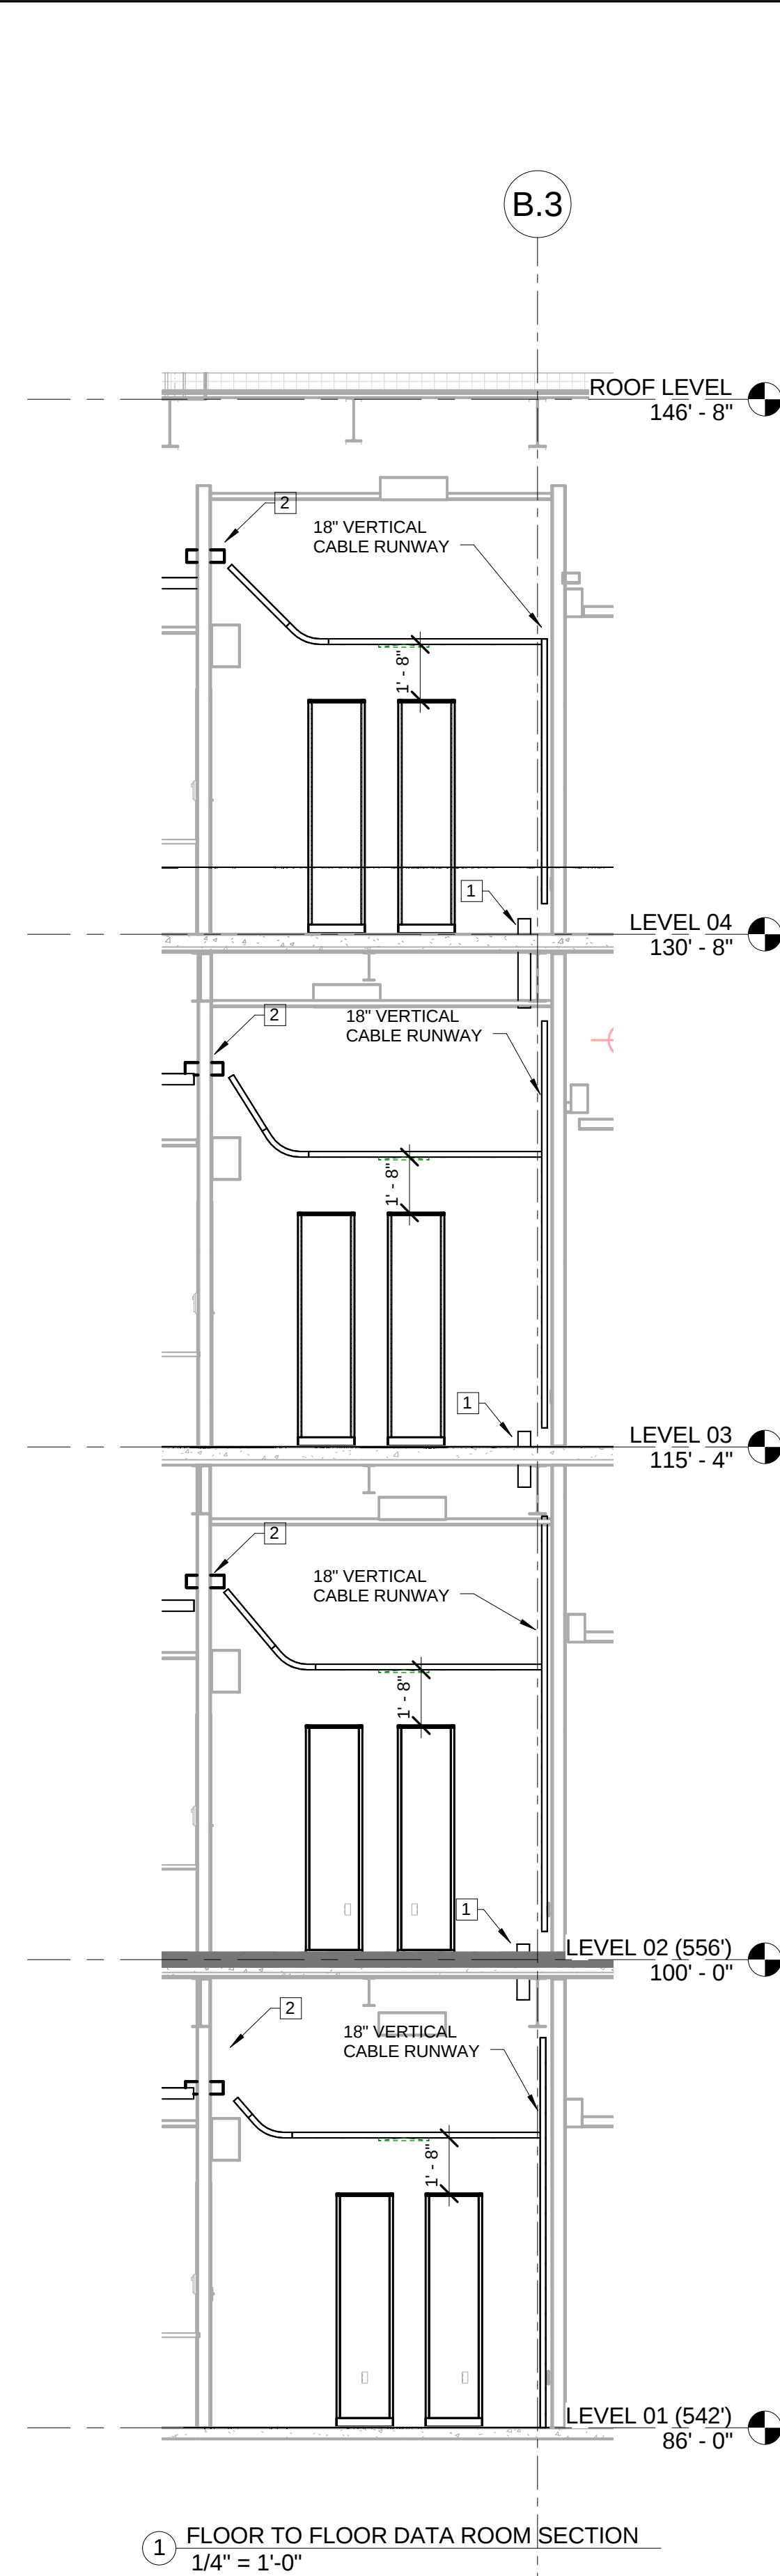

GENERAL NOTES:

THIS SHEET ONLY

1. CONFIRM LOCATION OF ALL COPPER AND FIBER PATCH PANELS WITH WEBSTER UNIVERSITY IT DEPARTMENT PRIOR TO INSTALLATION.
2. PROVIDE 3/4" THICK FIRE RATED PLYWOOD BACKBOARDS ON ALL WALLS OF THE MDF ROOM AND DATA ROOMS. BACKBOARD SHALL STAND 6" A.F.F. AND EXTEND 8'-0" HIGH. PAINT ALL SIX (6) SIDES BACKBOARD WITH WHITE FIRE RETARDANT PAINT LEAVING FIRE RATED LABELS EXPOSED.

KEYED NOTES:

THIS SHEET ONLY

- | | |
|---|--|
| 1 | PROVIDE FLOOR MOUNTED FIRE RATED PATHWAYS. SEE SPECIFICATION SECTION 078413 FOR MORE INFORMATION. |
| 2 | PROVIDE WALL MOUNTED FIRE RATED PATHWAYS. SEE SPECIFICATION SECTION 078413 FOR MORE INFORMATION. |
| 3 | PROVIDE QUARTZITE #PG336CB3A36 (TIER 22) HAND HOLE WITH A #PG336CB30R FOR HEAVY DUTY COVER. LOGO SHALL READ "COMMUNICATION". |
| 4 | PROVIDE (4) #4 SCHEDULE 40 PVC CONDUITS. PROVIDE STEEL SLEEVE FOR EACH CONDUIT PENETRATION THROUGH THE WALL. PROVIDE WATER TIGHT SEAL. PROVIDE (3) 1" INERDUCTS WITH PULL STRINGS IN ONE OF THE CONDUITS. PROVIDE PULL STRINGS IN THE REMAINING (3) CONDUITS. |
| 5 | TO HANDHOLE #6. SEE SHEETS T0100 AND T0201 FOR MORE INFORMATION. |
| 6 | PROVIDE 48 PORT SMOG WALL MOUNT PATCH PANEL (SEE "POS BACKBONE CABLING DIAGRAM" ON SHEET T0801). ATTACH TO THE EXISTING PLYWOOD BACKBOARD. THE OWNER SHALL BE RESPONSIBLE FOR REMOVING ABANDONED WALL MOUNTED EQUIPMENT TO MAKE ROOM FOR THE PATCH PANEL. SECURE CABLE TO EXISTING PLYWOOD BACKBOARD EVERY 48" C/W WITH VELCRO STRAPS. SEE DETAIL #3 ON SHEET T0801. |
| 7 | PROVIDE 50 PAIR 66M PUNCHDOWN BLOCK FOR TERMINATION OF ANALOG COPPER BACKBONE CABLEING. |
| 8 | EXISTING 4" UNDERGROUND CONDUIT UP TO HANDHOLE #6. SEE SHEET T0100. |