




© Cannon Design 2015
All rights reserved. No part of this document may be reproduced or transmitted in any form without written authorization by The Cannon Corporation.
4/18/2016 1:45:30 PM

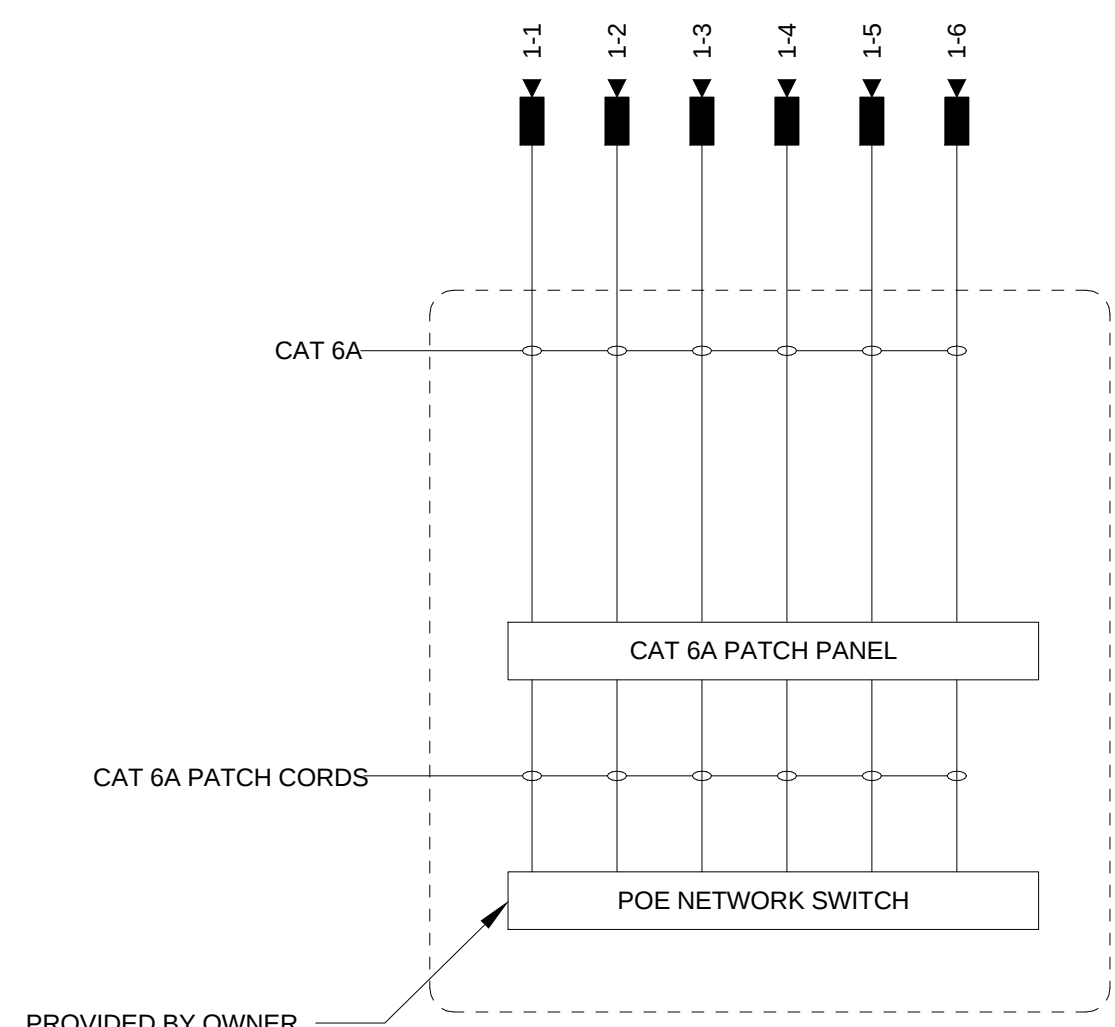


DATA 100B ROOM

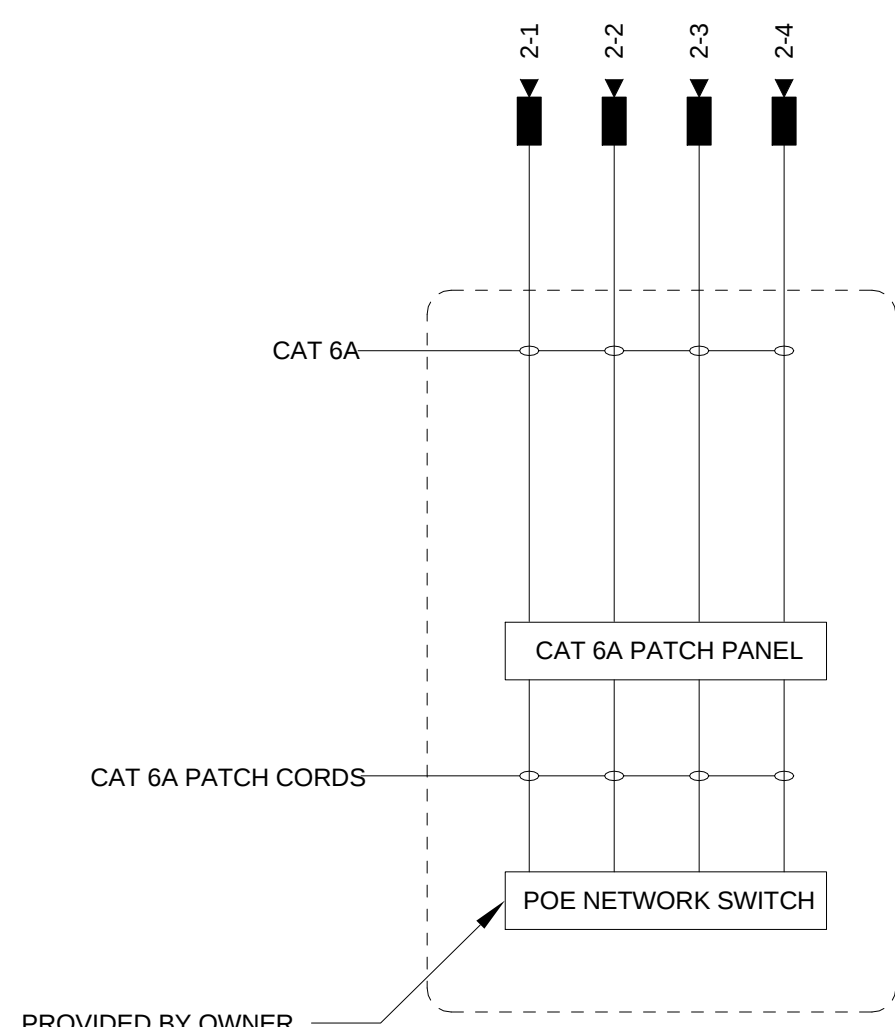


DATA 200B ROOM

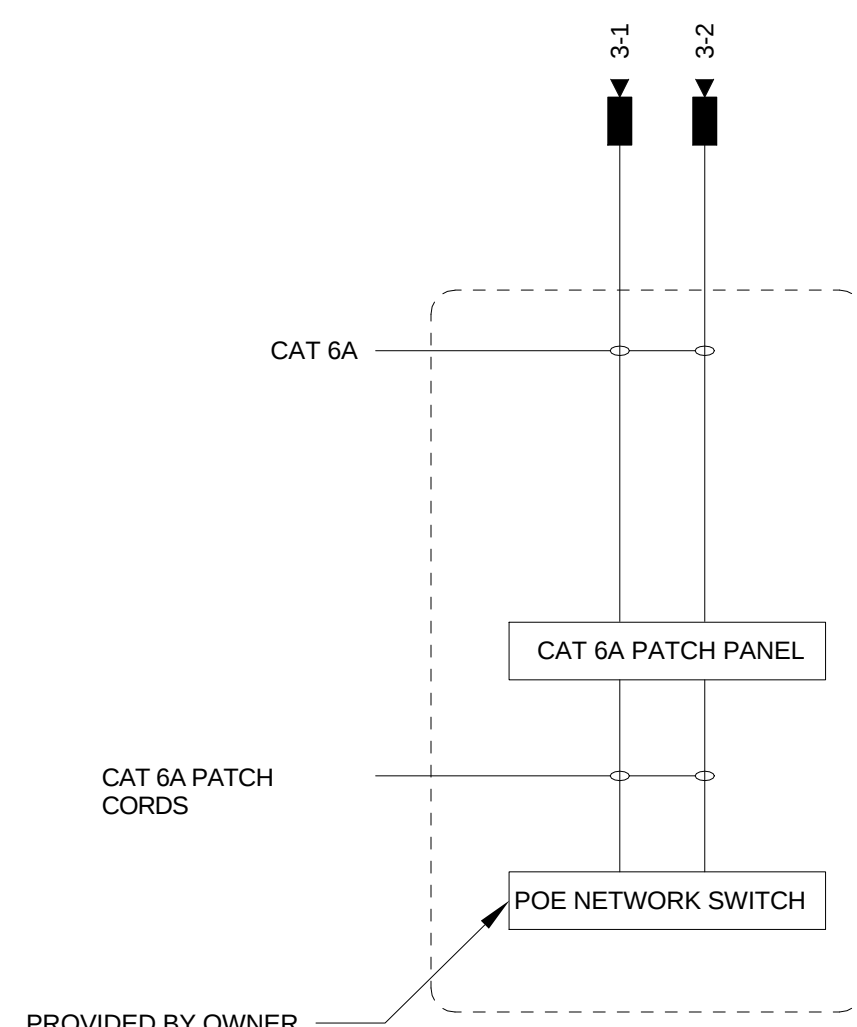


DATA 300B ROOM

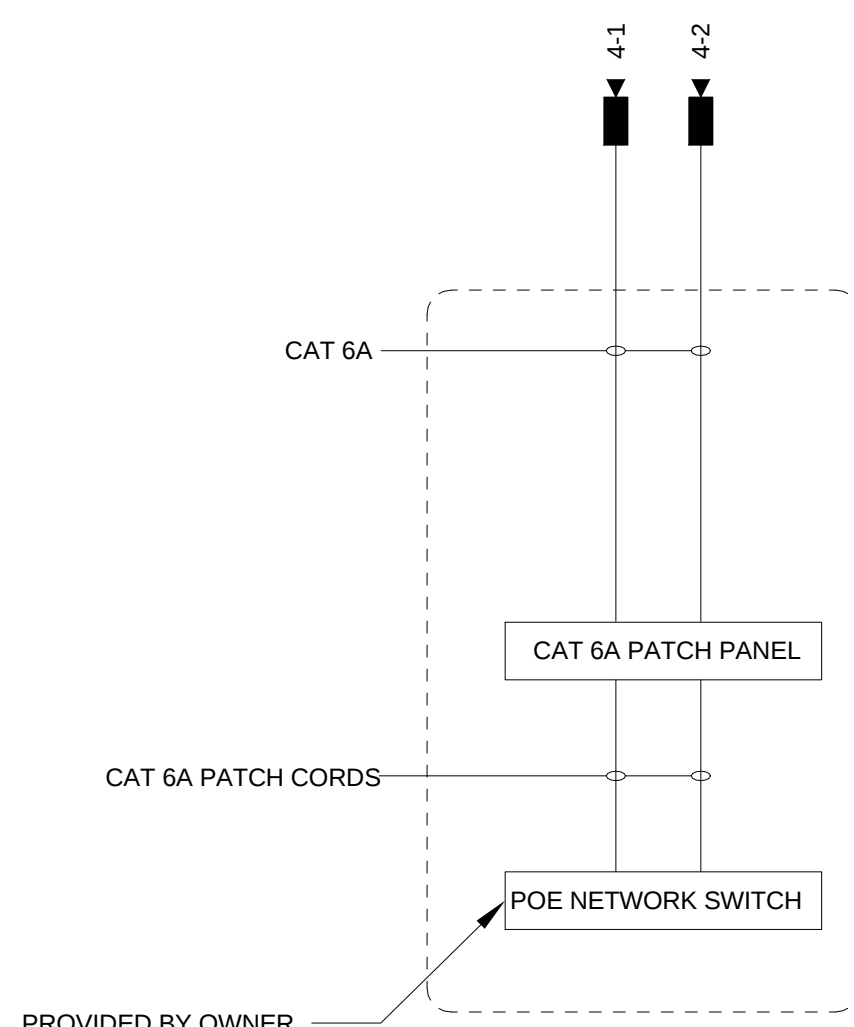


DATA 400B ROOM

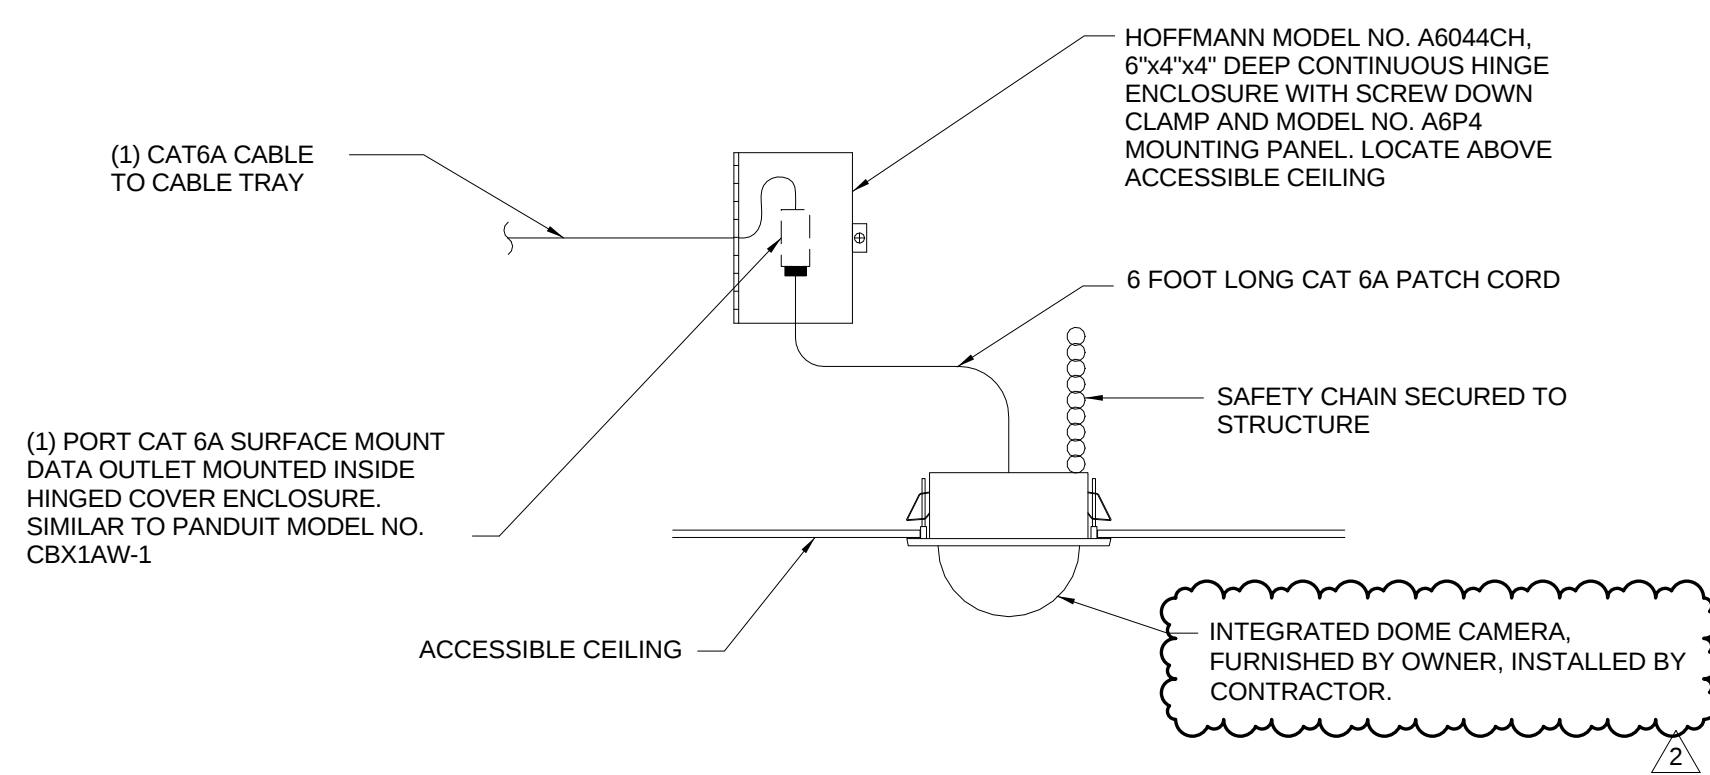


A RECESSED CAMERA - ACCESSIBLE CEILING
NOT TO SCALE
ROUGH IN ONLY WITH CONDUIT AND CABLING. CAMERA INSTALLATION BY OTHERS

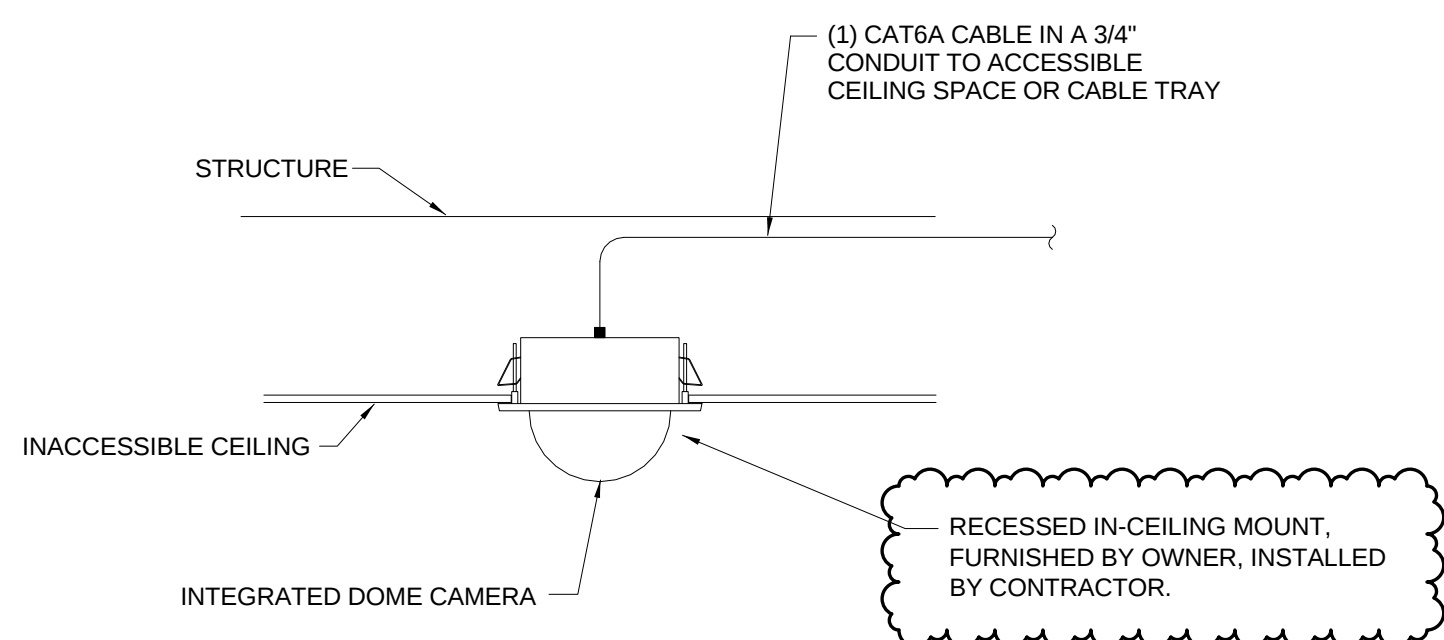

B RECESSED CAMERA - INACCESSIBLE CEILING
NOT TO SCALE
ROUGH IN ONLY WITH CONDUIT AND CABLING. CAMERA INSTALLATION BY OTHERS

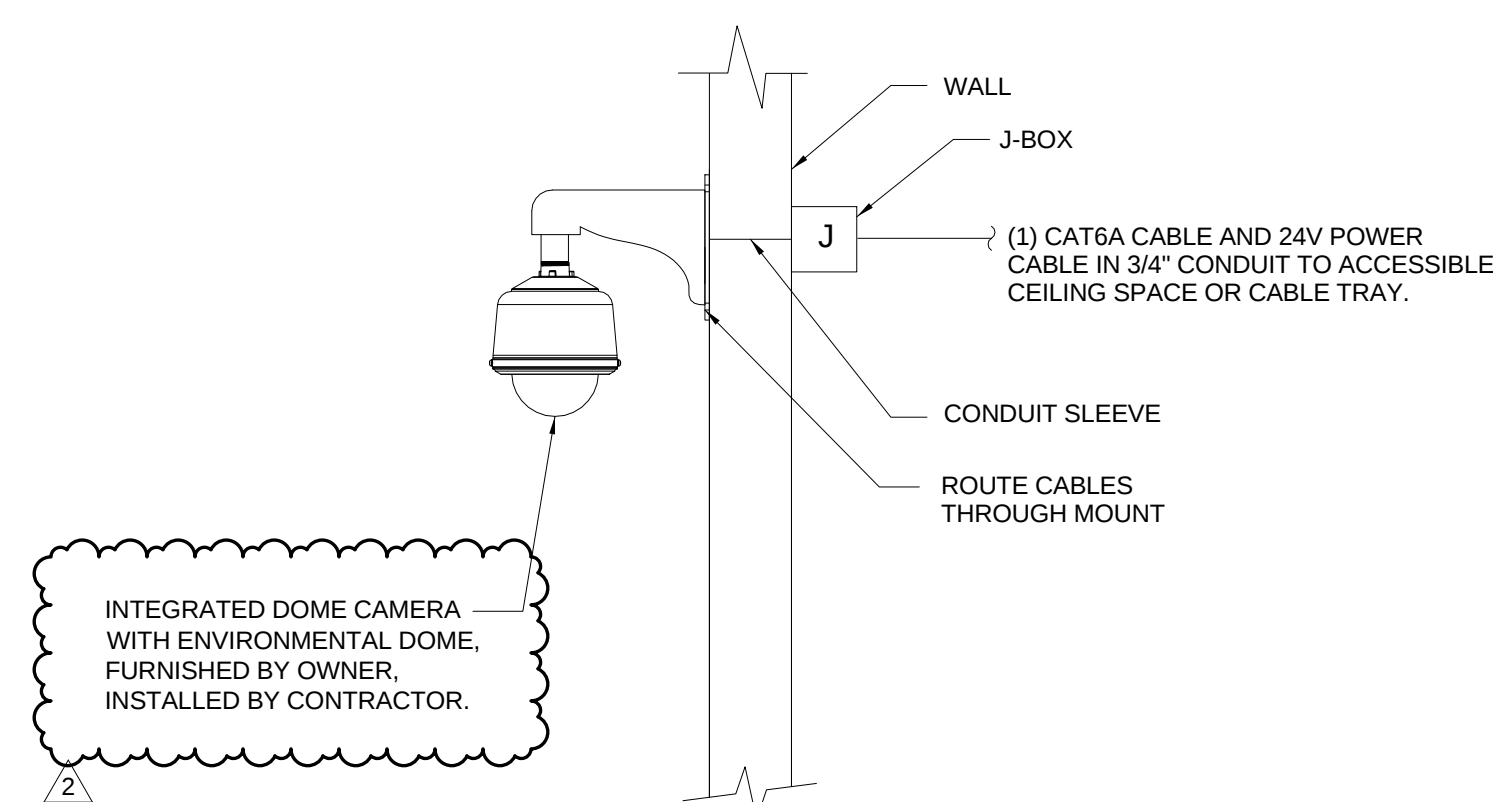

C OUTDOOR WALL MOUNT CAMERA DETAIL
NOT TO SCALE
ROUGH IN ONLY WITH CONDUIT AND CABLING. CAMERA INSTALLATION BY OTHERS

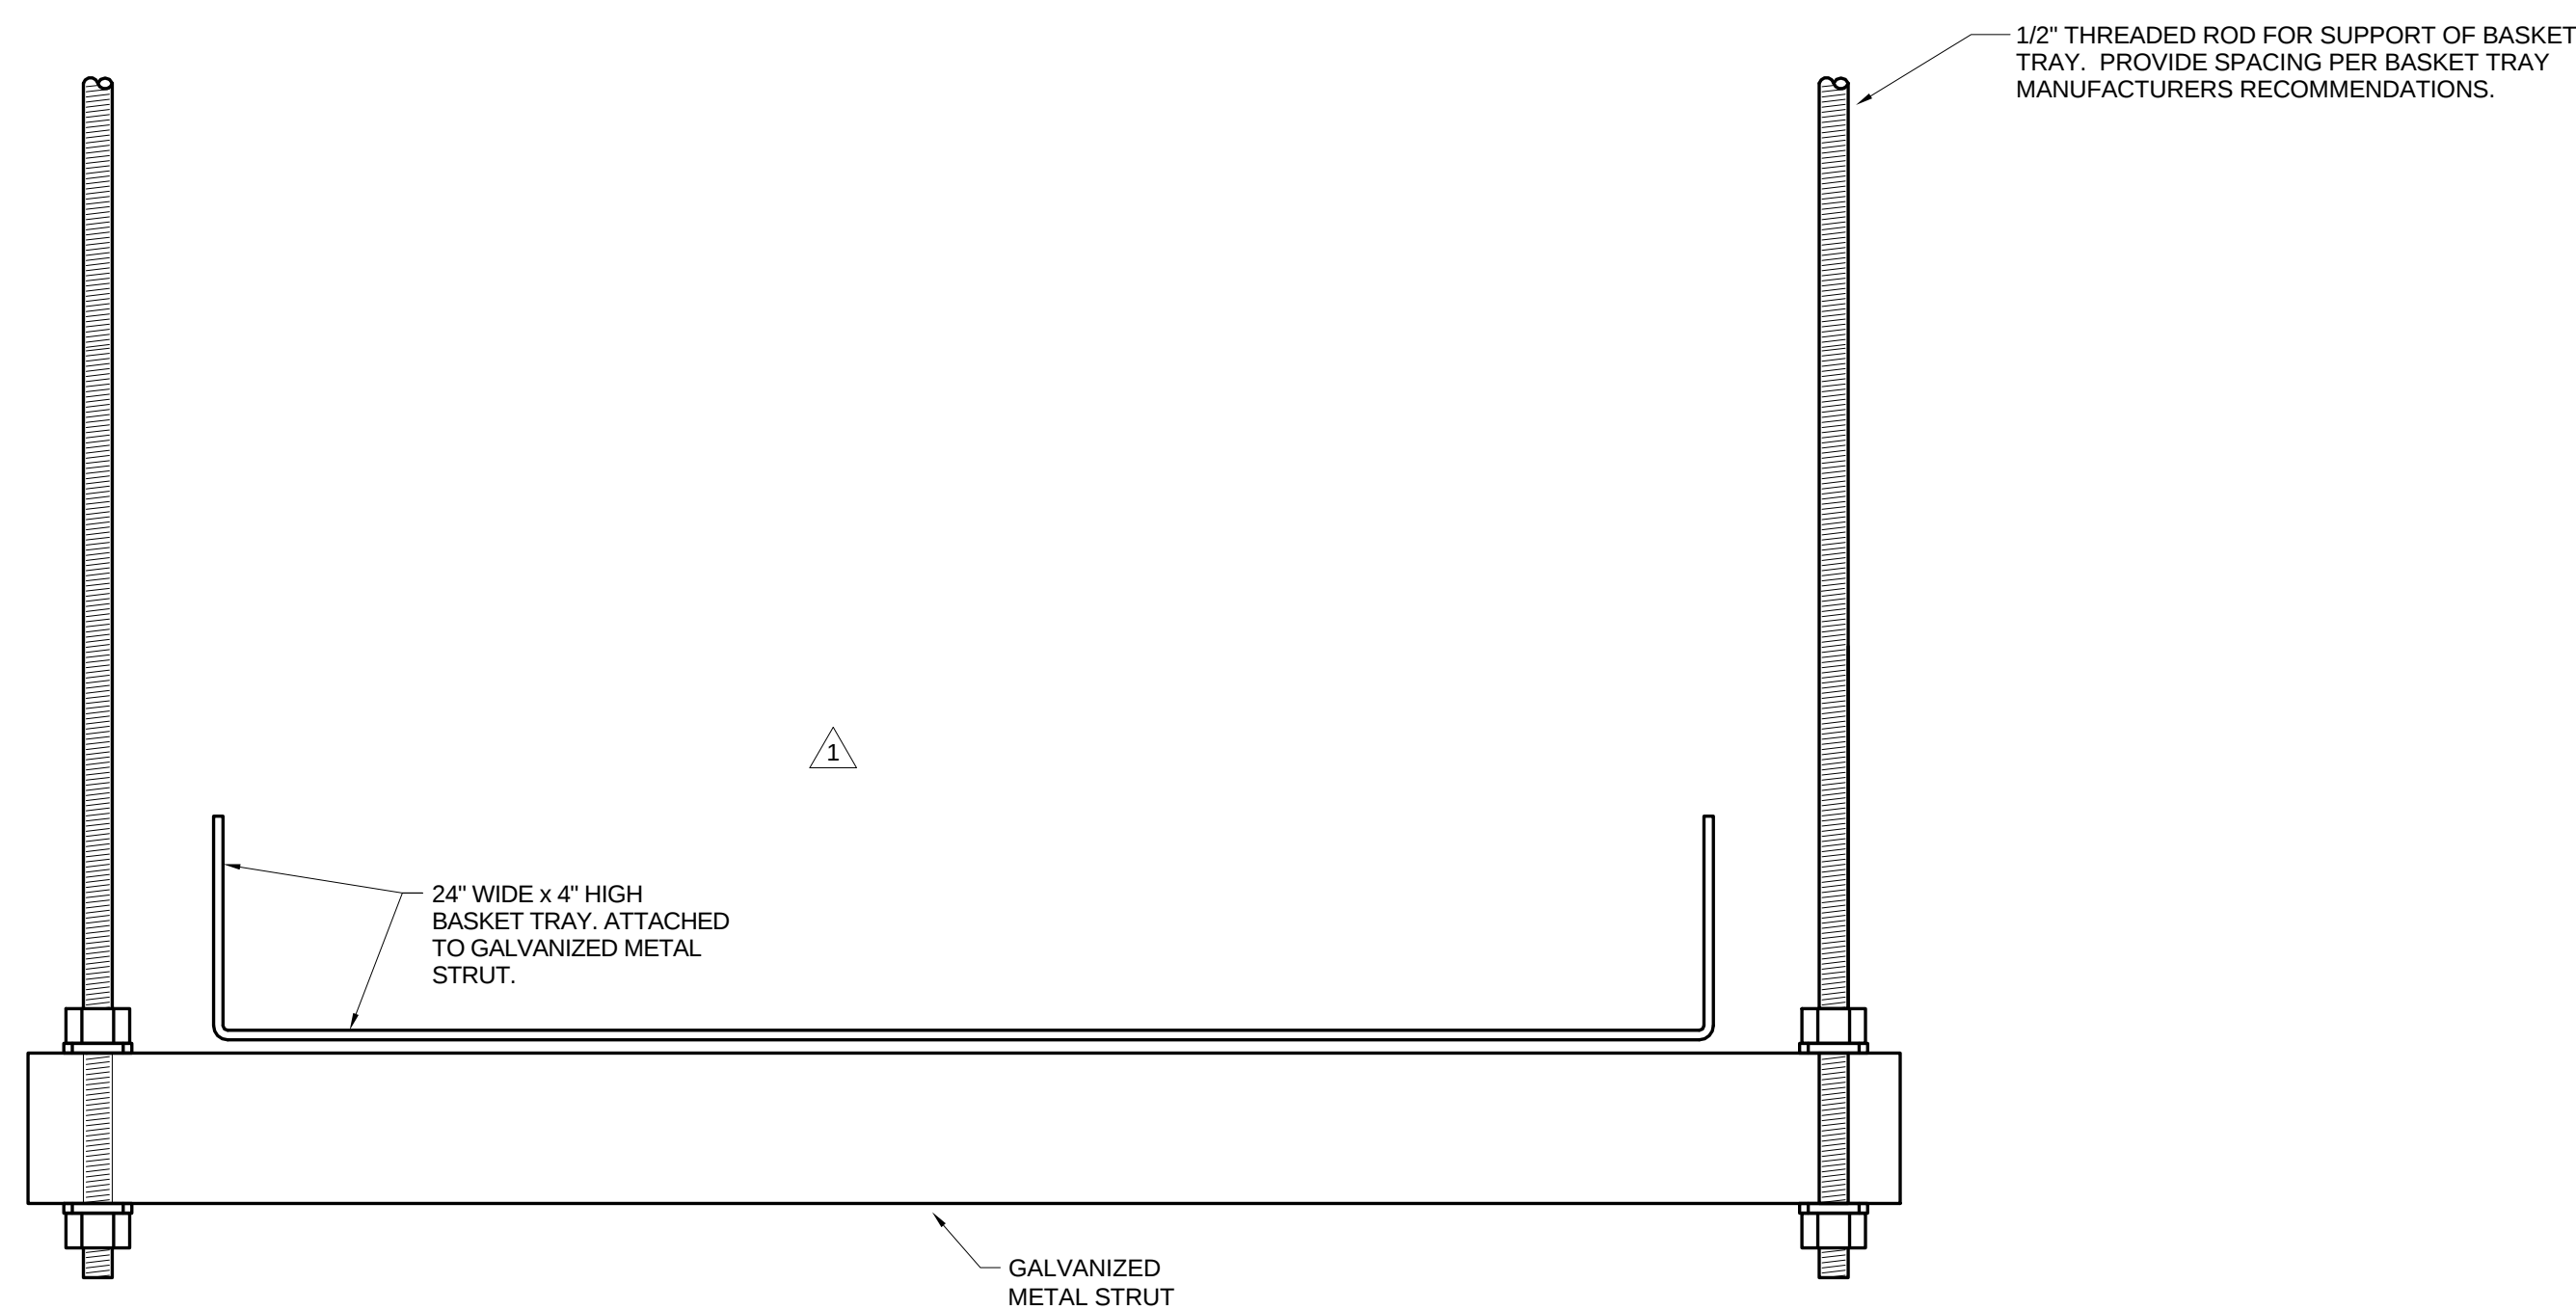

BASKET TRAY INSTALLATION DETAIL
SCALE: NONE