



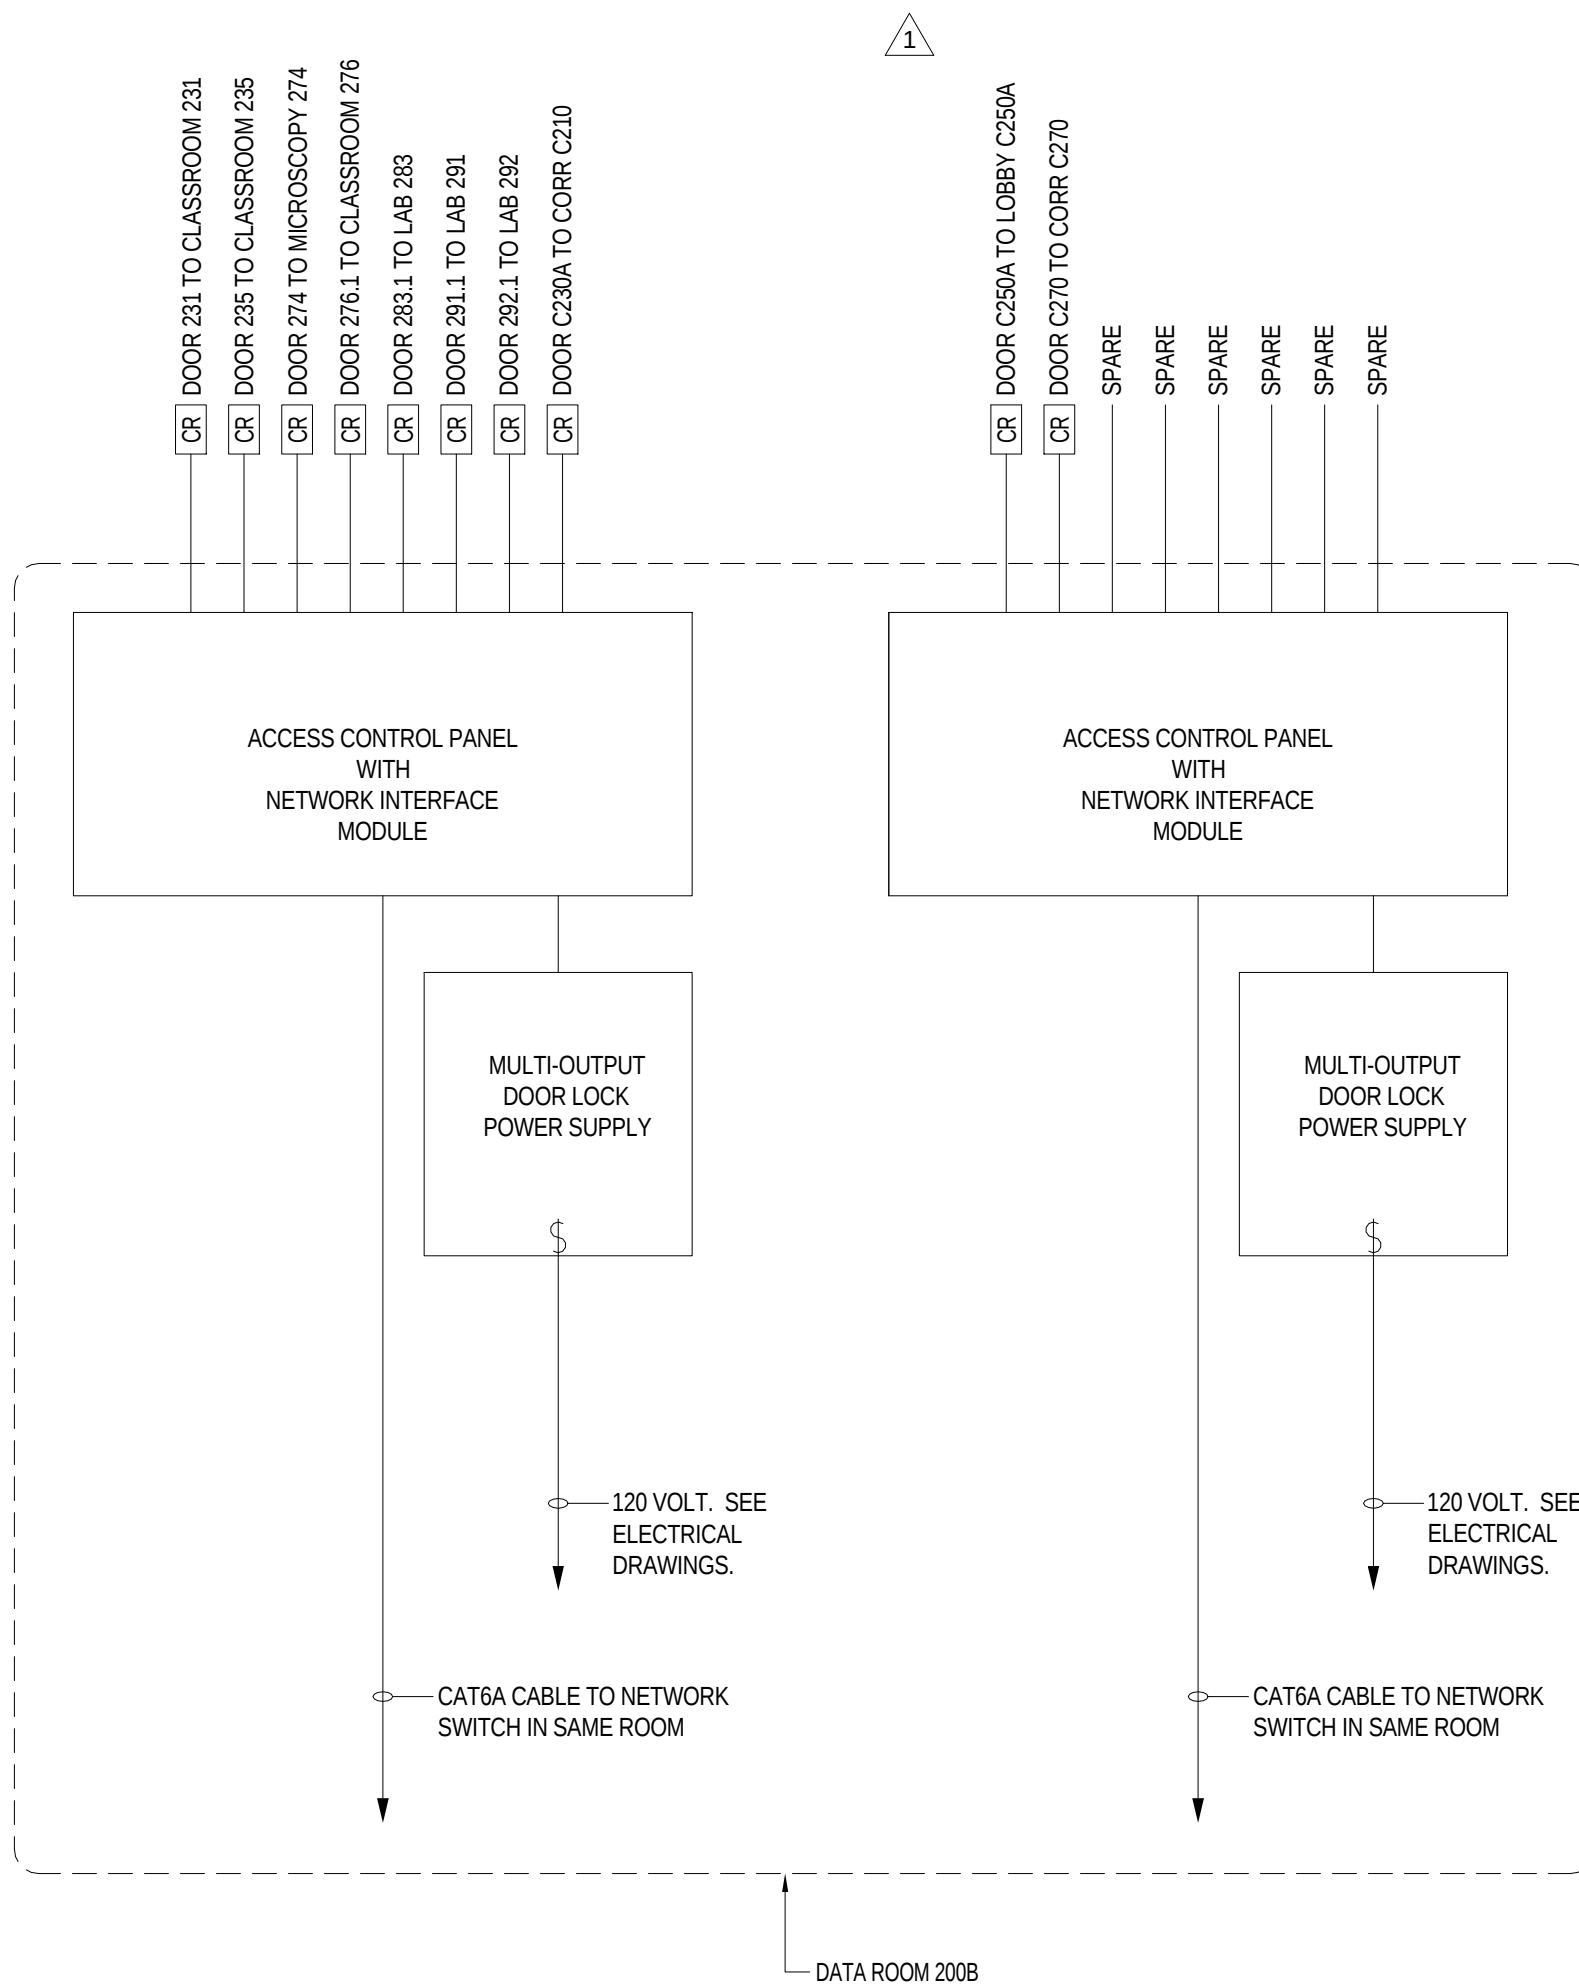

GENERAL NOTES:

1. DOOR INTERFACE BOX (DIB) NOT SHOWN FOR CLARITY. SEE TYPICAL SECURED DOOR WIRING DIAGRAM ON SHEET T0.804.

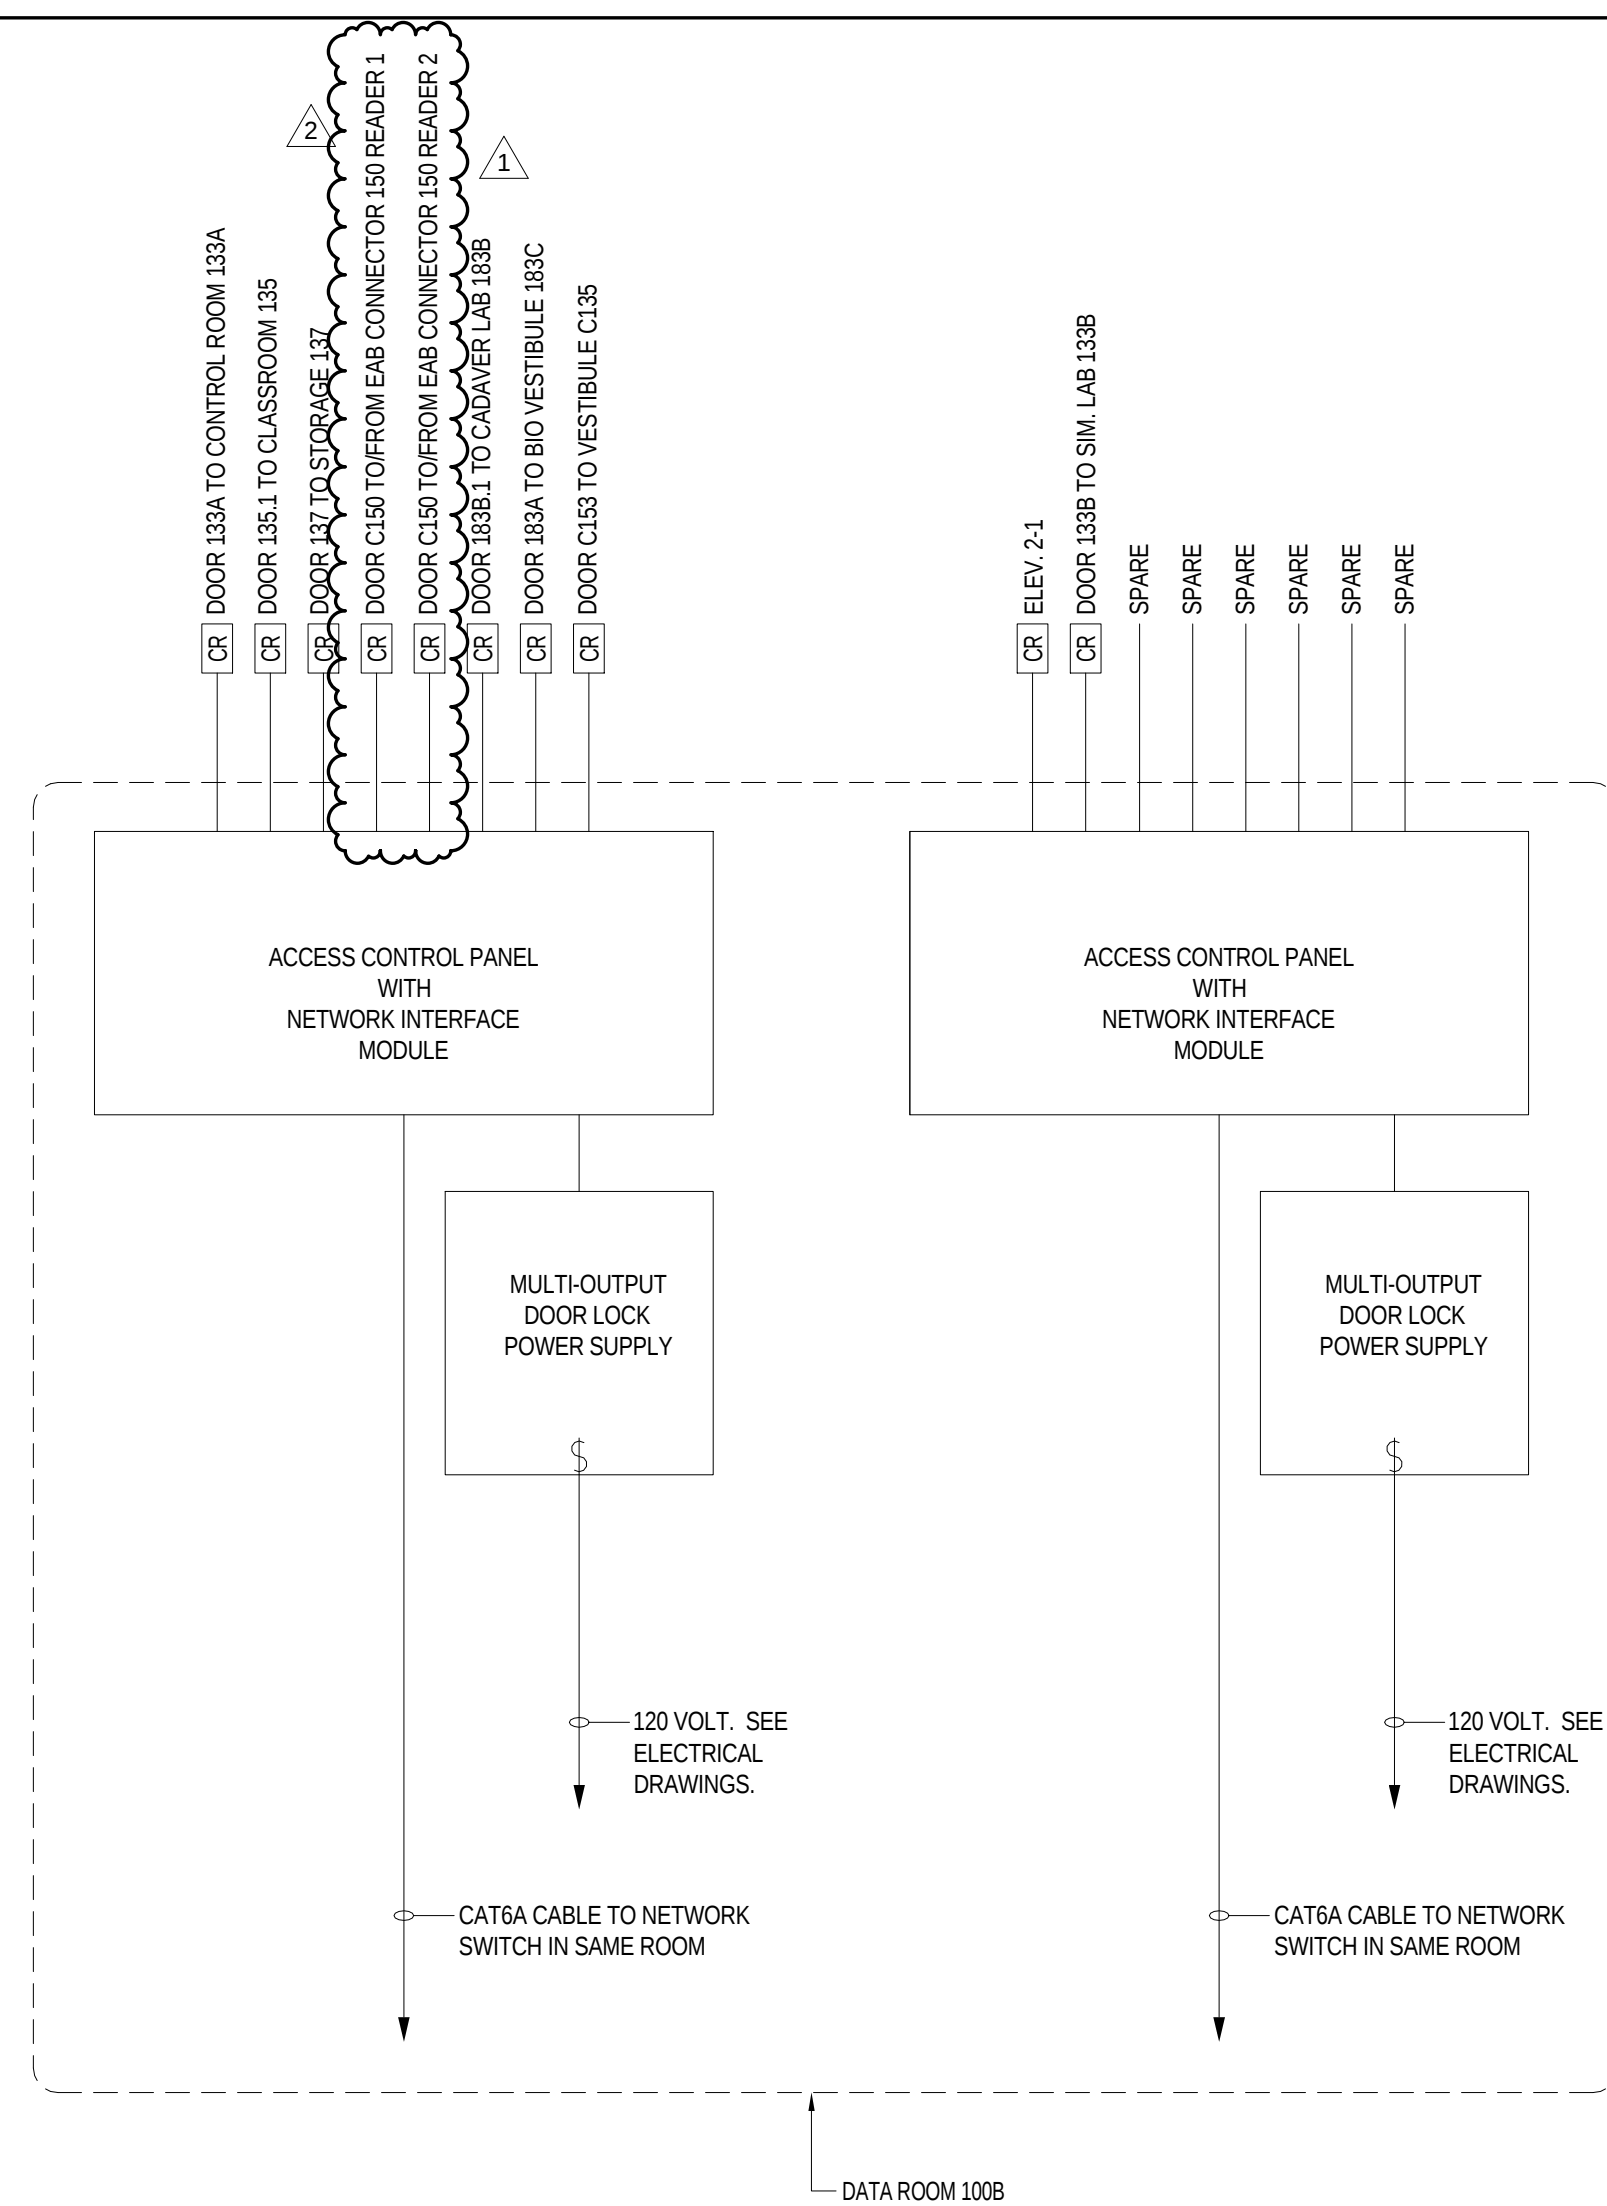