

sent 10/3



September 29, 2016

Craig A. Miller Sr
Webster University
470 East Lockwood Ave
St. Louis, MO 63119-3194

Via Email

Re: Paric Corporation Project No. 15051
15051-Webster University Interdisciplinary Science Building
CP-033 - ASI#26 Curtainwall Dimension Discrepancy

Dear Craig A. Miller Sr:

Paric Corporation proposes to complete the following additional work for the unchanged sum of ZERO Dollars And Zero Cents \$.00 .

This change will impact the scheduled completion date by 0 days.

- PCI-E-0037 (ASI#26 Curtainwall Dimension Discrepancy), Total \$.00

The owner contingency shall be utilized for this change proposal
Proposed Change Proposal Total: \$.00

If this change proposal meets with your approval, please sign and return this proposal for our records by October 07, 2016 at the latest. If accepted this scope will be incorporated into a change order.

Sincerely,

Paric Corporation

Jason Szachnieski
Project Manager

Accepted:

Date: 10/13/2016
Craig A. Miller Sr
Webster University

Declined:

Date: _____
Craig A. Miller Sr
Webster University

Paric Corporation

PROJECT MANAGEMENT - CHANGE ITEM DETAIL REPORT

15051 - 15051-Webster University Interdisciplinary Science Building

Page: 1 of 1

Date: 03-OCT-16

Time: 08:38 AM

Status: EXT EXT

CI Type	CI Number	Description	Estimated Amount	Quoted Amount	Final Amount	Due to Owner	Notes	Date Sent	Date Received	Date Closed	Budgeted Amount	Billing Amount	Owner CO
EXT	PCI-E-0037	ASI#26 Curtainwall Dimension Discrepancy				0.0003-OCT-16					0.00	0.00	

Vendor Name

Description

NGG Ltd., Incorporated	15051	08400.000 S Window / Glass Sub	0.00	ASI#26 Curtainwall Dimension Discrepancy	No Cost Change
Total For EXT		0.00	0.00	0.00	

Grand Total:

0.00 0.00 0.00

0.00 0.00

END OF REPORT

Report Parameters

Job: 15051 Project Code:
 From Change Order: Run Date: 03-OCT-16
 To Change Order: Run Time: 08:38 AM
 Status Code: Operator: JAS39SZA
 Report Type: DETAIL Posting Status: Unposted CI
 Print Notes: Y Report Code: PM5000
 Group By: STATUS

Architect's Supplemental Instructions

Architect's Project No:
04561.01

Architect's ASI No: 026

Project:
Webster University
Interdisciplinary Science
Building

Date Issued: 08/30/2016

Contract Date:

Reason Code: 03 Document Inconsistency

Discipline Code: 07 General Construction
(Architectural)

St. Louis
Baltimore
Boston
Buffalo
Calgary
Chicago
Houston
Los Angeles
Mumbai
New York
Phoenix
San Francisco
Shanghai
Toronto
Vancouver
Victoria
Washington DC

Owner:
Webster University

Architect:
Cannon Design
1100 Clark Avenue
St. Louis, MO 63102

Contractor:
Paric Construction

Contract For: General construction

The Work shall be carried out in accordance with the following supplemental instructions issued in accordance with the Contract Documents without change in Contract Sum or Contract Time. Indicate your acceptance of these instructions for minor change to the Work as consistent with the Contract Documents and return a copy to the Architect within fourteen (14) business days of the date of issuance of these instructions. If you feel a change in Contract Sum or Contract Time is warranted, please submit an itemized quotation for the changes for approval within fourteen (14) business days of the date of issuance of these instructions prior to proceeding on the Work. Proceeding with the Work in accordance with these instructions indicates your acknowledgement that there will be no change.

Attachments:

A0311, A0312, A0402

1100 Clark Avenue
St. Louis, Missouri
63102
T: 314.241.6250
F: 314.241.2570
www.cannondesign.com

Reason Codes:
#1. Jurisdictional Agency
#2. Constructor Driven
#3. Document Inconsistency
#4. Fast Track Driven
#5. A/E Scope
#6. Owners Scope
#7. Unforeseeable Conditions
#8. Other

Discipline Codes
#1. Demo-demolition
#2. Div1-Division 1 items on the spec book
(this item is not used)
#3. Electrical
#4. Elevator
#5. Equipment (Changes in equipment,
Owner Purchased)
#6. Fire Protection

Discipline Codes
#7. General Construction (Architectural)
#8. General Conditions (Div. 1)
#9. HVAC
#10. Other
#11. Plumbing
#12. Site Work/Landscaping
#13. Structural

Architect's Supplemental Instructions

Page 2

Description:

Revised dimension discrepancy for bottom of CFMF at top of curtain wall.

Please submit an itemized proposal for changes in contract Sum and Contract Time for proposed modifications to the Contract Documents described herein:

Issued by Architect:

Kathy Williams (KWA)

Accepted by Contractor:



CANNONDESIGN

1100 Clark Avenue
St. Louis, Missouri 63102
T 314 241 6250
F 314 241 2530

William Tee & Associates, Inc.
MEP/FP Engineer
7950 Manchester Road Suite 125
St. Louis MO 63143
314-886-7500

David Nelson & Associates, Inc.
Structural & Civil Engineers
600 South Vandewater Avenue
St. Louis, MO 63102

Faith Group
Technology
3101 S Hanley Rd Suite 100
St. Louis, MO 63113

Kuhlmann Leavitt, Inc.
Environmental Graphics & Signage

1400 Pershing Ave
St Louis, MO 63120
314 725-8816

PHWA Architects

Architecture
9721 Luning Road
St. Louis, MO 63124
314 967 2660

Spelman Brady & Company
Interior Designer
8251 Maryland Avenue, Suite 200
St. Louis, MO 63116


BWT Design
Landscape Architects
7222 Rio Bend Blvd.

St. Louis MO 63116
314 844 5700

Weld Engineering Services, Inc.
Chicago, IL, USA



3	ASI-226	20 AUG 2018
2	ADDENDUM 1.1	12 MAY 2018
1	ADDENDUM 1.2	13 MAR 2018
	ISSUED FOR CONSTRUCTION (RPT)	16 JAN 2018
No	Description	Date

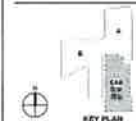


EXTERIOR ELEVATIONS

Project No	04561 01	Checked by
------------	----------	------------

A0311

6788 • J. Neurosci., June 23, 2010 • 30(25):6781–6790

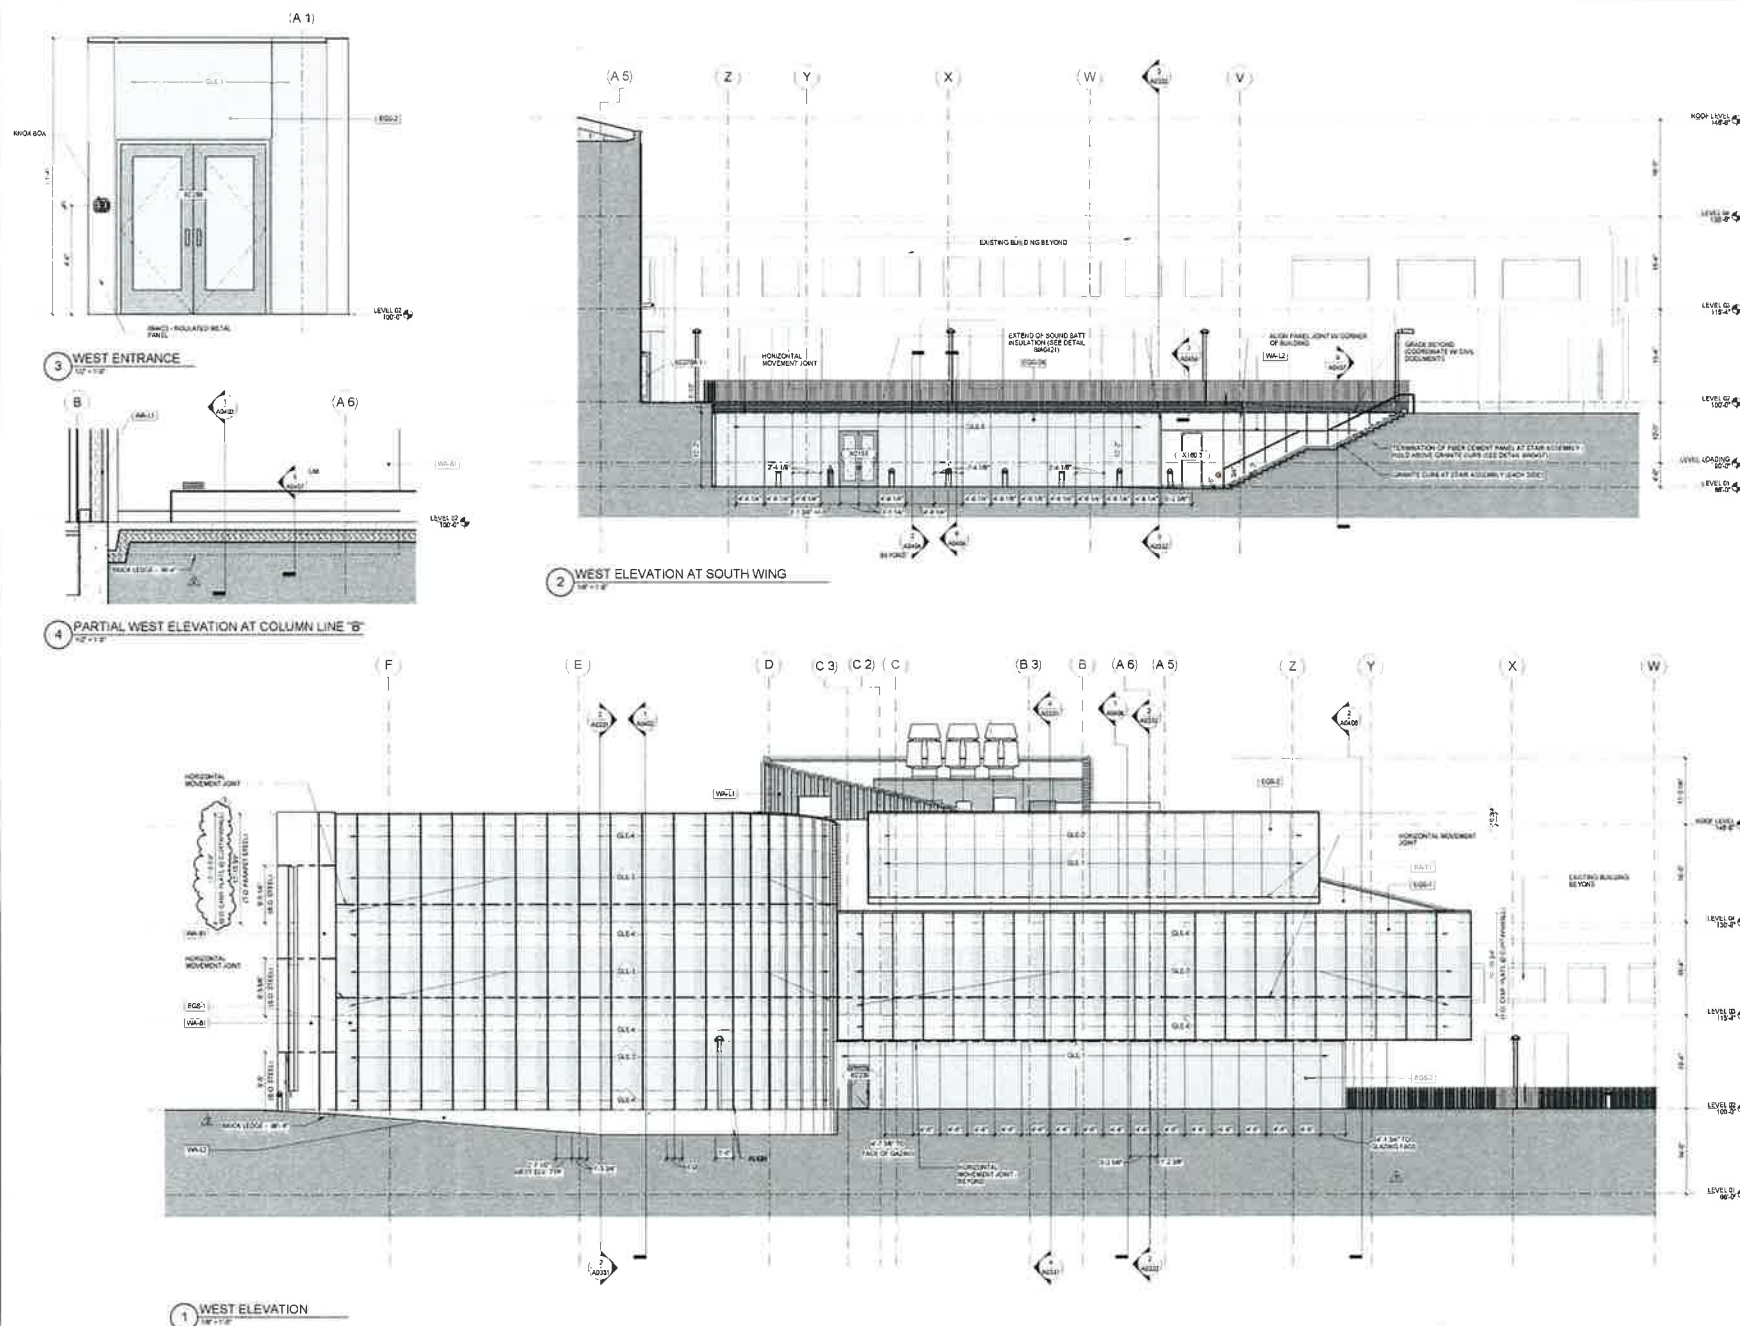

© Garmin Design 2015.
All rights reserved. No part of this document may be reproduced or transmitted in any form without prior written permission from Garmin Corporation.



David J. Cannon
8/10/16


1. A0312N	28 AUG 2016
2. A0312Z	23 AUG 2016
3. A0312M 1-1	13 MAY 2016
4. A0312M 1-2	16 MAY 2016
5. A0312M 1-3	26 JUN 2016
6. ISSUED FOR CONSTRUCTION (CUTS)	13 JUN 2016
7. Revision	Date



EXTERIOR ELEVATIONS

Project No: A0312-01 Checked by:

A0312

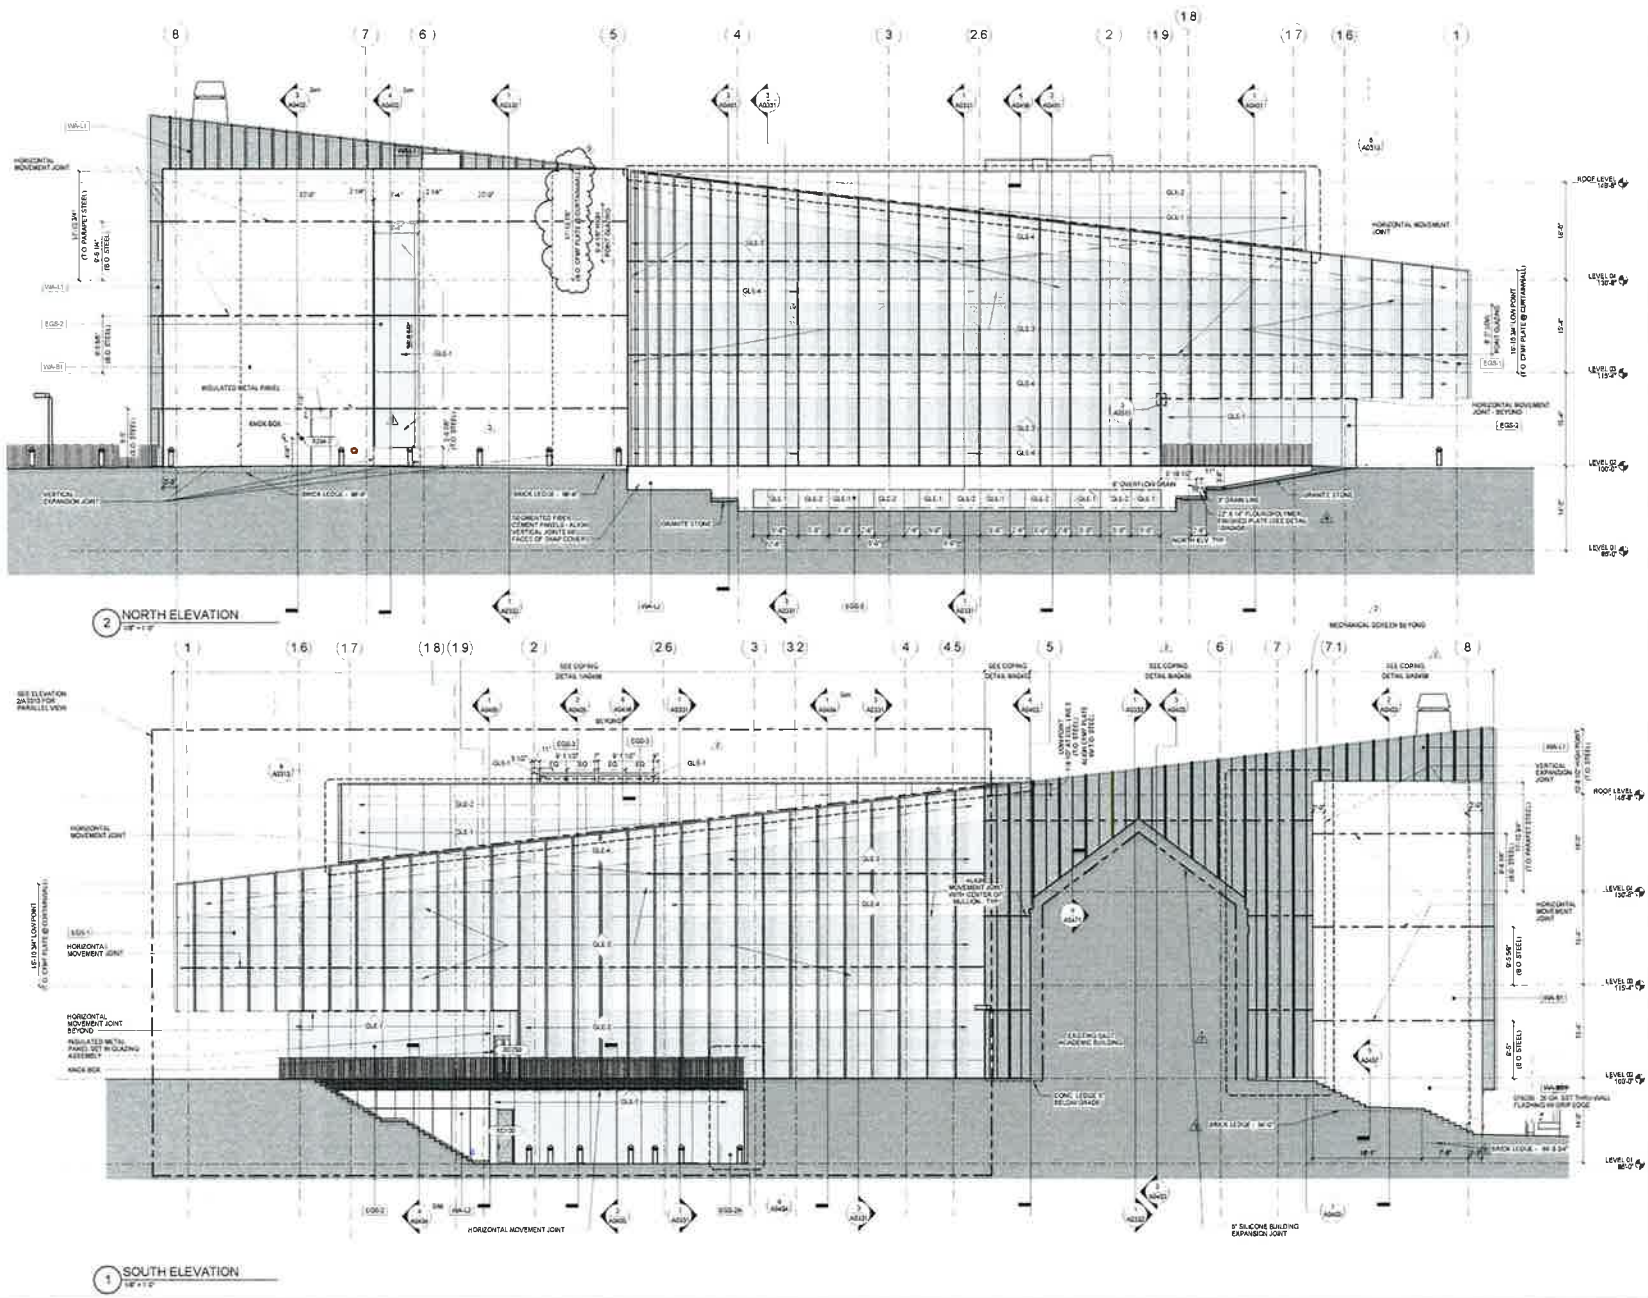



Karyn J. Williams
P.E.


2. Add SW	28 AUG 2014	
3. ADD SW (H) I	28 JAN 2018	
ISSUED FOR CONSTRUCTION (SHP)	13 JAN 2018	
No.	Description	Date

Drawing Title


WALL SECTIONS

Project No. 095101 Drawn by


A0402

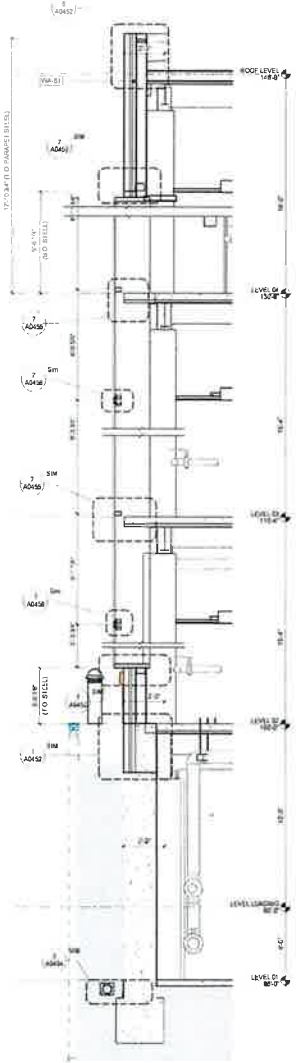


4 NORTH WALL SECTION E - WA-B1
28' x 11'

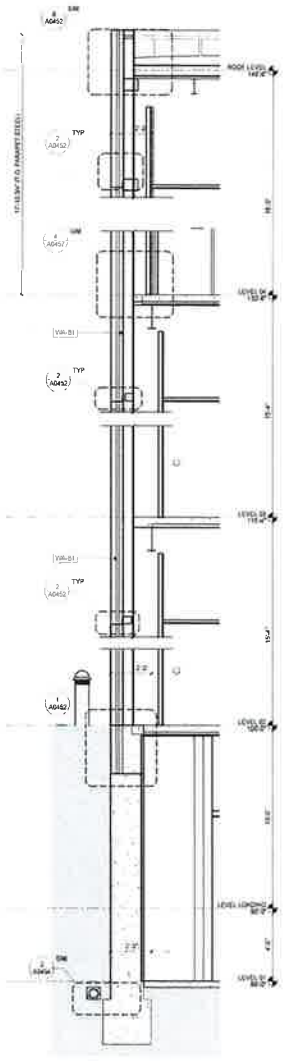

3 NORTH WALL SECTION D - WA-B1
28' x 11'

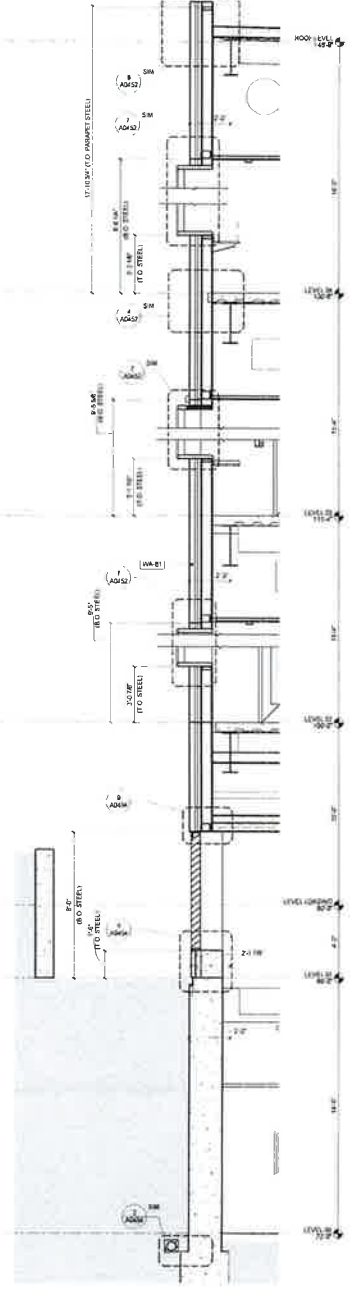

2 EAST WALL SECTION - WA-B1
28' x 11'

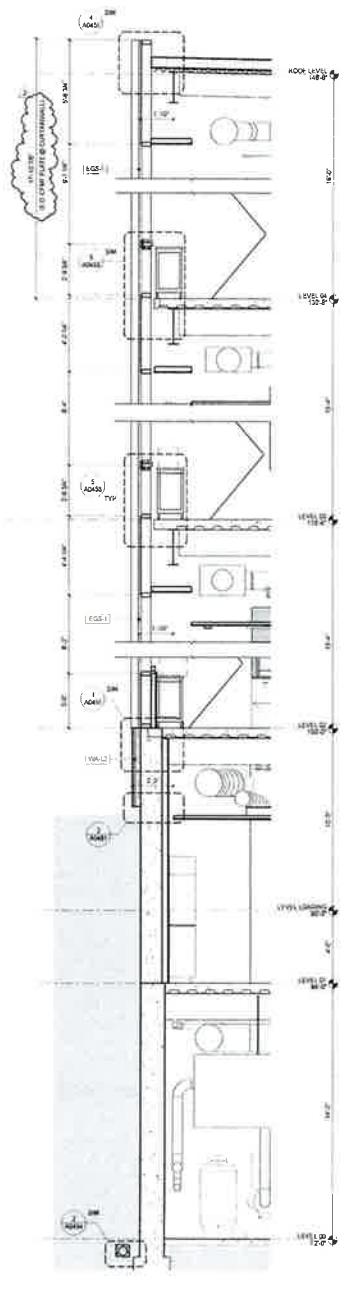

1 WEST WALL SECTION - SSG CURTAINWALL & WA-L2
28' x 11'