




Kathy R. Williams
4.21.16

CONFORMED SET 01 JUL 2016

1 ADDENDUM 1-9		21 APR 2016
ISSUED FOR CONSTRUCTION (BP1)		15 JAN 2016
No.	Description	Date

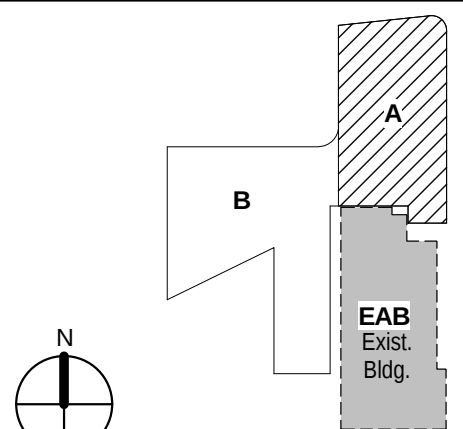


KEY PLAN

Drawing Title:

EXTERIOR - LEVEL 01
AREA A FLOOR PLAN

Project No.: 04561.01 Checked by:

A0101.EA

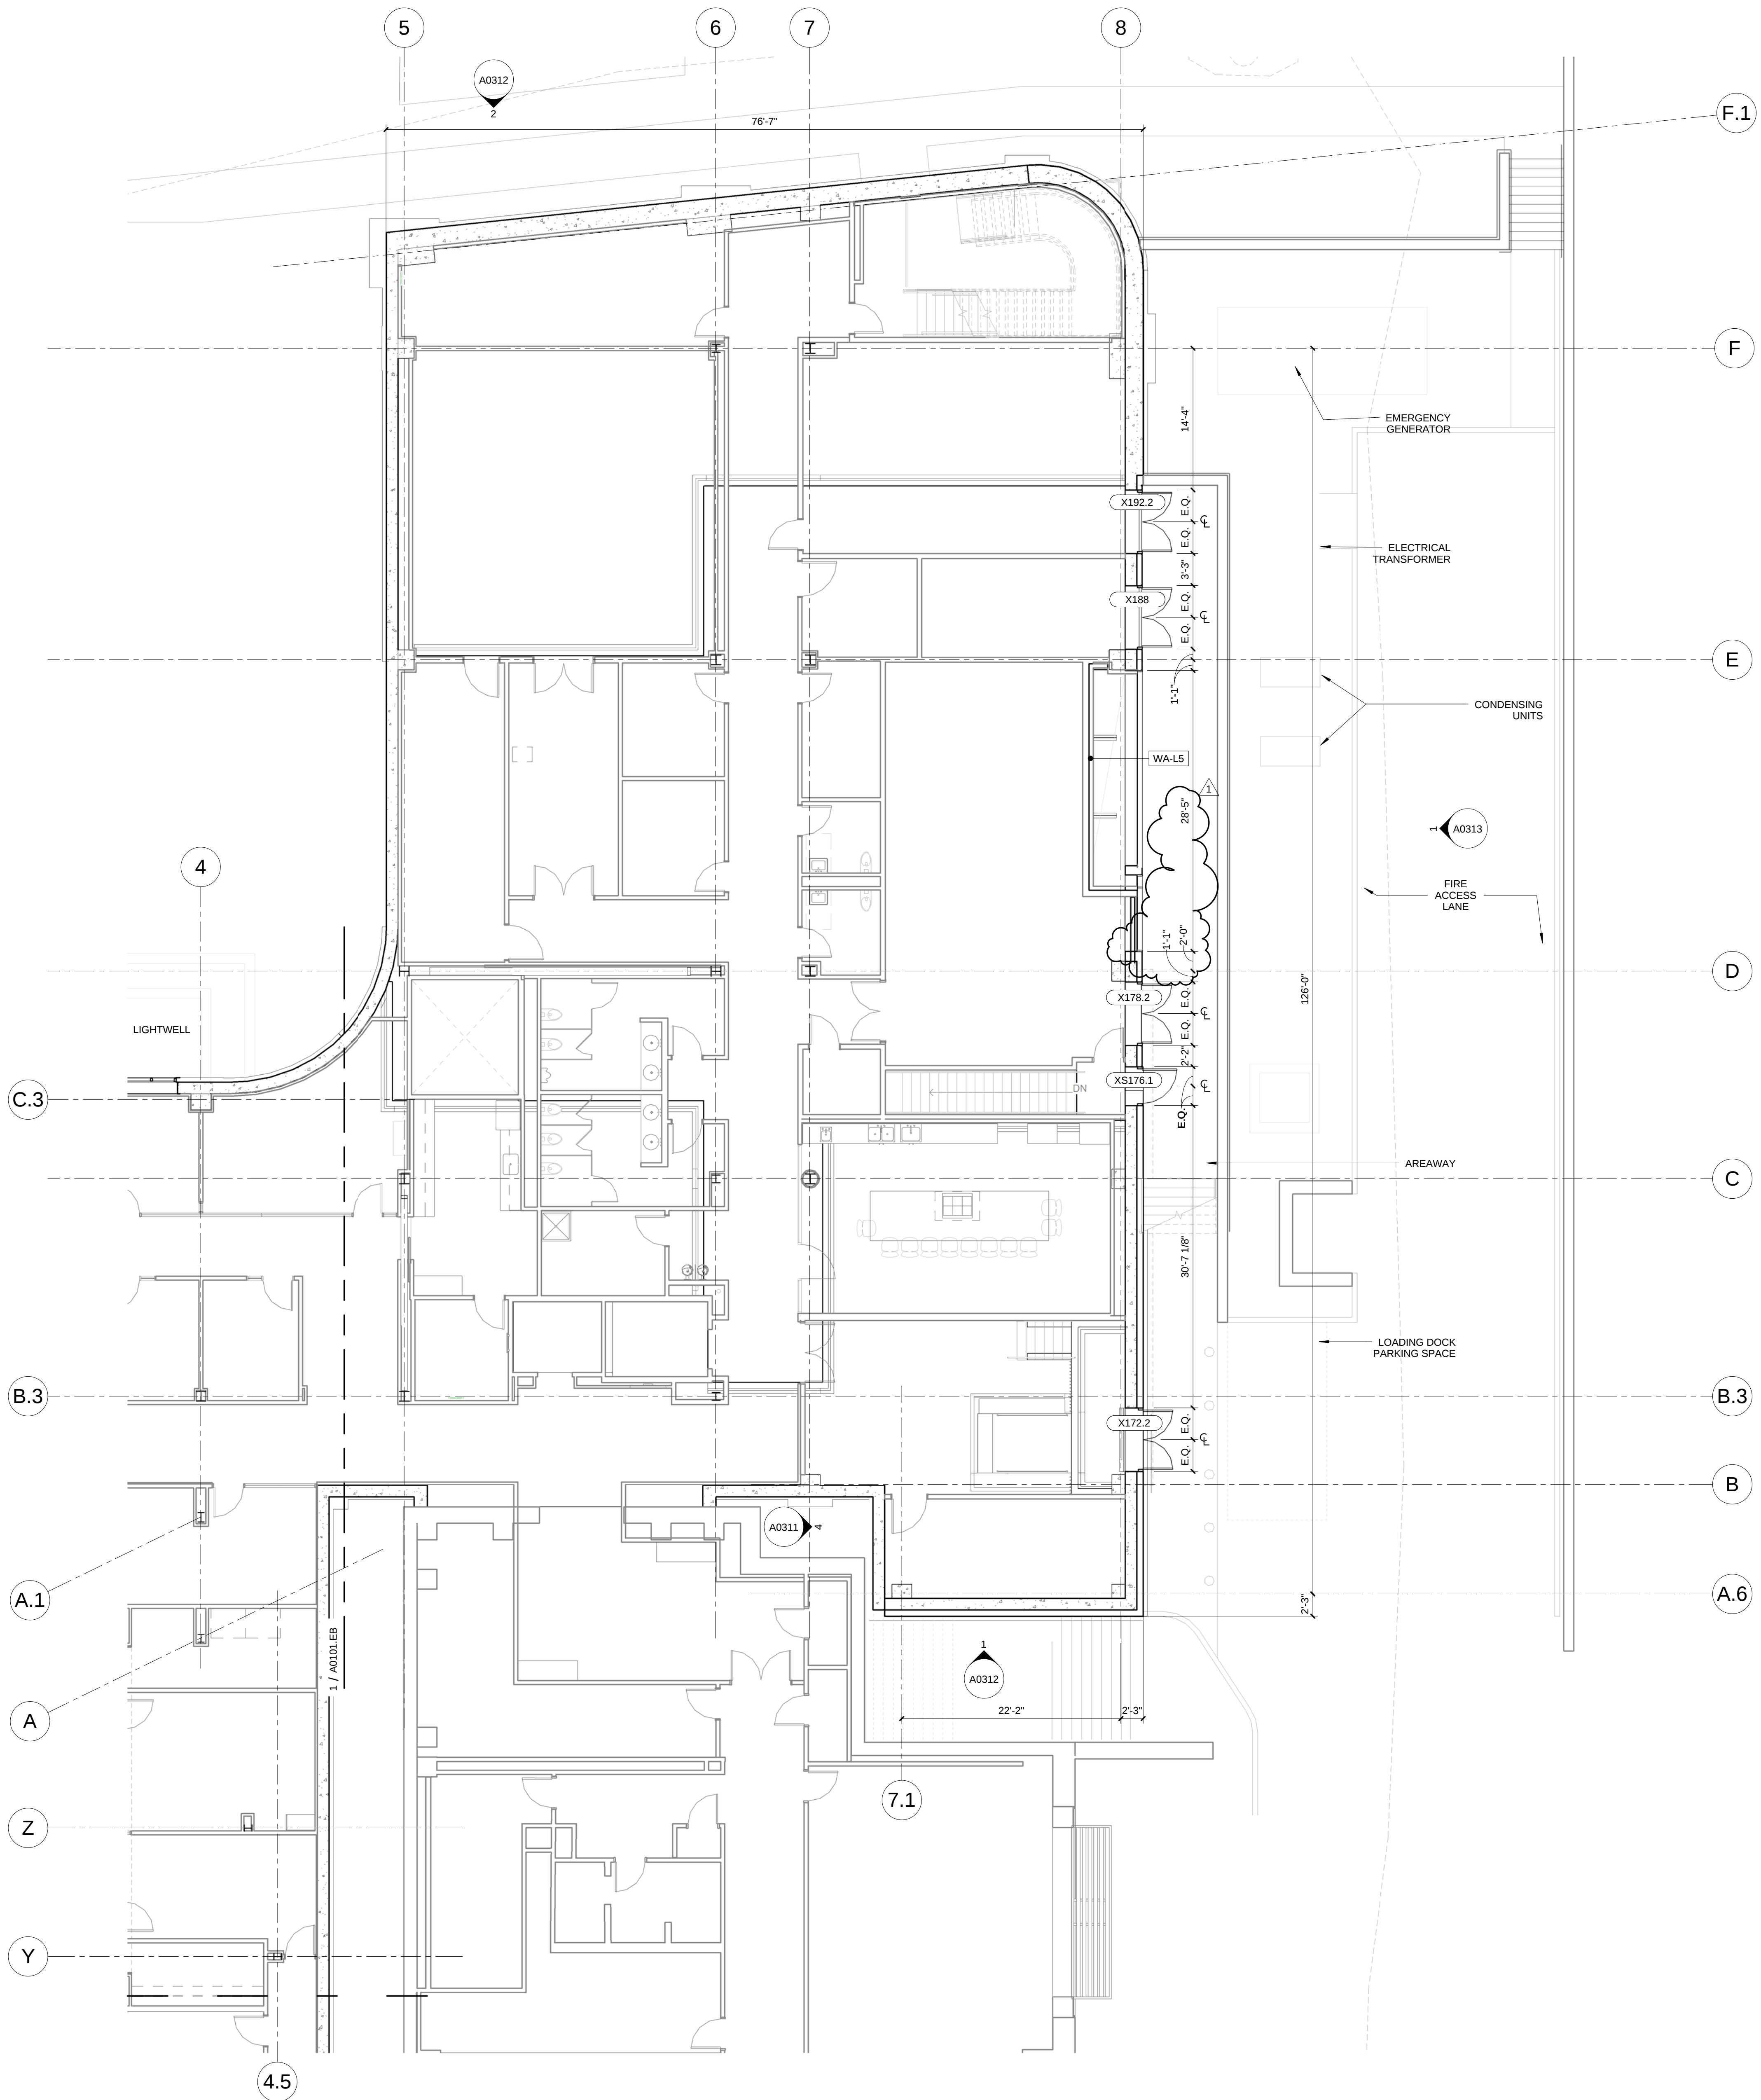

1 EXTERIOR - LEVEL 01 AREA A FLOOR PLAN
1/8" = 1'-0"

