



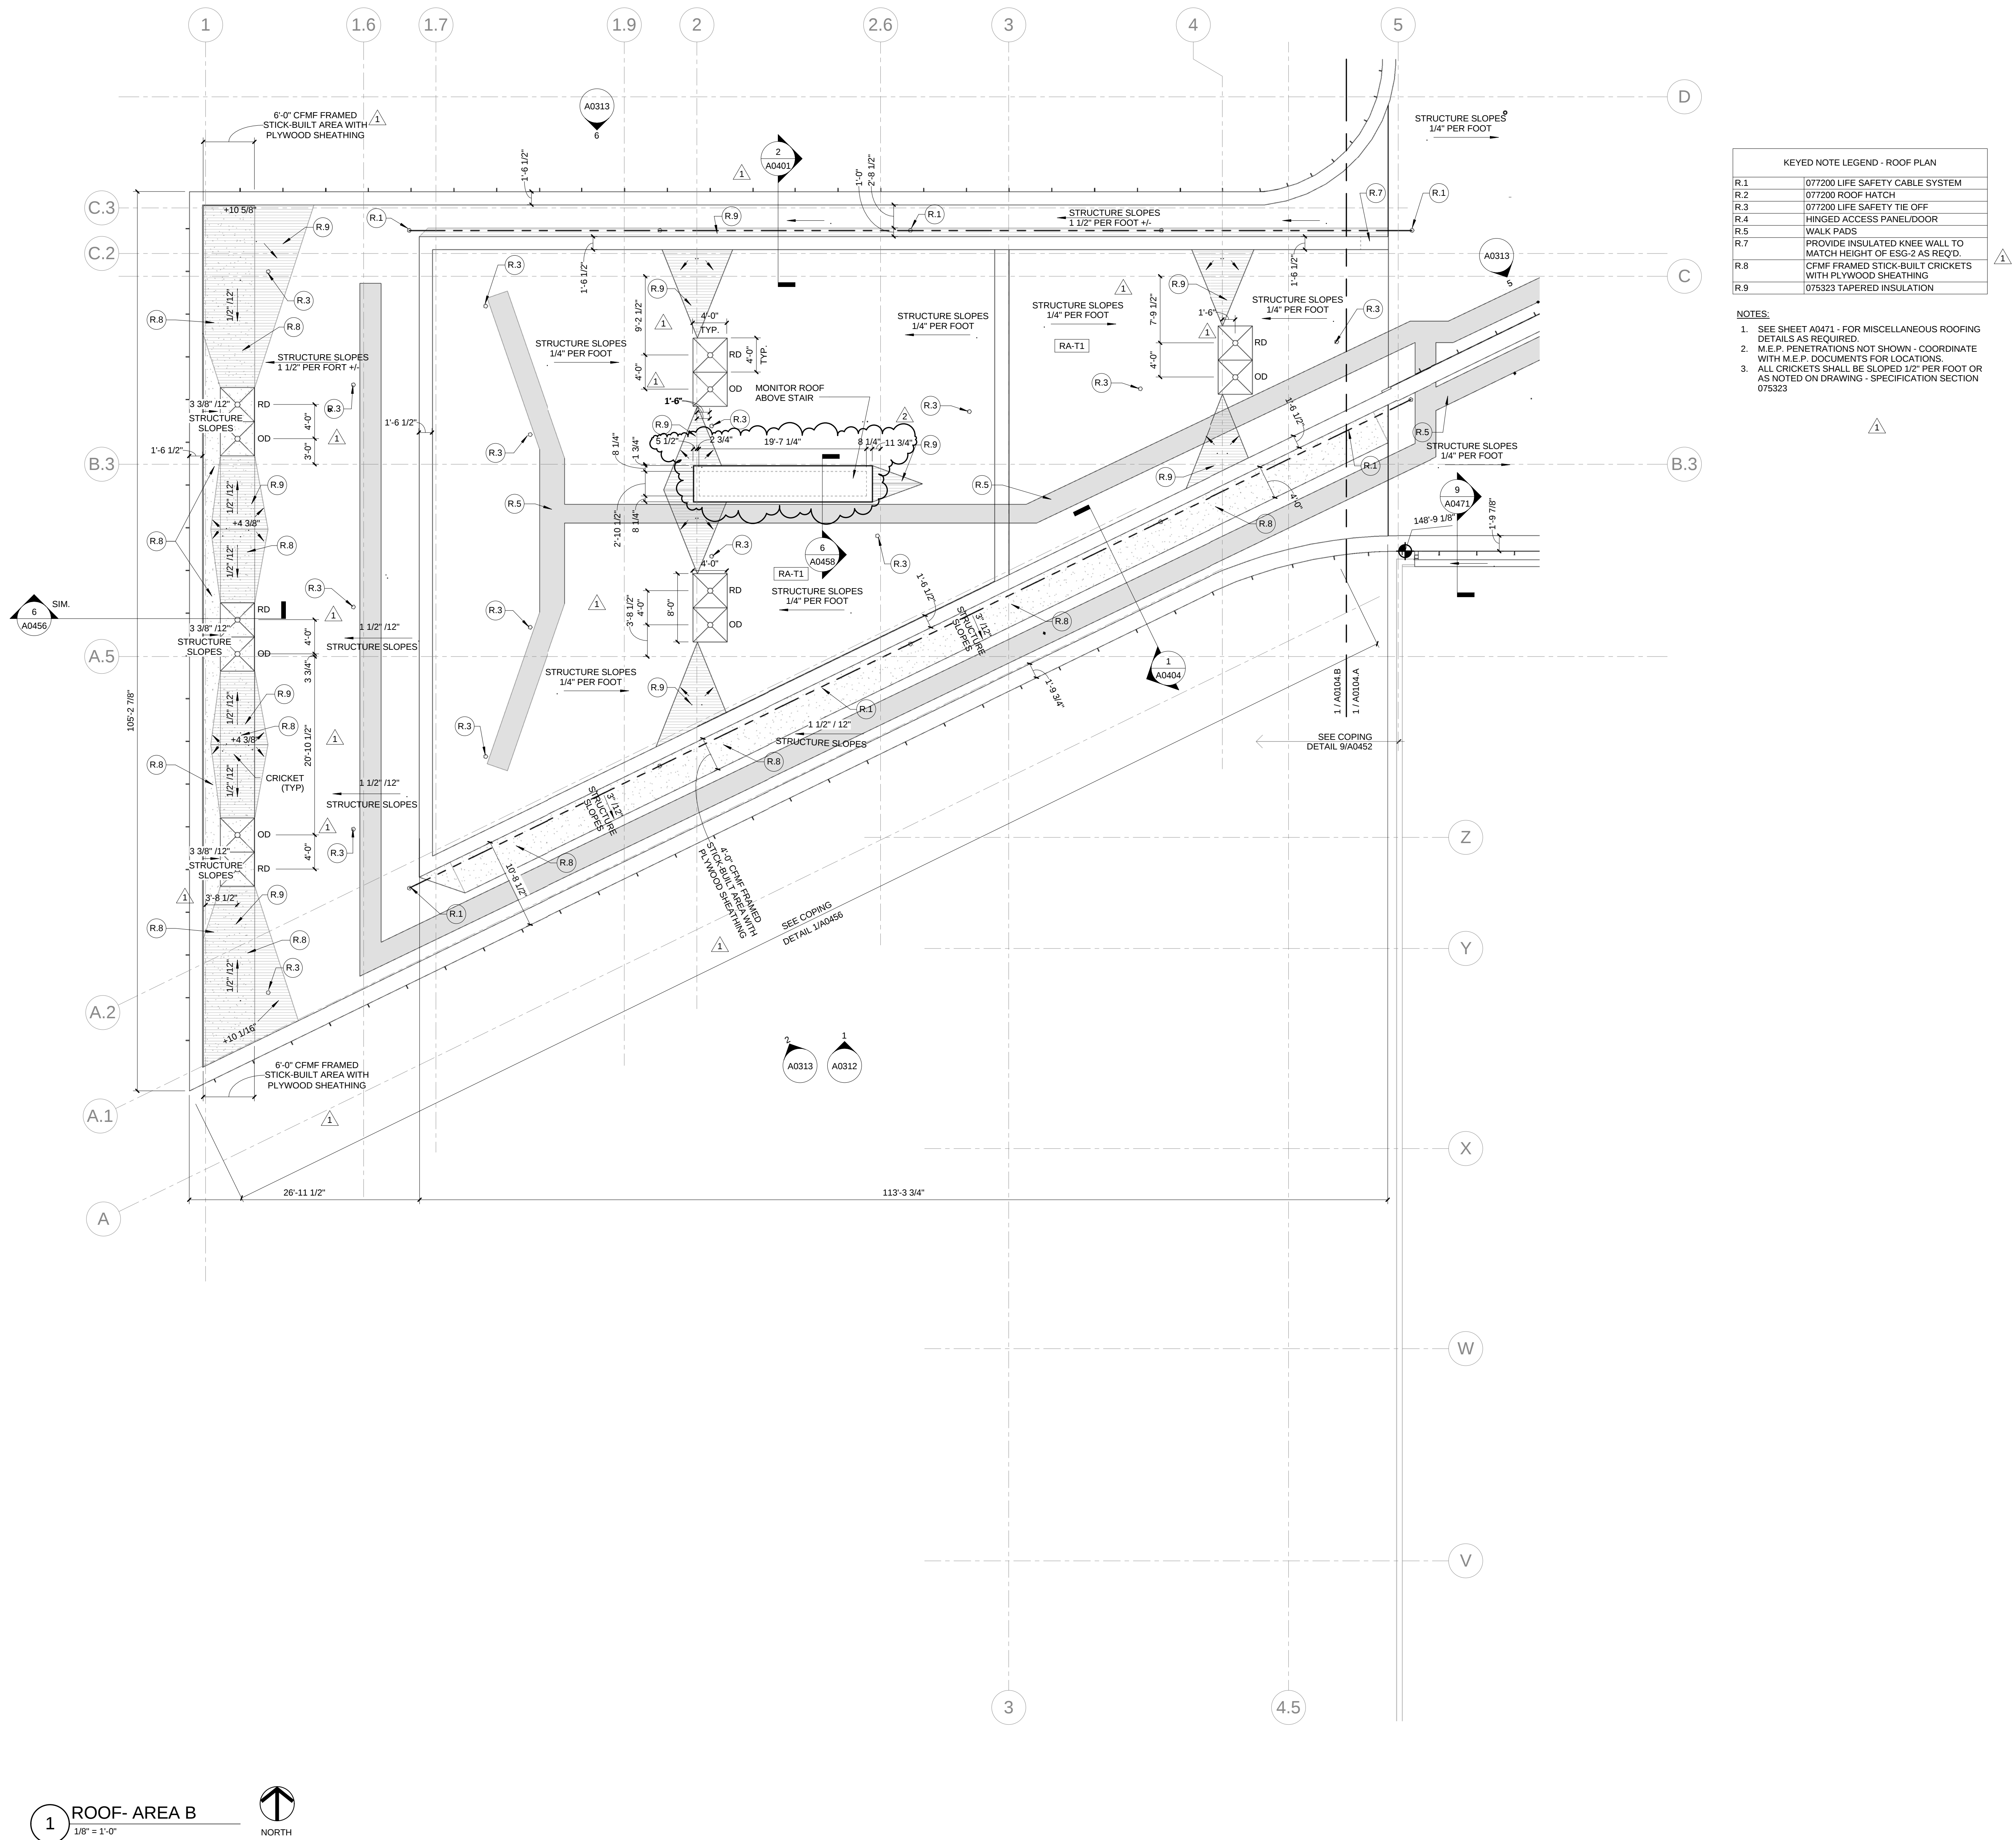

Kathy R. Williams
3.16.16

CONFORMED SET 01 JUL 2016

2	ADDENDUM 1-7	16 MAR 2016
1	ADDENDUM 1-1	29 JAN 2016
1	ISSUED FOR CONSTRUCTION (BP1)	15 JAN 2016

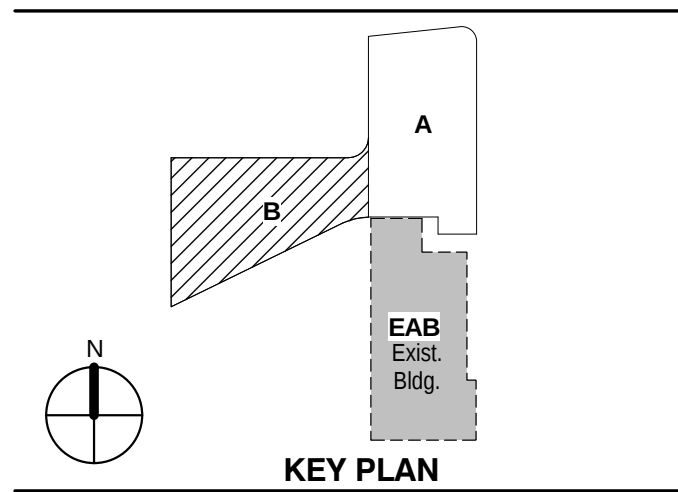

KEY PLAN

Drawing Title:

ROOF PLAN-AREA B

Project No.: 04561.01 Checked by:

A0110.B