

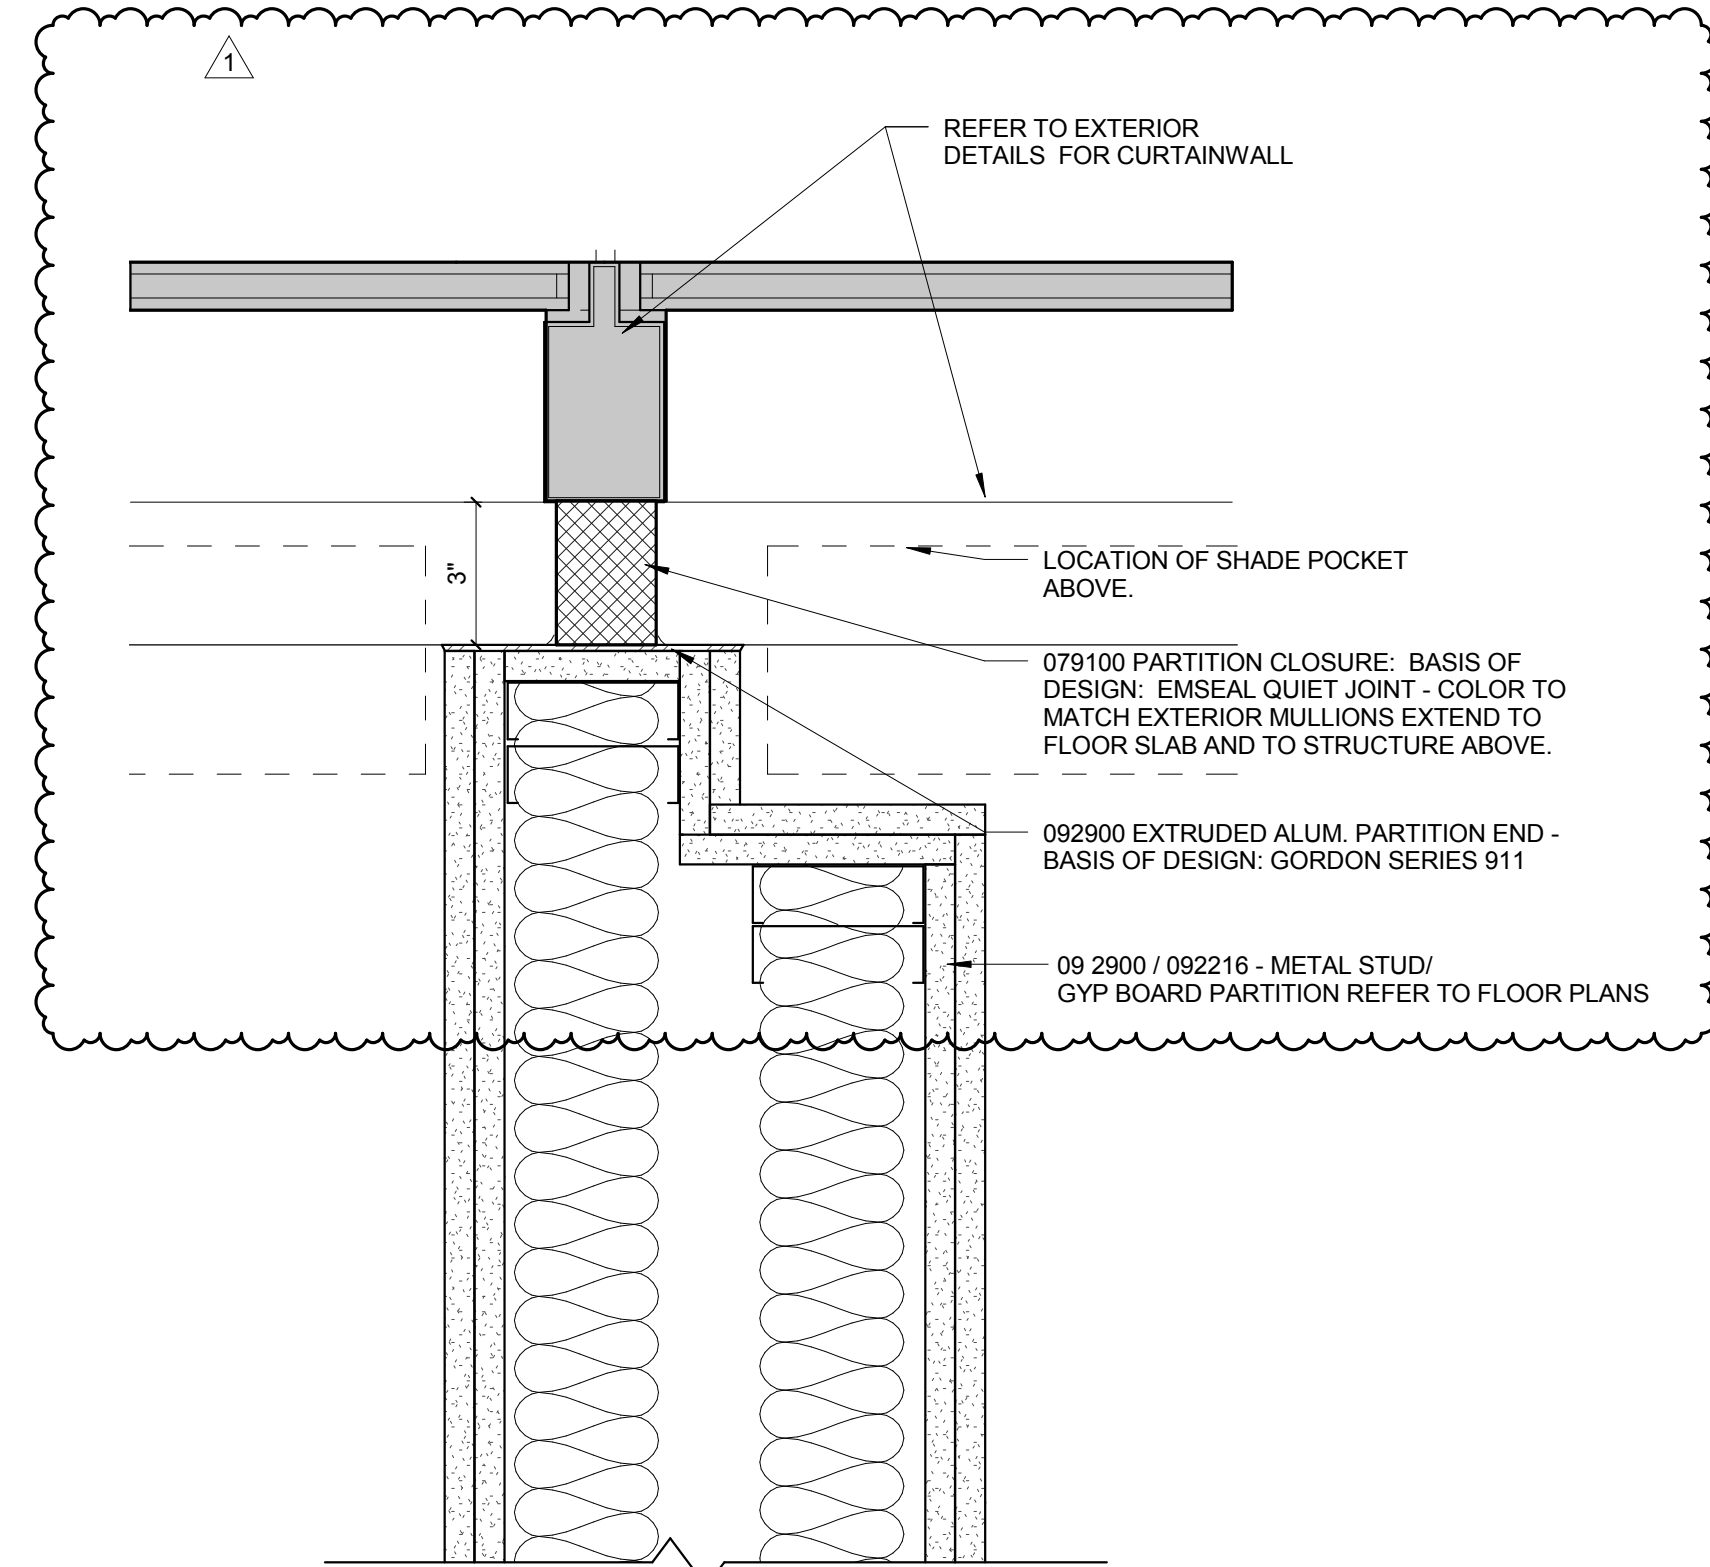
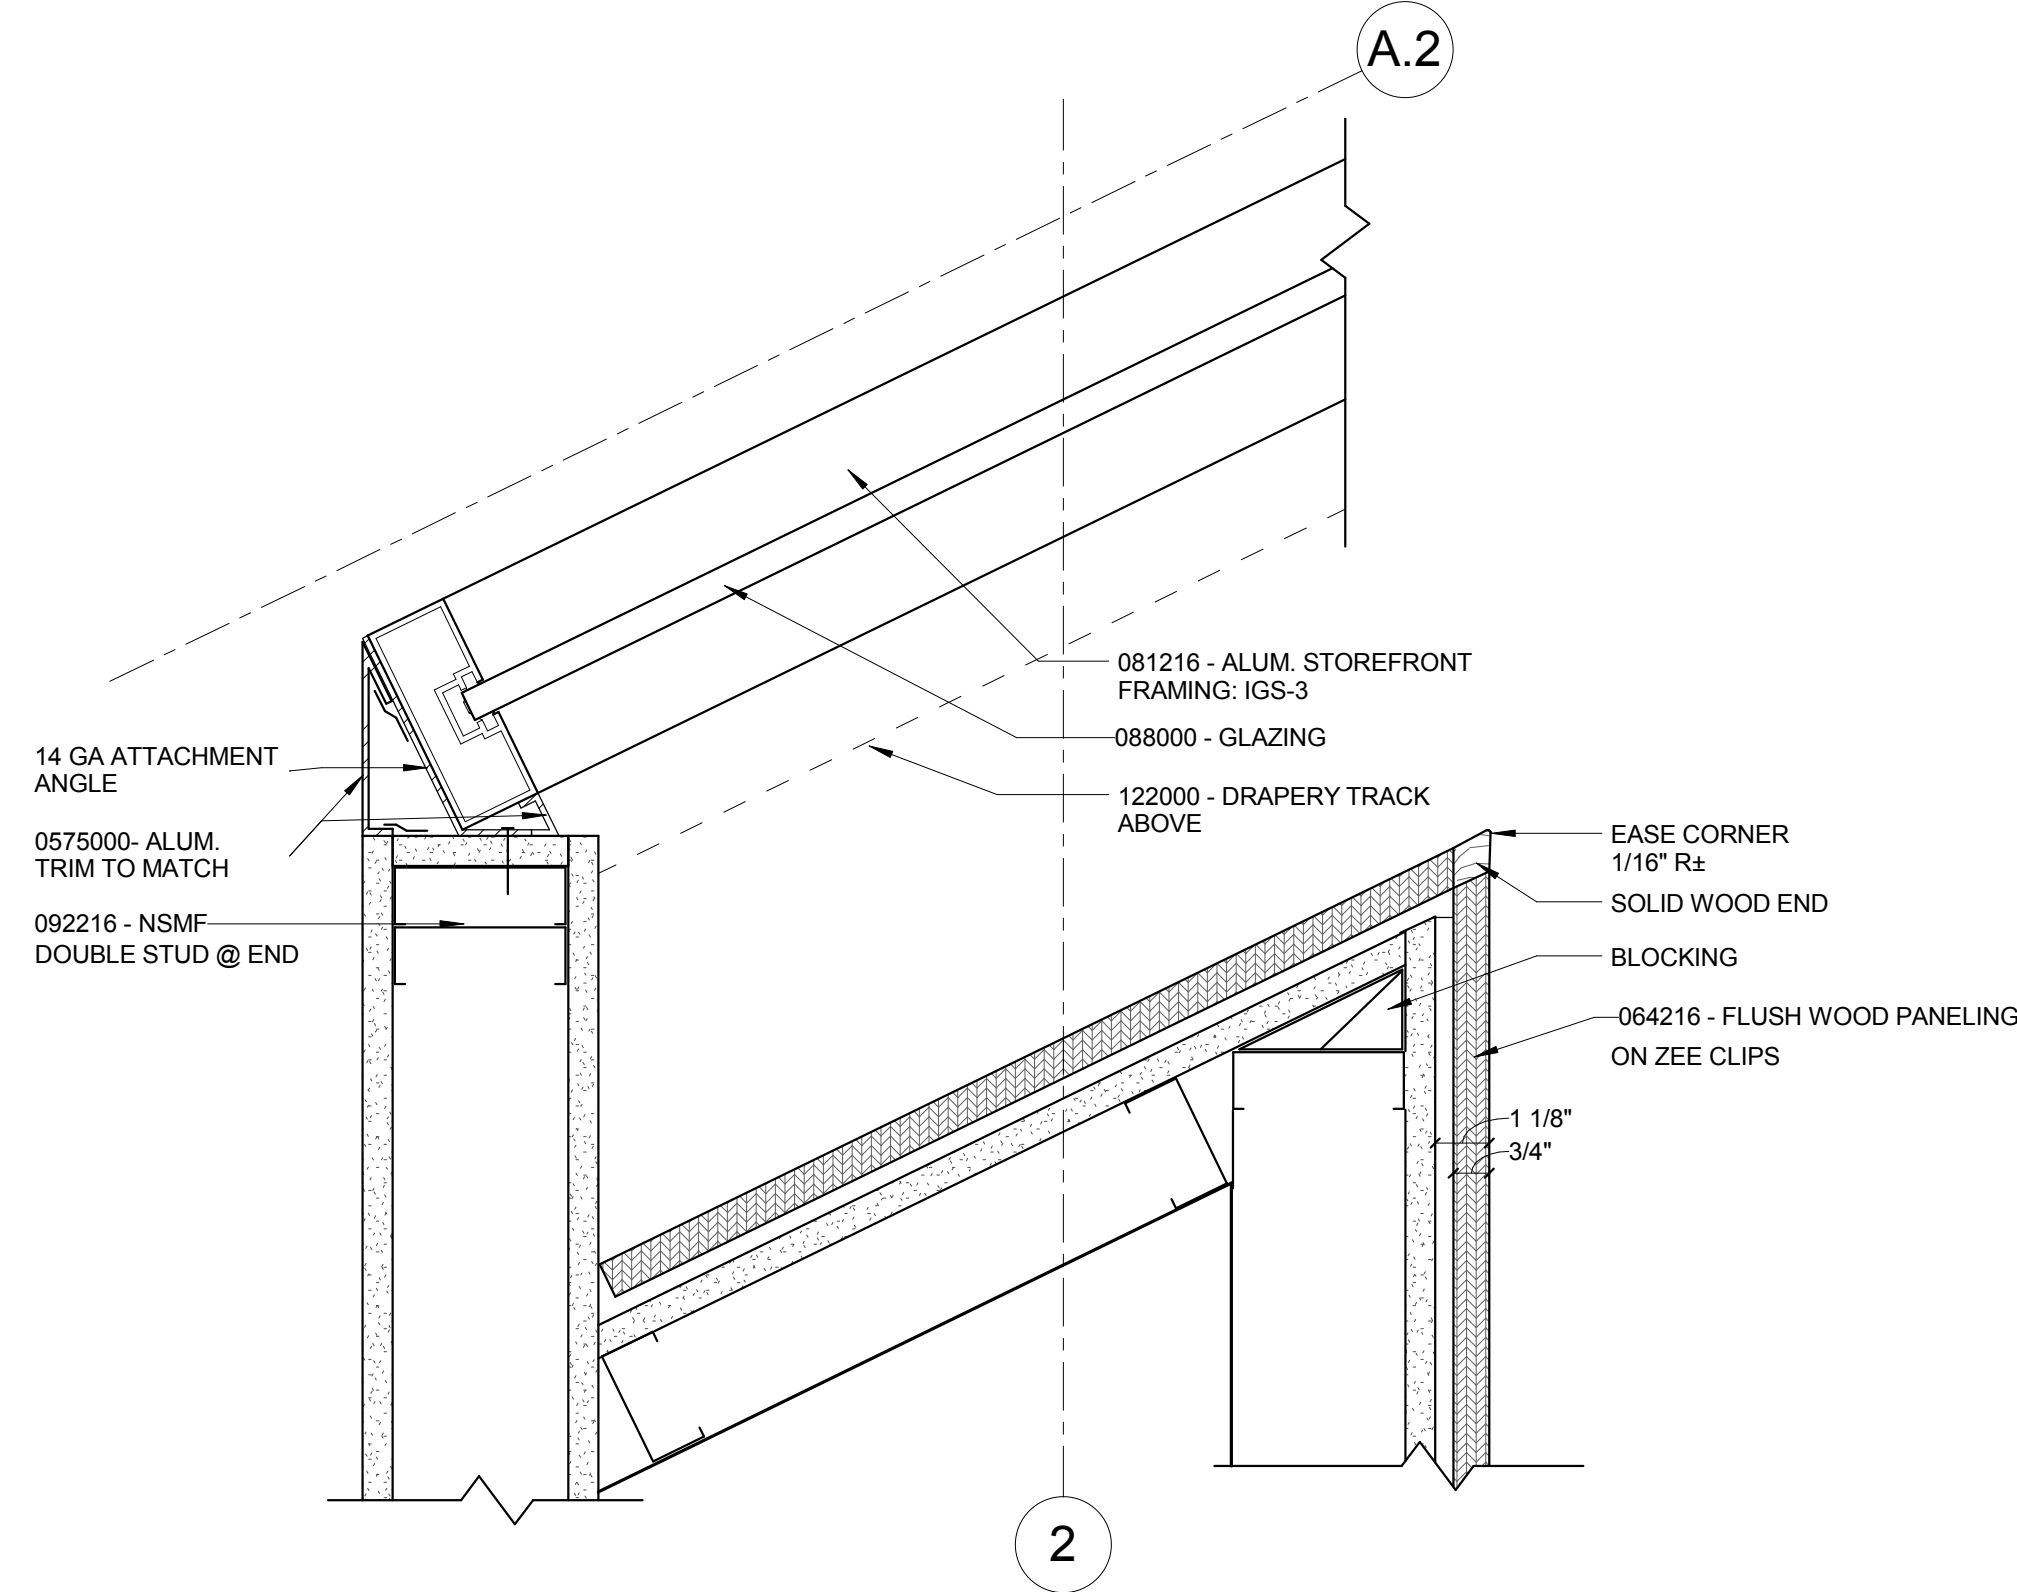
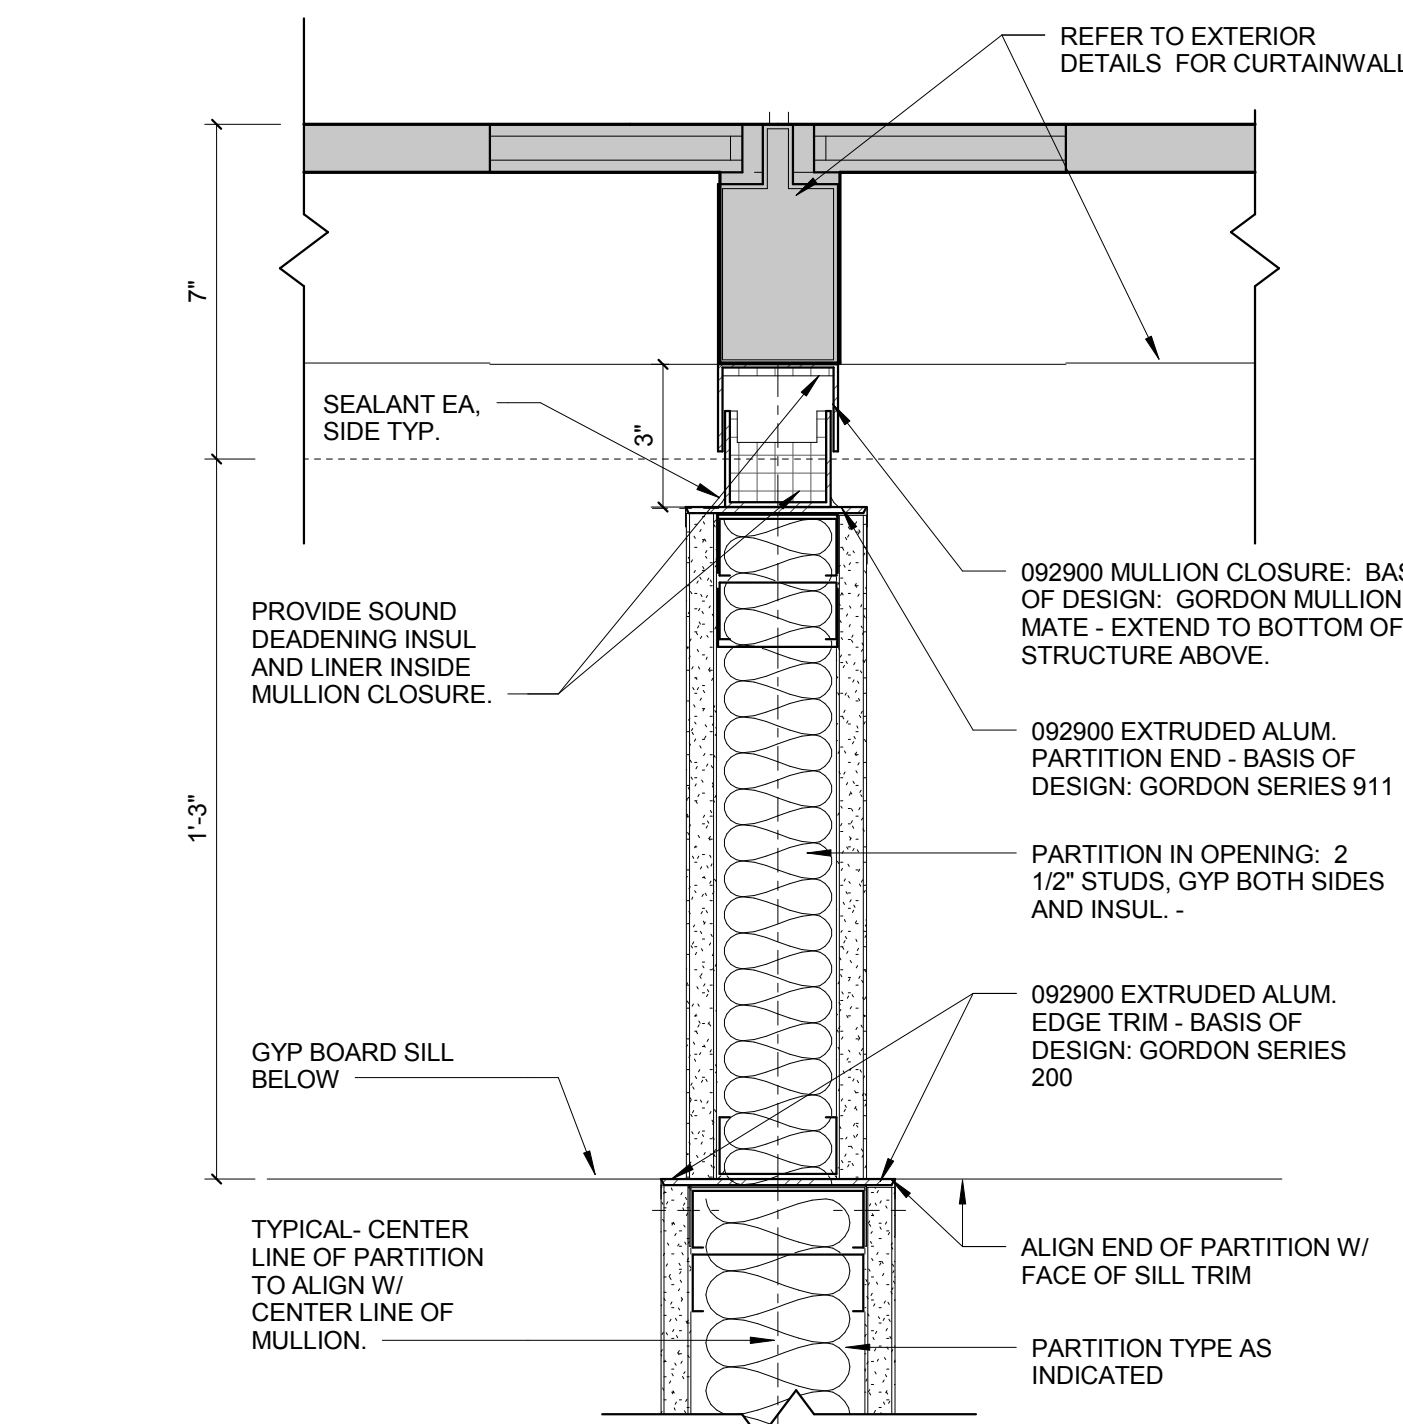
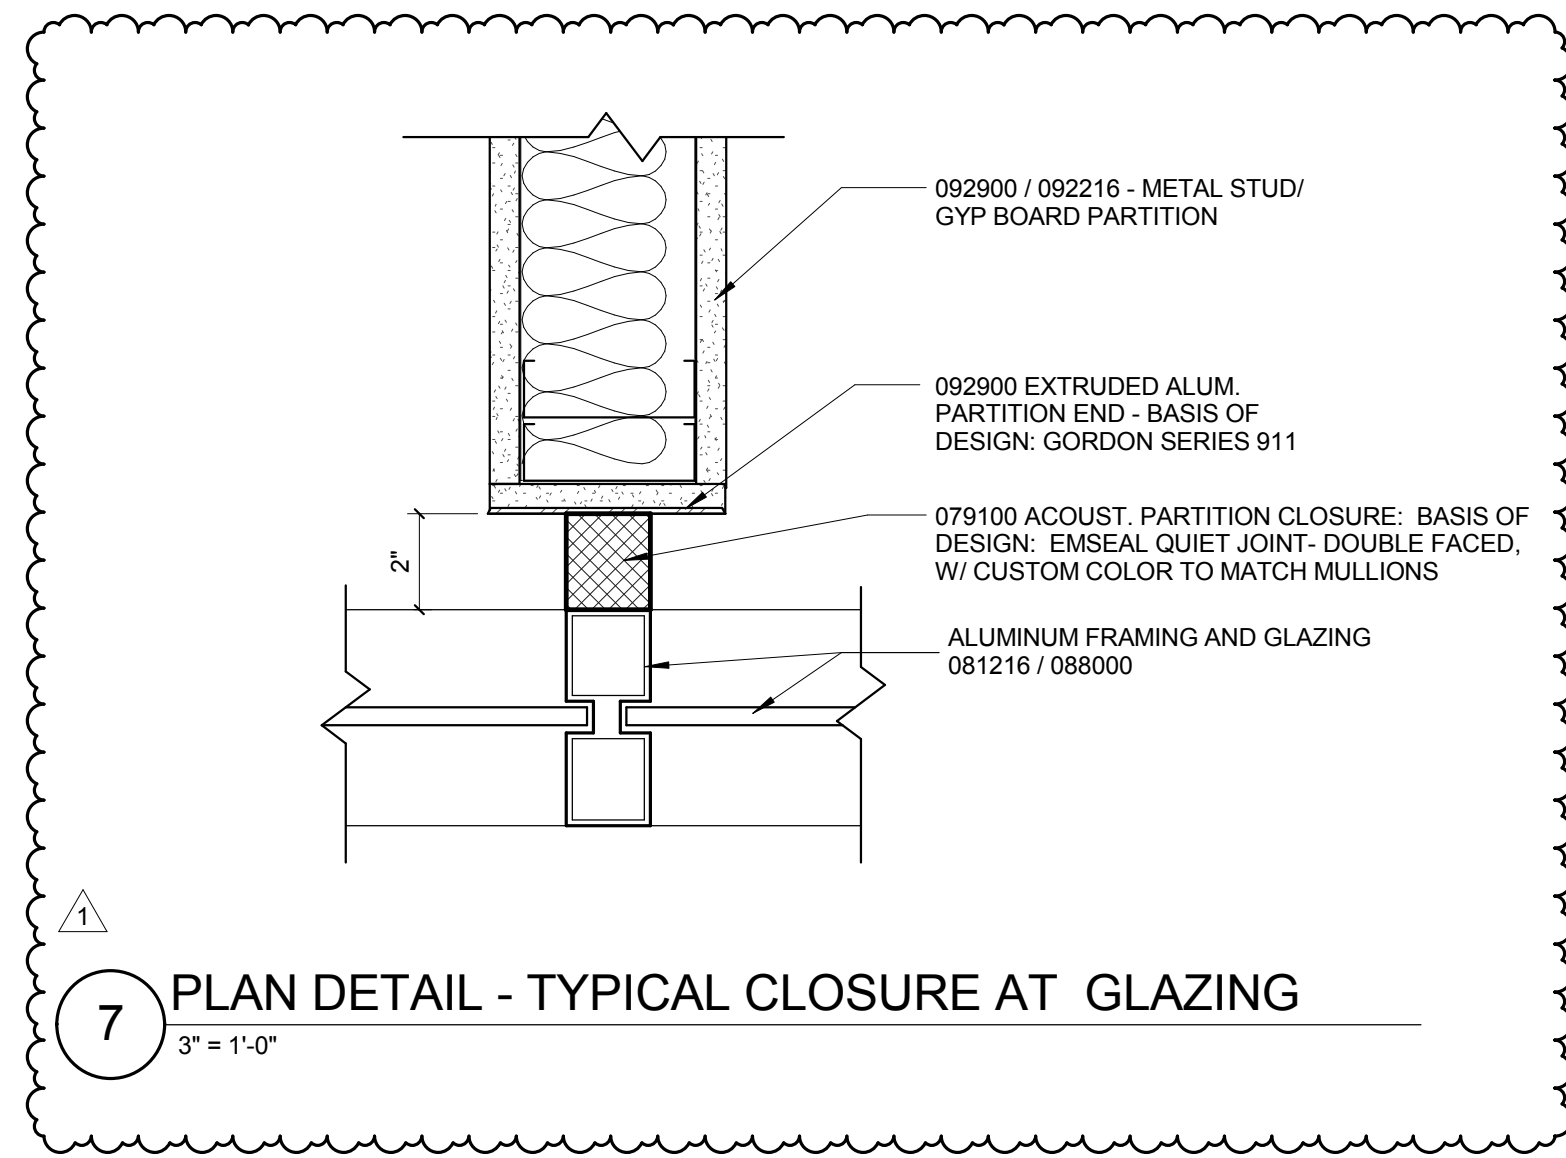


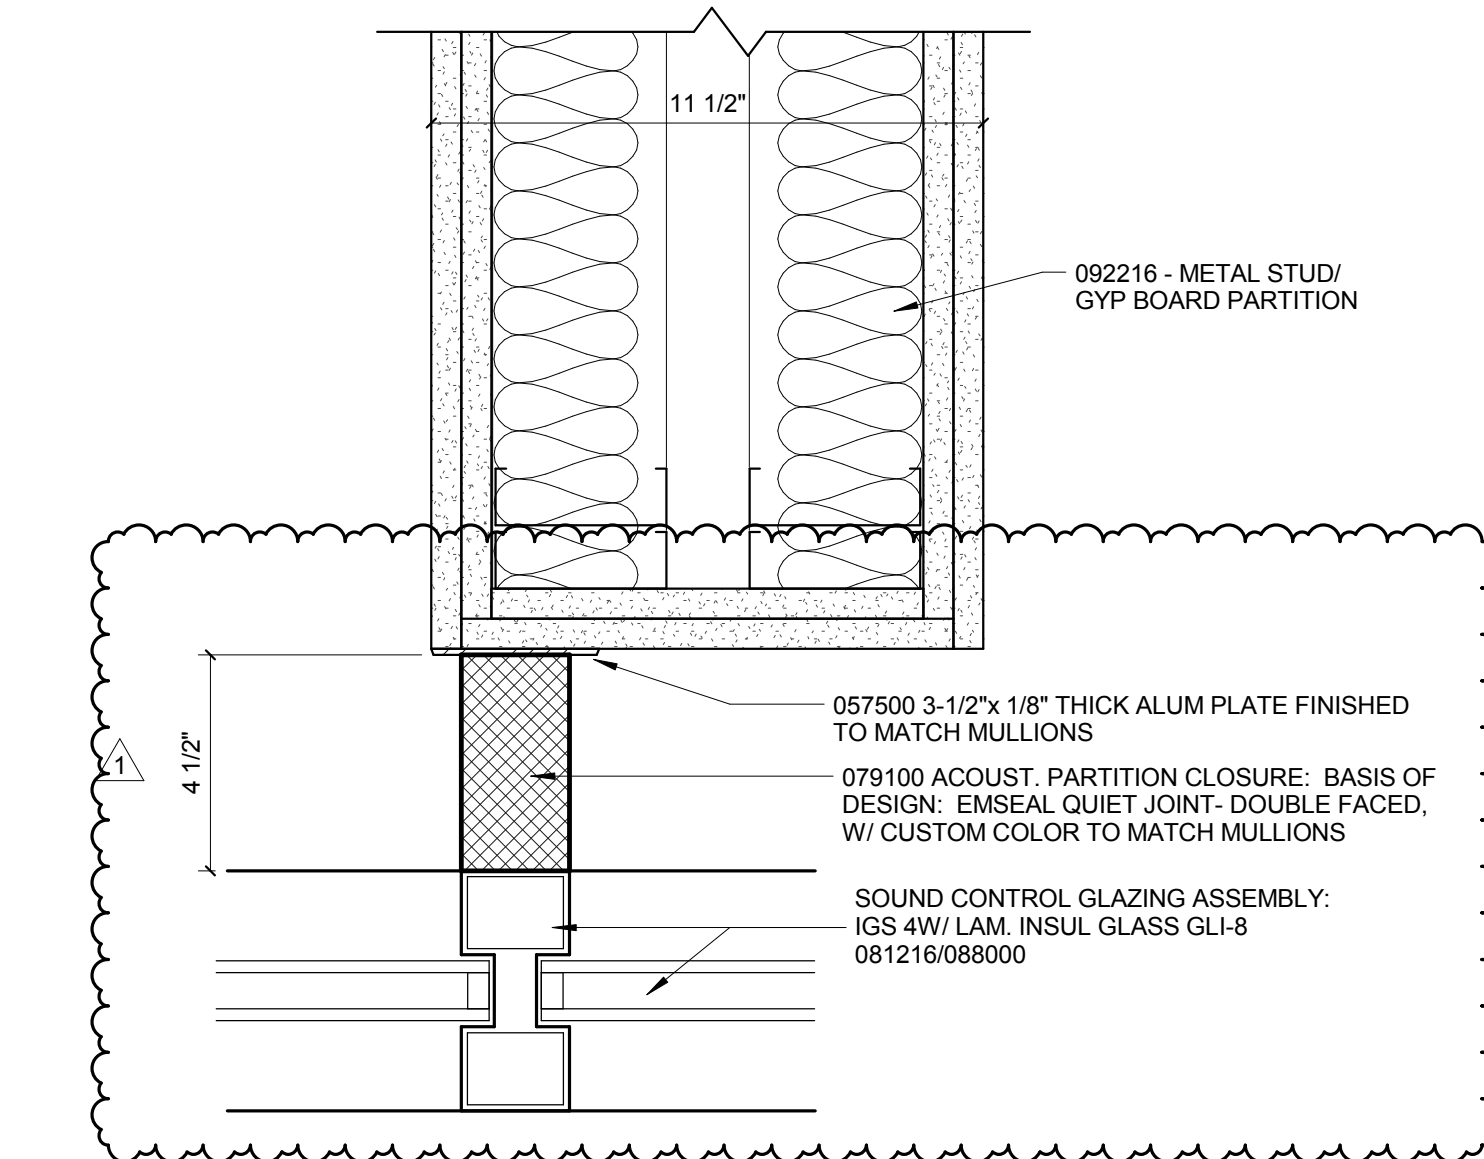

6 PLAN DETAIL AT CONF. ROOM
3" = 1'-0"

1 PLAN DETAIL - WEST WALL
3" = 1'-0"

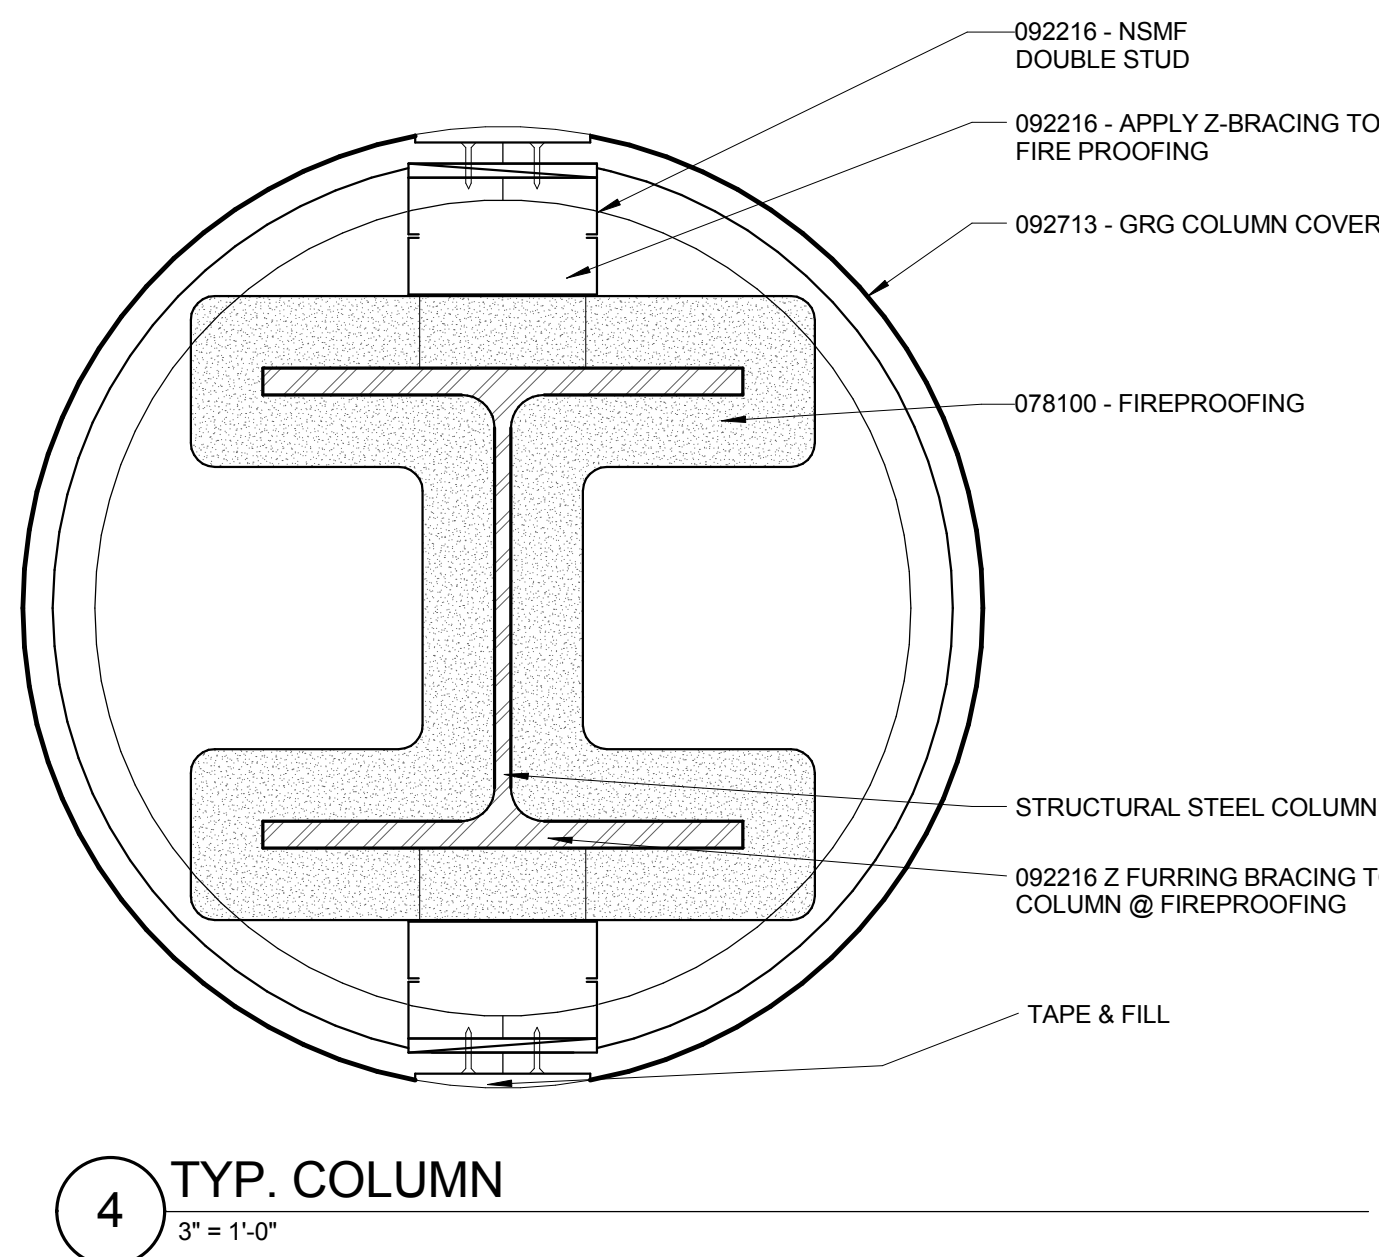

CONFORMED SET

01 JUL 2016

1	ADDENDUM 3-2	15 APR 2016
1	ISSUED FOR CONSTRUCTION (BP3)	15 MAR 2016
No.	Description	Date

Drawing Title:

INTERIOR PLAN DETAILS

Project No.: 04561.01

Checked by:

A0811