



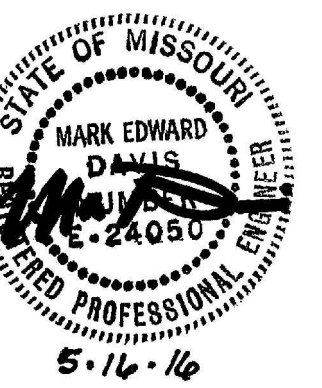

CONFORMED SET 01 JUL 2016



3	ADDENDUM 1-12	16 JUN 2016
2	ADDENDUM 1-10	5 MAY 2016
1	ADDENDUM 1-1	29 JAN 2016
-	ISSUED FOR CONSTRUCTION (BP1)	15 JAN 2016

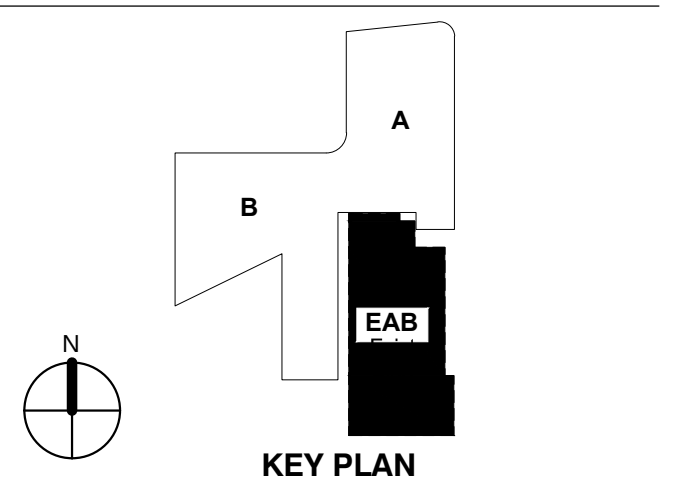




BASIN SECTIONS

Project No.: 04561.00 Checked by:

C602

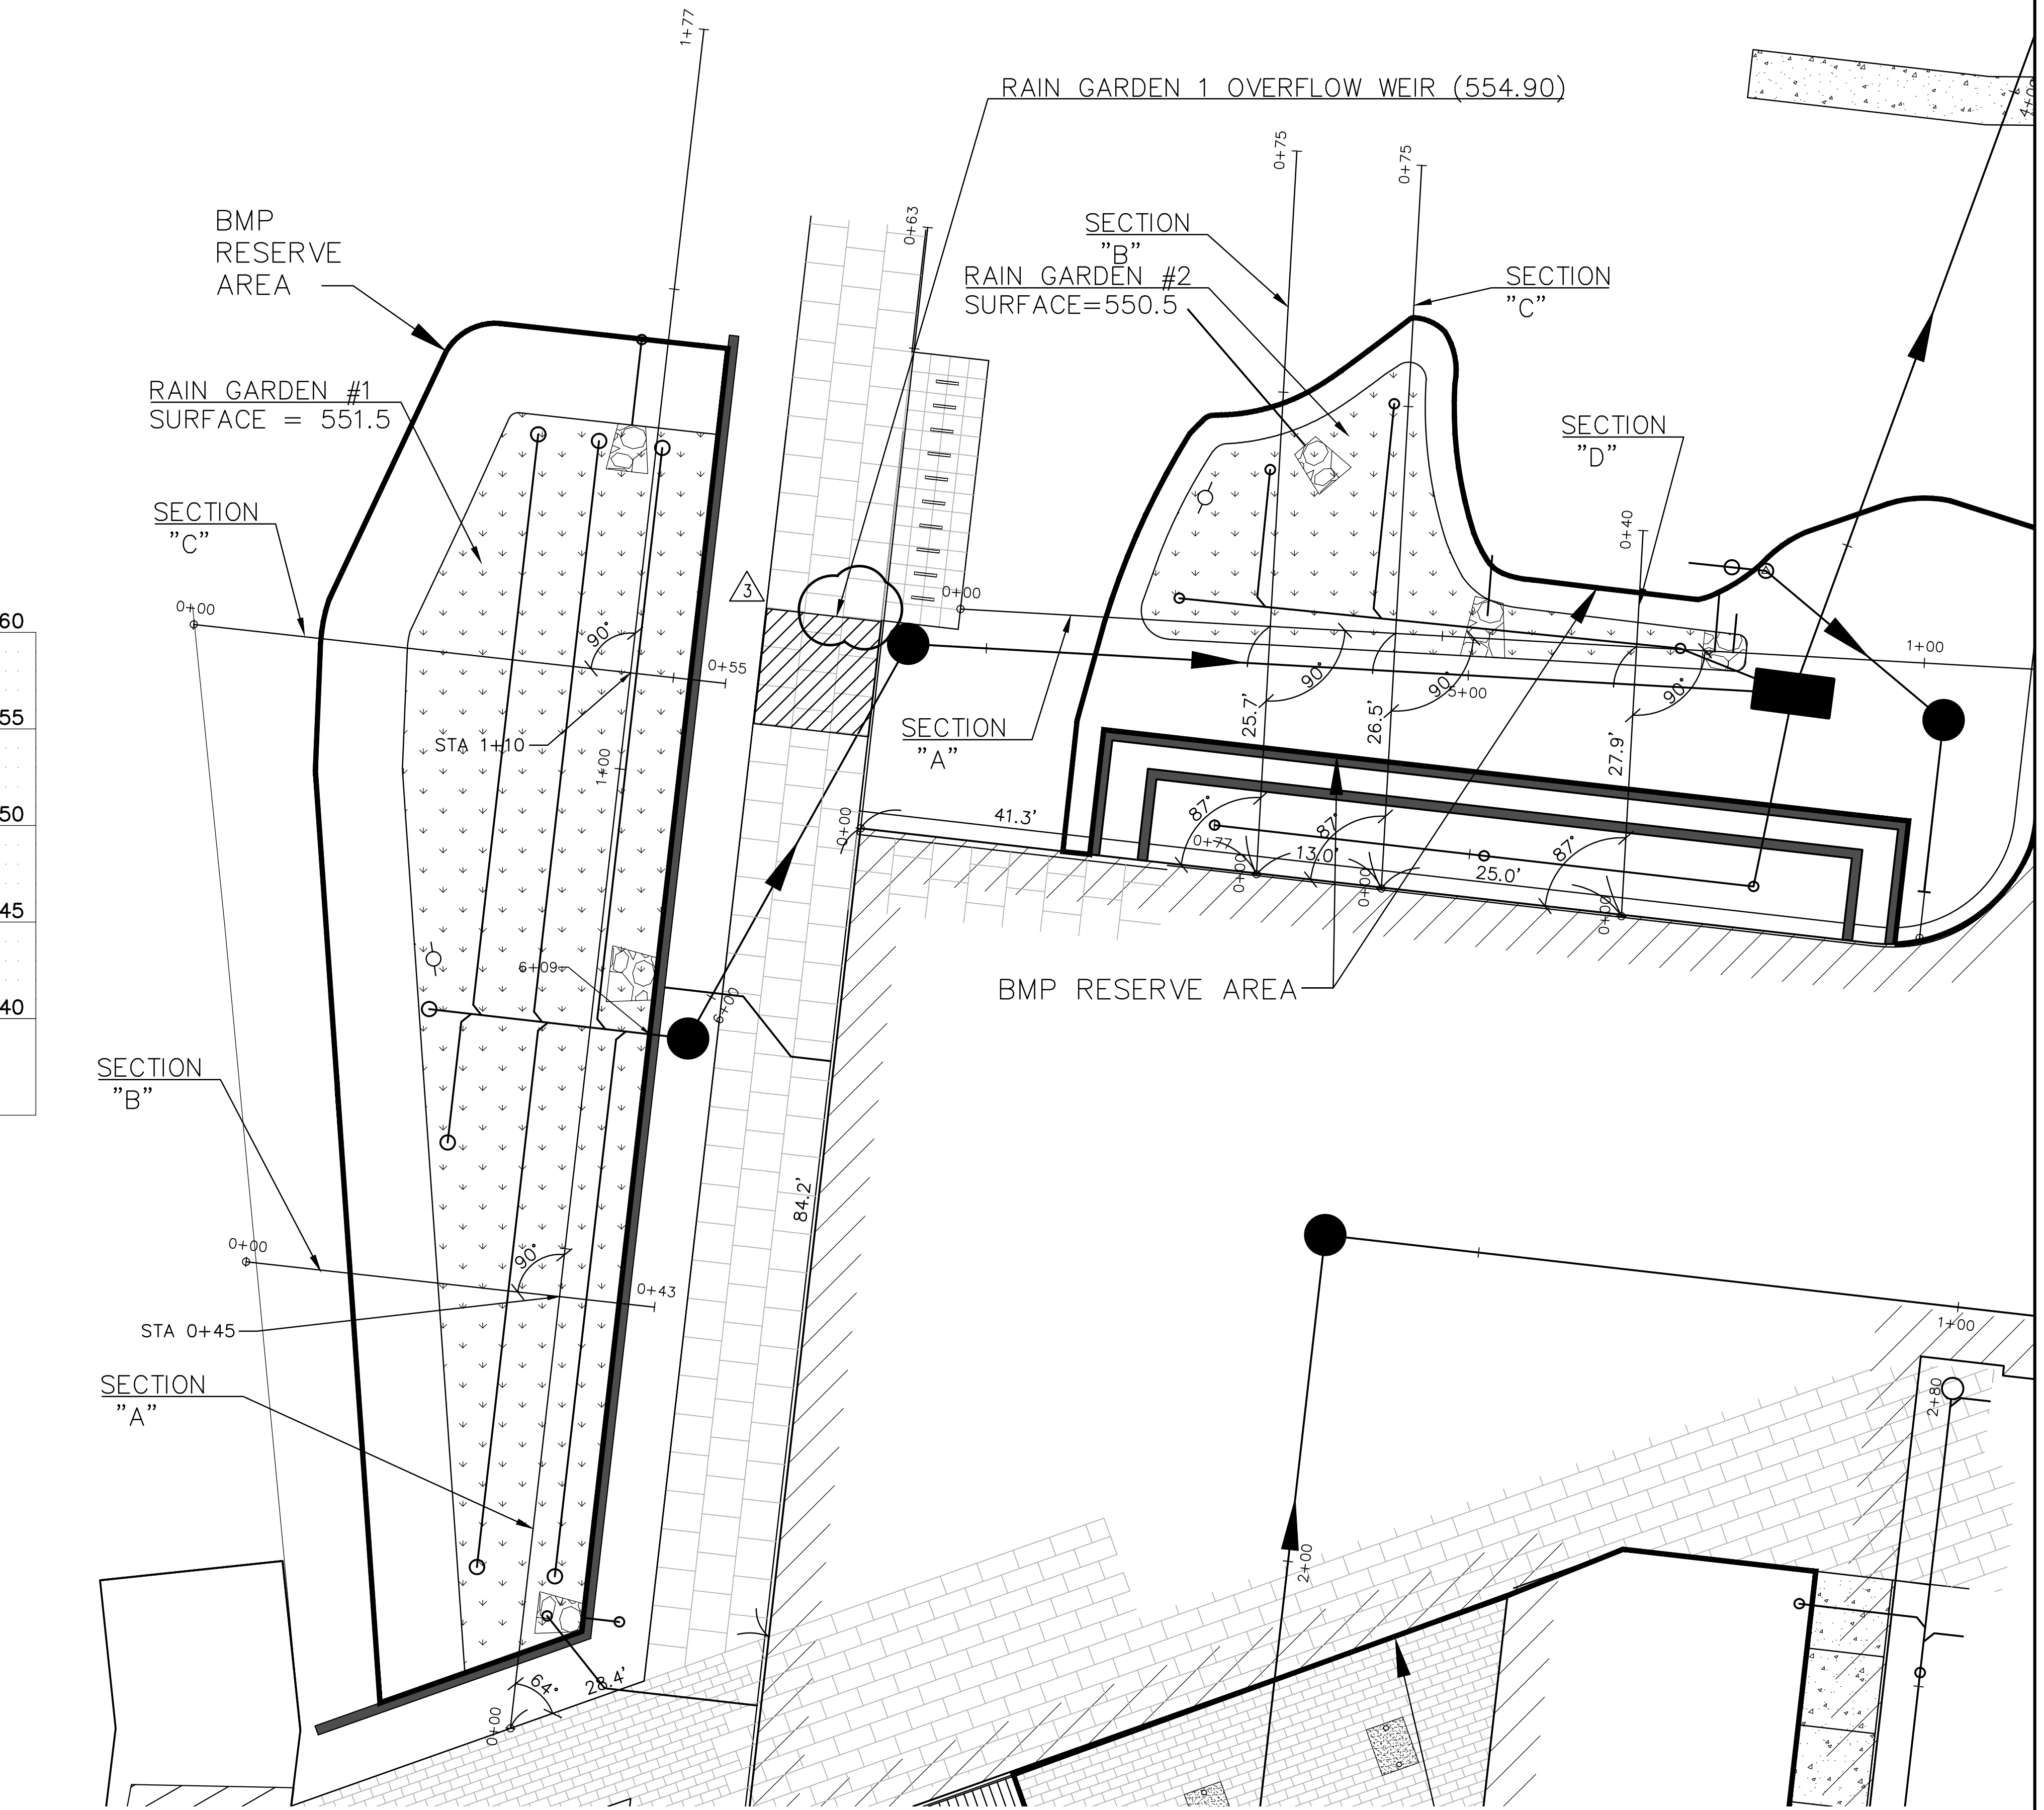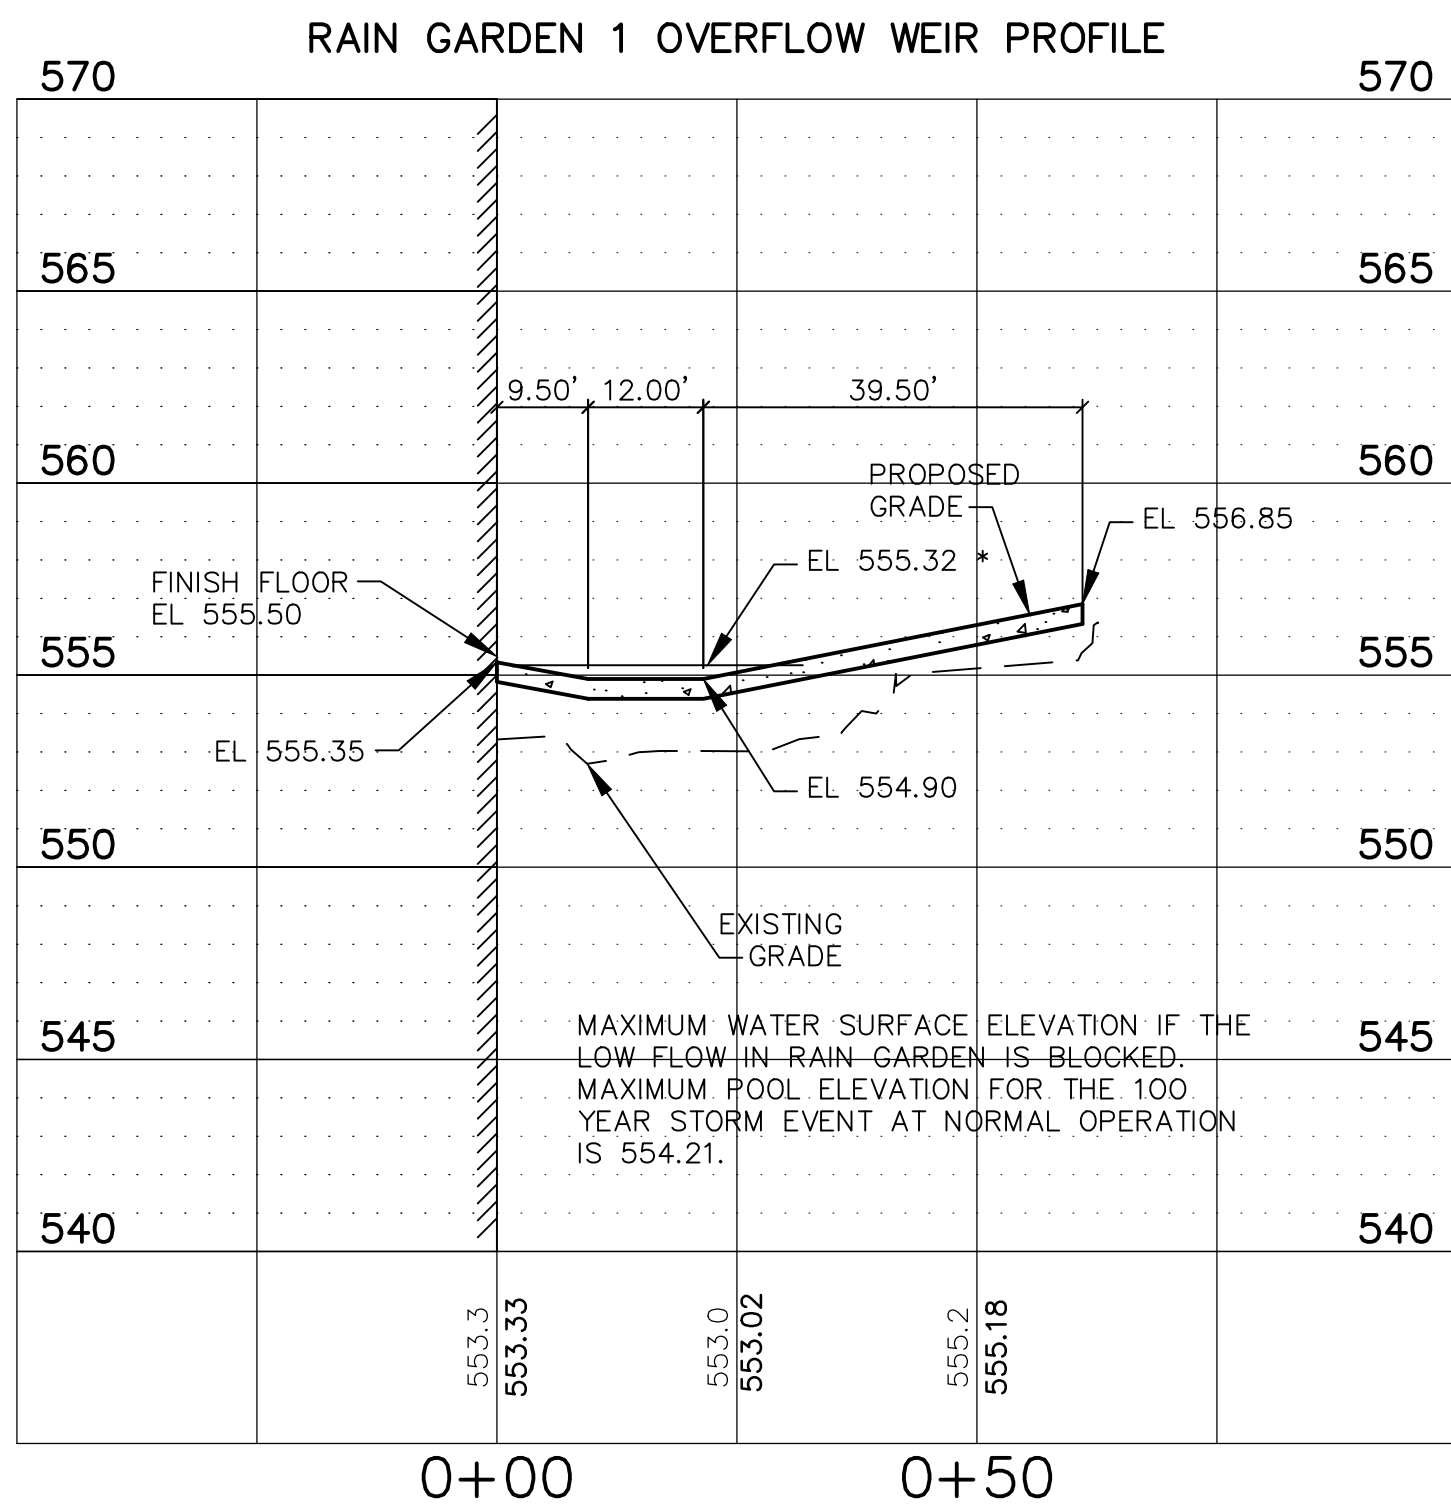

NOTE:
CONTRACTOR TO PROVIDE SIGNED AND SEALED SHOP DRAWINGS TO BE APPROVED BY THE PROJECT ENGINEER AND MSD. CONTACT MSD AT 314-335-2072.

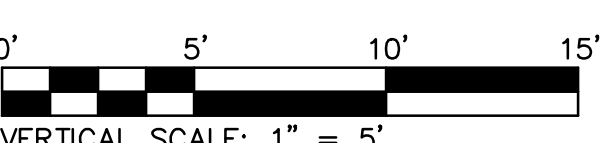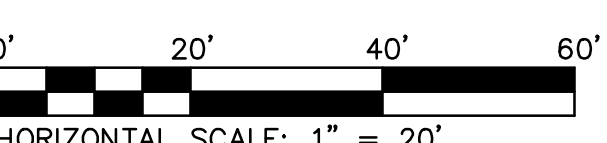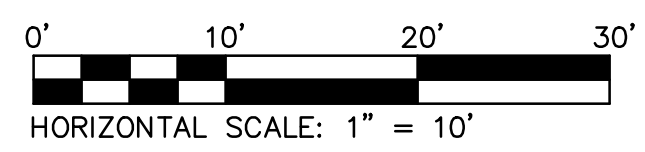

SCALES FOR PROFILES

