


CONFORMED SET

01 JUL 2016

|                               |              |             |
|-------------------------------|--------------|-------------|
| 1                             | ADDENDUM 2-1 | 17 MAR 2016 |
| ISSUED FOR CONSTRUCTION (BP2) |              | 01 MAR 2016 |
| No.                           | Description  | Date        |

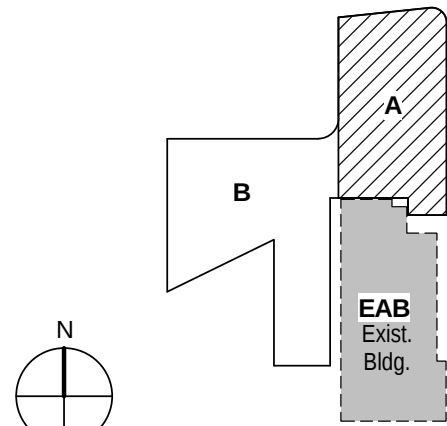

KEY PLAN


Drawing Title:

LEVEL 0 FLOOR PLAN -  
FIRE PROTECTION

Project No.: 04561.01

Checked by:

FP0100.A

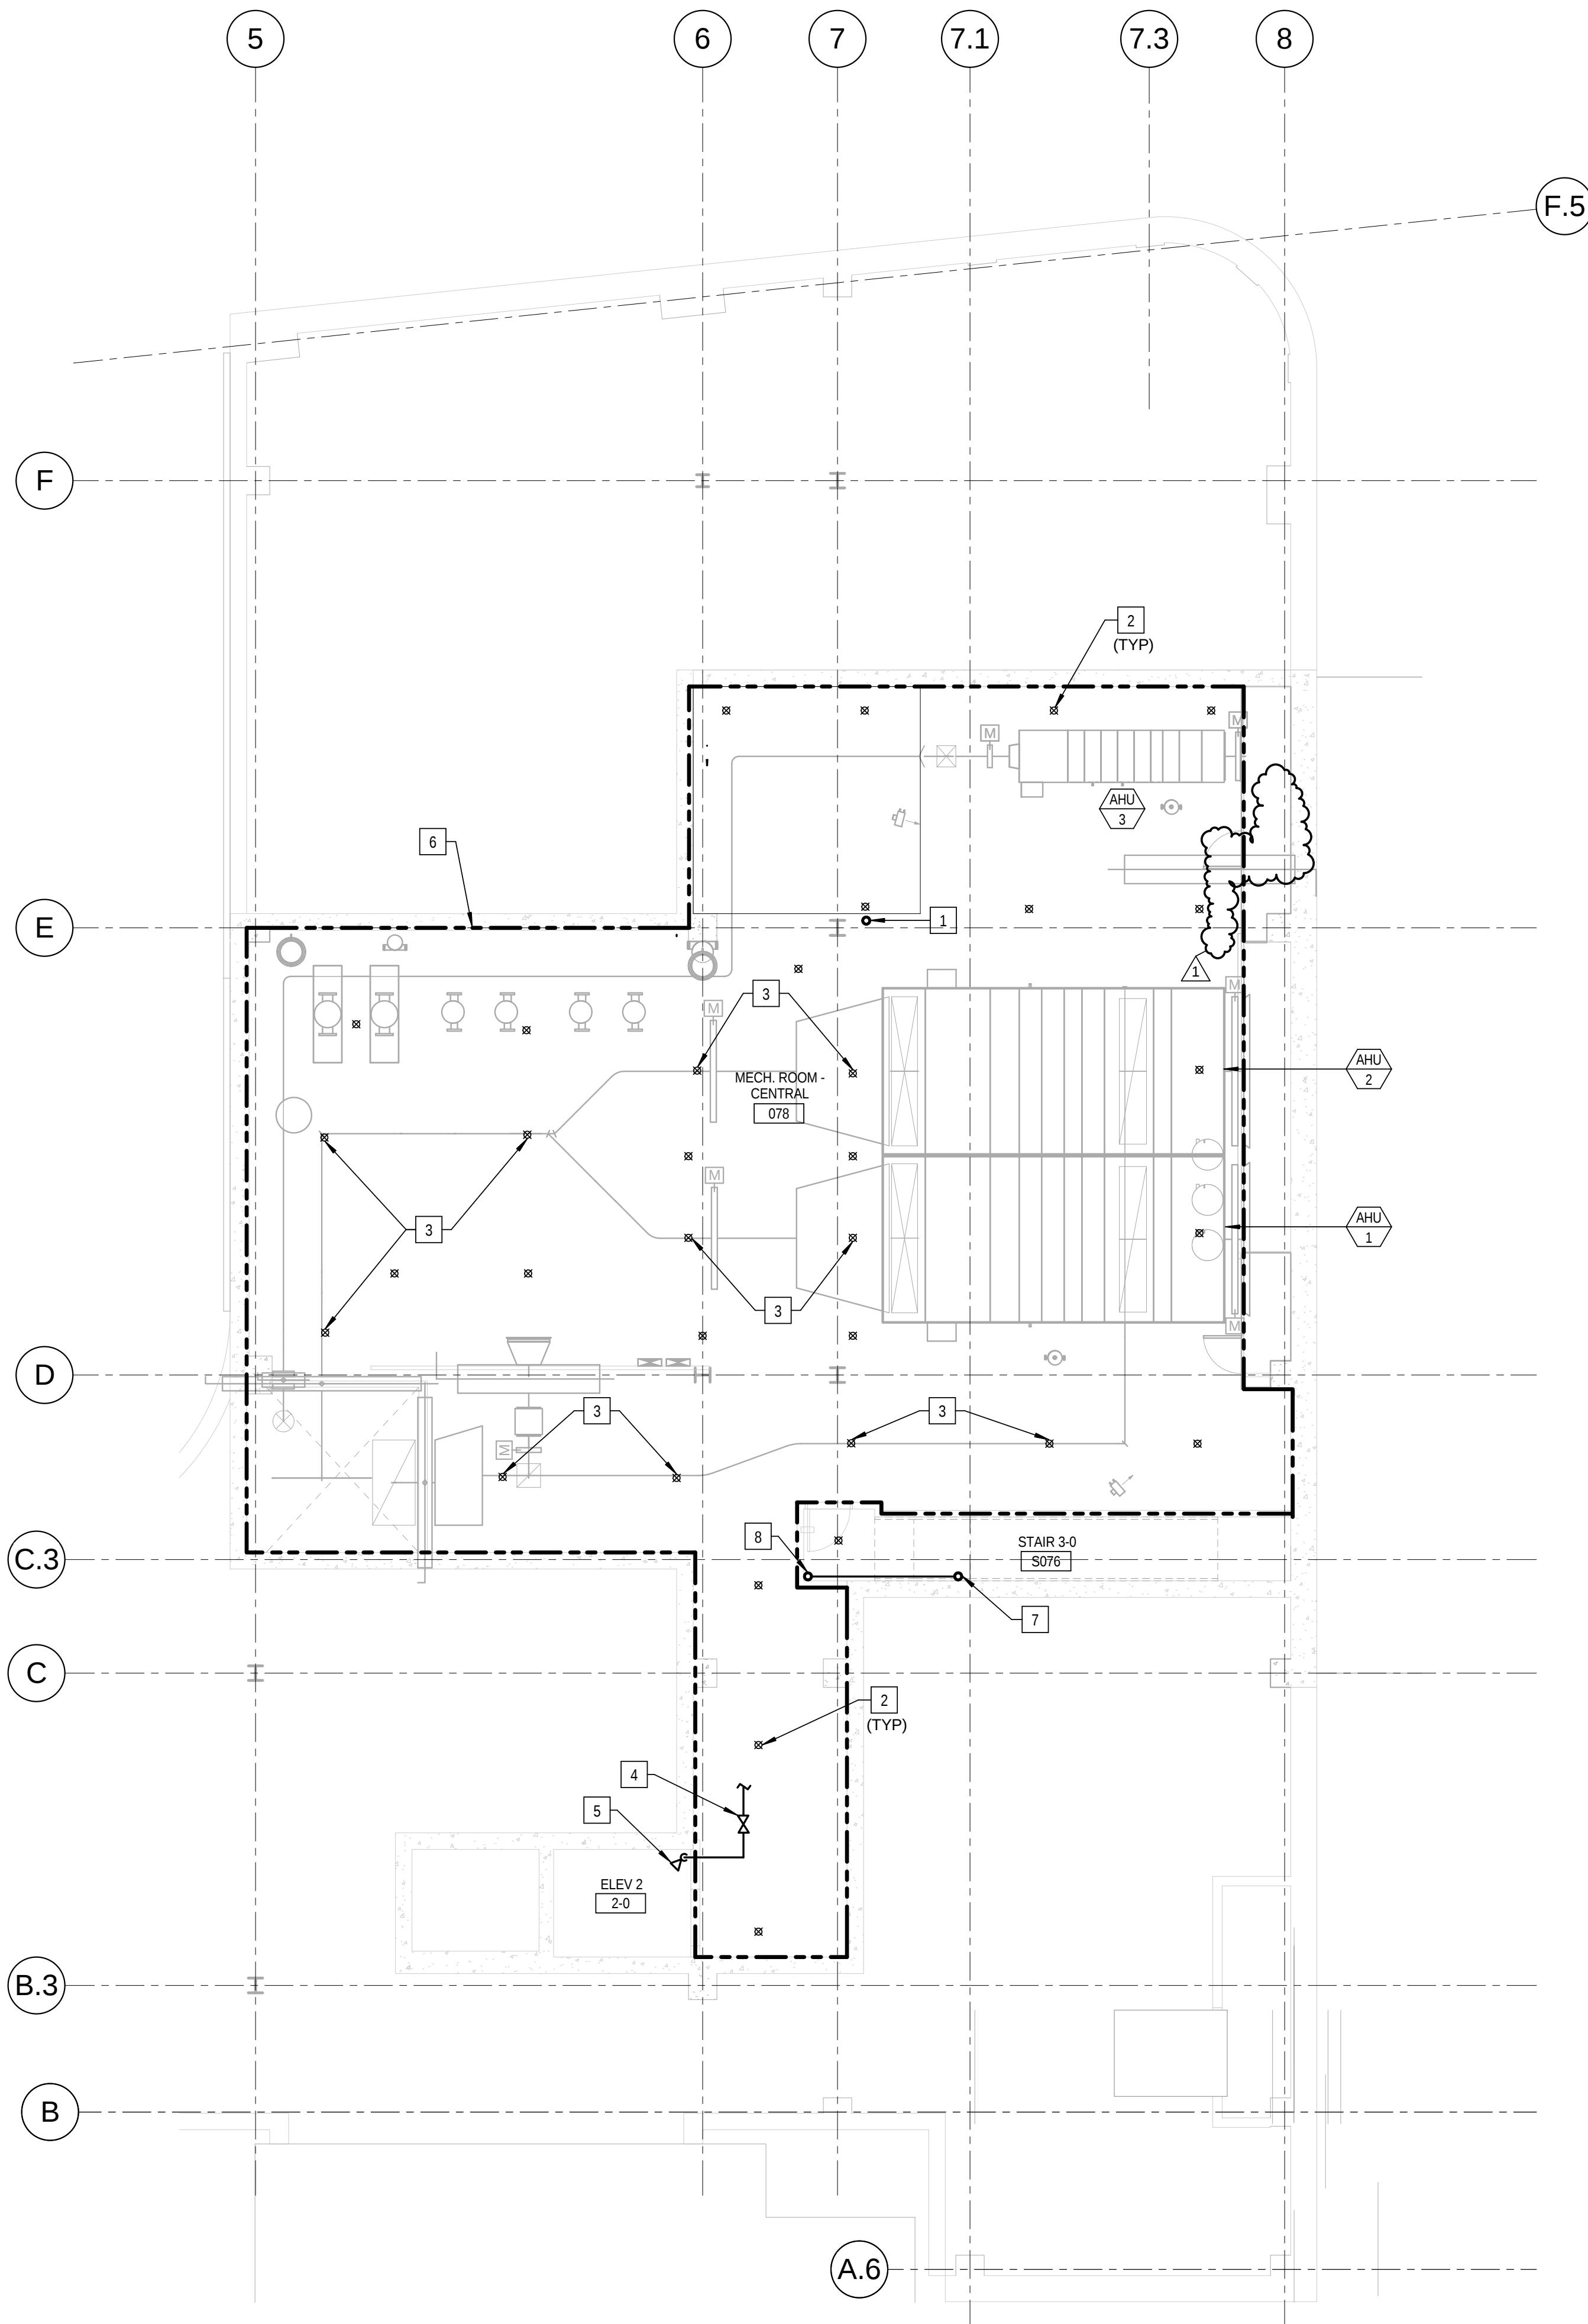

1 LEVEL 0 FLOOR PLAN - FIRE PROTECTION

1/8" = 1'-0"