


CONFORMED SET 01 JUL 2016

1	ADDENDUM 2-1	17 MAR 2016
1	ISSUED FOR CONSTRUCTION (BP2)	01 MAR 2016
No.	Description	Date

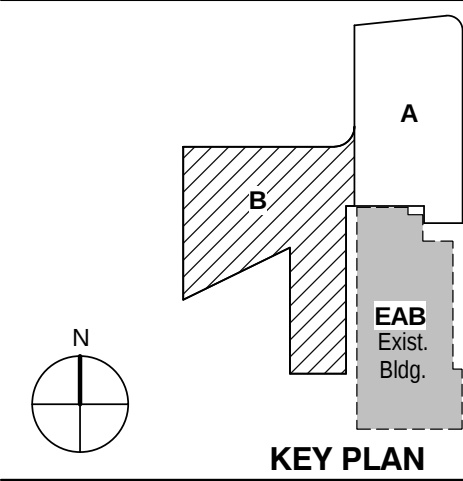


KEY PLAN

LEVEL 03 AREA B FLOOR
PLAN - FIRE PROTECTION

Project No.: 04561.01 Checked by:

FP0103.B

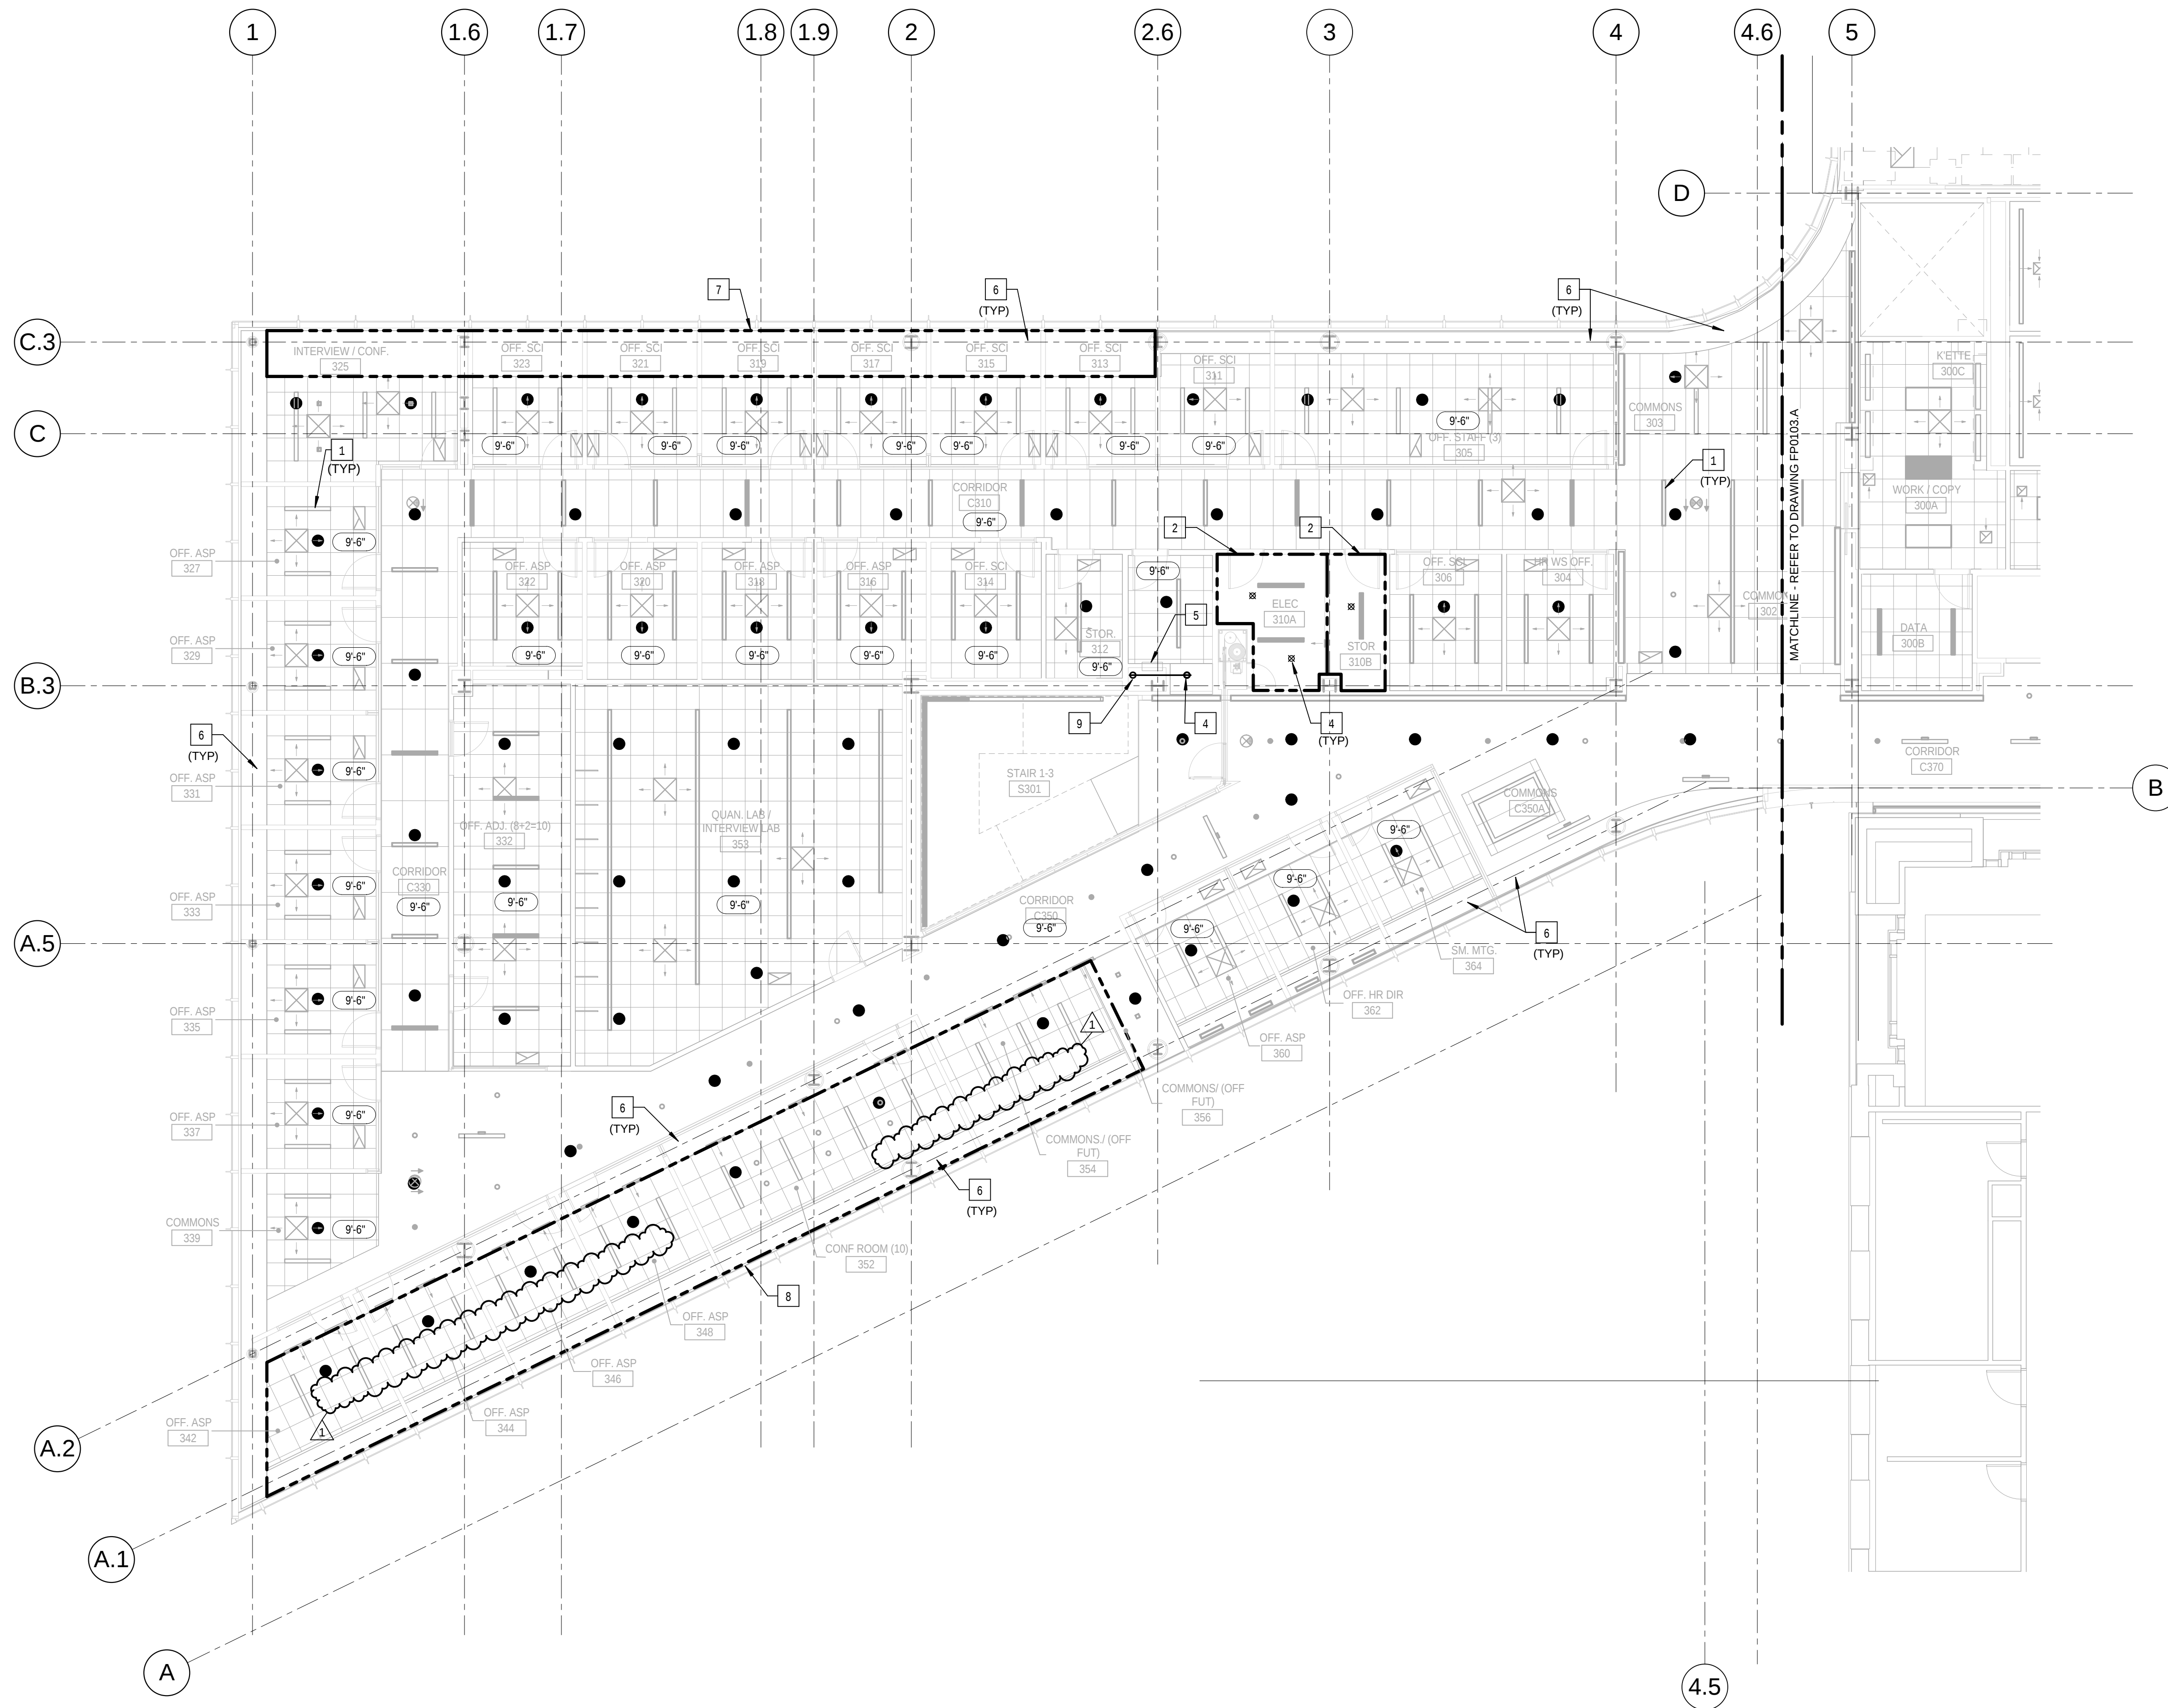

1 LEVEL 03 AREA B FLOOR PLAN - FIRE PROTECTION
1/8" = 1'-0"