


INTERIOR SYMBOLS LEGEND

- SHADED AREAS ARE NOT INCLUDED IN SCOPE OF WORK FOR INTERIOR RENOVATION
- KEYED NOTE
- LVT-1 INSTALLATION DIRECTION. INSTALL PARALLEL WITH DIRECTION OF SYMBOL
- XX-# LOCATION OF FLOORING MATERIAL TRANSITION
- XX-# SPECIFIED FINISH, REFERENCE FINISH SCHEDULE IF NOT NOTED.

INTERIORS SYMBOLS LEGEND
1/8" = 1'-0"

PLAN KEY NOTES

- 1 WVP-2 OPAQUE, WHITE (LAQUER FINISH) PANELS TO BE LOCATED FLOOR TO CEILING AT DESIGNATED LOCATIONS. SEE ELEVATIONS AND ENVIRONMENTAL GRAPHICS DRAWINGS FOR LAYOUT AND GRAPHIC INLAY.
- 2 WVP-1 TO BE USED ON FACES OF WALLS AND SOFFITS AT DESIGNATED LAB ENTRANCE RECESSES.
- 3 OPAQUE FINISH WOOD PERFORATED PANELS FOR ACOUSTICS WITH 1 1/2" FIBERGLASS ACOUSTICS WHITE BATTS BEHIND. TO BE PAINTED SCHEDULED WALL COLOR.
- 4 AP-1 FABRIC WRAPPED ACOUSTIC PANELS - FULL HEIGHT.
- 5 VERTICAL WOOD GRILLE SCREEN - REFER TO INTERIOR ELEVATIONS.
- 6 AWC-1 MARKER BOARD PAINT TO BE USED FULL HEIGHT.
- 7 CWC-1 CORK WALLCOVERING TO BE APPLIED 3'0" AFF TO CEILING.
- 8 EXTENTS OF WALL TILE. SEE SHEET ID0202 FOR FLOOR AND WALL PATTERN.
- 9 EXTENTS OF FAP-1 PANELS TO BE MOUNTED ABOVE WALL BASE.
- 10 WALL TO HAVE 3/16" SOUND COUSTIC PADS. PADS TO BE PAINTED SCHEDULED WALL COLOR.
- 11 COMBINATION AWC-1 MARKER BOARD PAINT AND CWC-1 CORK WALLCOVERING WALL TREATMENT. CWC-1 TO BE 4'0" WIDE SECTION ON NORTH SIDE OF WALL / REMAINDER OF WALL TO BE AWC-1. SEE ELEVATIONS ON ID0202 FOR TYPICAL.
- 12 ONE WALL TO RECEIVE AWC-1. LOCATION TO BE DETERMINED AFTER OFFICE LAYOUTS FINALIZED.

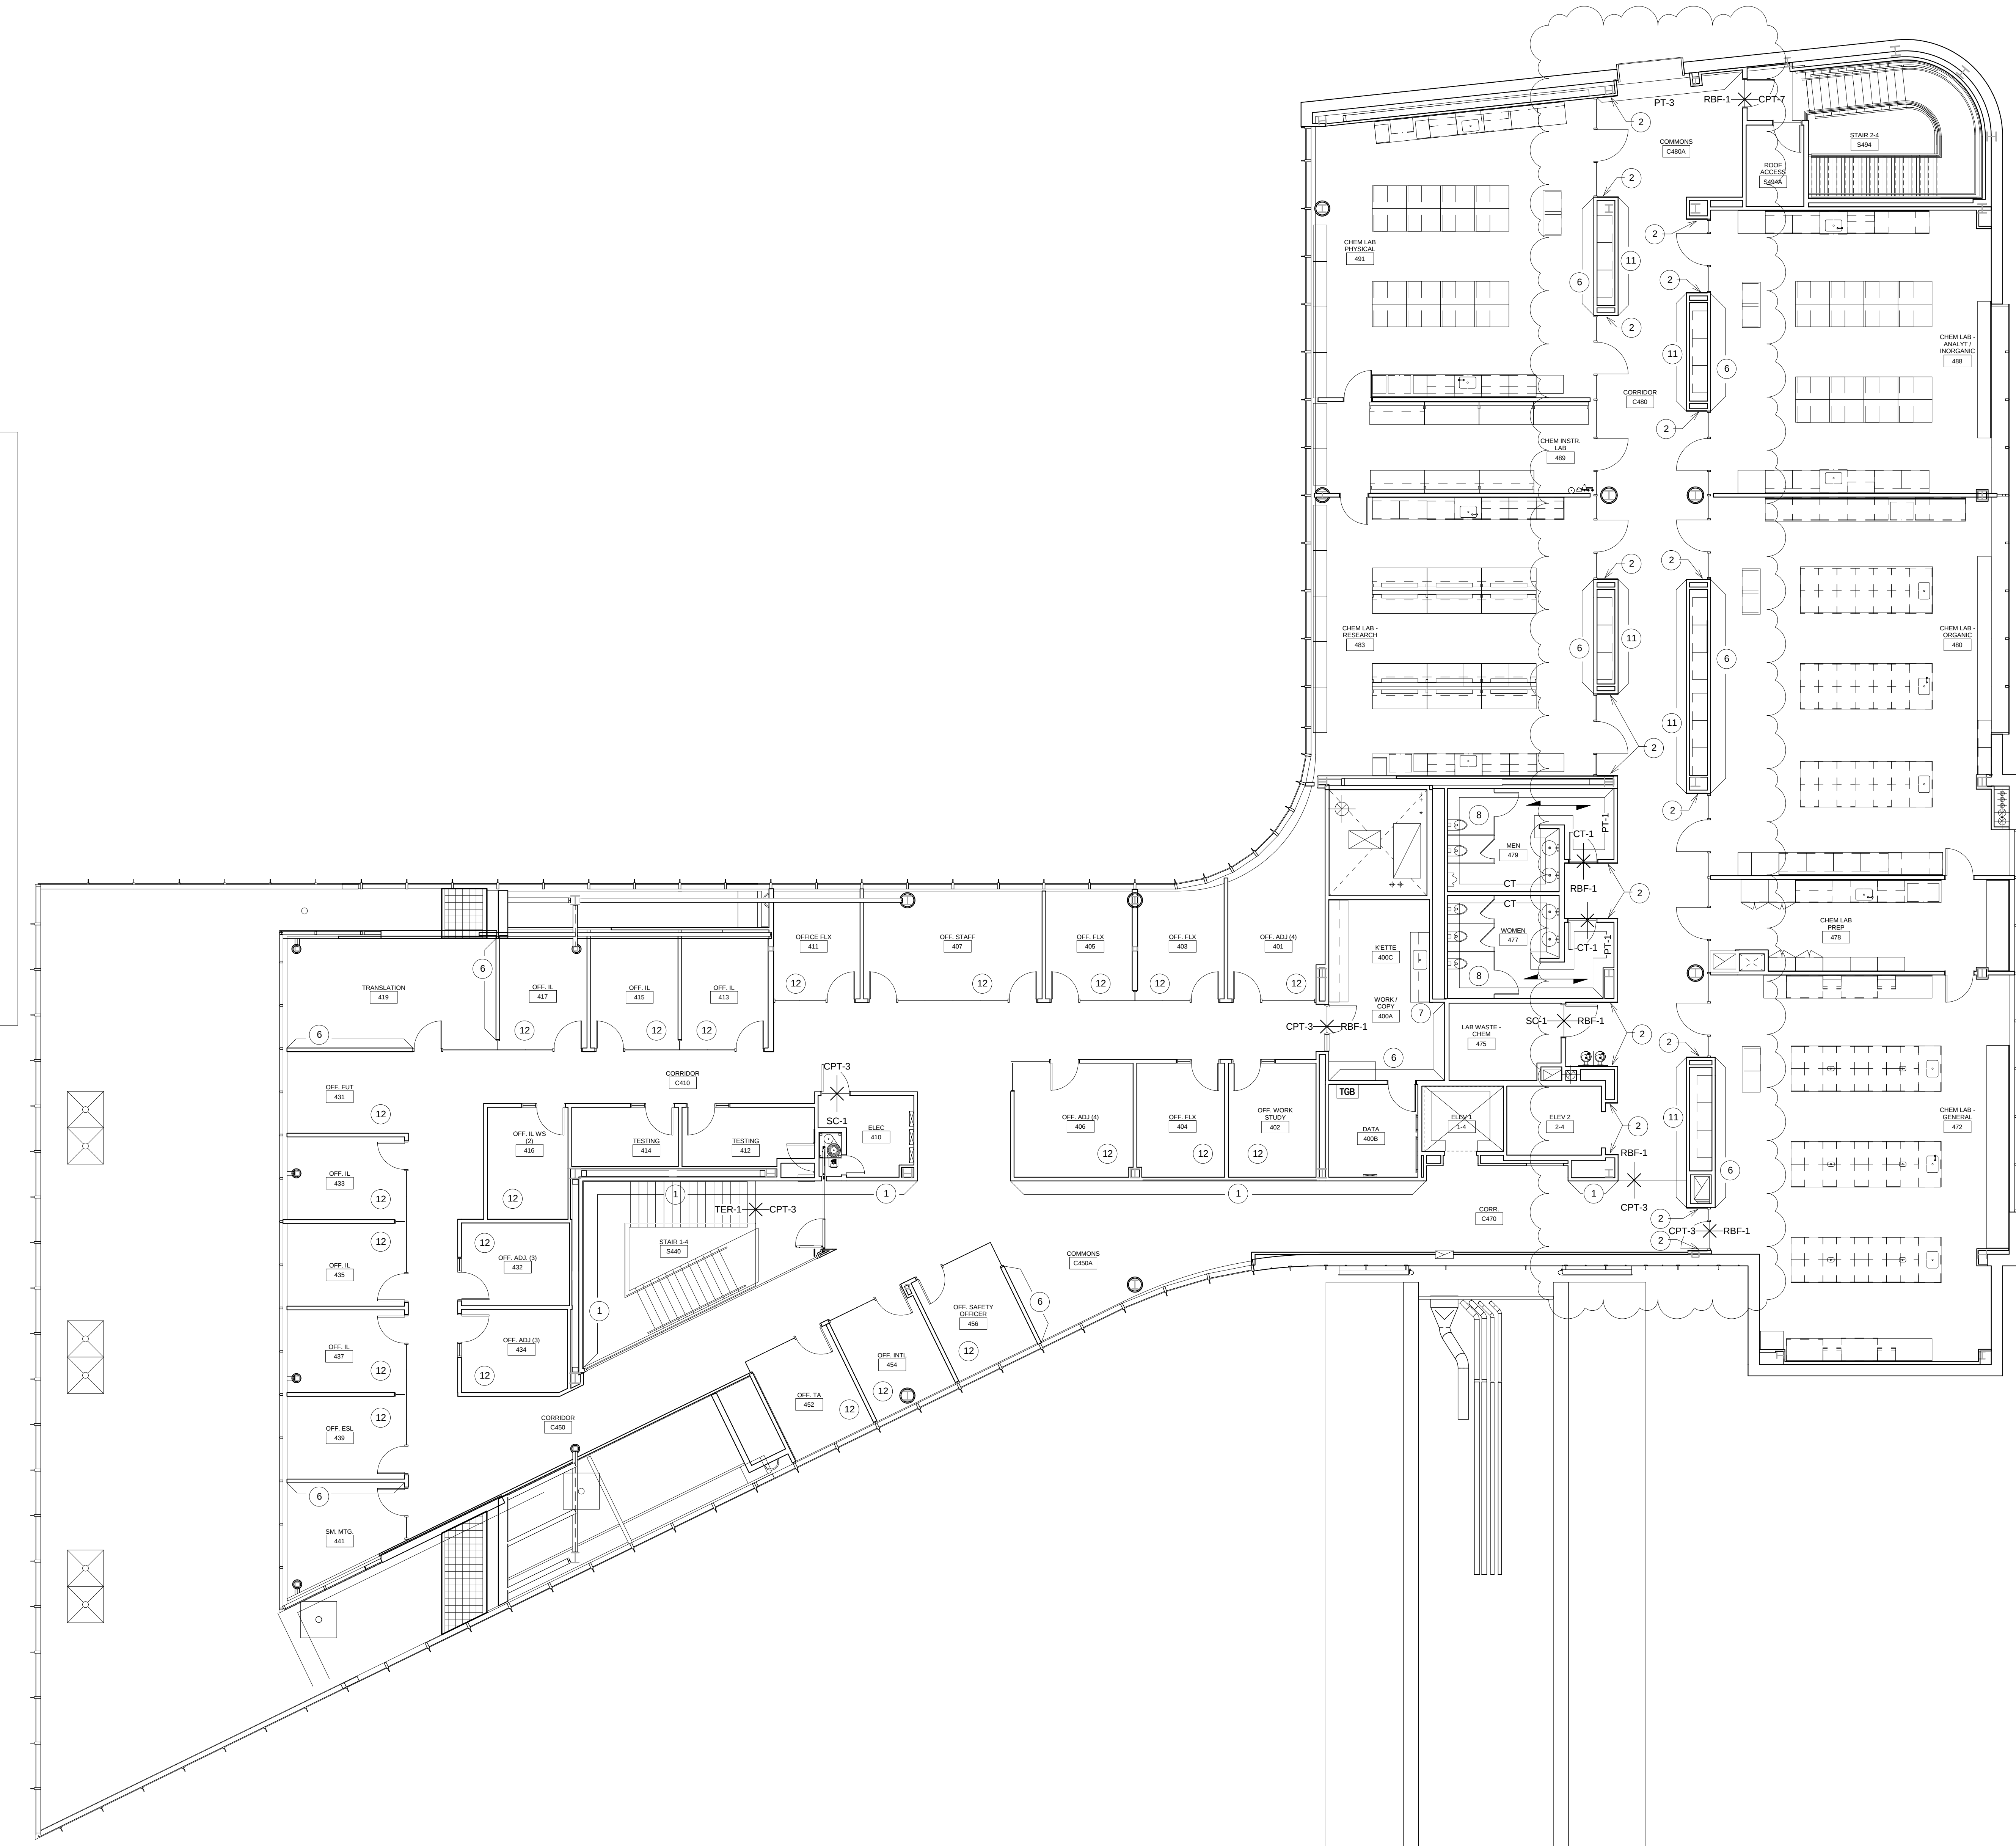

FOURTH FLOOR TRANSITION PLAN
1/8" = 1'-0"

William Tao & Associates, Inc.
MEP/FP Engineer
7955 Manchester Road, Suite 125
St. Louis, MO 63143
314-884-7600

David Mason & Associates, Inc.
Structural & Civil Engineer
800 South Vandeventer Avenue
St. Louis, MO 63110
314.534.1053

Faith Group
Technology
3101 S. Hanley Rd. Suite 100
St. Louis, MO 63143
314.991.2229

Kuhmann Leavitt, Inc.
Environmental Graphics & Signage
7400 Pershing Ave
St. Louis, MO 63130
314.725.6616

KWA Architects
Architecture
9721 Litzinger Road
St. Louis, MO 63124
314.962.2560

Spellman Brady & Company
Interior Designer
8251 Maryland Avenue, Suite 300
St. Louis, MO 63105
314.862.0070

SWT Design
Landscape Architect
7722 Big Bend Blvd
St. Louis, MO 63119
314.644.5700

Webb Engineering Services, Inc.
Plumbing & Fire Protection
1400 S. 3rd Street, Suite 201
St. Louis, MO 63104
314.588.0600

CONFORMED SET

01 JUL 2016

1 ADDENDUM 3-2 15 APR 2016
ISSUED FOR CONSTRUCTION (BP3) 15 MAR 2016
No. Description Date

Drawing Title:

FOURTH FLOOR
TRANSITION PLAN

Project No.: 04561.01 Checked by:

ID0104