


KEYED NOTES: (THIS SHEET ONLY)


- NOT USED.
- FLOOR SINK FOR USE ON LEVEL 3. COORDINATE INSTALLATION WITH THE GENERAL CONTRACTOR FOR THE FLOOR OPENING.
- PIPING IN EACH ROOM TO BE RUN AS HIGH AS POSSIBLE TO AVOID CONFLICTS. COORDINATE INSTALLATION AND ROUTING WITH OTHER TRADES PRIOR TO ROUGH-IN.
- 1/2" CW, 1/2" HW AND 2" VENT DOWN IN WALL TO SERVE FIXTURE.
- BREAKROOM SINKS ARE TO BE SERVED FROM WATER, WASTE AND VENT PIPING IN TOILET ROOM CHASE.
- PROVIDE SHUT-OFF VALVES AT THE ENTRY TO EACH ROOM.
- EMERGENCY SHOWER TO BE SERVED WITH FIELD FURNISHED AND INSTALLED 1" TEMPERED WATER TO SHOWER HEAD FROM WALL RECESSED CABINET. EYEWASH PORTION OF ASSEMBLY TO 2" WASTE AND 2" VENT. TYPICAL FOR ALL INSTALLATIONS. REFER TO DRAWING P0403, DETAIL 3.
- DECK MOUNTED EMERGENCY EYEWASH TO BE LOCATED AT SINK. INSTALL THERMOSTATIC MIXING VALVE IN CABINET SPACE BELOW THE SINK. COORDINATE MOUNTING REQUIREMENTS OF EYEWASH AND TMV WITH THE GENERAL CONTRACTOR. TYPICAL FOR ALL INSTALLATION. REFER TO DRAWING P0403, DETAIL 4.
- DROP PIPING DOWN TO BELOW STRUCTURAL STEEL MEMBER. HOLD TIGHT TO BOTTOM OF STEEL.
- PIPING IN CORRIDOR TO BE RUN AT BOTTOM OF STRUCTURAL STEEL CROSS MEMBERS. COORDINATE INSTALLATION AND ROUTING WITH OTHER TRADES PRIOR TO ROUGH-IN.
- 4" SANITARY VENT RISER UP TO SERVE WATER CLOSETS, URINALS AND FLOOR DRAINS ON EACH LEVEL.
- 4" SANITARY WASTE RISER UP TO SERVE WATER CLOSETS, URINALS AND FLOOR DRAINS ON EACH LEVEL.
- 2" SANITARY WASTE RISER UP TO SERVE LAVATORIES ON EACH LEVEL.
- 2" SANITARY VENT UP TO SERVE LAVATORIES ON EACH LEVEL.
- FLOOR SINK UNDER COUNTERTOP WITH IN CASEWORK. VERIFY LOCATION WITH EXACT EQUIPMENT PLACEMENT PRIOR TO ROUGH-IN. COORDINATE FLOOR OPENING WITH THE GENERAL CONTRACTOR.
- HOT WATER RETURN CIRCUIT SETTER VALVE. LOCATE IN AN ACCESSIBLE LOCATION ABOVE THE CEILING. REFER TO DRAWING P0502, DETAIL 11/P0502.
- COORDINATE AND VERIFY LOCATION OF DOWNSPOUT NOZZLE AND WALL SLEEVE PRIOR TO ROUGH-IN.
- REFER TO DRAWING P0405 WASTE SUPPLY, RISER 6.
- REFER TO DRAWING P0407 WATER SUPPLY, RISER 3.
- REFER TO DRAWING P0405 WATER SUPPLY, RISER 2.
- REFER TO DRAWING P0407 WATER SUPPLY, RISER 4.
- REFER TO DRAWING P0407 WATER SUPPLY, RISER 3.
- 1/2" HW DOWN IN WALL TO SERVE UNDERCOUNTER GLASS WASHER. VERIFY CONNECTION POINT AND LOCATION. PROVIDE ALL FITTINGS AS REQUIRED.
- 1/2" CW AND 1/2" HW DOWN IN WALL TO SERVE CLASS 1 BIOLOGICAL CABINET. VERIFY CONNECTION POINT AND LOCATION. PROVIDE ALL FITTINGS AS REQUIRED.

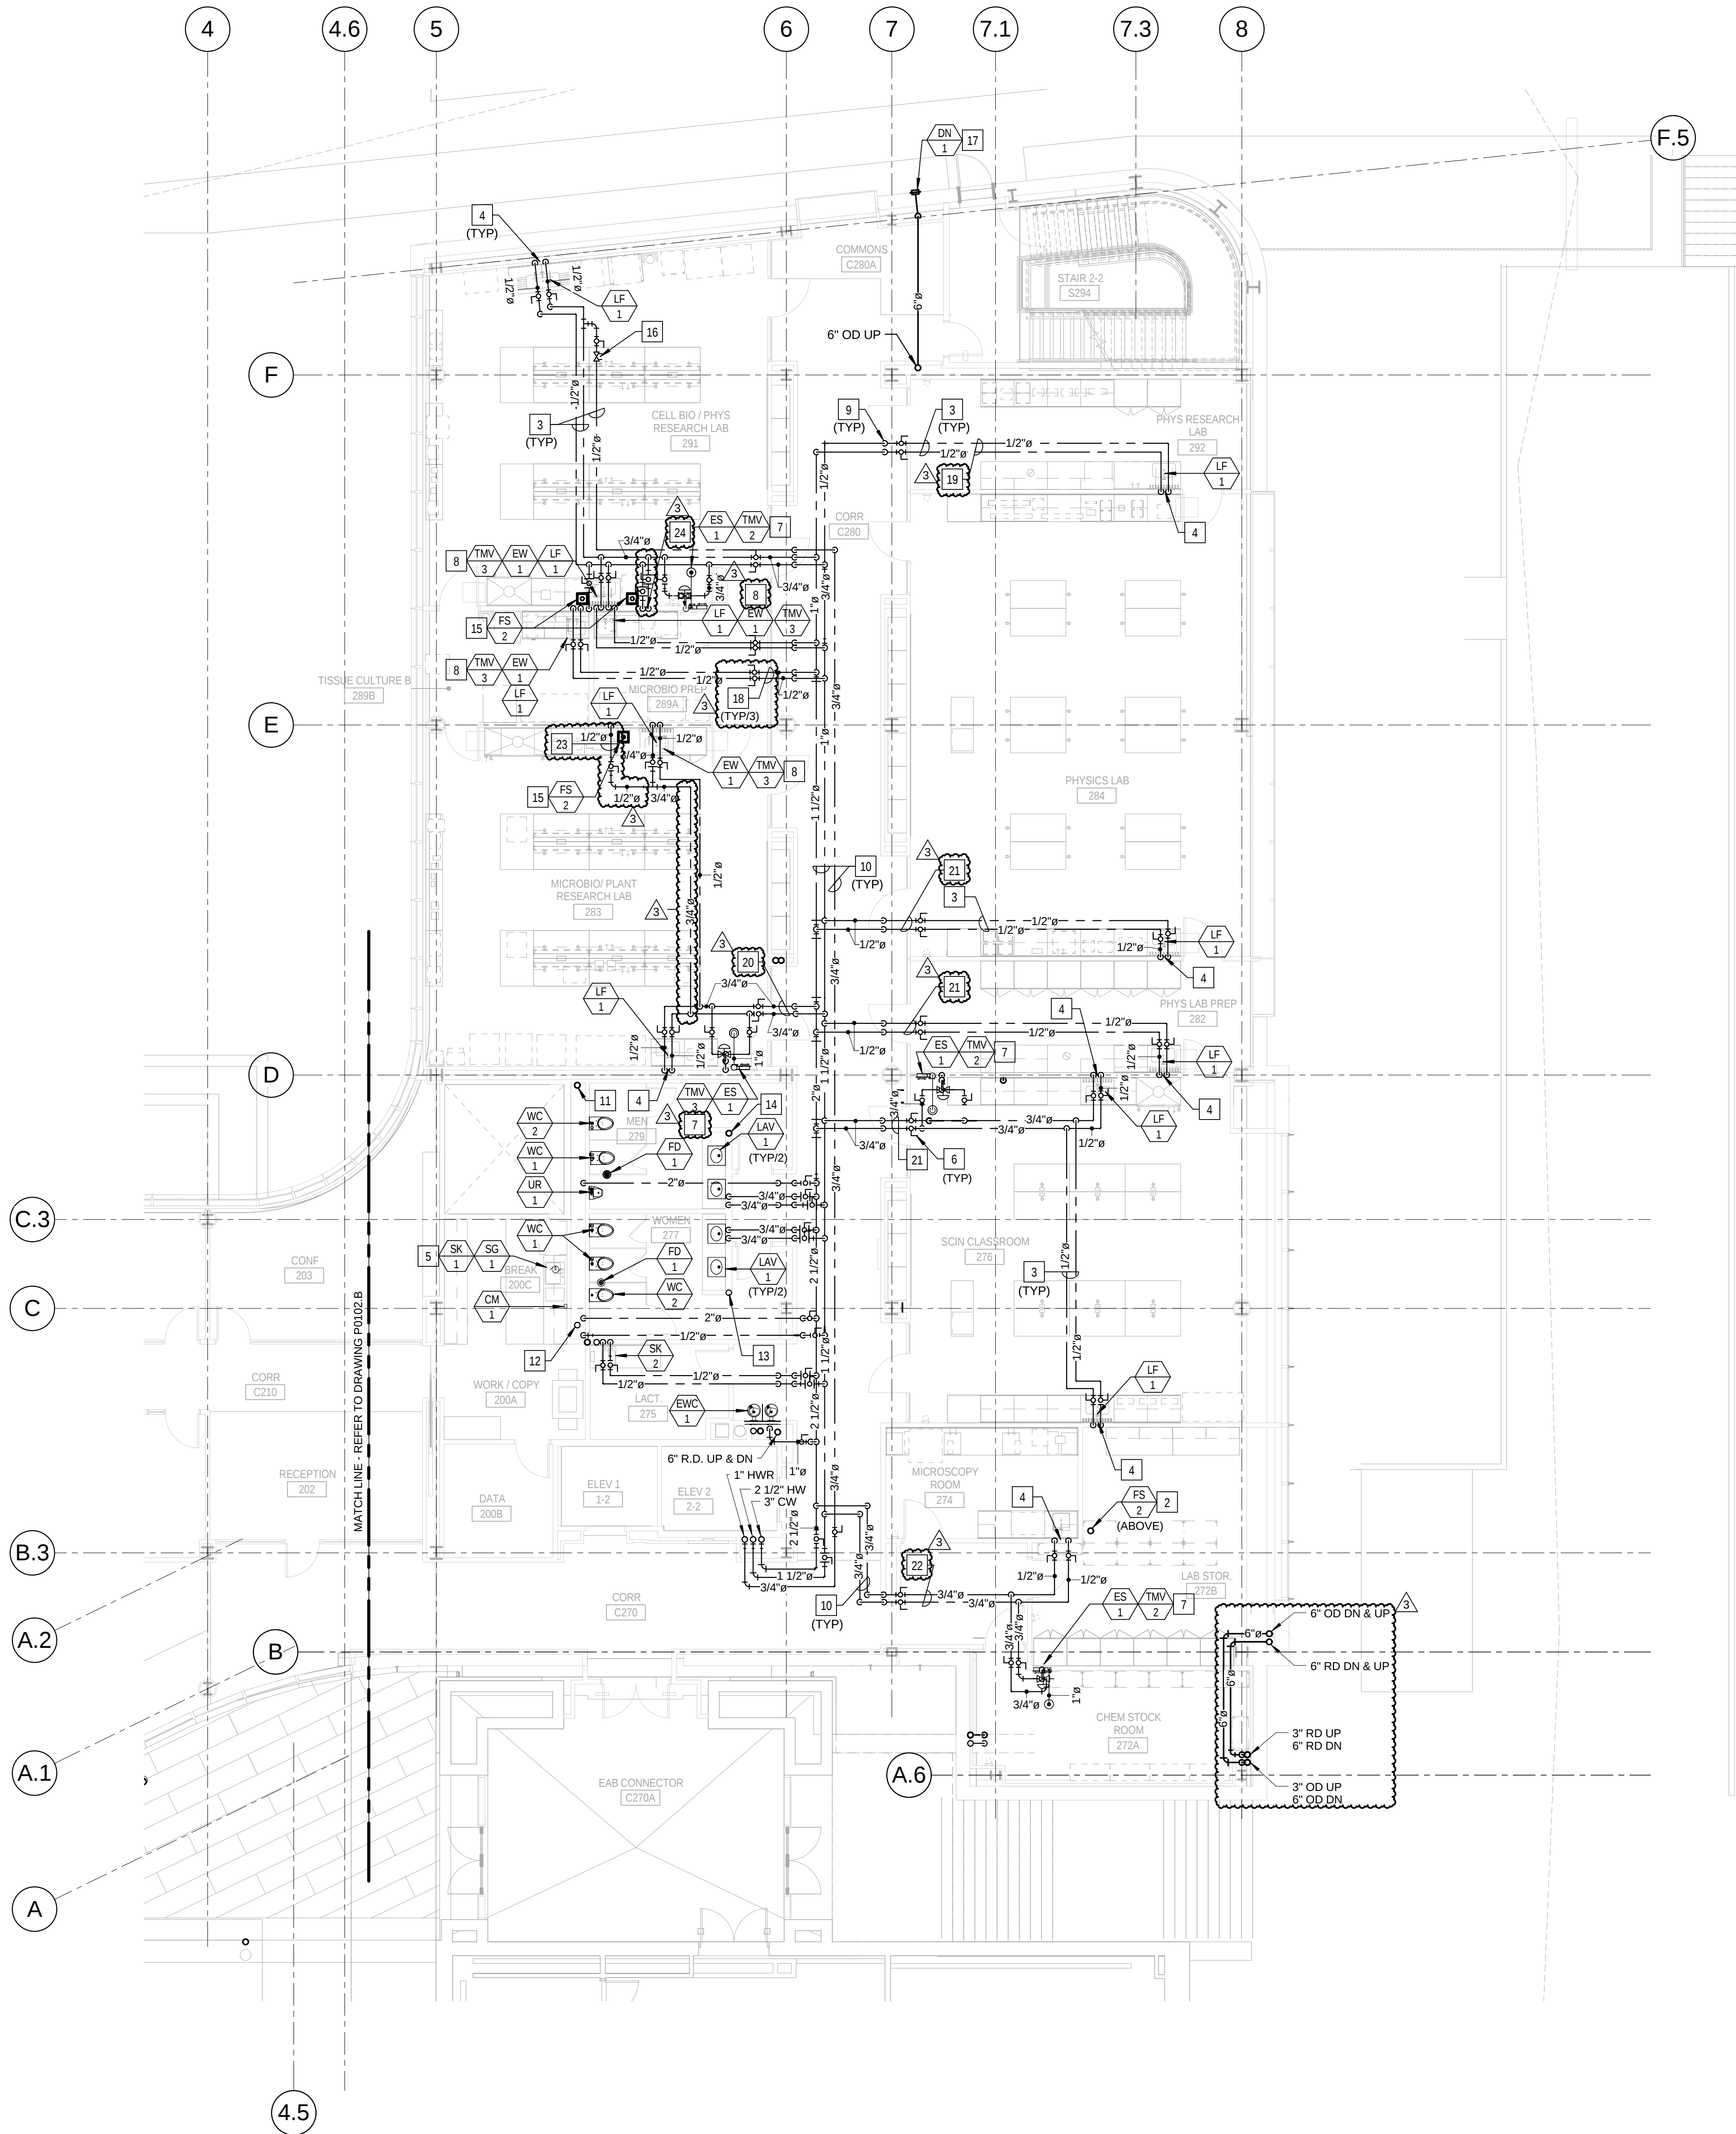

1 LEVEL 02 AREA A FLOOR PLAN - PLUMBING
1/8" = 1'-0"

CONFORMED SET 01 JUL 2016

3	ADDENDUM 2-4	24 MAY 2016
2	ADDENDUM 2-2	19 APR 2016
1	ADDENDUM 2-1	17 MAR 2016
-	ISSUED FOR CONSTRUCTION (BP2)	01 MAR 2016

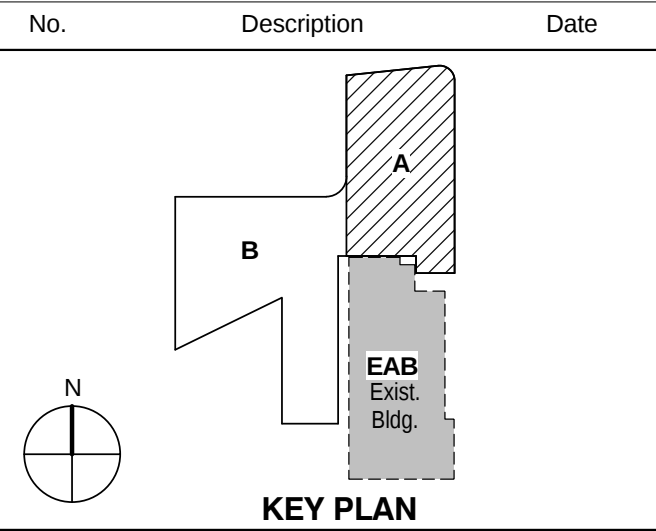

Drawing Title:

LEVEL 02 AREA A FLOOR
PLAN - PLUMBING

Project No.: 04561.01 Checked by:

P0102.A