


CONFORMED SET 01 JUL 2016

3 ADDENDUM 2-4 24 MAY 2015
2 ADDENDUM 2-2 19 APR 2016
1 ADDENDUM 2-1 17 MAR 2016
- ISSUED FOR CONSTRUCTION (BP2) 01 MAR 2016

No.	Description	Date
-----	-------------	------

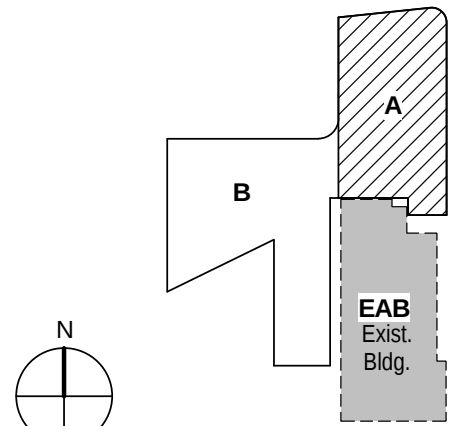


KEY PLAN

Drawing Title:

LEVEL 03 AREA A FLOOR
PLAN - PLUMBING

Project No.: 04561.01 Checked by:

P0103.A

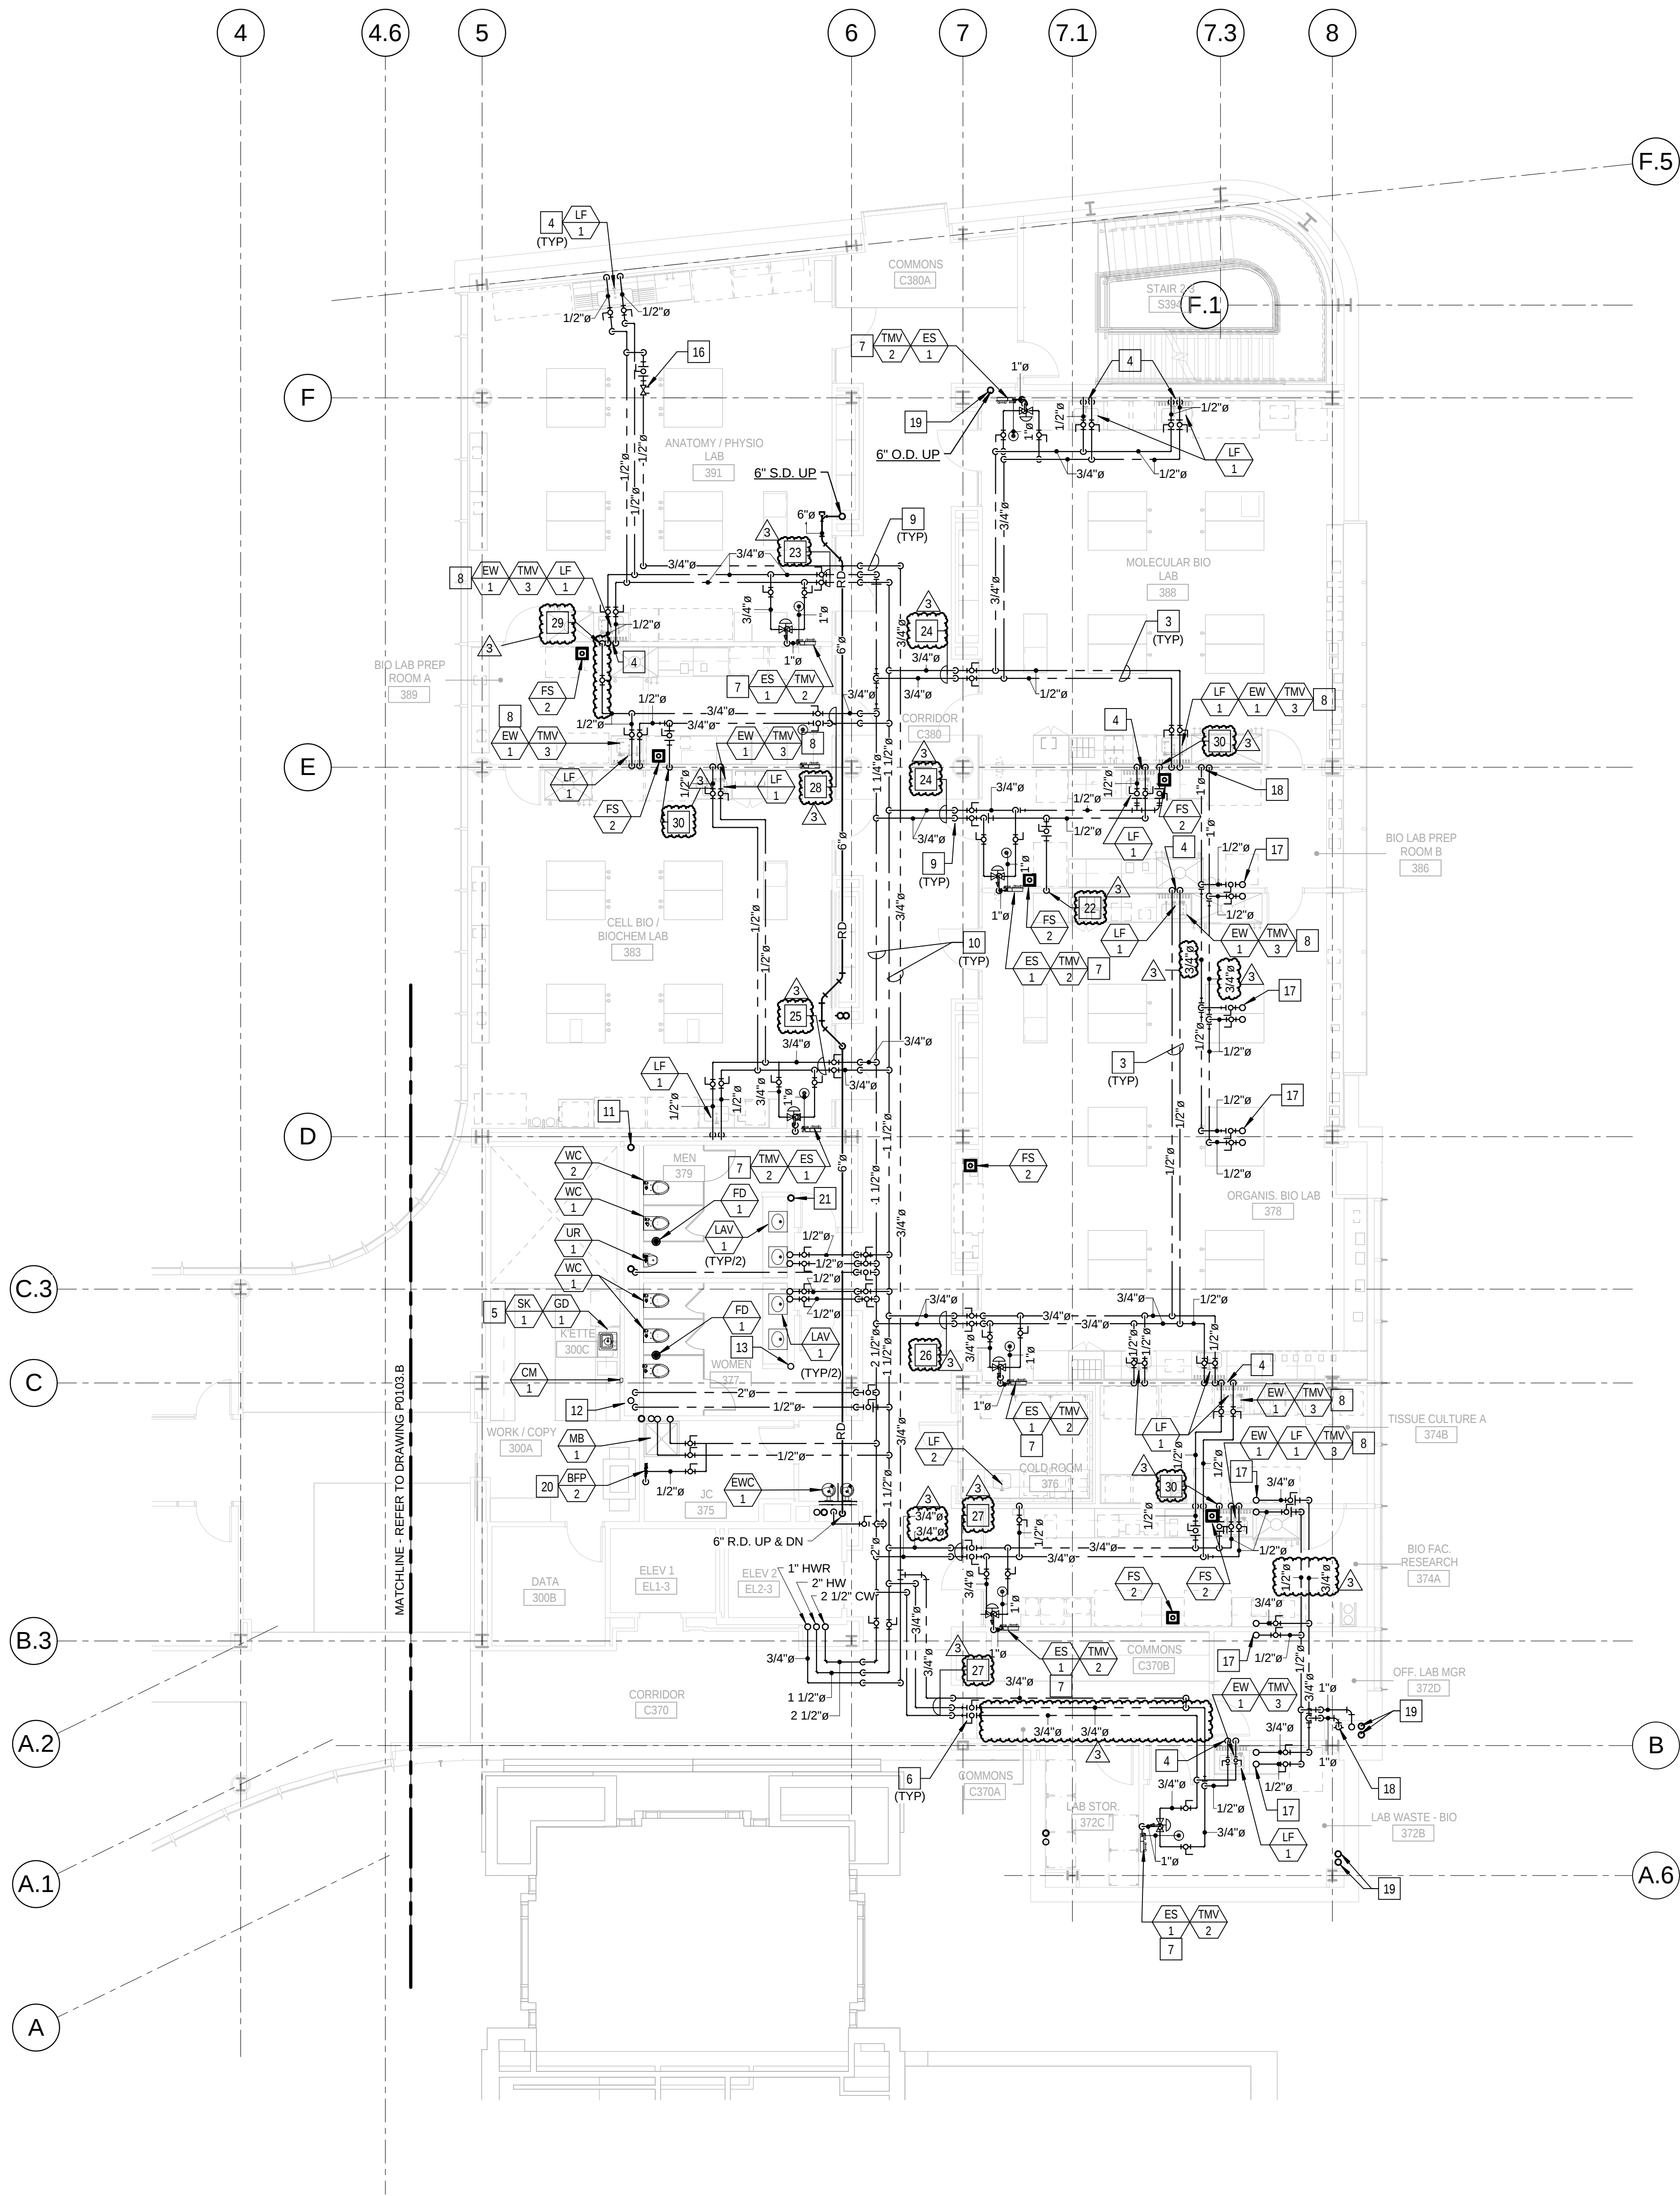

1 LEVEL 03 AREA A FLOOR PLAN - PLUMBING
1/8" = 1'-0"