


CONFORMED SET

01 JUL 2016

1	ADDENDUM 2-1	17 MAR 2016
1	ISSUED FOR CONSTRUCTION (BP2)	01 MAR 2016
No.	Description	Date

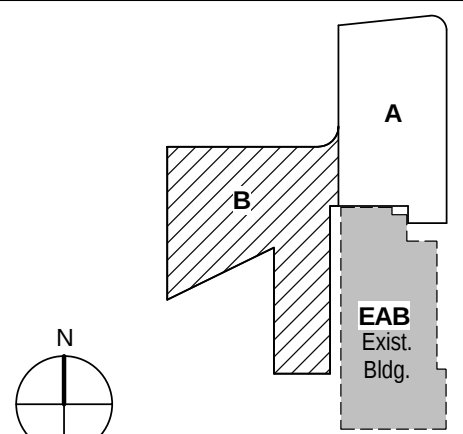

KEY PLAN


Drawing Title:

LEVEL 04 AREA B FLOOR
PLAN - PLUMBING

Project No.: 04561.01

Checked by:

P0104.B

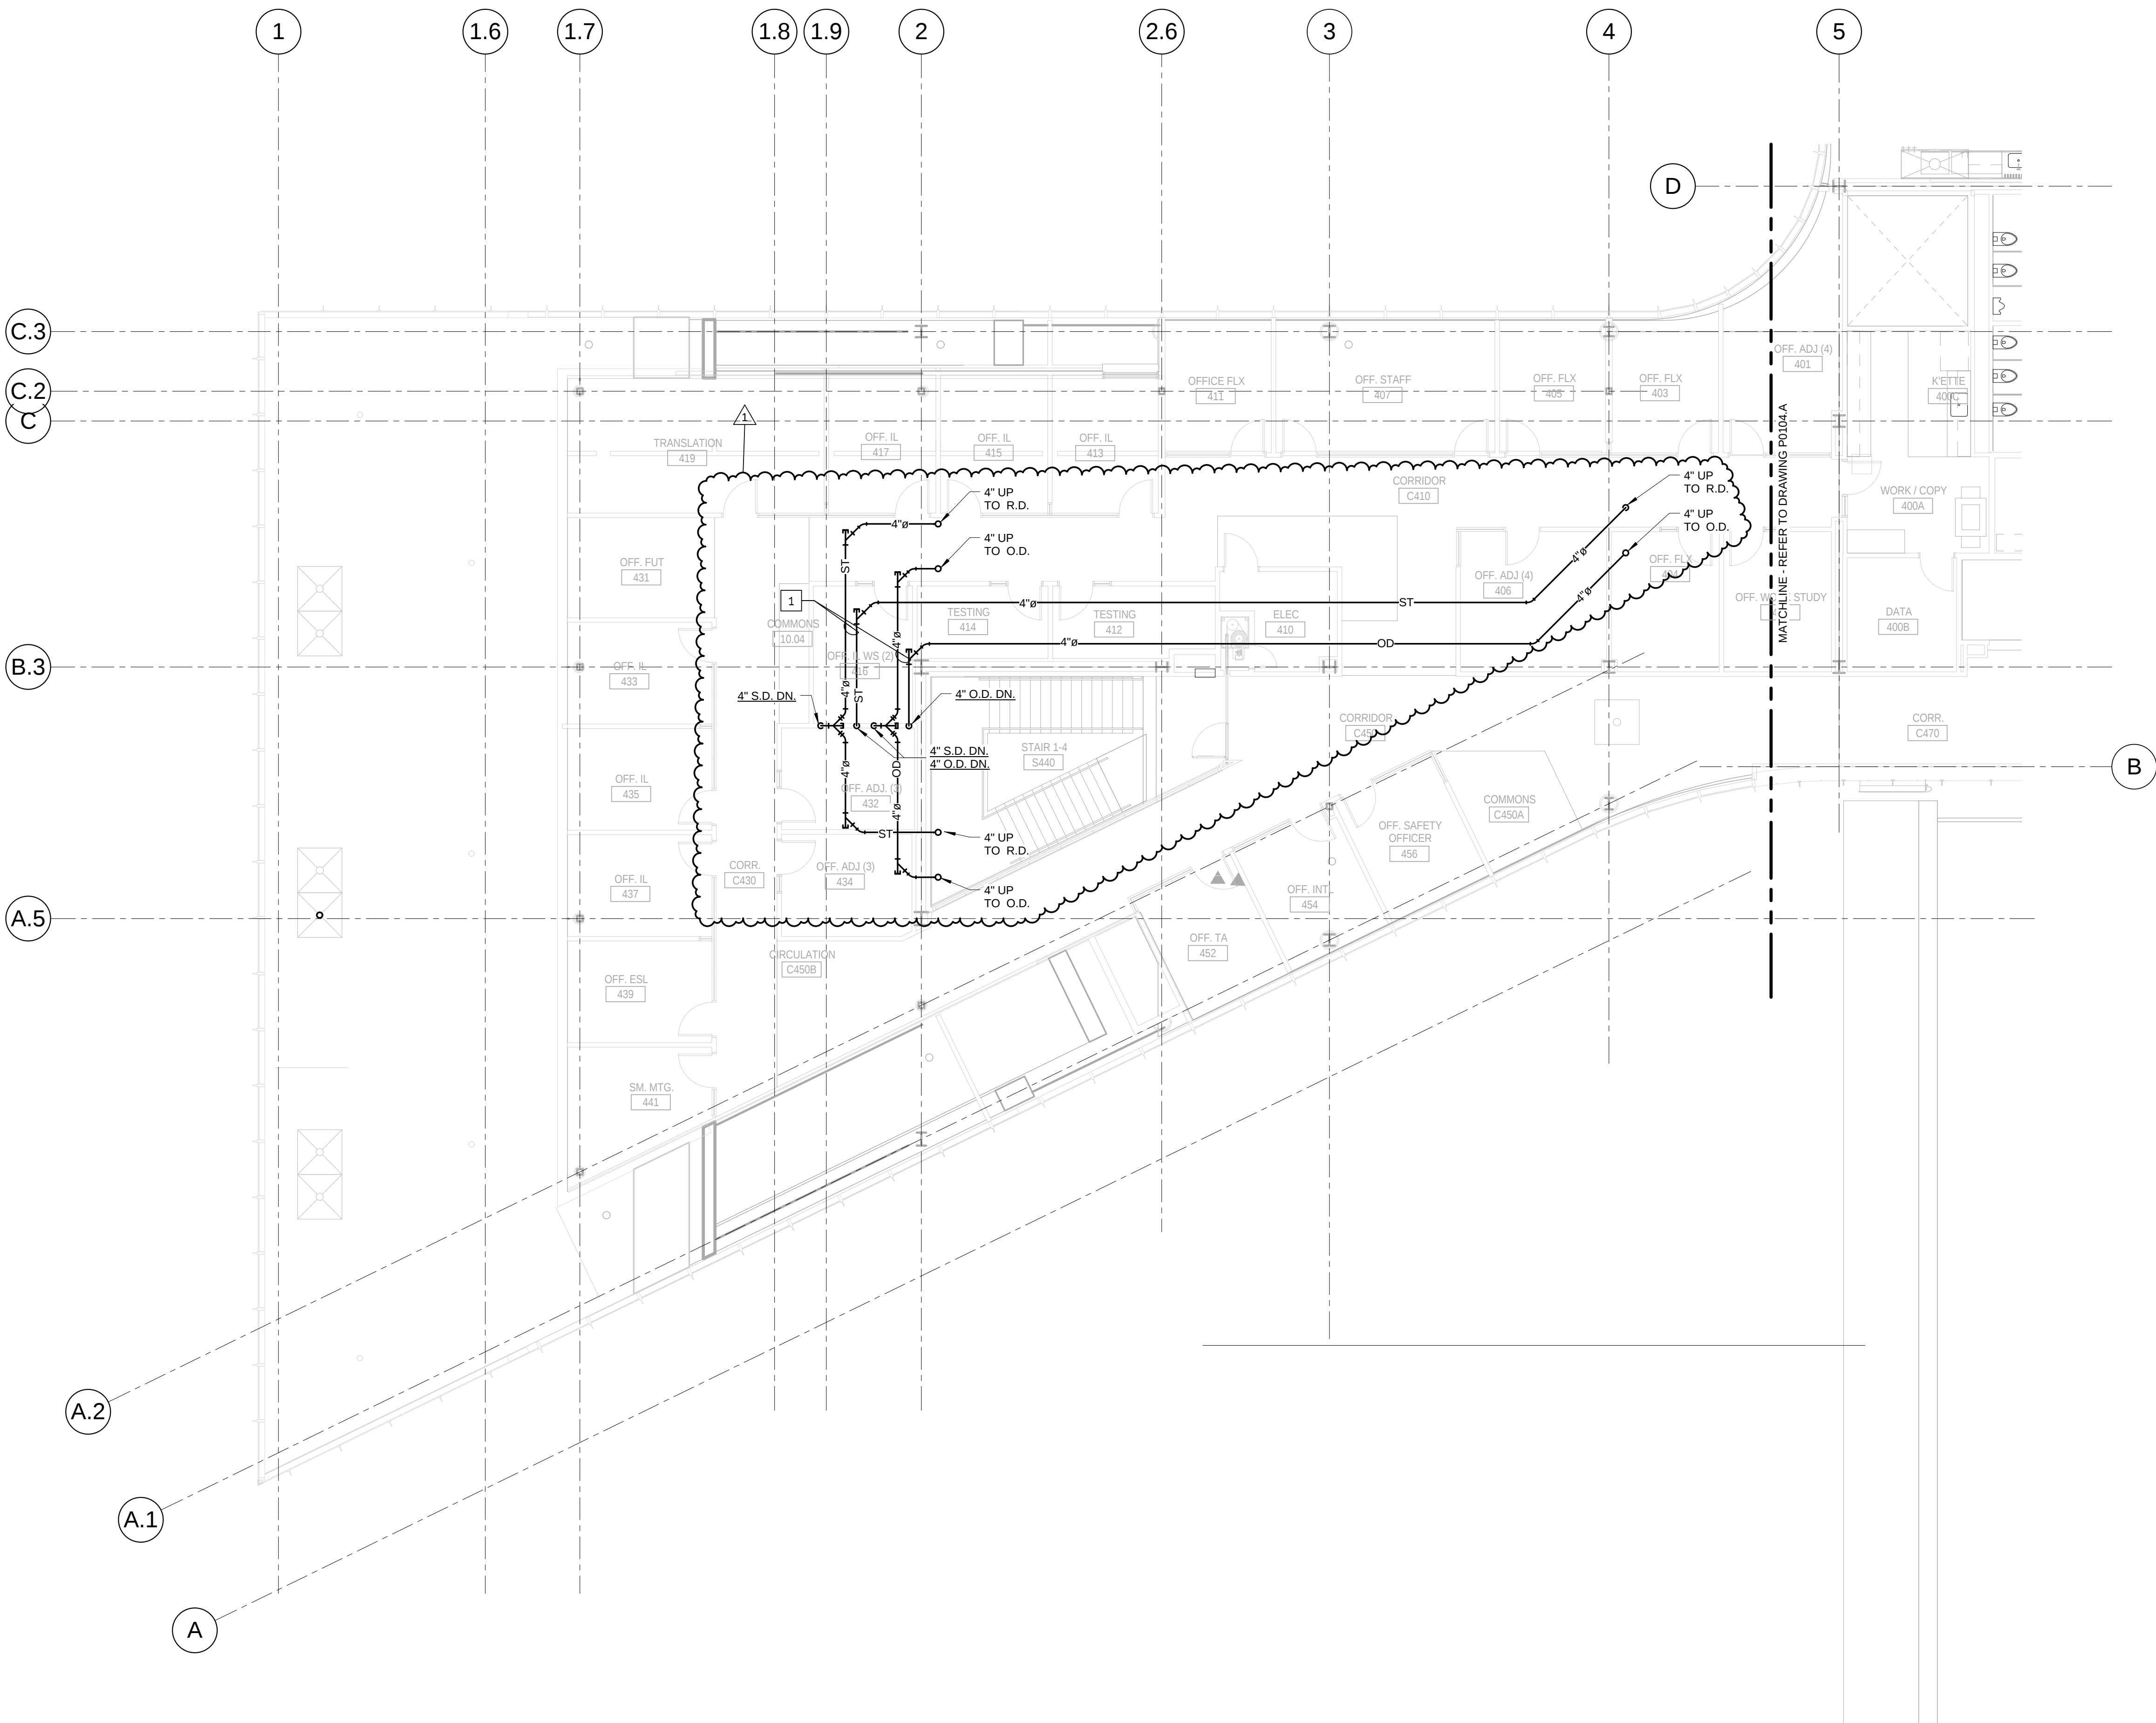

KEYED NOTES: (THIS SHEET ONLY)

- 1 INSTALL PIPING AS HIGH AS POSSIBLE. COORDINATE EXACT ROUTING AND LOCATION WITH ALL CONSTRUCTION TRADES PRIOR TO INSTALLATION.

1 LEVEL 04 AREA B FLOOR PLAN - PLUMBING
1/8" = 1'-0"