


CONFORMED SET 01 JUL 2016


1	ADDENDUM 2-2	19 APR 2016
1	ISSUED FOR CONSTRUCTION (BP2)	01 MAR 2016
No.	Description	Date

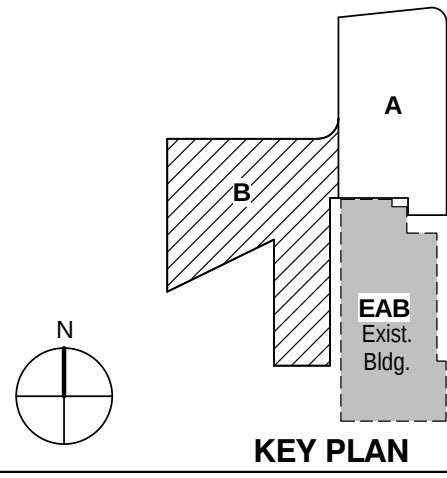

LEVEL 05 ROOF PLAN
AREA B - PLUMBING

Project No.: 04561.01 Checked by:

P0105.B

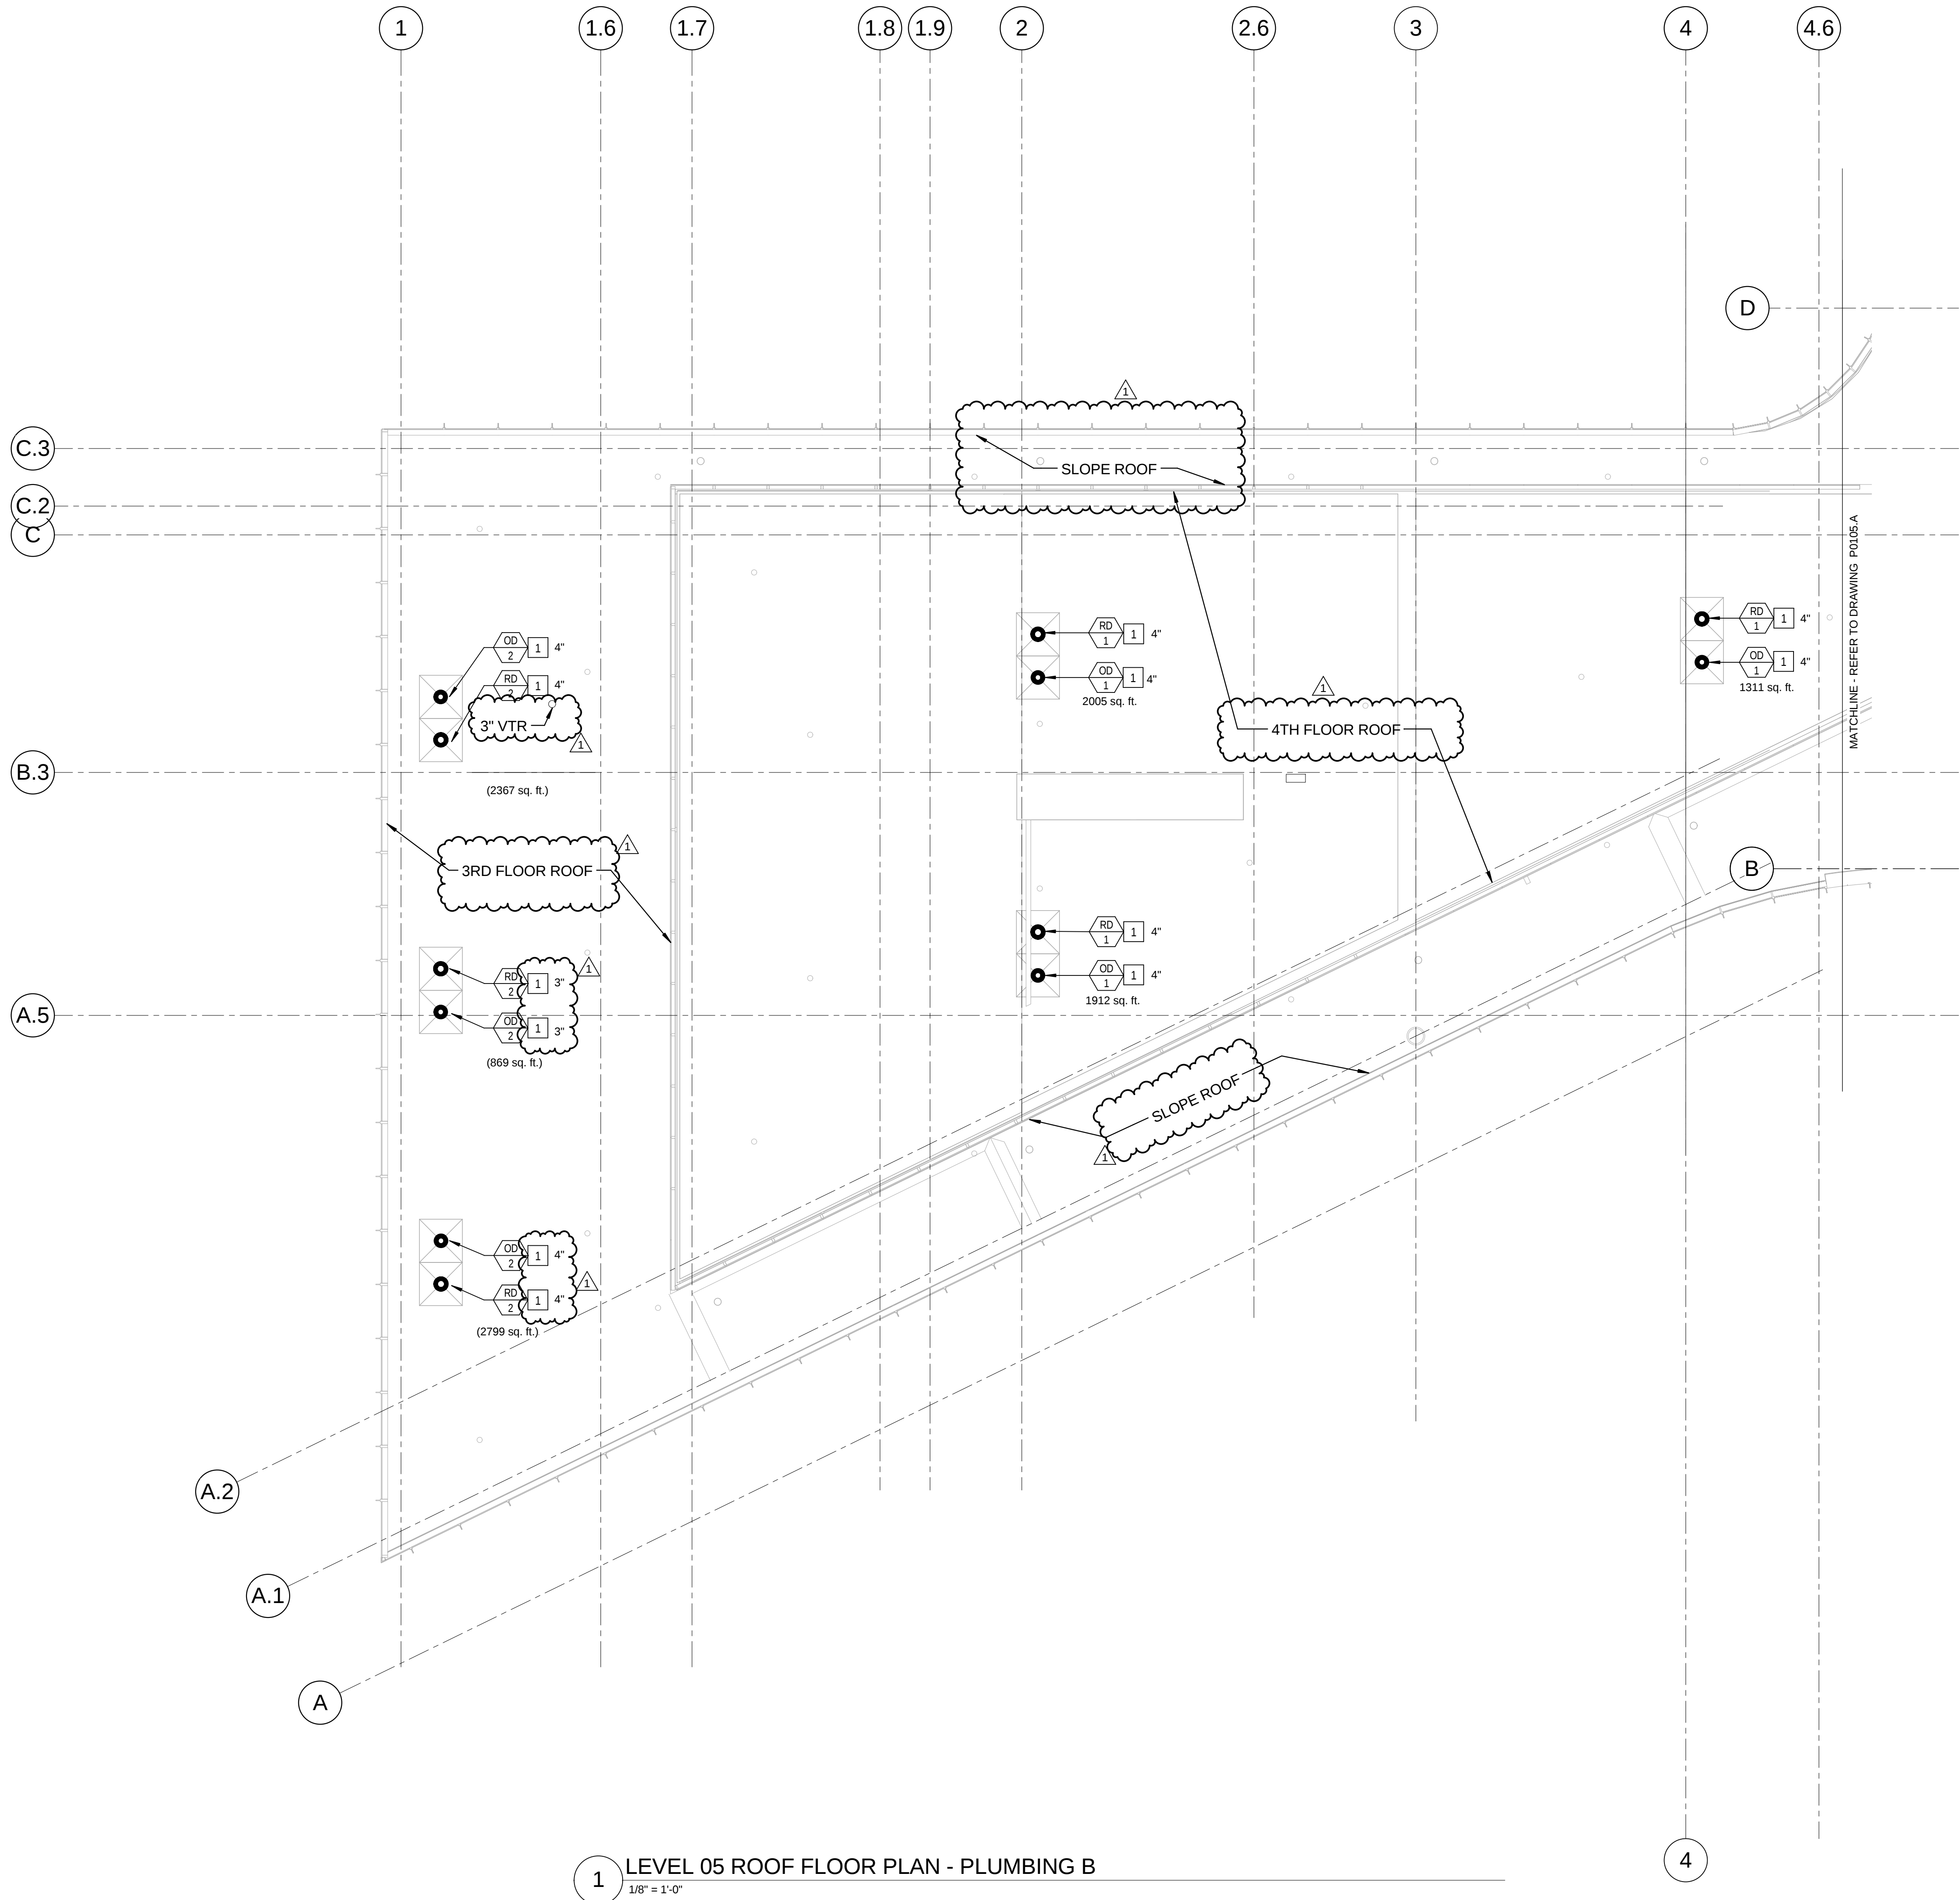

NOTE - PLUMBING NEW WORK

- CONTRACTOR SHALL FURNISH AND INSTALL ROOF DRAINS AND OVERFLOW DRAINS. REFER TO DETAIL ON DRAWING P0501.