


KEYED NOTES: (THIS SHEET ONLY)


- 3" SANITARY WASTE AND 3" SANITARY VENT RISERS.
- 3" SANITARY WASTE AND 3" SANITARY VENT DOWN FROM LEVEL 3. OFF-SET ABOVE THE CEILING TO CONTINUE DOWN.
- 4" SANITARY VENT RISER UP AND DOWN.
- 4" SANITARY WASTE UP AND DOWN. REFER TO DRAWING P0401 FOR RISER DIAGRAMS.
- 2" SANITARY WASTE UP AND DOWN. REFER TO DRAWING P0401 FOR RISER DIAGRAMS.
- 2" SANITARY VENT UP AND DOWN.
- 2" SANITARY VENT DOWN IN WALL TO SERVE LABORATORY SINK.
- 2" SANITARY VENT DOWN IN WALL TO SERVE EMERGENCY SHOWER.
- 2" SANITARY WASTE UP TO LEVEL 3 LAB SINK.
- 2" SANITARY WASTE UP TO LEVEL 3 EMERGENCY SHOWER EYE/FACE WASH STATION. REFER TO DRAWING P0403, DETAIL 3.
- FLOOR SINK TO BE LOCATED BELOW THE CASEWORK TO ACCEPT DISCHARGE FROM THE LAB EQUIPMENT. COORDINATE LOCATION WITH CASEWORK.
- 2" SANITARY VENT UP TO LEVEL 3, ALIGN WITH CASEWORK AND WALL ABOVE. REFER TO DRAWING P0403, DETAIL 3.
- FLOOR SINK SET TO SERVE LEVEL 3. COORDINATE LOCATION OF FLOOR SINK WITH CASEWORK ABOVE AND WITH ABOVE CEILING CONDITIONS ON THIS LEVEL.
- NOT USED.
- PIPING IN EACH ROOM TO BE RUN AS HIGH AS POSSIBLE TO AVOID CONFLICTS. COORDINATE INSTALLATION AND ROUTING WITH OTHER TRADES PRIOR TO ROUGH-IN.
- 2" SANITARY WASTE AND 2" SANITARY VENT RISERS TO SERVE ELECTRIC WATER COOLERS ON EACH LEVEL. REFER TO DRAWING P0401 FOR WASTE AND VENT RISER.
- 3" SANITARY WASTE AND 2" VENT RISERS TO SERVE MOP BASINS ON LEVELS 1 AND 3 AND COUNTERTOP SINK ON LEVEL 2. REFER TO DRAWING P0401 FOR WASTE AND VENT RISER.
- 3" SANITARY WASTE AND 3" SANITARY VENT DOWN.
- REFER TO DRAWING P0404 SANITARY WASTE AND VENT RISER DIAGRAM 1-2.
- REFER TO DRAWING P0406 SANITARY WASTE AND VENT RISER DIAGRAM 3-1.
- REFER TO DRAWING P0404 SANITARY WASTE AND VENT RISER DIAGRAM 2-3.
- REFER TO DRAWING P0408 SANITARY WASTE AND VENT RISER DIAGRAM 4-2.
- REFER TO DRAWING P0408 SANITARY WASTE AND VENT RISER DIAGRAM 5-2.

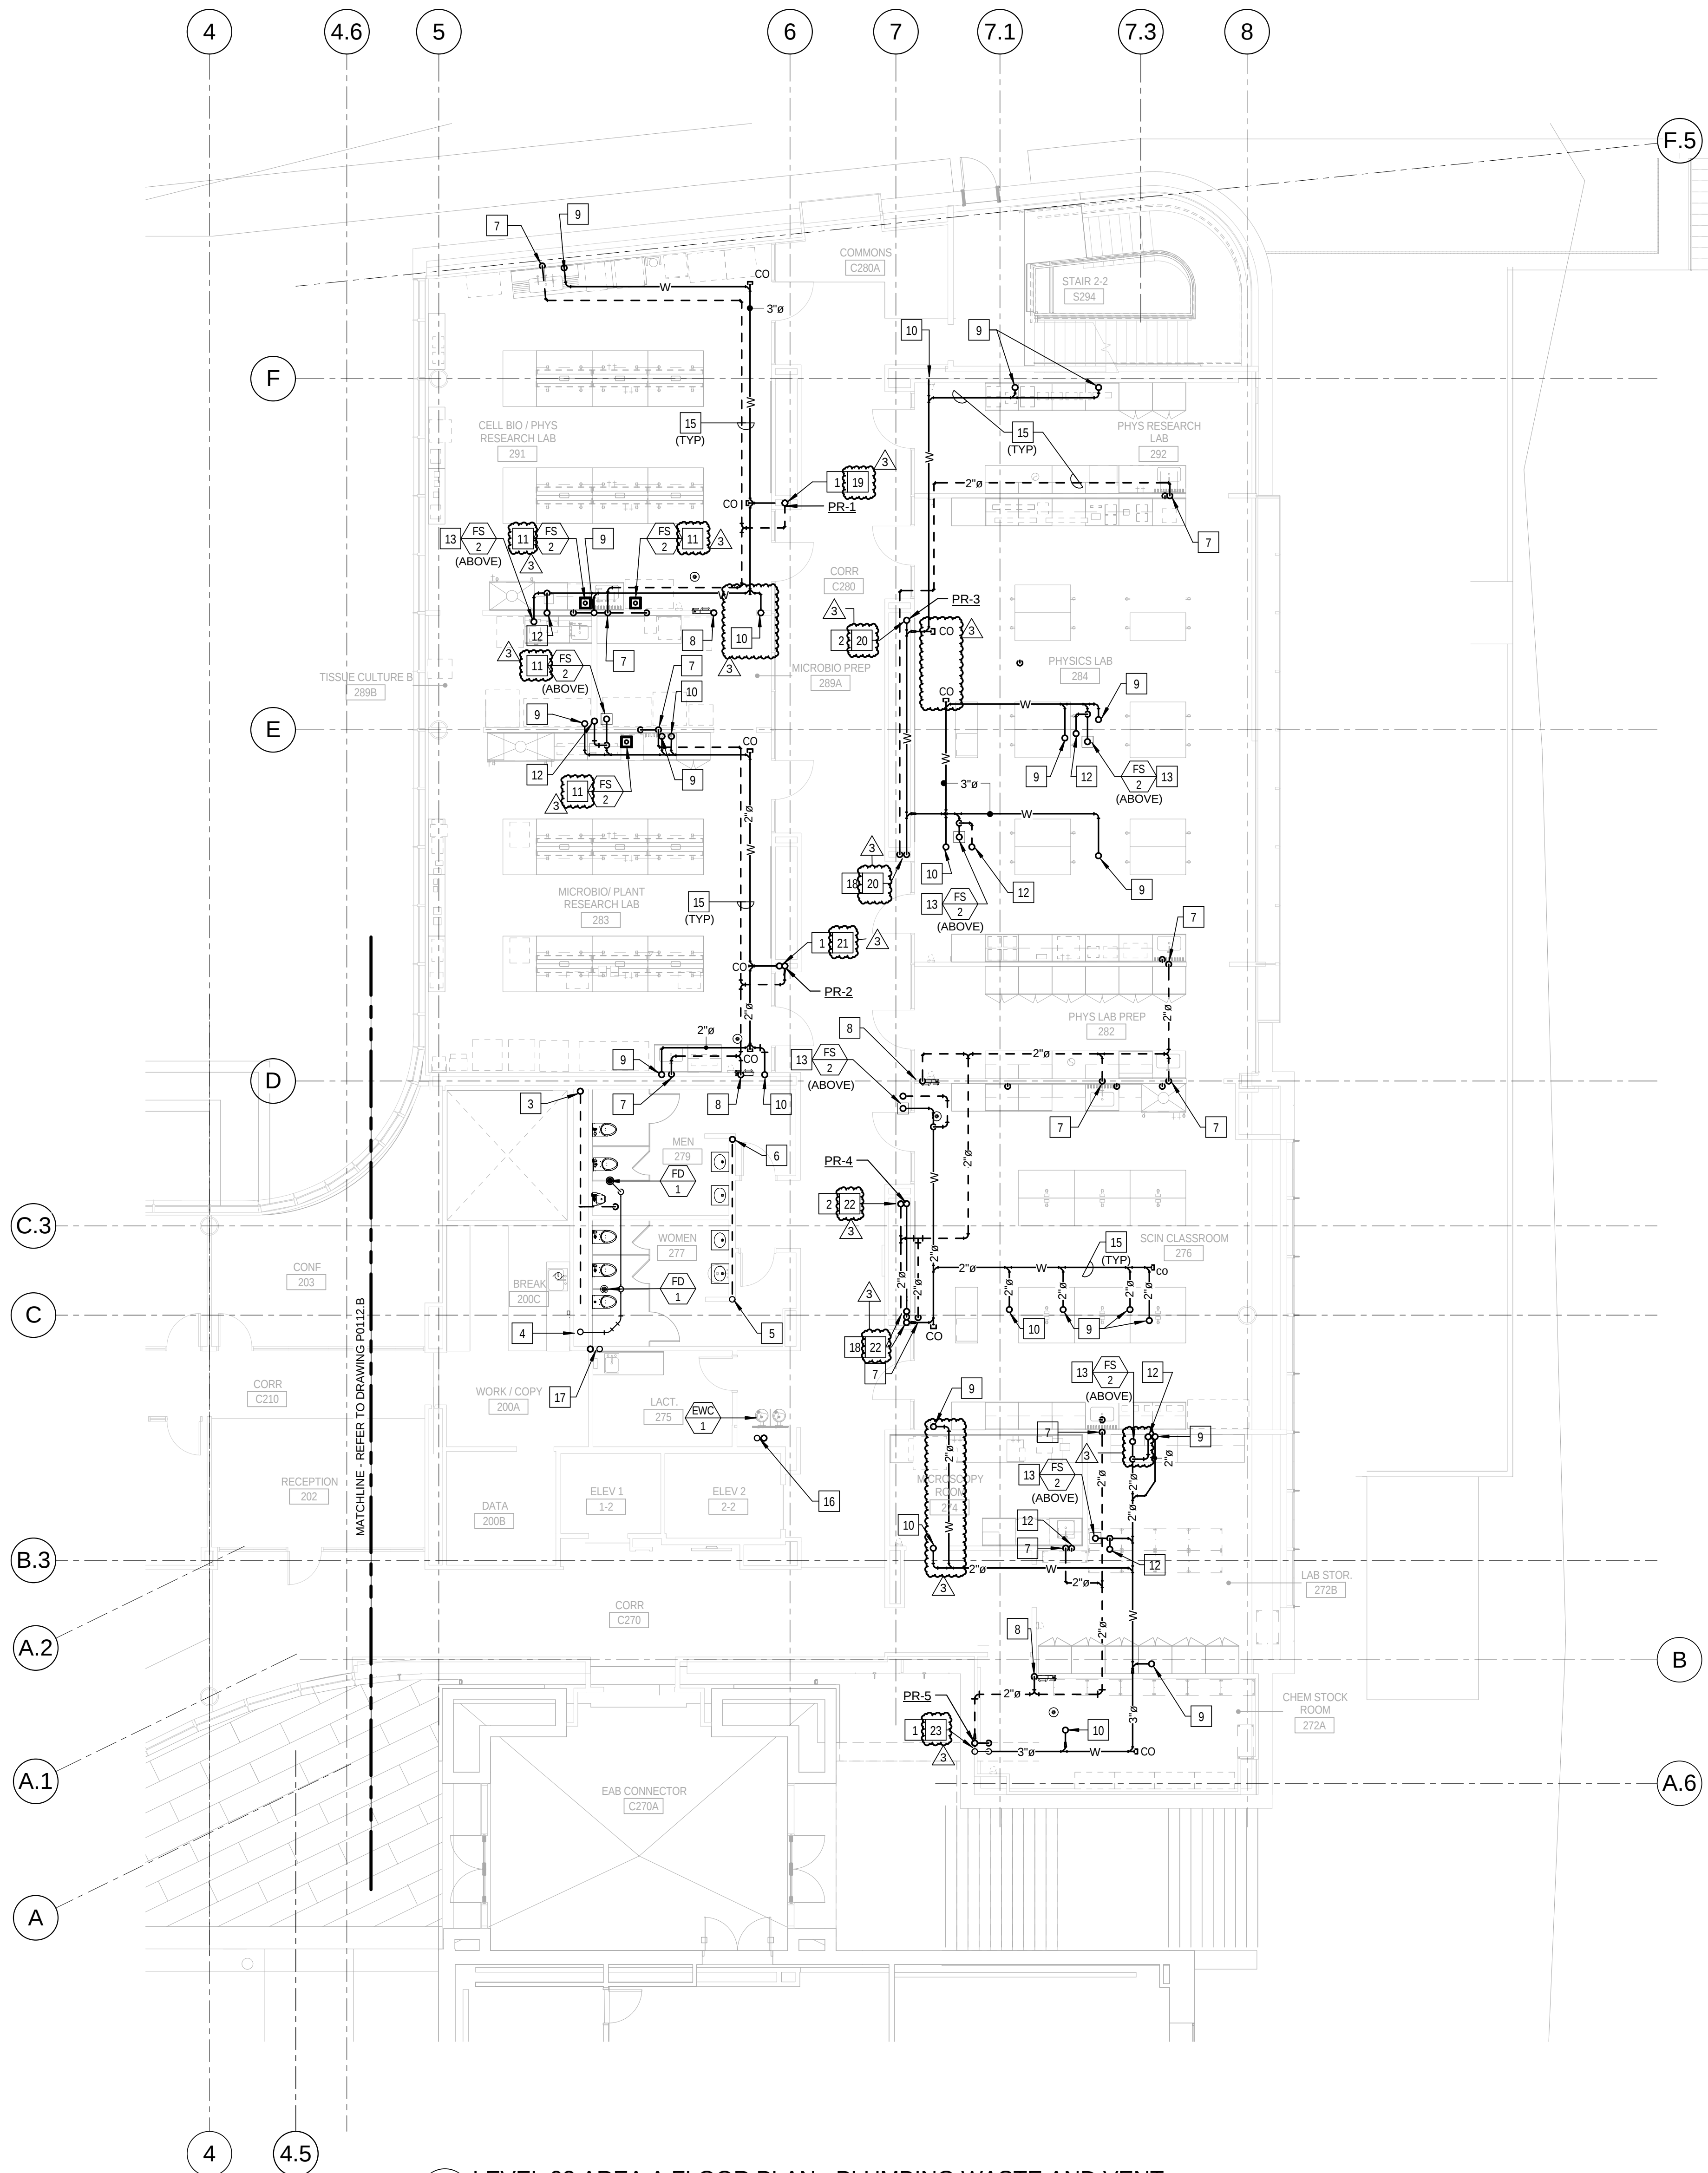

1 LEVEL 02 AREA A FLOOR PLAN - PLUMBING WASTE AND VENT
1/8" = 1'-0"

CONFORMED SET 01 JUL 2016

3 ADDENDUM 2-4 24 MAY 2015
2 ADDENDUM 2-2 19 APR 2016
1 ADDENDUM 2-1 17 MAR 2016
- ISSUED FOR CONSTRUCTION (BP2) 01 MAR 2016

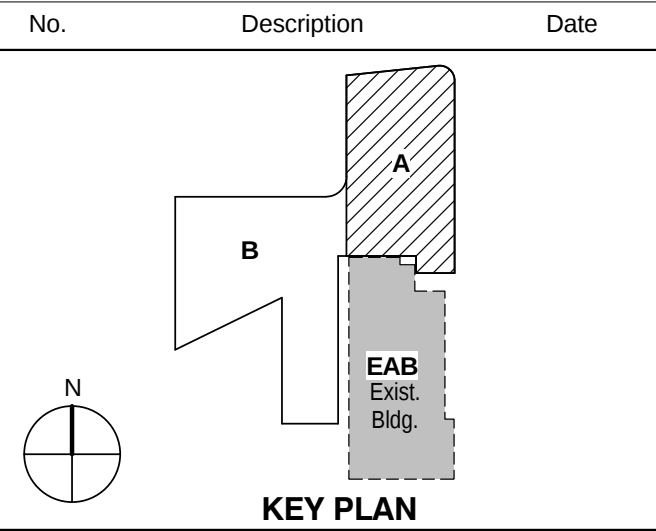

KEY PLAN

Drawing Title:

LEVEL 02 AREA A FLOOR
PLAN - PLUMBING WASTE
AND VENT

Project No.: 04561.01 Checked by:

P0112.A