


CONFORMED SET 01 JUL 2016

3 ADDENDUM 2-4 24 MAY 2016
2 ADDENDUM 2-2 19 APR 2016
1 ADDENDUM 2-1 17 MAR 2016
- ISSUED FOR CONSTRUCTION (BP2) 01 MAR 2016

No.	Description	Date
-----	-------------	------

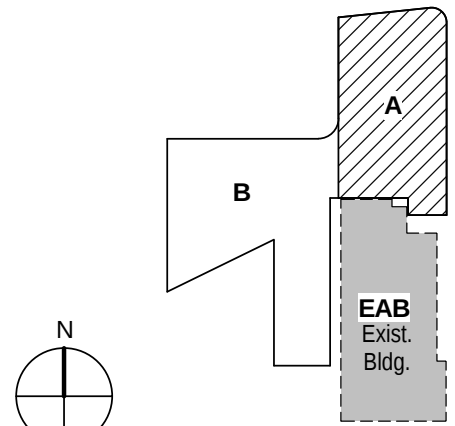

KEY PLAN


Drawing Title:

LEVEL 03 AREA A FLOOR
PLAN - PLUMBING WASTE
AND VENT

Project No.: 04561.01

Checked by:

P0113.A

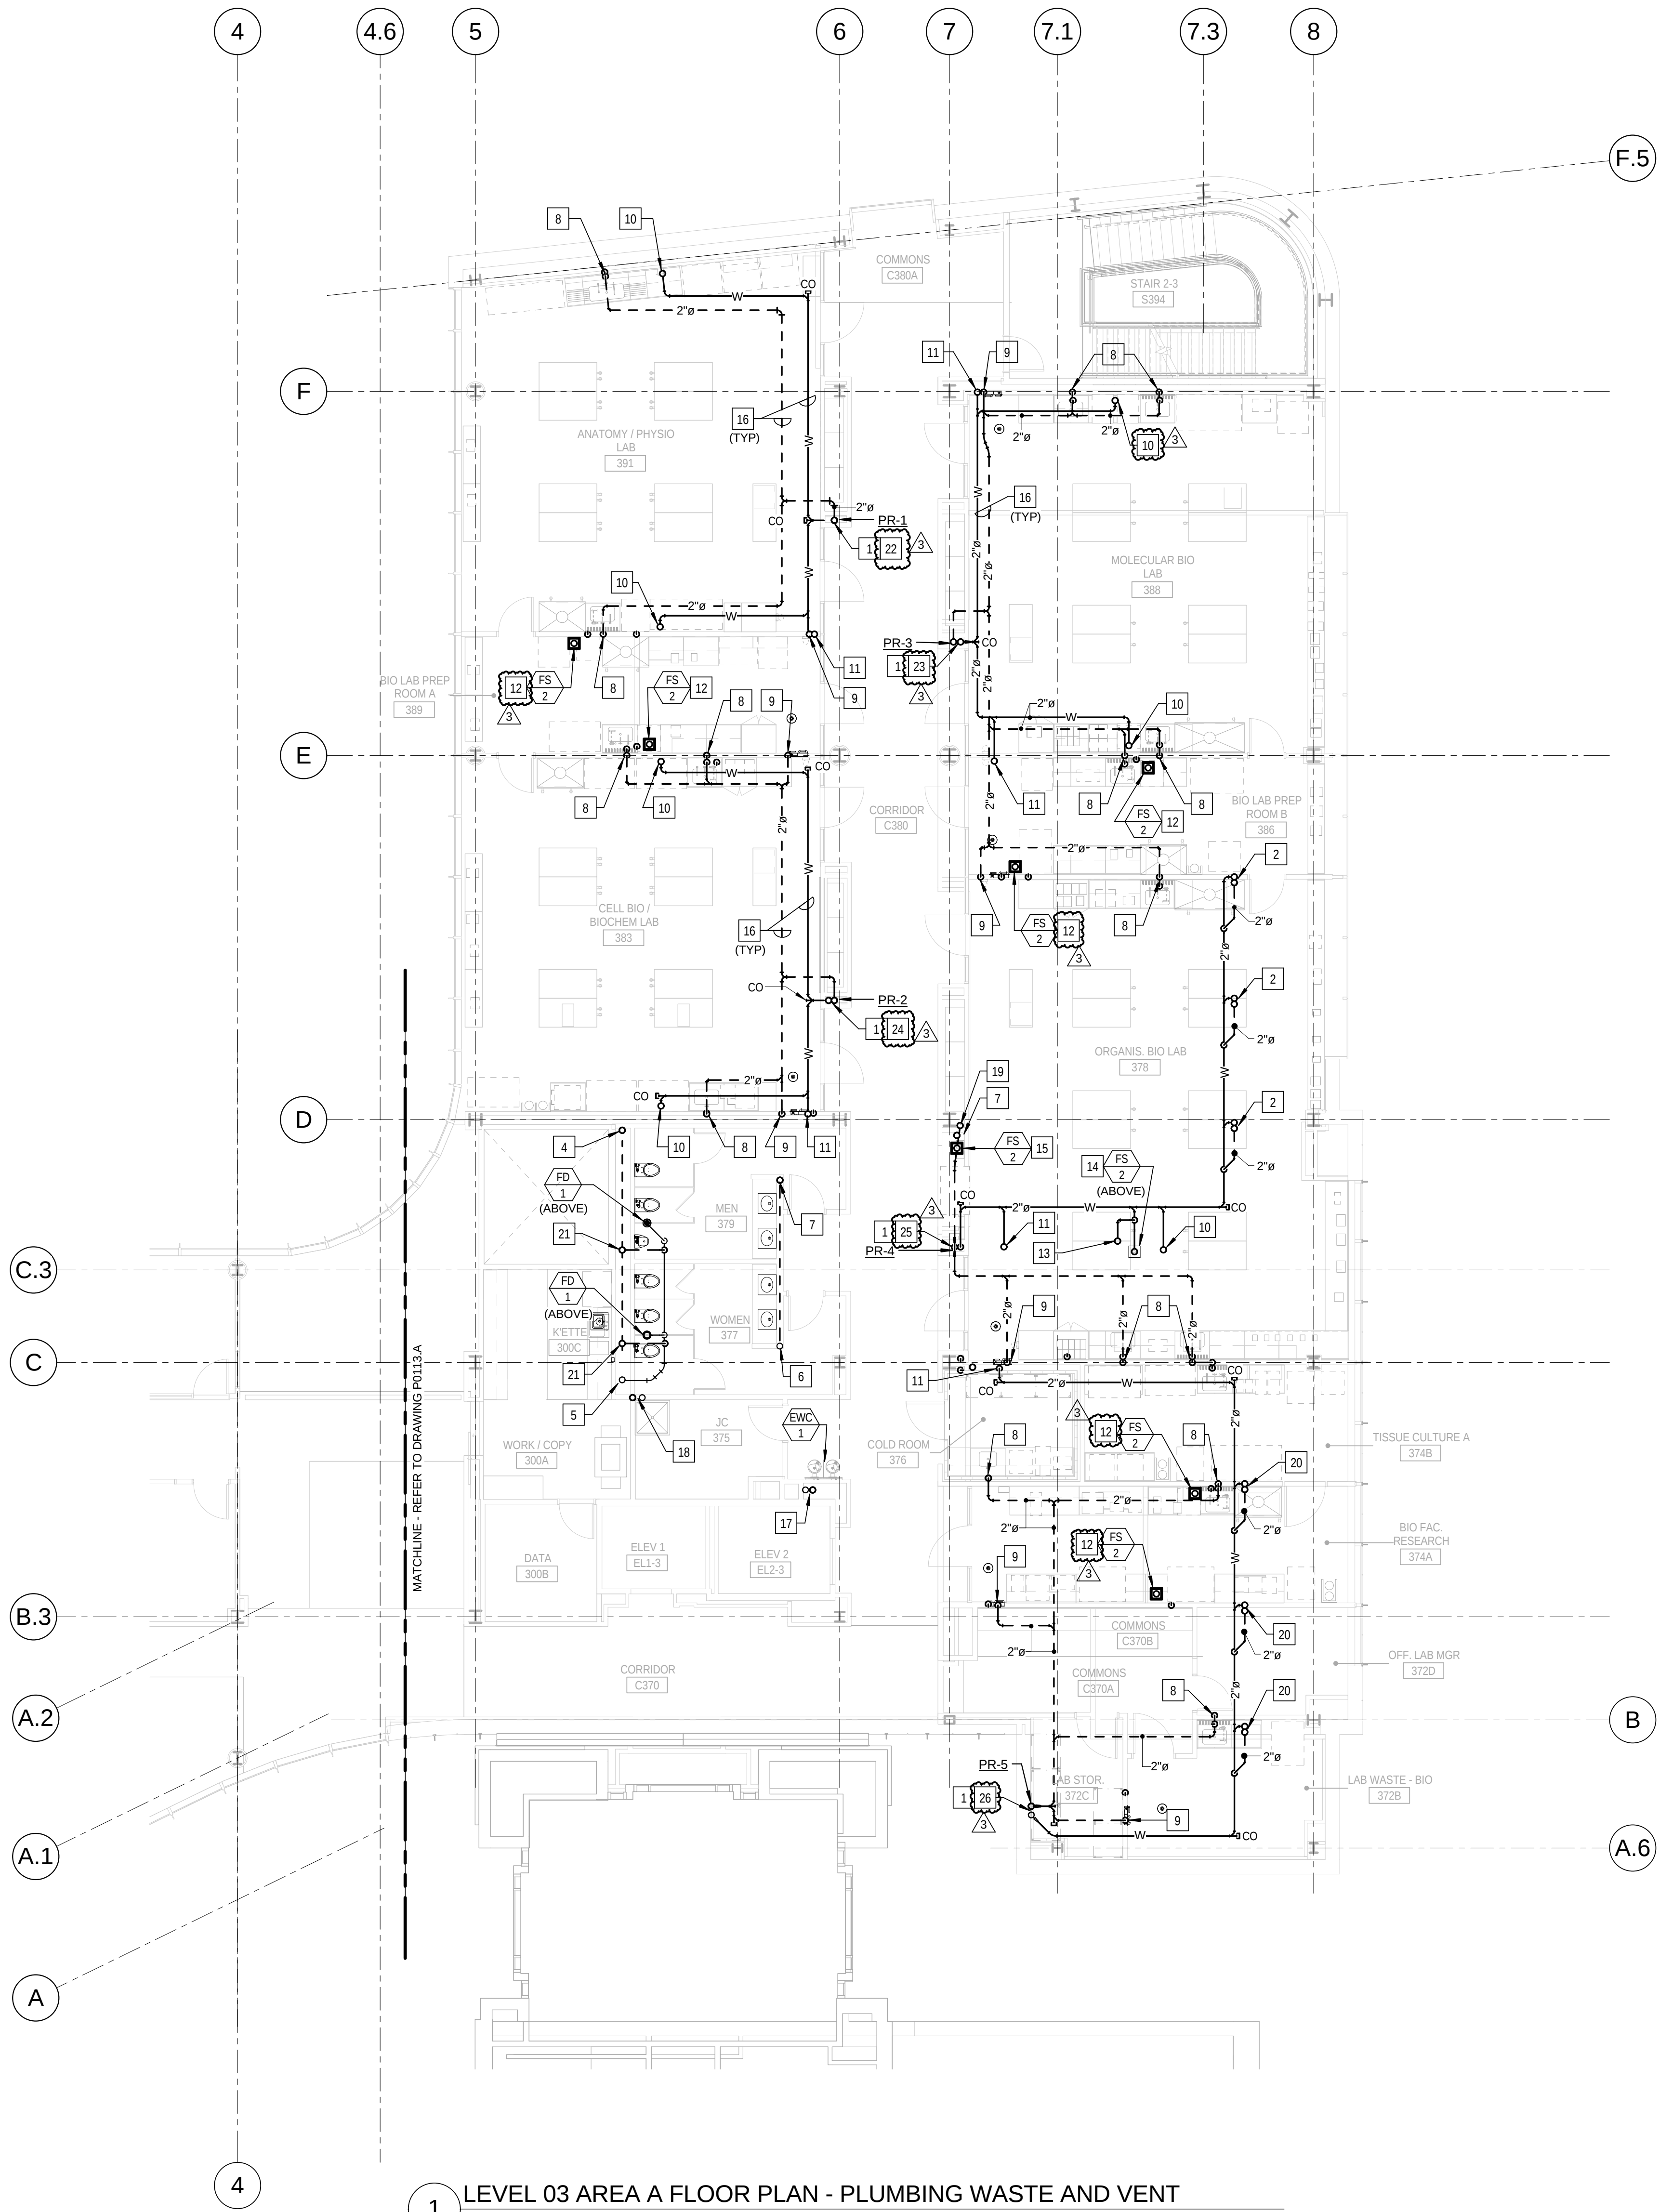

KEYED NOTES: (THIS SHEET ONLY)

- 3" SANITARY WASTE AND 3" SANITARY VENT RISERS.
- 2" SANITARY WASTE AND 2" SANITARY VENT UP TO ISLAND LAB BENCH SINKS ABOVE. EXTEND THE VENT UP TO BELOW THE COUNTERTOP BEFORE RETURNING DOWN. PROVIDE CLEANOUTS TEES IN WASTE AND VENT PIPING IN CABINET BELOW THE SINK. EXTEND AND CONNECT VENT RETURN TO THE SANITARY WASTE BELOW THE FLOOR, FIVE FOOT DOWN-STREAM.
- 3" SANITARY WASTE AND 3" SANITARY VENT DOWN FROM LEVEL 3. OFF-SET ABOVE THE CEILING TO CONTINUE DOWN.
- 4" SANITARY VENT RISER UP AND DOWN.
- 4" SANITARY WASTE UP AND DOWN. REFER TO DRAWING P0401 FOR RISER DIAGRAMS.
- 2" SANITARY WASTE UP AND DOWN. REFER TO DRAWING P0401 FOR RISER DIAGRAMS.
- 2" SANITARY VENT UP AND DOWN.
- 2" SANITARY VENT DOWN IN WALL TO SERVE LABORATORY SINK.
- 2" SANITARY VENT DOWN IN WALL TO SERVE EMERGENCY SHOWER.
- 2" SANITARY WASTE UP TO LEVEL 4 LAB SINK.
- 2" SANITARY WASTE UP TO LEVEL 4 EMERGENCY SHOWER EYE/FACE WASH STATION.
- FLOOR SINK TO BE LOCATED BELOW THE CASEWORK TO ACCEPT DISCHARGE FROM THE LAB EQUIPMENT. COORDINATE LOCATION WITH CASEWORK.
- 2" SANITARY VENT UP TO LEVEL 4. ALIGN WITH CASEWORK AND WALL ABOVE.
- FLOOR SINK SET TO SERVE LEVEL 4. COORDINATE LOCATION OF FLOOR SINK WITH CASEWORK ABOVE AND WITH ABOVE CEILING CONDITIONS ON THIS LEVEL.
- NOT USED.
- PIPING IN EACH ROOM TO BE RUN AS HIGH AS POSSIBLE TO AVOID CONFLICTS. COORDINATE INSTALLATION AND ROUTING WITH OTHER TRADES PRIOR TO ROUGH-IN.
- 2" SANITARY WASTE AND 2" SANITARY VENT RISERS TO SERVE ELECTRIC WATER COOLERS ON EACH LEVEL. REFER TO DRAWING P0401 FOR WASTE AND VENT RISER.
- 3" SANITARY WASTE AND 2" VENT RISERS TO SERVE MOP BASINS ON LEVELS 1 AND 3 AND COUNTERTOP SINK ON LEVEL 2. REFER TO DRAWING P0401 FOR WASTE AND VENT RISER.
- 3" SANITARY VENT UP TO LEVEL 4. REFER TO DRAWING P0114.A.
- 2" SANITARY WASTE AND 2" SANITARY VENT UP TO ISLAND LAB BENCH SINKS AND CUP SINKS ABOVE. EXTEND THE VENT UP TO BELOW THE COUNTERTOP BEFORE RETURNING DOWN. PROVIDE CLEANOUTS TEES IN WASTE AND VENT PIPING IN CABINET BELOW THE SINK. EXTEND AND CONNECT VENT RETURN TO THE SANITARY WASTE BELOW THE FLOOR, FIVE FOOT DOWN-STREAM.
- 2" SANITARY VENT UP IN PLUMBING CHASE.
- REFER TO DRAWING P0404 SANITARY WASTE AND VENT RISER DIAGRAM 1-3.
- REFER TO DRAWING P0406 SANITARY WASTE AND VENT RISER DIAGRAM 3-3.
- REFER TO DRAWING P0404 SANITARY WASTE AND VENT RISER DIAGRAM 2-4.
- REFER TO DRAWING P0408 SANITARY WASTE AND VENT RISER DIAGRAM 4-3.
- REFER TO DRAWING P0408 SANITARY WASTE AND VENT RISER DIAGRAM 5-3.