


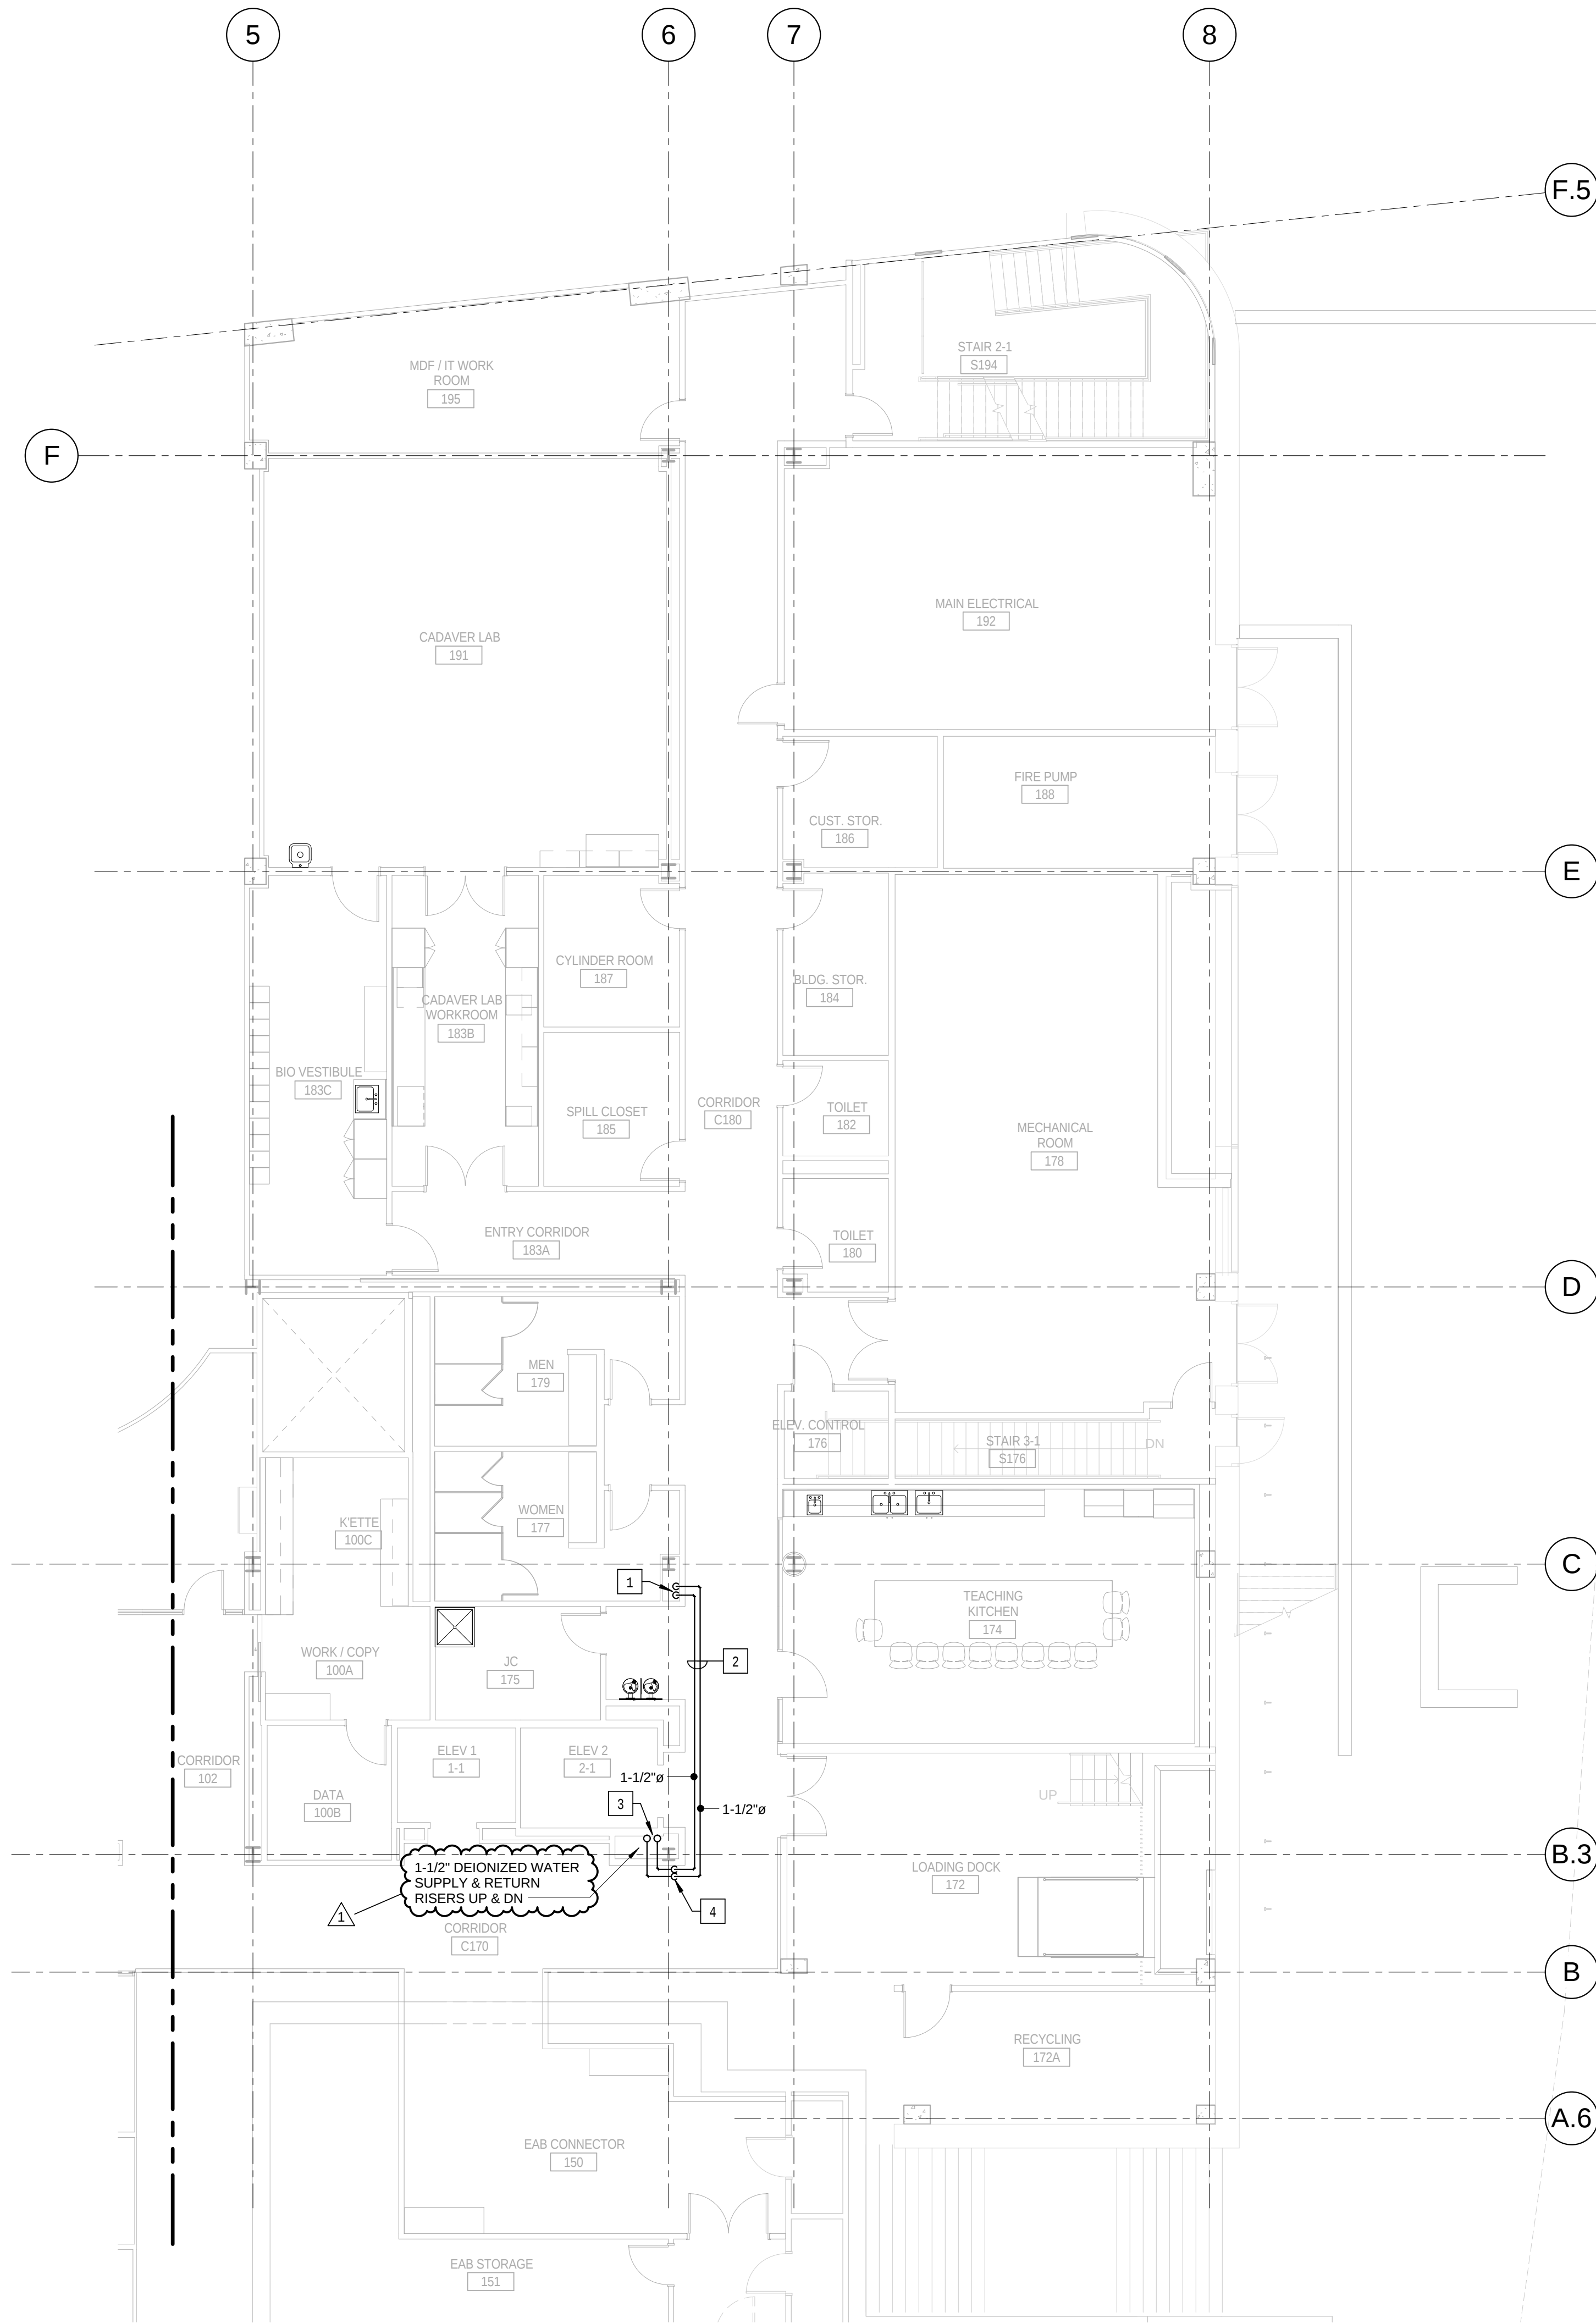


1 LEVEL 01 AREA A FLOOR PLAN - LABORATORY DEIONIZED WATER SYSTEM
1/8" = 1'-0"

KEYED NOTES - (THIS SHEET ONLY)

- 1 DEIONIZED WATER RISERS DOWN TO LEVEL 0. REFER TO DRAWING P0300 A FOR CONTINUATION.
- 2 RUN PIPING IN CORRIDOR AT BOTTOM OF STRUCTURAL STEEL CROSS MEMBERS. COORDINATE INSTALLATION AND ROUTING WITH OTHER TRADES PRIOR TO ROUGH-IN.
- 3 BUILDING SERVICE RISER FOR DEIONIZED WATER. COORDINATE INSTALLATION WITH BUILDING STRUCTURE AND OTHER SERVICES WITHIN CHASE.
- 4 DROP PIPING DOWN TO BELOW STRUCTURAL STEEL. HOLD TIGHT TO BOTTOM OF STEEL.

CONFORMED SET 01 JUL 2016

1 ADDENDUM 2-1 17 MAR 2016		
ISSUED FOR CONSTRUCTION (BP2) 01 MAR 2016		
No.	Description	Date

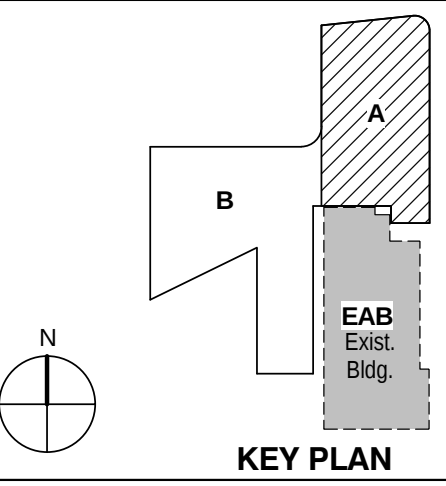

Drawing Title:

LEVEL 01 AREA A FLOOR
PLAN - LABORATORY
DEIONIZED WATER
SYSTEM

Project No.: 04561.01 Checked by:

P0301.A