



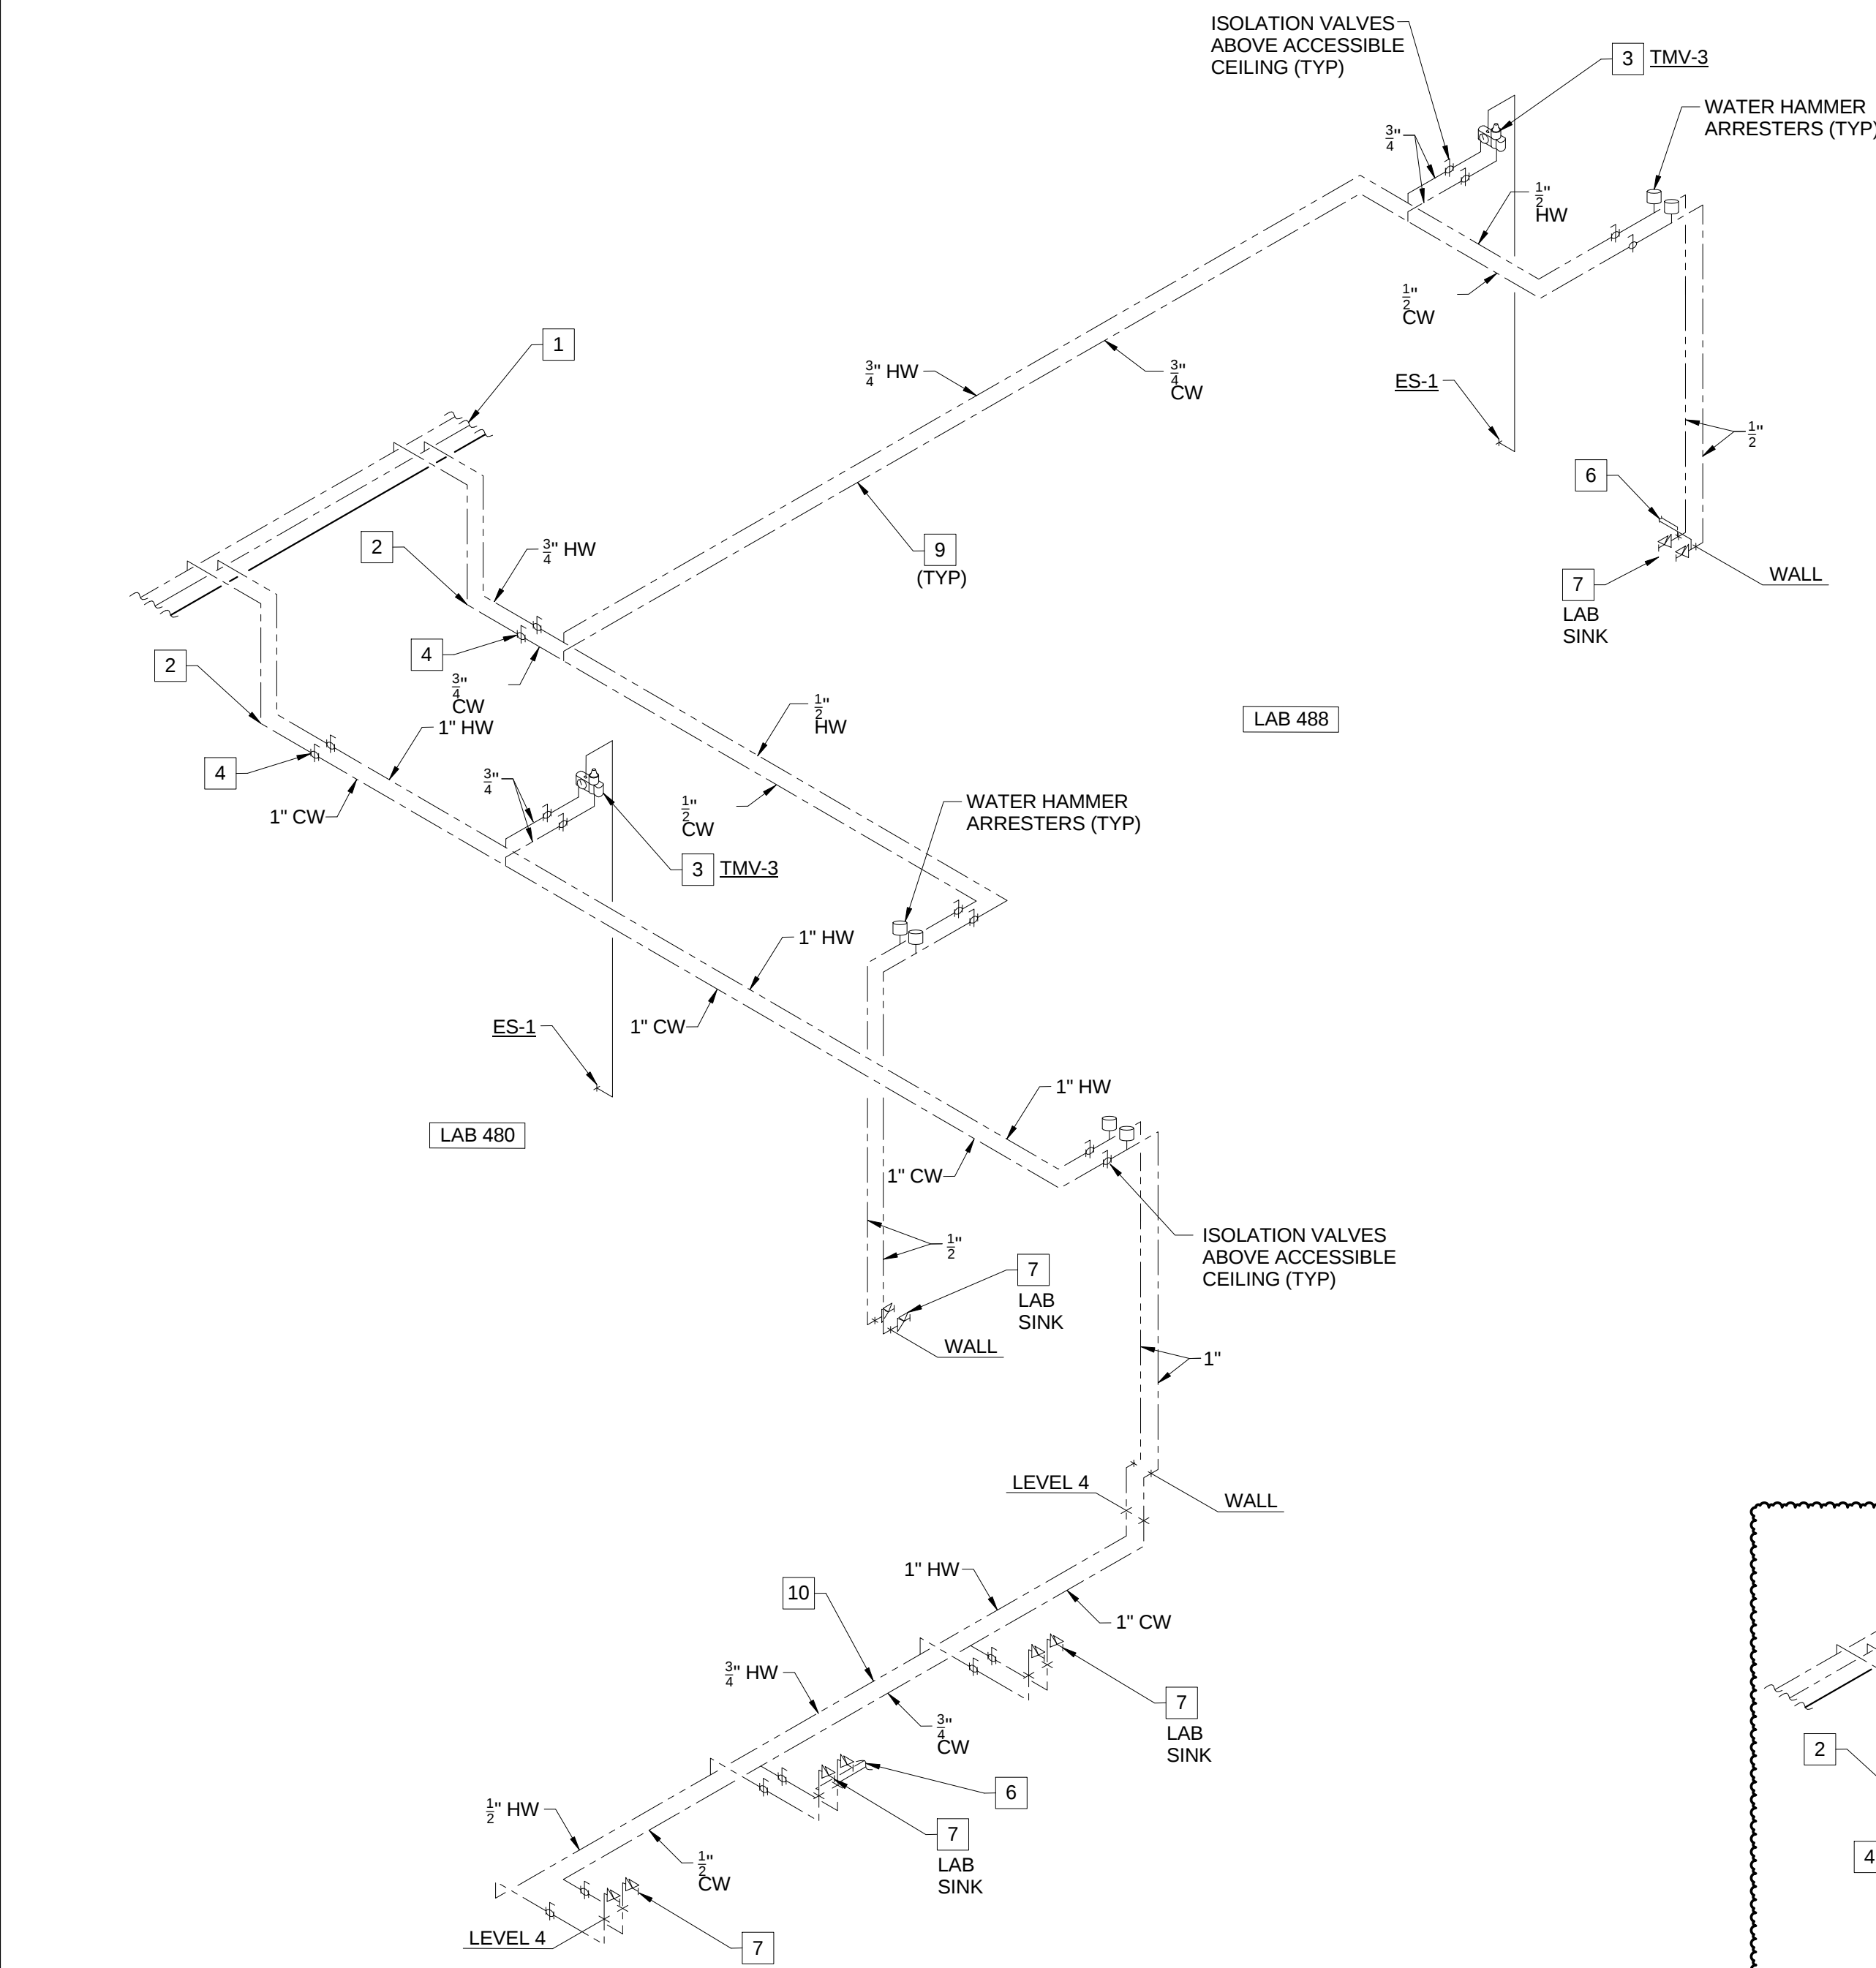


2 DOMESTIC WATER SUPPLY RISER - LAB 480 AND LAB 488

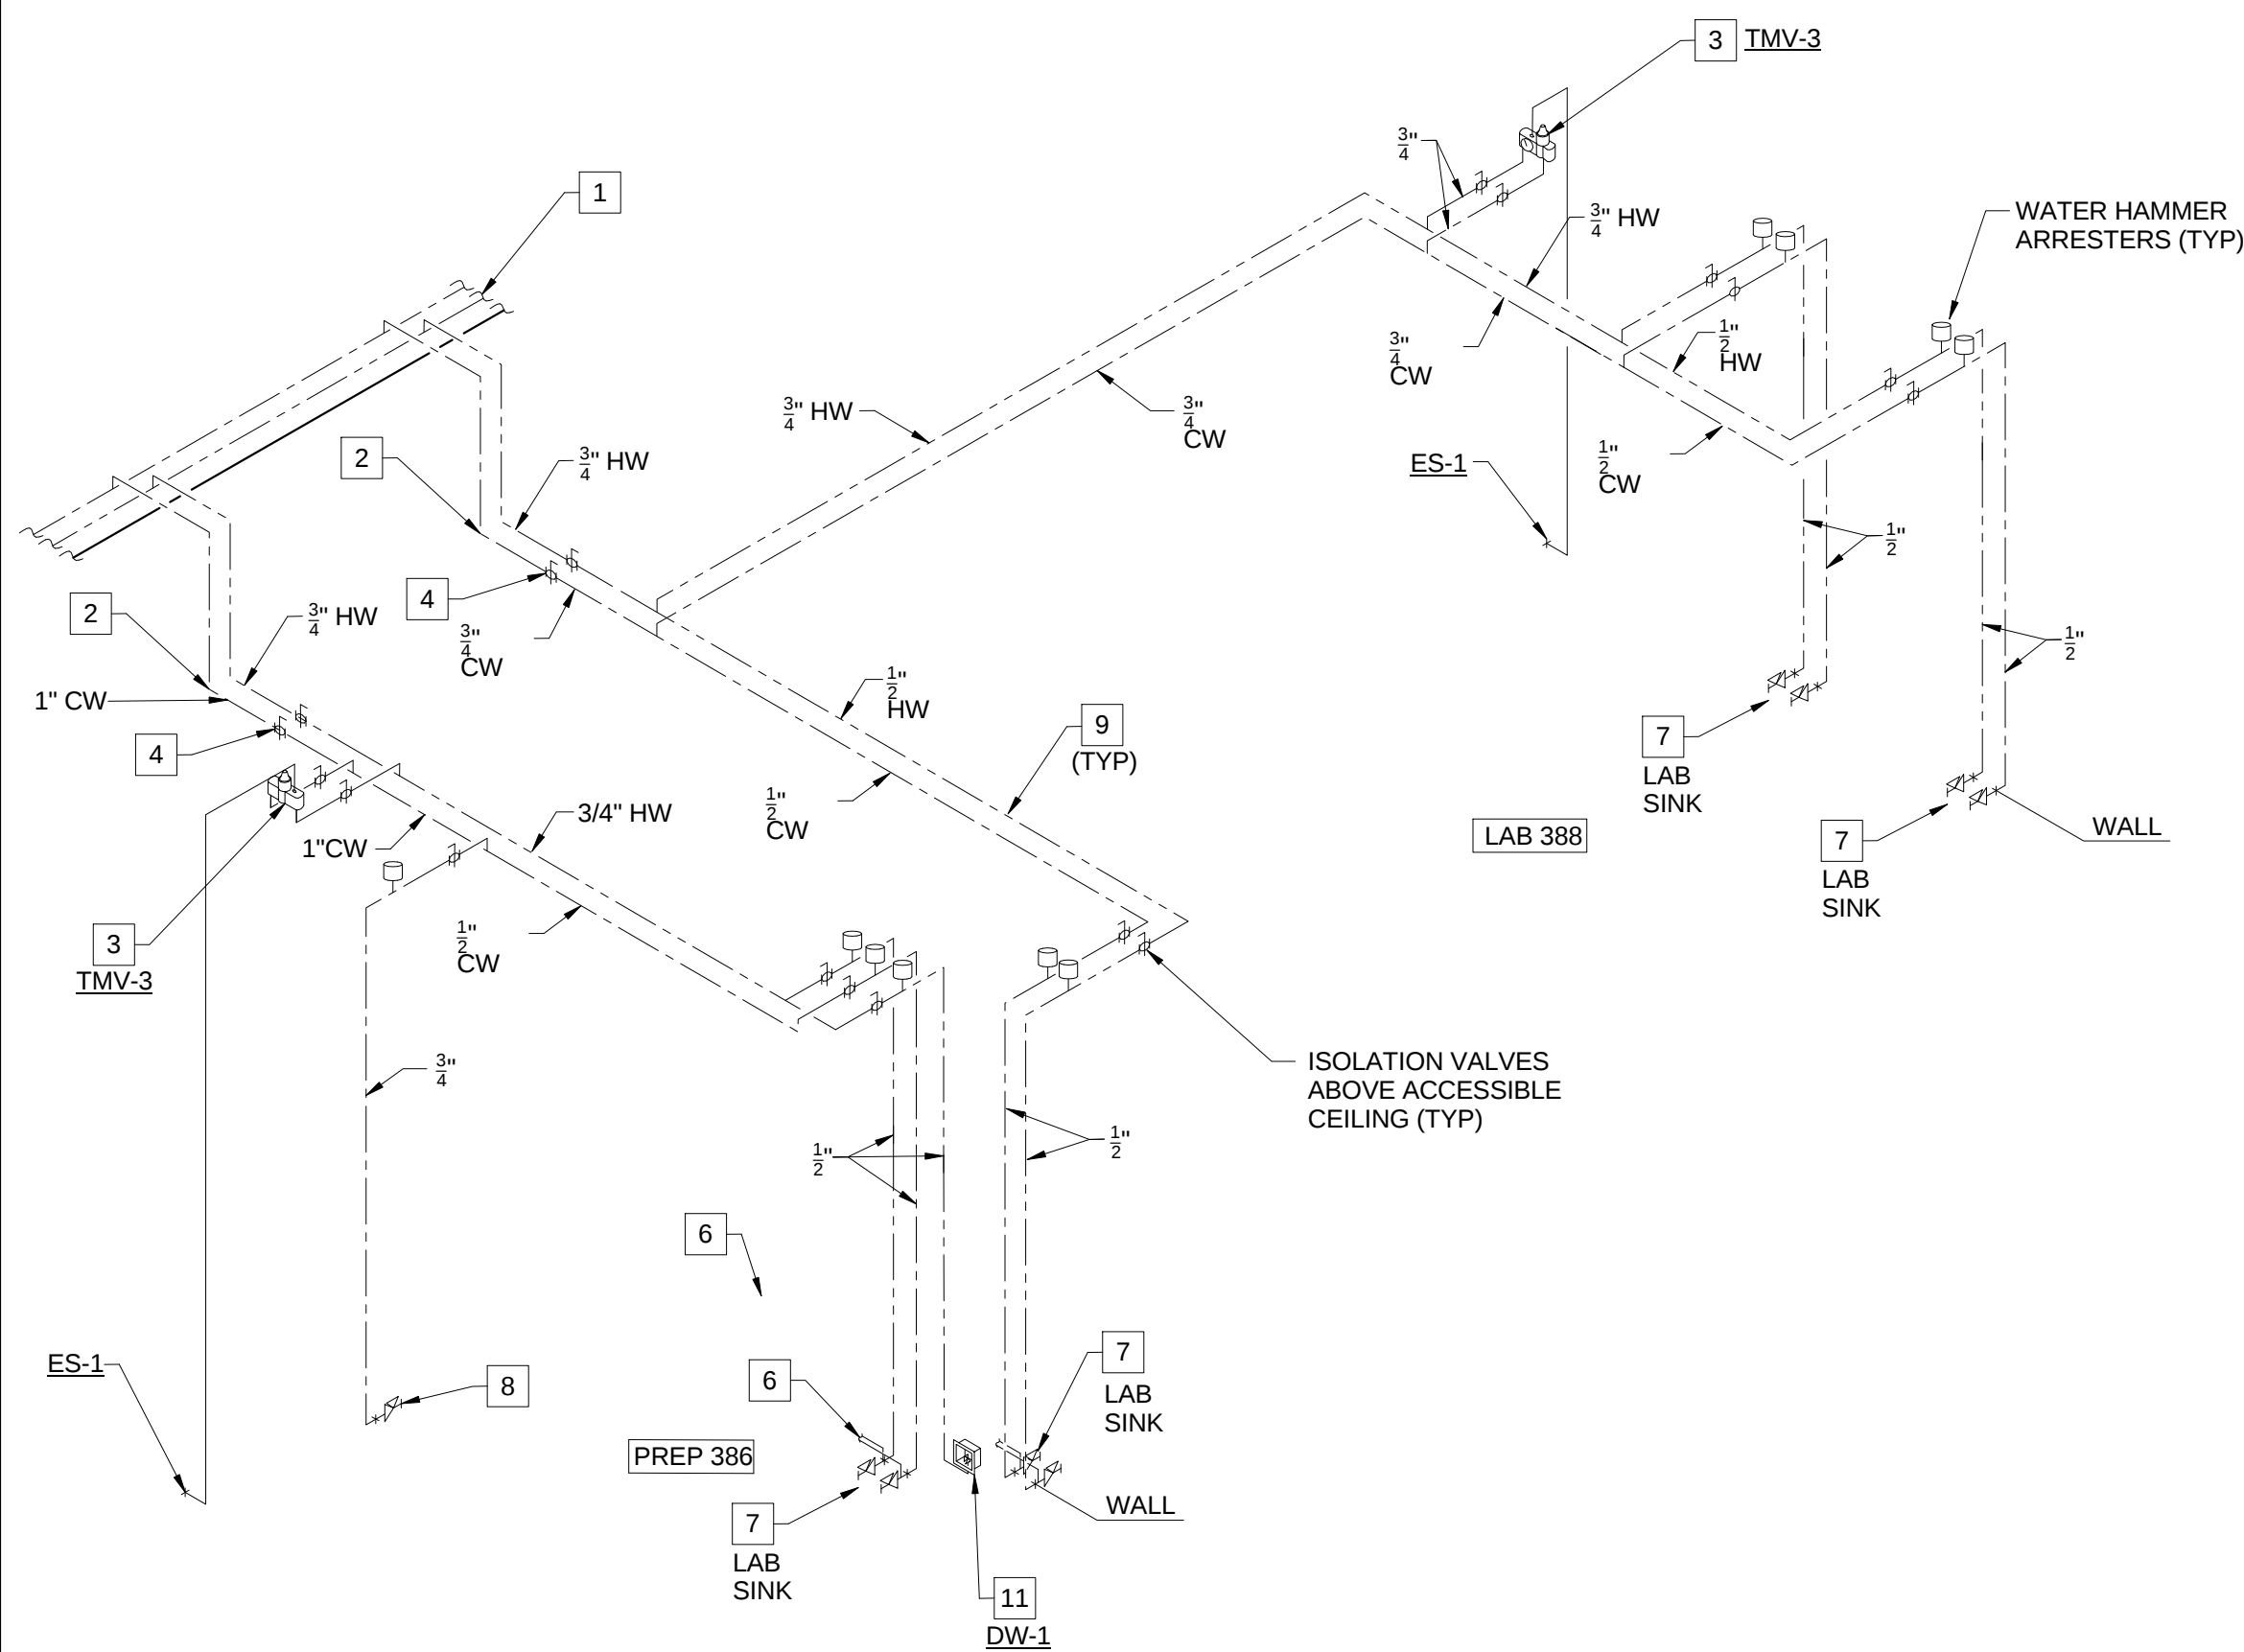


1 DOMESTIC WATER SUPPLY RISER - LAB 378, PREP 386 AND LAB 388

KEYED NOTES (THIS SHEET ONLY)


- 1 DOMESTIC WATER PIPING IN THE CORRIDOR TO BE RUN AT THE BOTTOM OF THE STRUCTURAL CROSS MEMBERS. COORDINATE INSTALLATION AND ROUTING WITH OTHER TRADES ON THIS PROJECT.
- 2 DROP PIPIDROP PIPING BELOW THE STRUCTURAL STEEL MEMBER. HOLD TIGHT TO BOTTOM OF STEEL.
- 3 THERMOSTAT THERMOSTATIC MIXING VALVE (TMV-2) SERVING THE EMERGENCY SHOWER TO BE LOCATED ABOVE THE ACCESSIBLE CEILING. REFER TO DRAWING P0403, DETAIL 4/P0403 FOR PIPING DIAGRAM OF EMERGENCY SHOWER. VERIFY LOCATION AND PIPING CONFIGURATION PRIOR TO ROUGH-IN.
- 4 PROVIDE SHUT-OFF VALVES AT THE ENTRY TO EACH ROOM.
- 5 REFER TO DRAWING P0502, DETAIL 11/P0502 FOR HOT WATER RETURN PIPING DIAGRAM.
- 6 WATER PIPING CONNECTION TO THERMOSTATIC MIXING VALVE (TMV-3) SERVING THE DECK MOUNTED EMERGENCY EYEWASH. REFER TO DRAWING P0403, DETAIL 4/P0403 FOR PIPING DIAGRAM OF EMERGENCY EYEWASH. VERIFY LOCATION AND PIPING CONFIGURATION PRIOR TO ROUGH-IN.
- 7 LAB SINK WITH LAB FAUCET TYPE 'LF-1'.
- 8 WATER CONNECTION FOR AUTOCLAVE. COORDINATE LOCATION AND INSTALLATION WITH EQUIPMENT AND CASEWORK. VERIFY EQUIPMENT CONNECTIONS AND LOCATION, PROVIDE FITTINGS AND FINAL CONNECTIONS AS REQUIRED. COORDINATE INSTALLATION WITH EQUIPMENT.
- 9 DOMESTIC WATER PIPING IN EACH ROOM TO BE RUN AS HIGH AS POSSIBLE TO AVOID CONFLICTS. COORDINATE INSTALLATION WITH OTHER TRADES ON THIS PROJECT PRIOR TO ROUGH-IN.
- 10 DOMESTIC WATER PIPING IN CEILING SPACE OF LEVEL 3 TO SERVE LAB SINKS ON LEVEL 4. COORDINATE ROUTING AND INSTALLATION WITH SPACE CONDITIONS.
- 11 WATER CONNECTION FOR UNDER COUNTER GLASS WASHER. COORDINATE LOCATION AND INSTALLATION WITH EQUIPMENT AND CASEWORK.

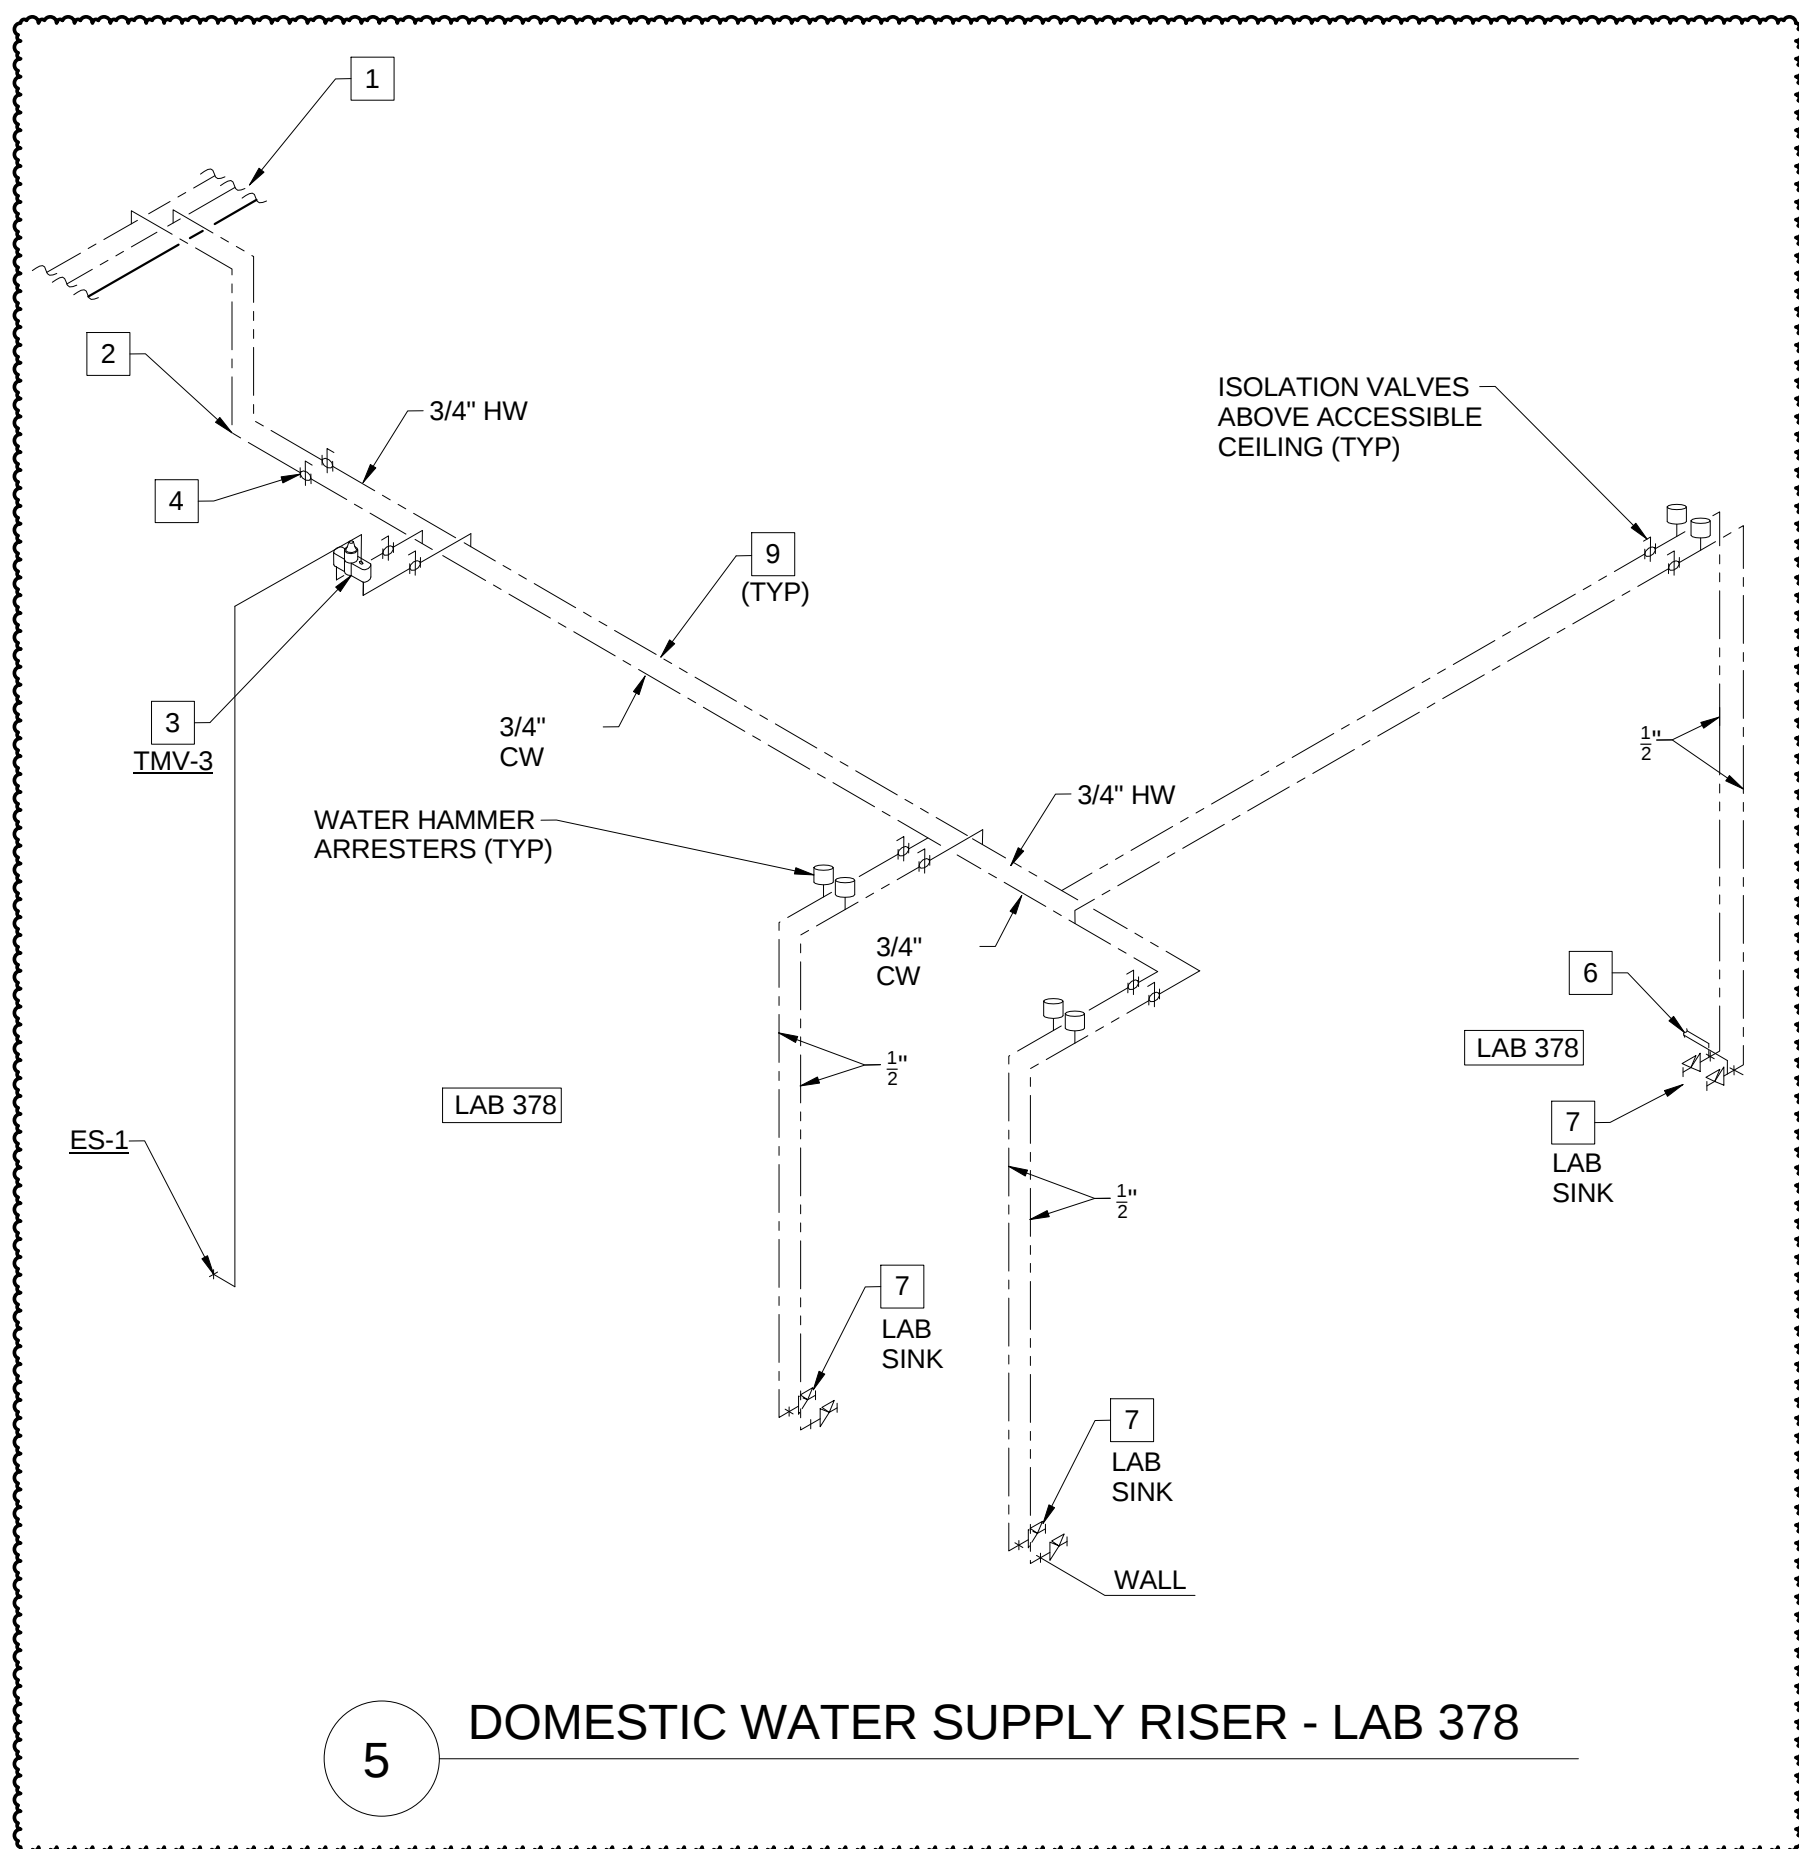

5 DOMESTIC WATER SUPPLY RISER - LAB 378

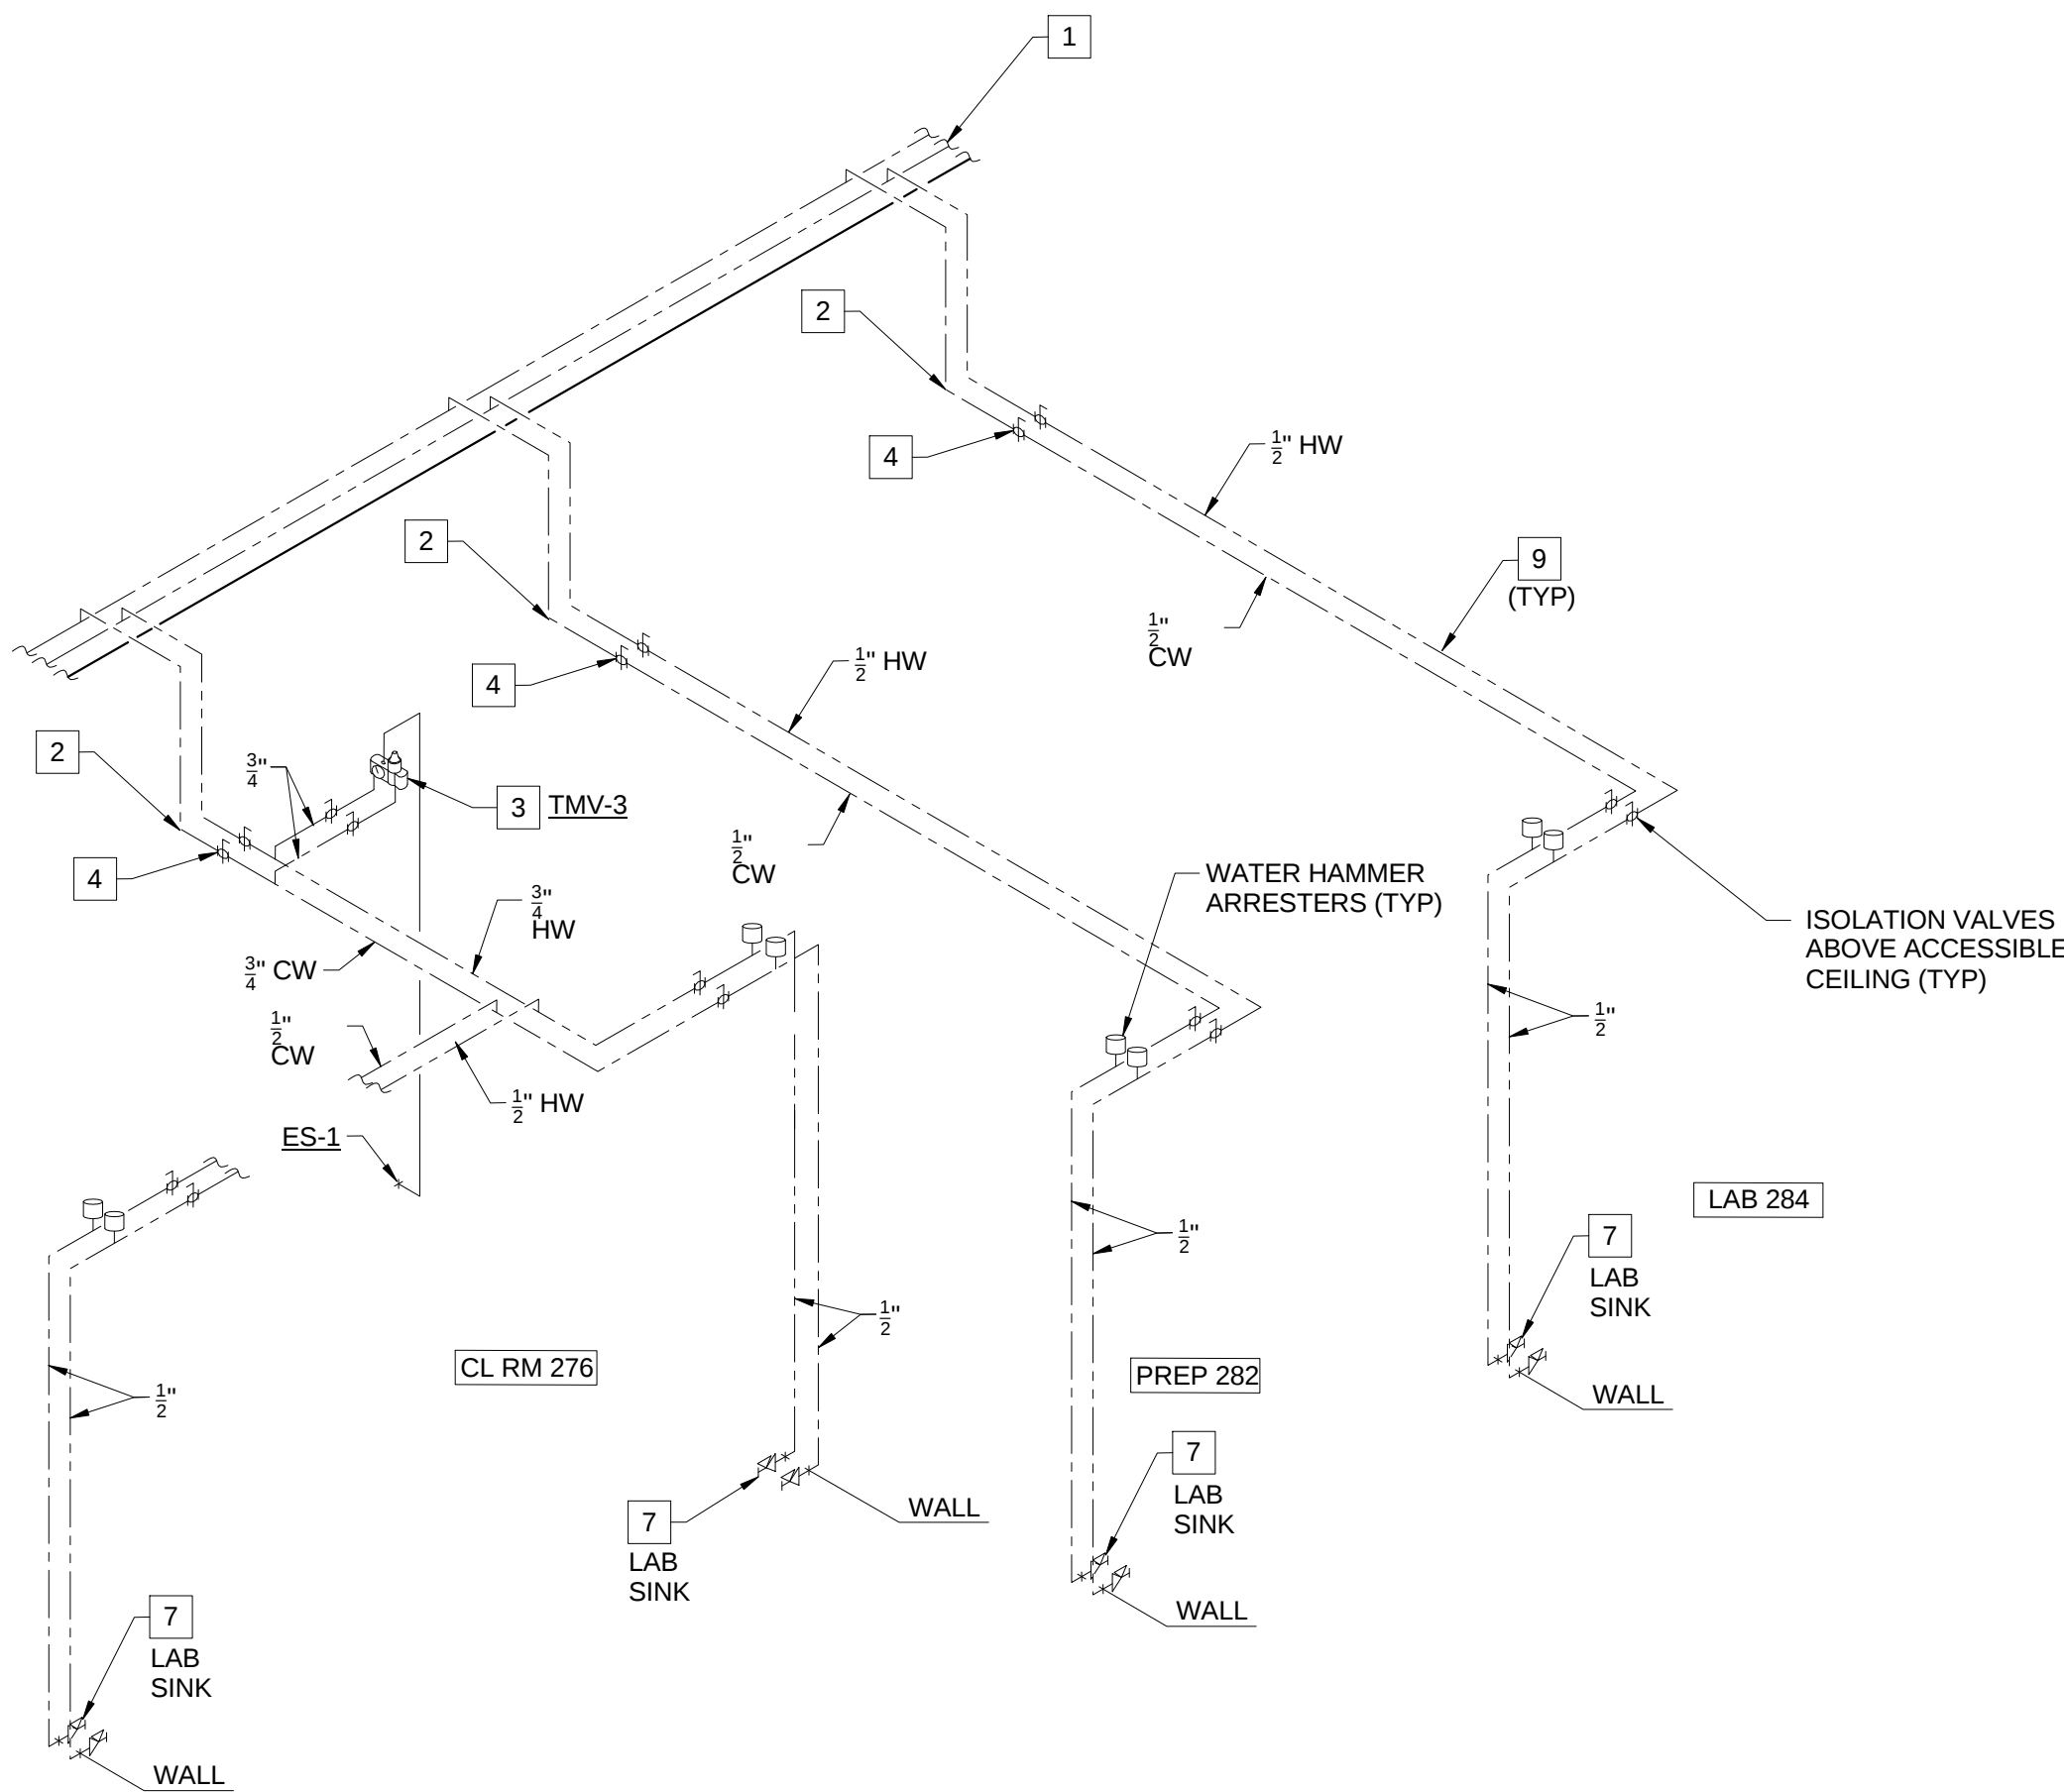

4 DOMESTIC WATER SUPPLY RISER - CLASS ROOM 276, PREP 282 AND LAB 284

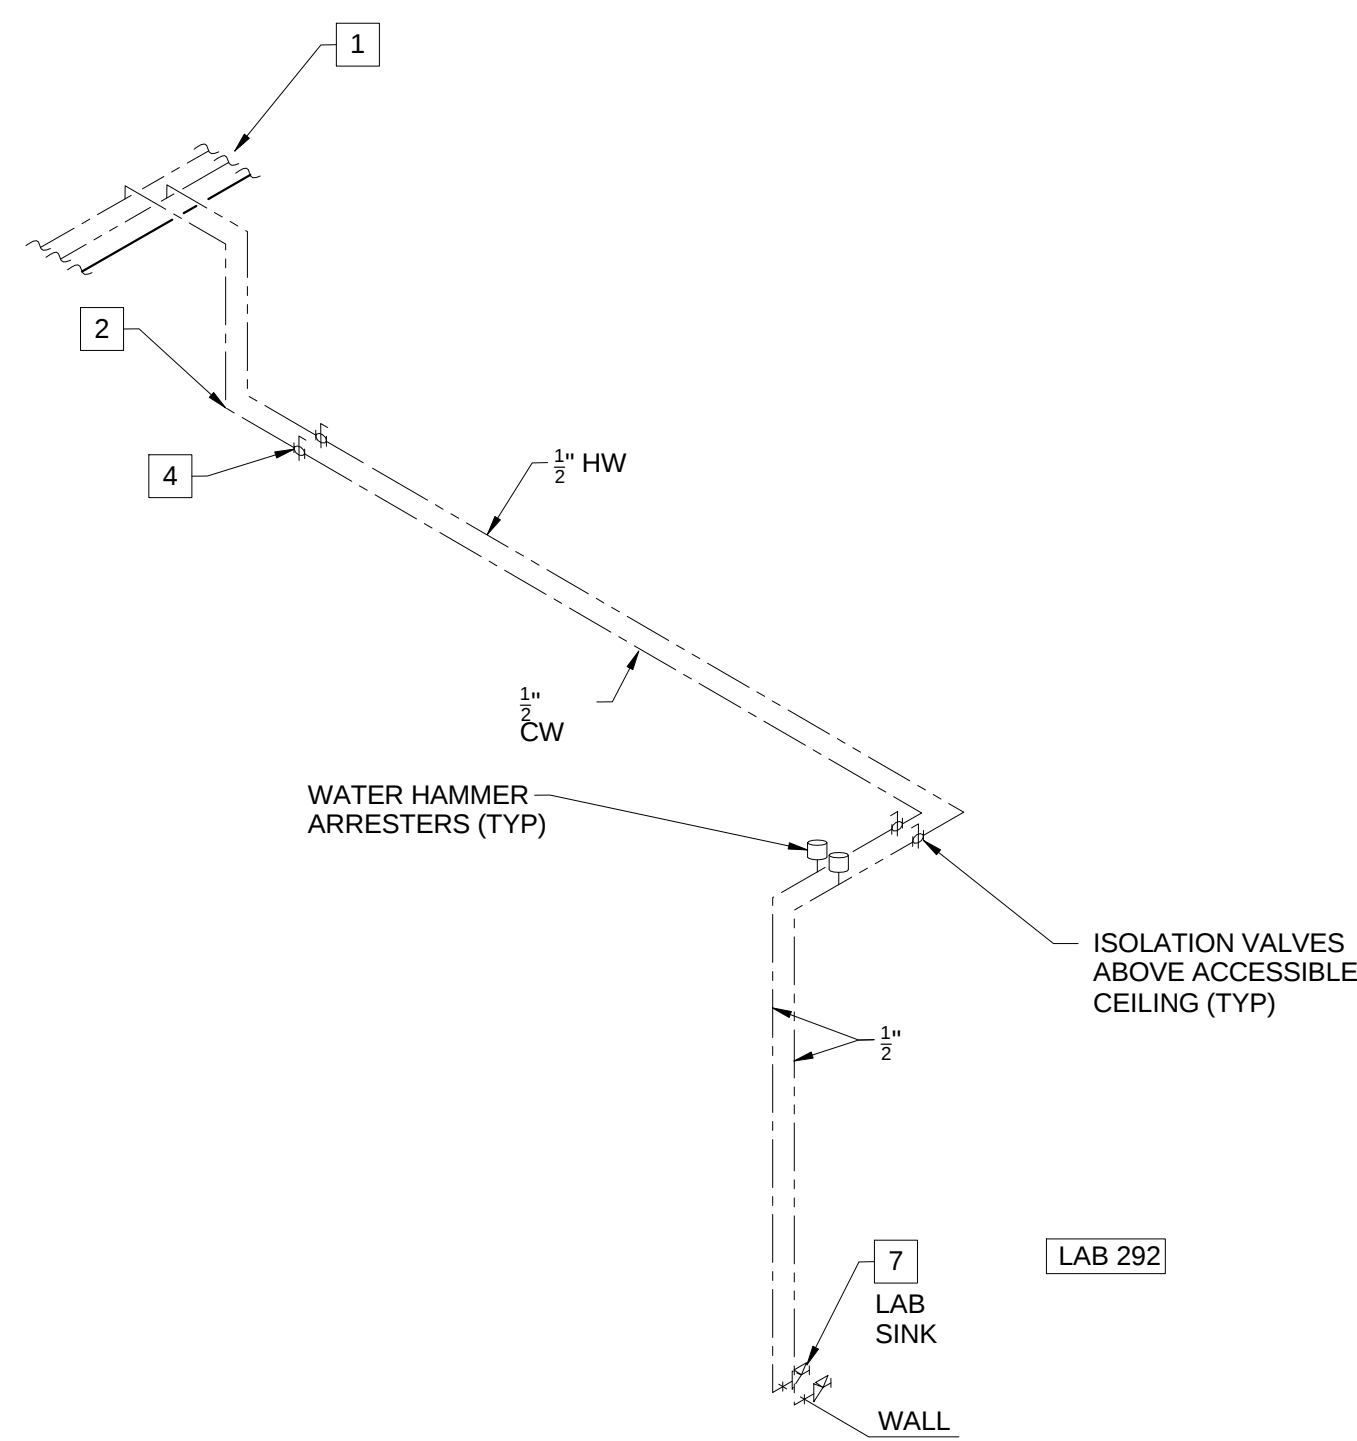

3 DOMESTIC WATER SUPPLY RISER - LAB 292

1 DOMESTIC WATER SUPPLY RISER DIAGRAMS
SCALE: N.T.S.

CONFORMED SET 01 JUL 2016

2	ADDENDUM 2-4	24 MAY 2016
1	ADDENDUM 2-2	19 APR 2016
-	ISSUED FOR CONSTRUCTION (BP2)	01 MAR 2016
No.	Description	Date

Drawing Title:

RISERS - PLUMBING

Project No.: 04561.01 Checked by:

P0407