

CONFORMED SET

01 JUL 2016

4	ADDENDUM 1-11	13 MAY 2016
3	ADDENDUM 1-7	16 MAR 2016
2	ADDENDUM 1-2	01 FEB 2016
1	ADDENDUM 1-1	29 JAN 2016
1	ISSUED FOR CONSTRUCTION (BPT)	15 JAN 2016
No.	Description	Date


Drawing Title:

**LEVEL 03 FLOOR
FRAMING PLAN**

Project No.: 04561.01

Checked by:

S0104

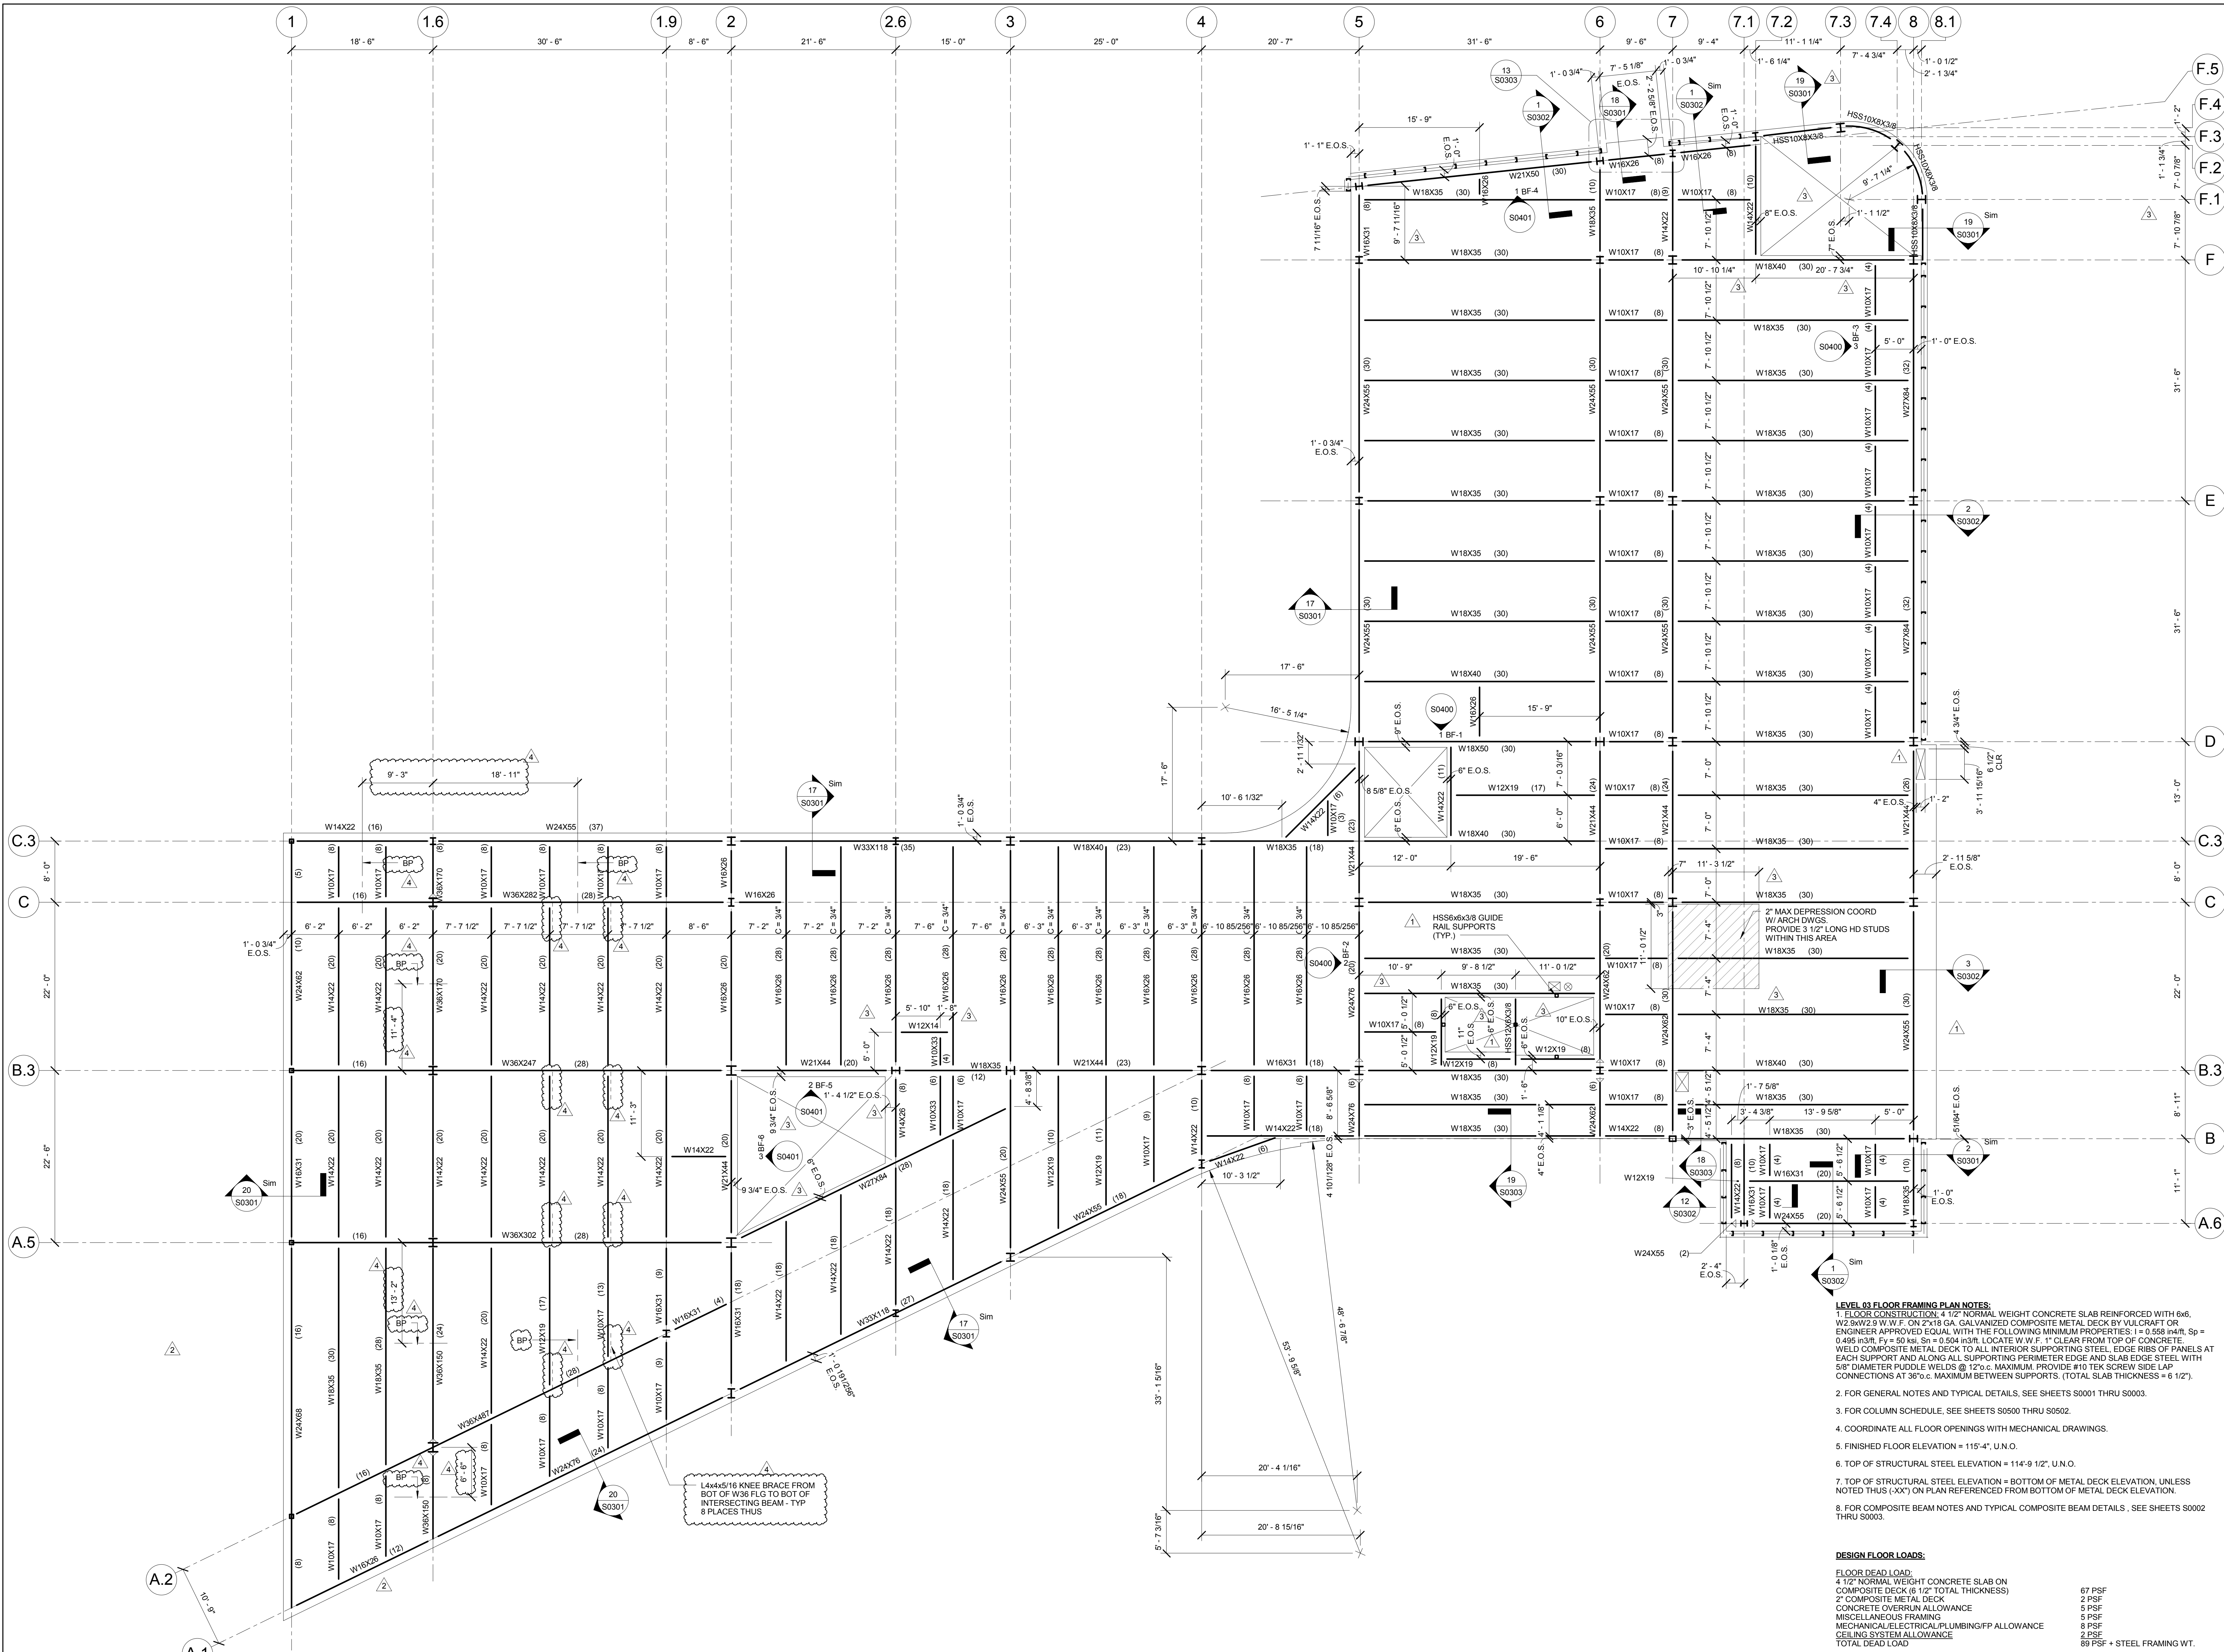

LEVEL 03 FLOOR FRAMING PLAN
1/8" = 1'-0"

