


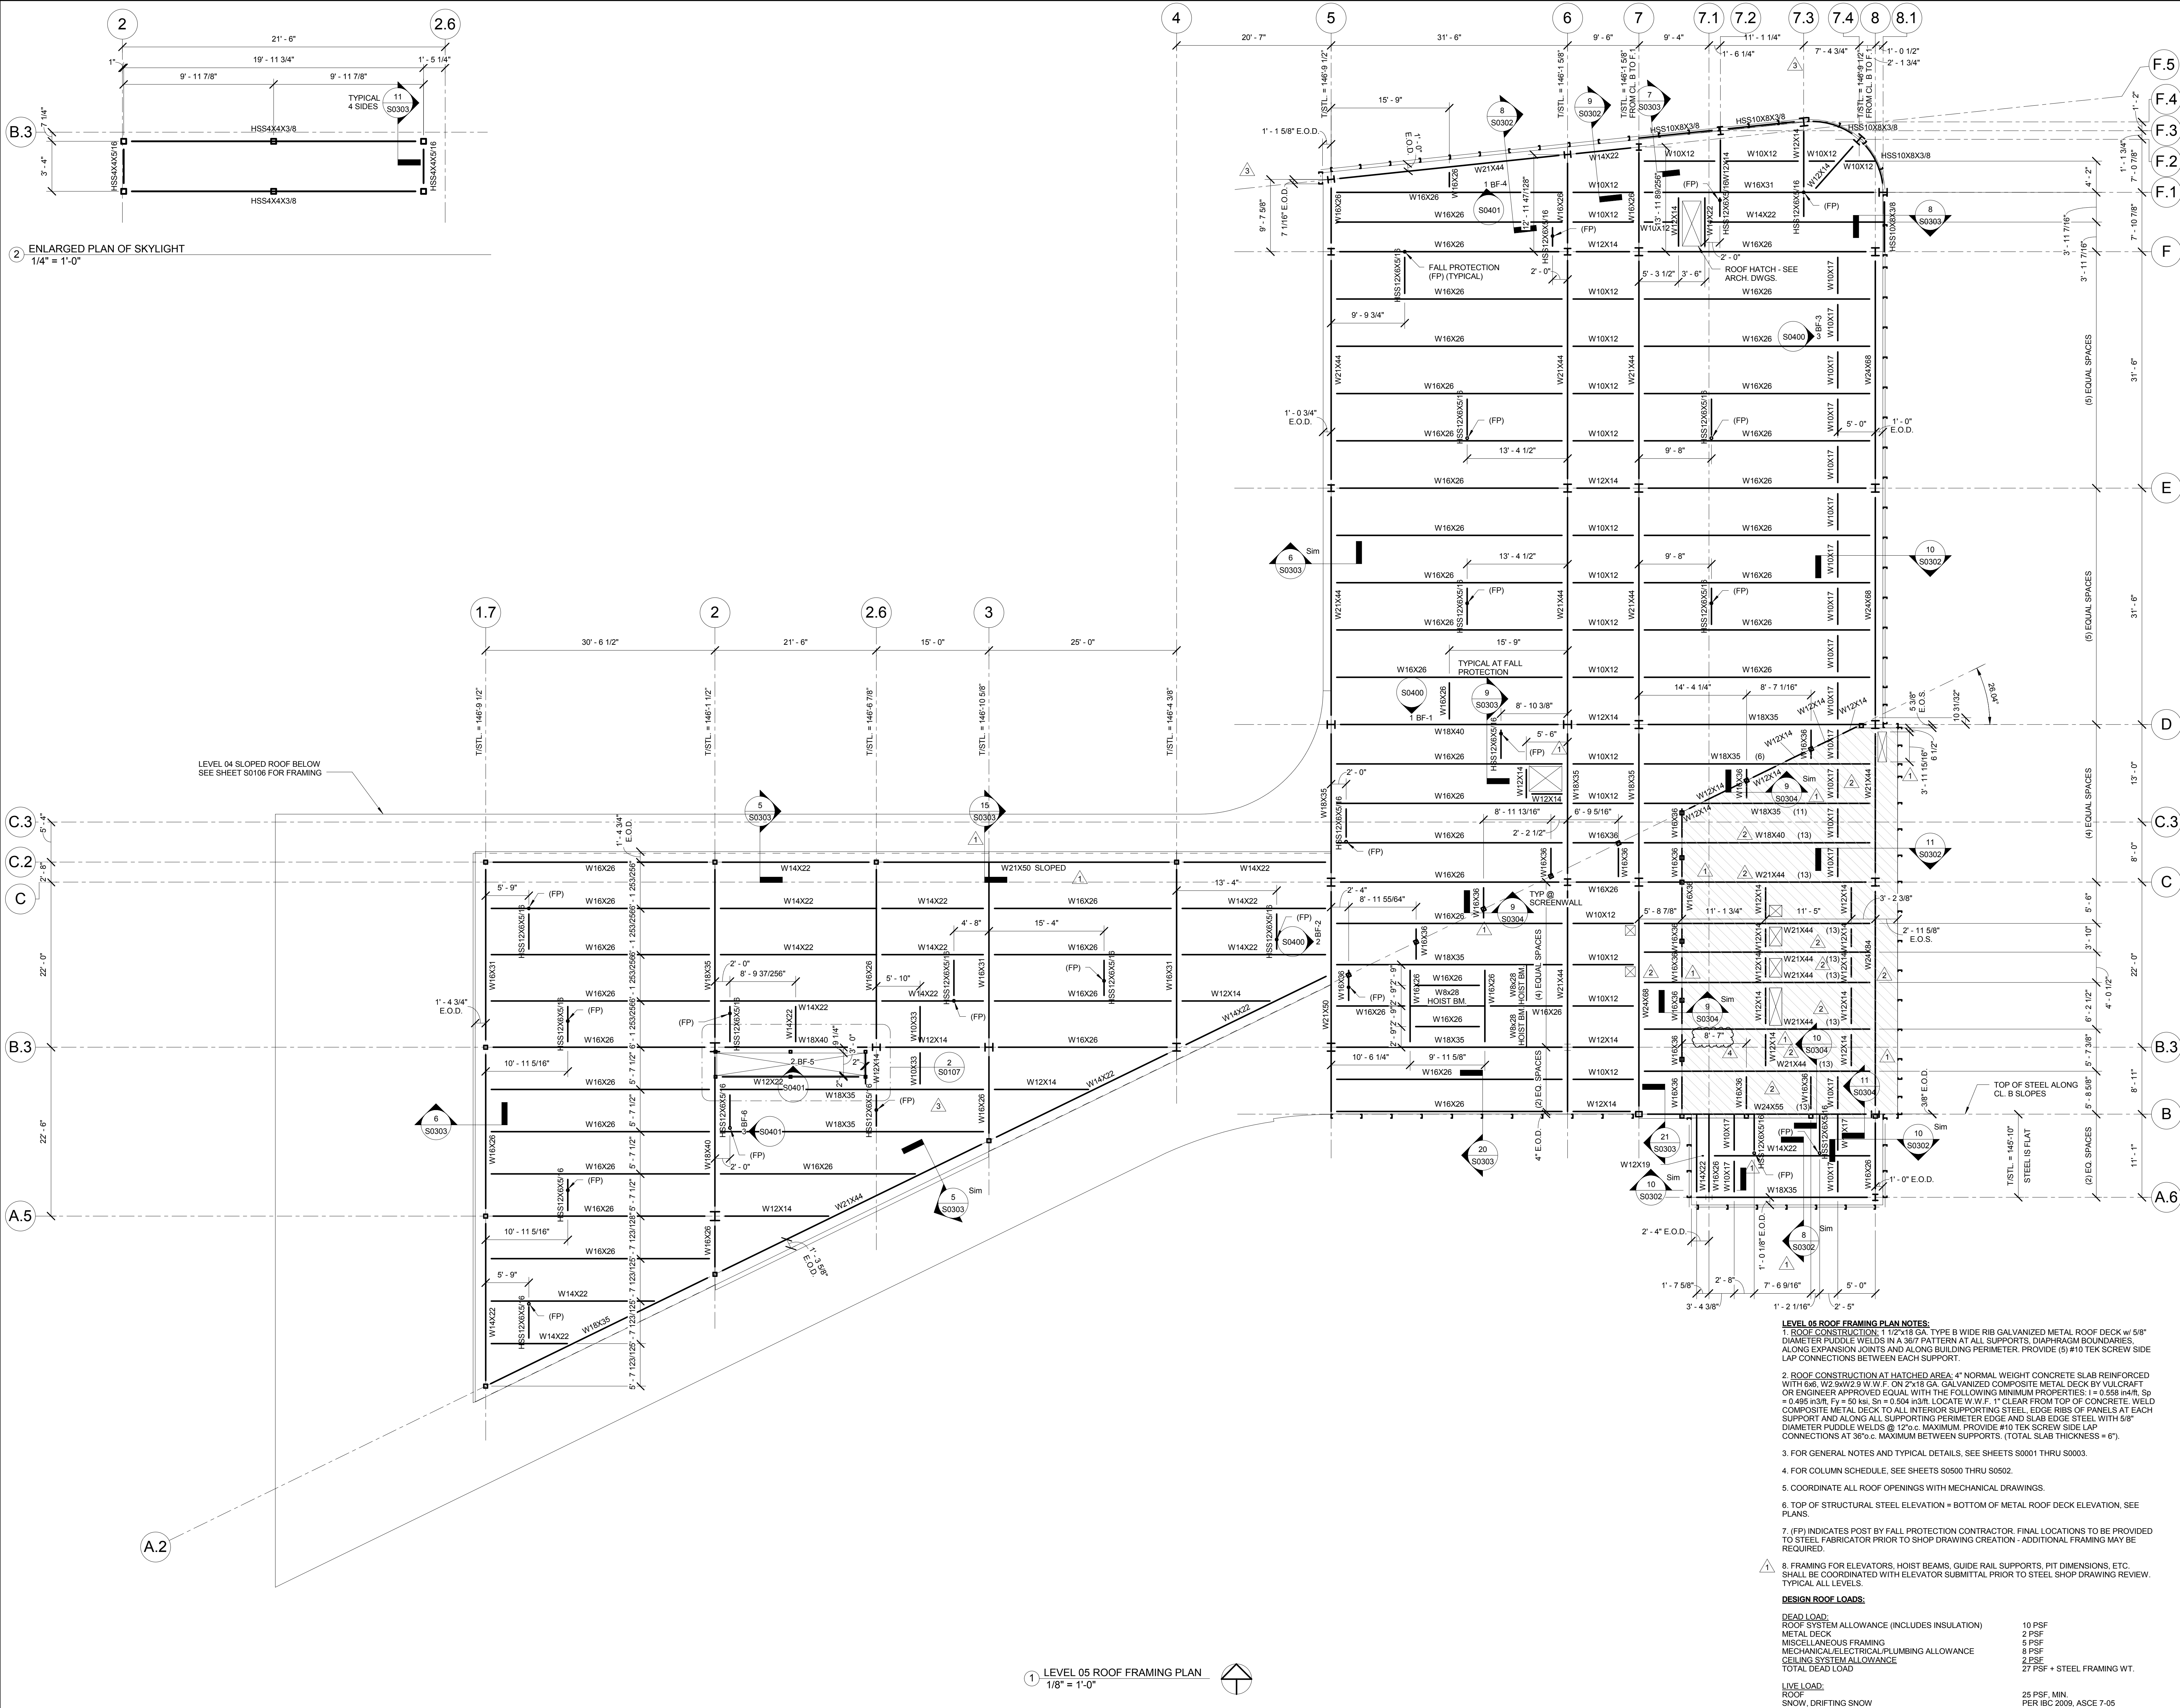

CONFORMED SET 01 JUL 2016

4	ADDENDUM 1-11	13 MAY 2016
3	ADDENDUM 1-7	16 MAR 2016
2	ADDENDUM 1-3	02 FEB 2016
1	ADDENDUM 1-1	29 JAN 2016
-	ISSUED FOR CONSTRUCTION (BPT)	15 JAN 2016

No.	Description	Date
Drawing Title:		
LEVEL 05 ROOF FRAMING PLAN		
Project No.: 04561.01		
Checked by:		