



PARIC CORPORATION
77 Westport Plaza Suite 250
St. Louis, MO 63146
TEL: 636-561-9500
FAX: 636-561-9501

REQUEST FOR INFORMATION **DATE:** April 13, 2016 **NO.:** RFI-034

To: Cannon Design

Attn: Kelvin Patel

From: Paric Corporation

Requested By: Devin Gates

Project Name: Webster University Interdisciplinary Science Building Project No.: 15051

Subject: Existing irrigation lines at ISB project

Response Required By: April 20, 2016

Drawing / Spec Reference:

Information Requested:

There are existing irrigation lines running thru the ISB project limits that will need to be relocated to construct the building. See attached plan markups. These lines feed out of the East side of the EAB. Should these existing lines be relocated back so the existing irrigation system feeds in a similar manner? Or should the new irrigation system incorporate new zones to accommodate the adjacent existing areas? Please advise.

Suggestion: See attached documents for reference.

Response:


Since area to be irrigated with the ISB project is no greater than what is currently being irrigated by the EAB system, SWT recommends designing the new ISB irrigation as a modification to the existing EAB irrigation system. Making adjustment to existing zones and utilizing the existing EAB controller and main line connection. See attachment for suggested routing for mainline.

ARCHITECT'S RESPONSE:


This information is provided as an interpretation of the Contract Documents for implementation. It is not an authorization for change to the Contract Sum or Contract Time. If this information results in a claim for a change to the Contract, the Contractor shall notify the [Construction Manager][Architect] of a change through the change process.

Answered By: _____


Date: _____

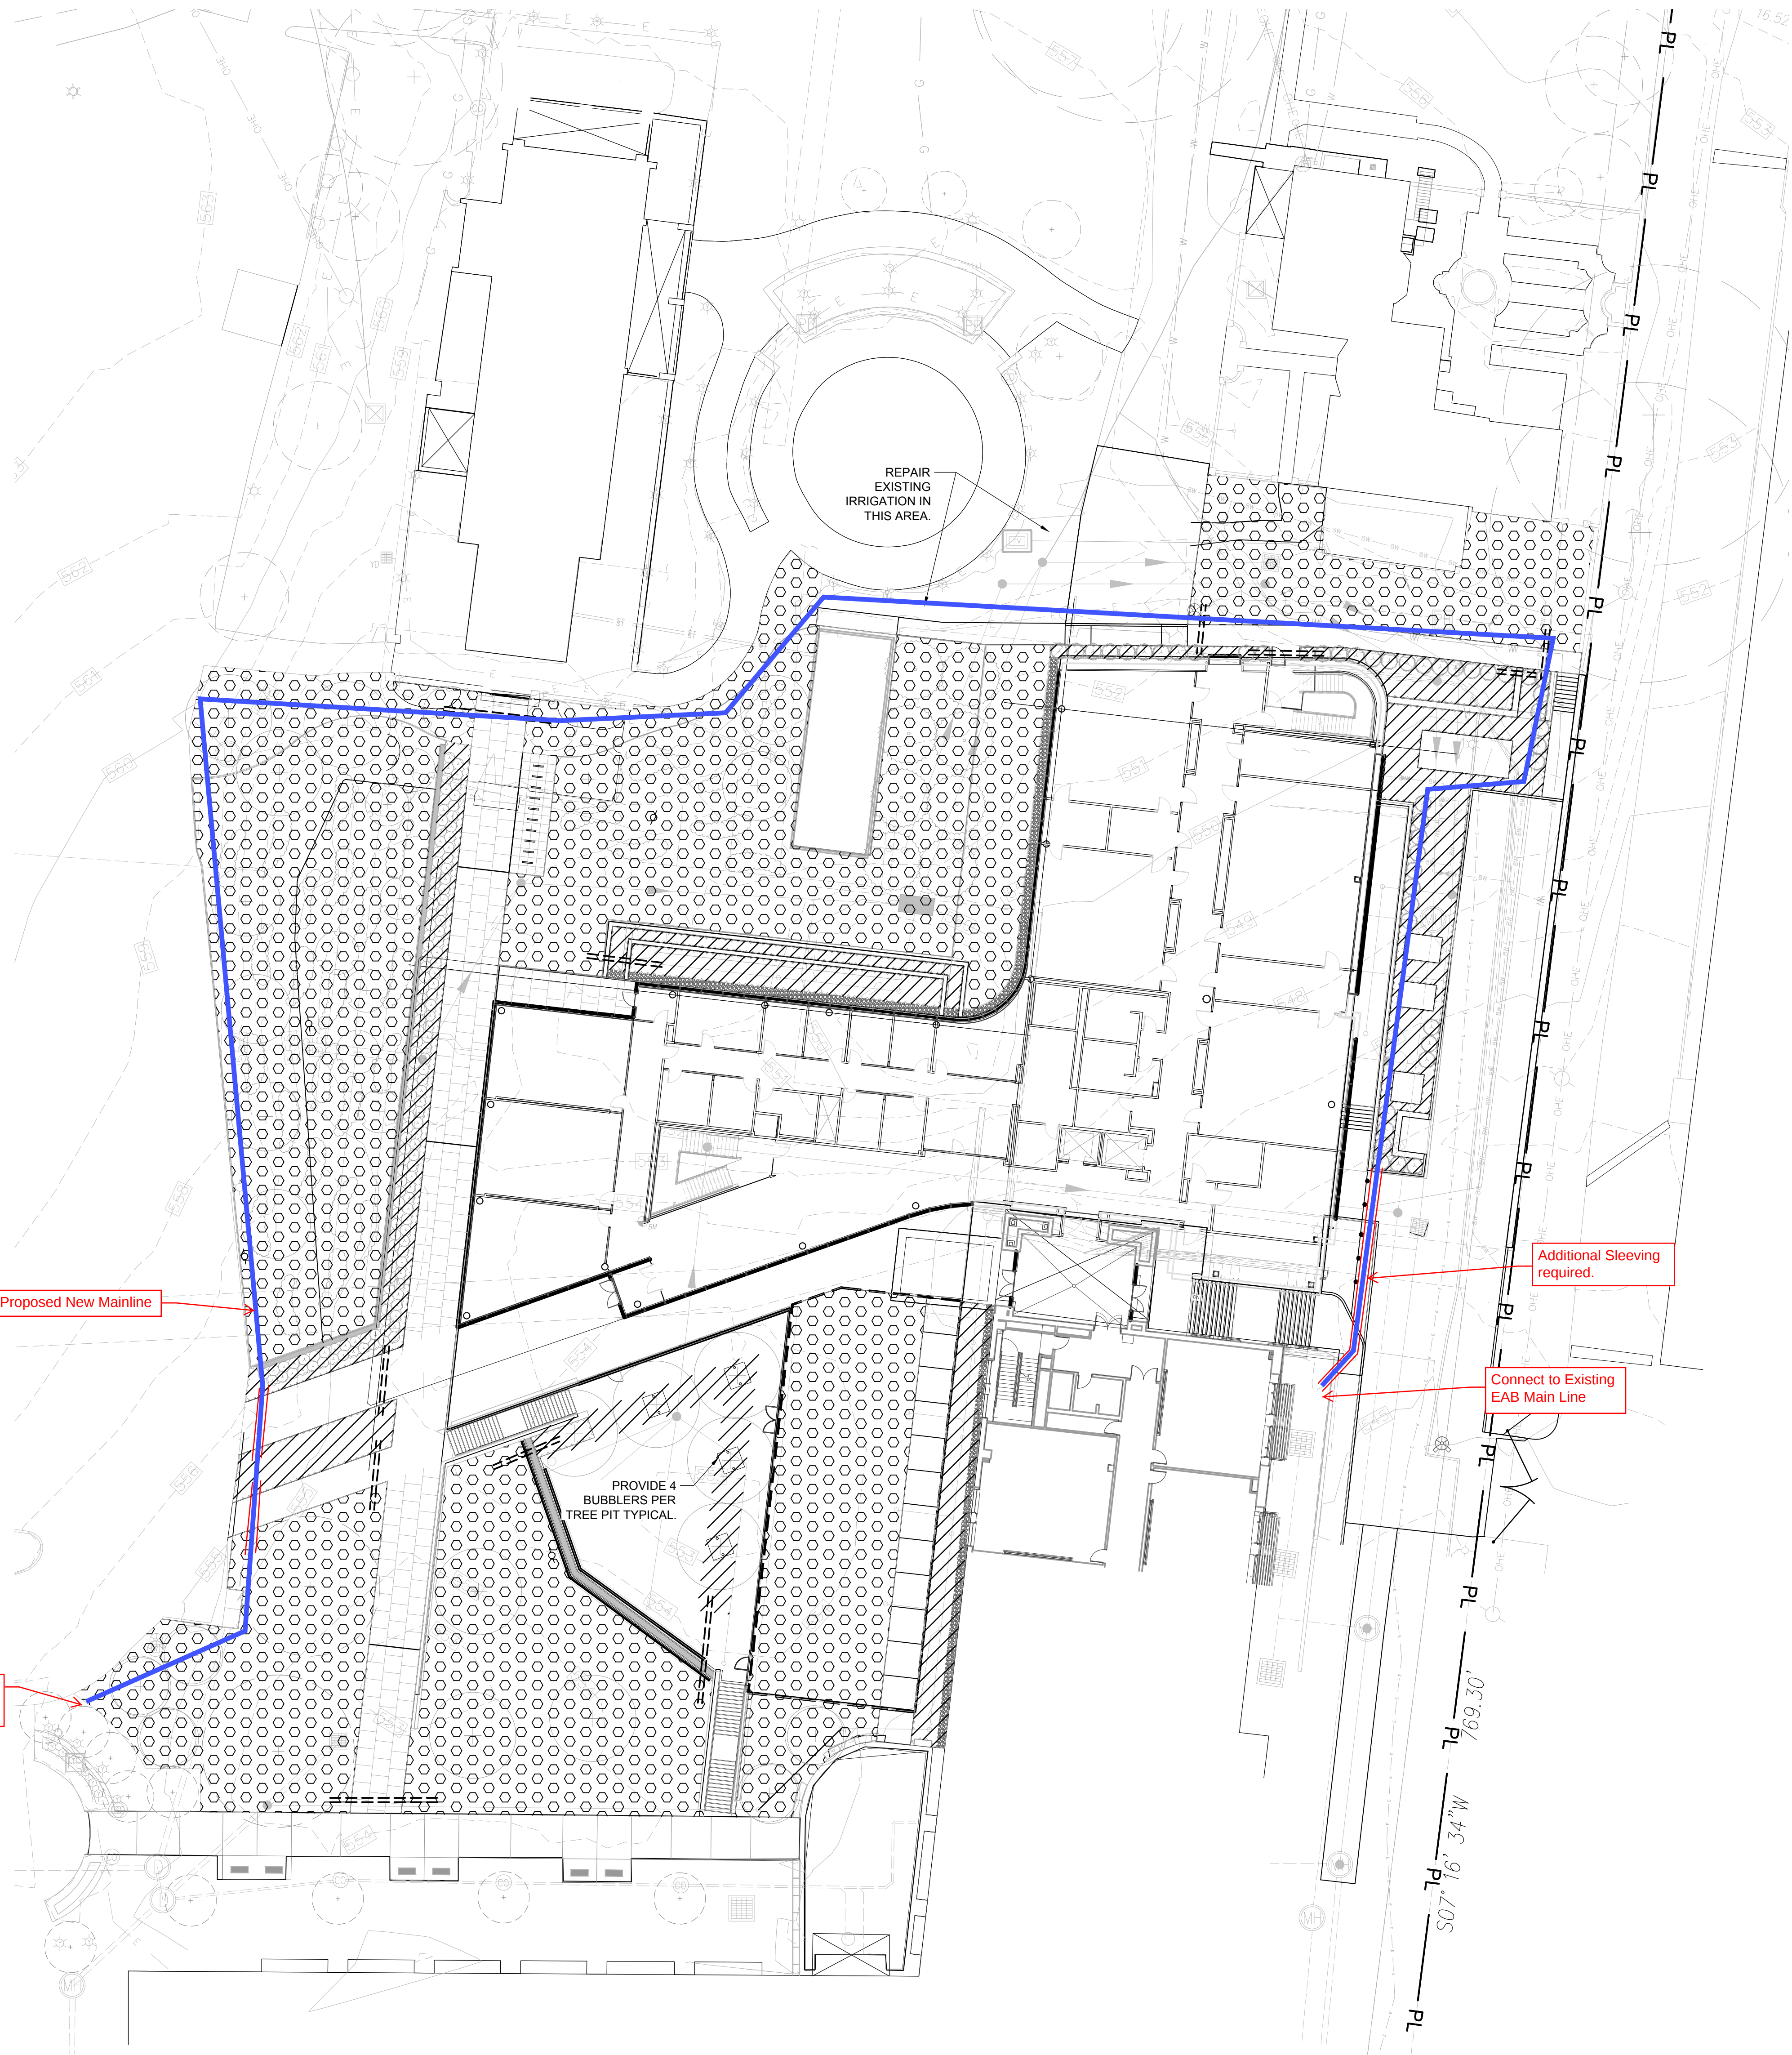


LEGEND

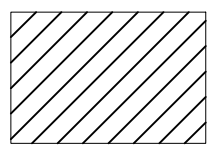

POP UP SHRUB BUBBLERS

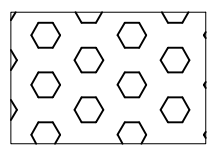

SPRAY IRRIGATION
- TURF AREAS, POPUP ROTORS.
- BMP AREAS SHALL BE IRRIGATED BY
HIGH POPUP SPRAYS/ROTORS
LOCATED ALONG THE PERIMETER OF
THE PLANTING AREAS.

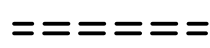

IRRIGATION SLEEVE

NOTES:

1. COORDINATE CONTROLLER LOCATION WITH OWNER.
2. COORDINATE BACKFLOW LOCATION WITH CIVIL/MEP DRAWINGS.
3. SEE SPECIFICATIONS.



Webster University
Interdisciplinary Science
Building

CANNONDESIGN

1100 Clark Avenue
St. Louis, Missouri 63102
T: 314.241.6250
F: 314.241.2570

William Tao & Associates, Inc.
MEP/FP Engineer
7955 Manchester Road, Suite 125
St. Louis, MO 63143
314-884-7600


David Mason & Associates, Inc.
Structural & Civil Engineer
800 South Vandeventer Avenue
St. Louis, MO 63110
314.534.1053

SWT Design
Landscape Architect
7722 Big Bend Blvd
St. Louis, MO 63119
314.644.5700

Spellman Brady & Company
Interior Designer
8251 Maryland Avenue, Suite 300
St. Louis, MO 63105
314.862.0070

Webb Engineering Services, Inc.
Plumbing & Fire Protection
1400 S. 3rd Street, Suite 201
St. Louis, MO 63104
314.588.0600

Faith Group
Technology
930 N. McKnight Rd
St. Louis, MO 63132
314.991.2228

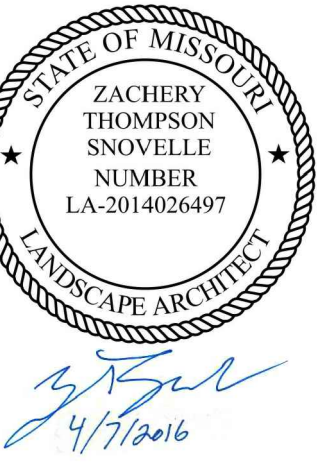

ISSUED FOR CONSTRUCTION (BPS) 15 MAR 2016

No.	Description	Date
-----	-------------	------

Drawing Title:

IRRIGATION
PLAN

SWT Project No.: 20018.01 Checked by:

L170

MSD P# 28874-01 MSD BASE MAP 23K2

© Cannon Design 2015

IRRIGATION EQUIPMENT SCHEDULE

Backflow Preventers
Symbol Description
N Febco Reduced Pressure Assembly In Line "Y"

Controllers
Symbol Description
A Rainbird LXPLUS modular

Equipment
Symbol Description
N Netam Filter
N Netam Pressure Regulator

Irrigation Heads
Symbol Description
V RAINBIRD 3500 Series Nozzle 2 ADJ.
* RAINBIRD 5000 Plus 2.5 ADJ.
* RAINBIRD 5000 Plus 3.0 360°
* RAINBIRD 5000 Plus 3.0 ADJ.
* RAINBIRD 5000 Plus 3.0 ADJ.
* RAINBIRD Plastic MPR Nozzles Nozzle 8 Series trajectory 10 deg 90°
* RAINBIRD Plastic MPR Nozzles Nozzle 8 Series trajectory 10 deg 180°
* RAINBIRD Plastic MPR Nozzles Nozzle 10 Series trajectory 15 deg 90°
* RAINBIRD Plastic MPR Nozzles Nozzle 10 Series trajectory 15 deg 180°
* RAINBIRD Plastic MPR Nozzles Nozzle 12 Series trajectory 30 deg 180°
* RAINBIRD Plastic MPR Nozzles Nozzle 15 Series trajectory 30 deg 90°
* RAINBIRD Plastic MPR Nozzles Nozzle 15 Series trajectory 30 deg 180°

Pipe (Lateral)
Symbol Description
— 200 PSI SDR 21 PVC Pipe
— 200 PSI SDR 21 PVC Pipe
— 200 PSI SDR 21 PVC Pipe
— 200 PSI SDR 21 PVC Pipe

Pipe (Mainline)
Symbol Description
— 200 PSI SDR 21 PVC Pipe

Pipe (Sleeve)
Symbol Description
— 200 PSI SDR 21 PVC Pipe
— 200 PSI SDR 21 PVC Pipe

Point of Connection
Symbol Description
⊕ 2" PDC

Subsurface
Symbol Description
— 0.60 gph, 18.00 in on center, 20.00 in spacing

Valves
Symbol Description
N Control Valve Brio
N Quick Coupler Valves

Symbol Description
⊙ 33RC

DRIP ORNAMENTAL ZONE LABEL




D10 1" PDC
Drip zone #
GPM
Valve Size
*Rain Bird LD-06-12

SPRAY TURF ZONE LABEL

S10 1" PDC
Spray zone #
GPM
Valve Size
*4" 1804 Rainbird
** RAINBIRD MPR Nozzle

ROTOR TURF LABEL

R10 1" PDC
Rotor zone #
GPM
Valve Size
*4" Rainbird 5004
** Standard 3.0 Nozzle

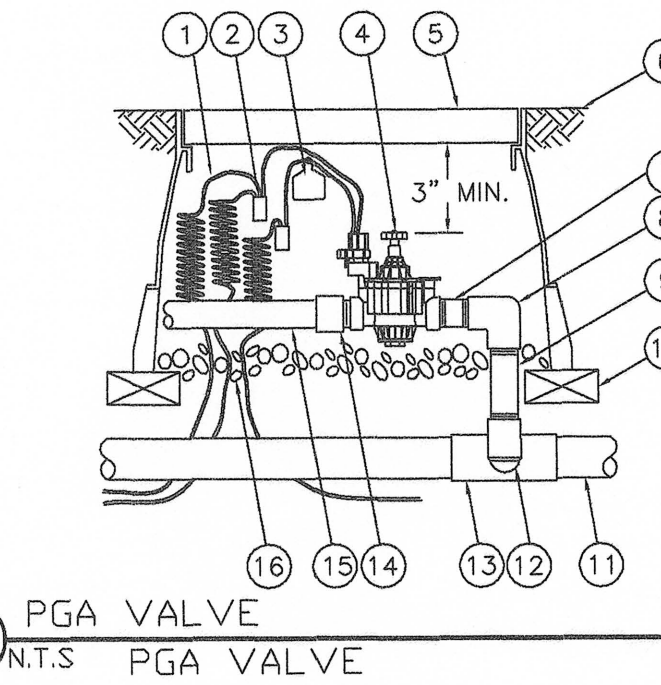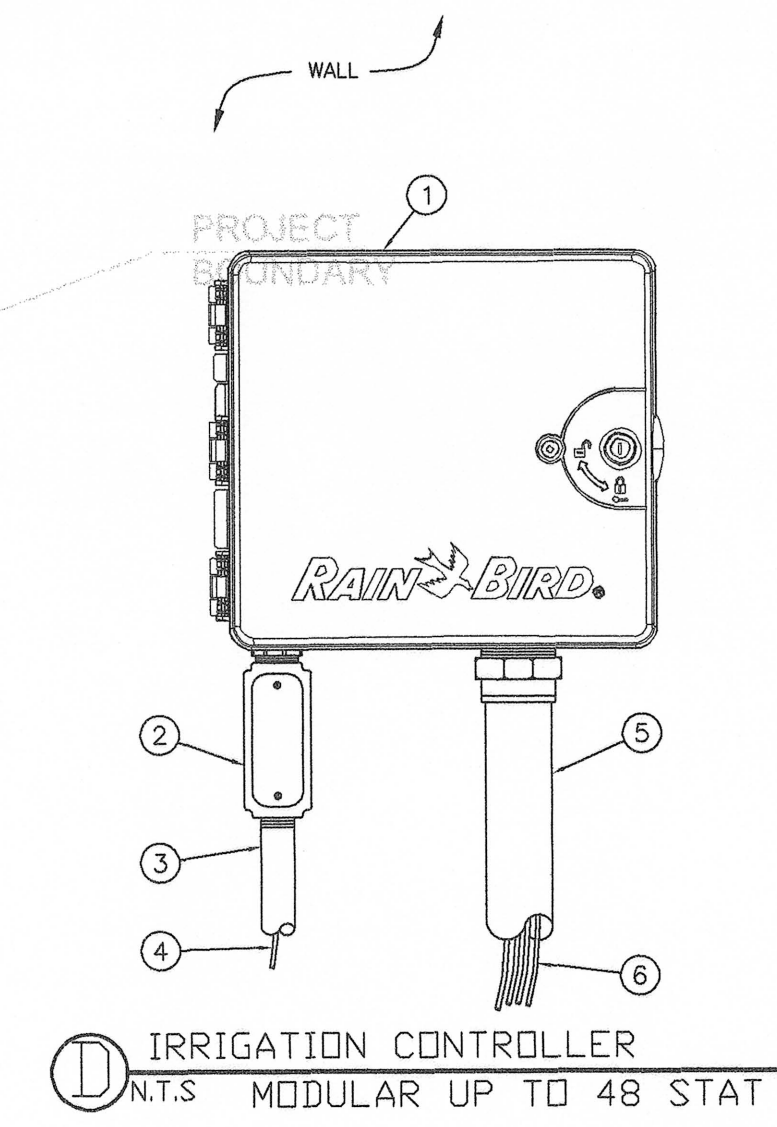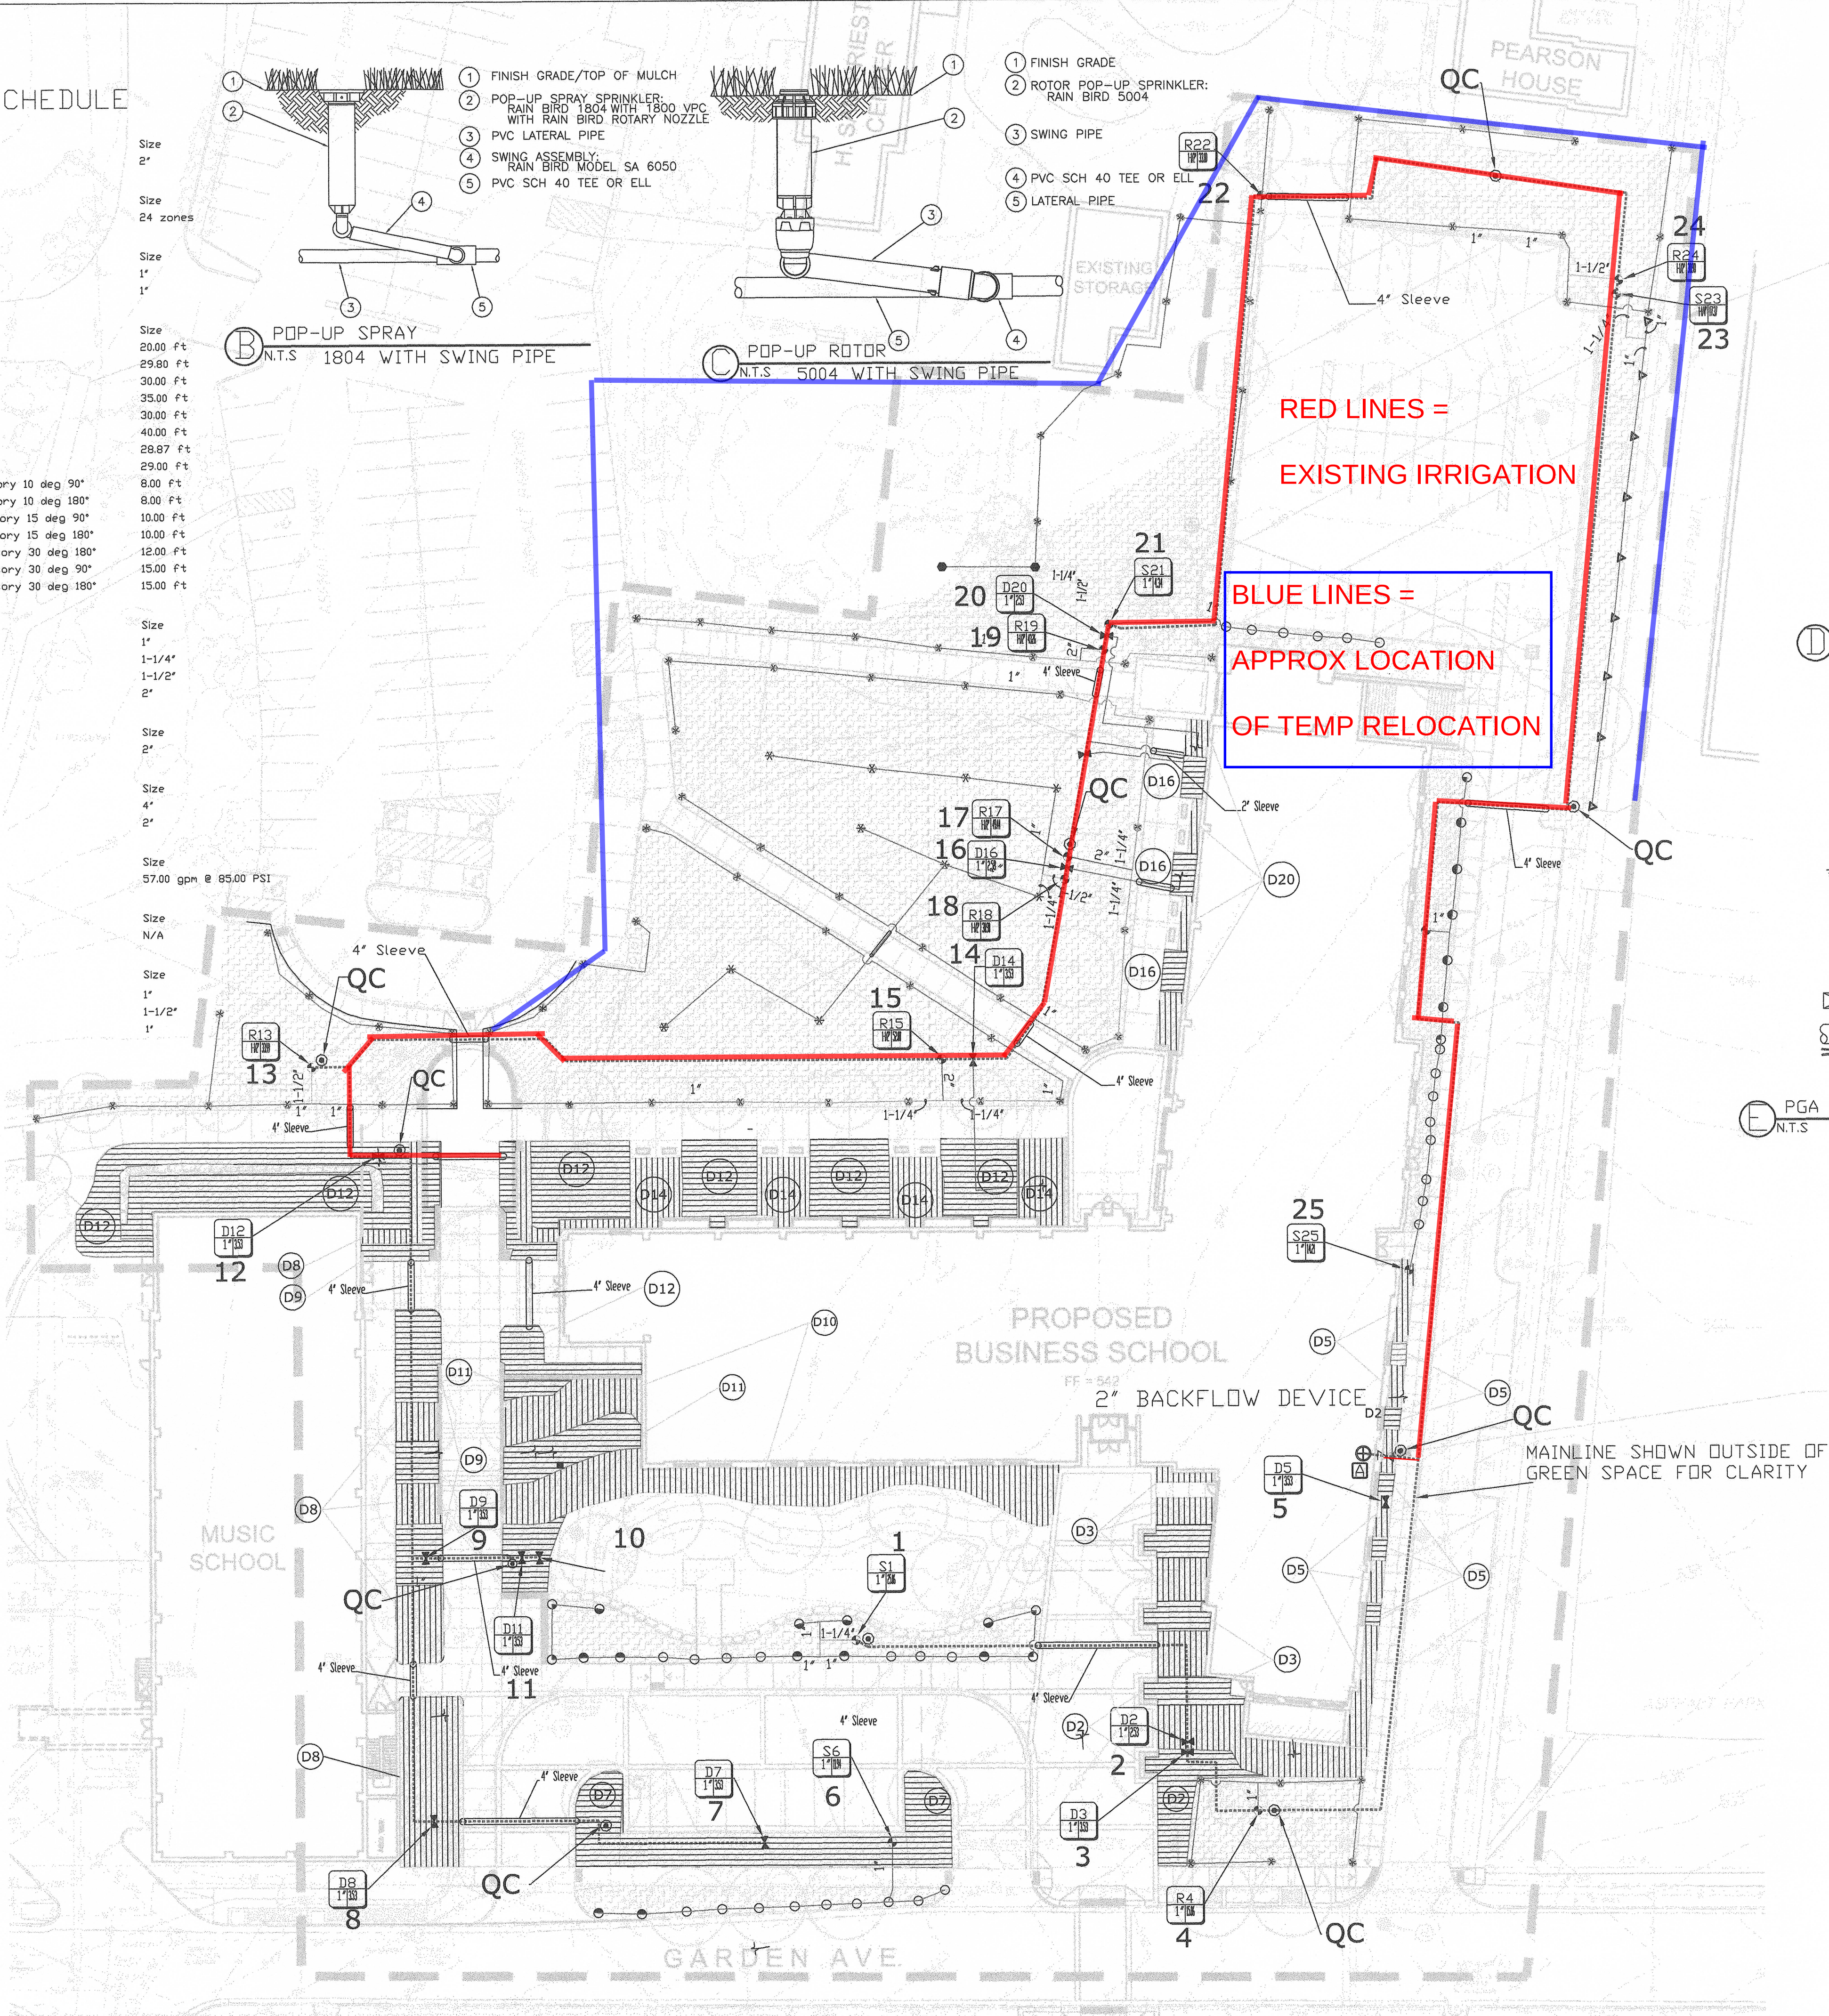

WEBSTER UNIVERSITY
School of Business and Technology
470 East Lockwood Avenue
Irrigation Plan
8/28/2011
REV 10/13/2011
AS BUILT 6/15/2012

Roden's
Irrigation Division
This Proprietary Document
Is The Property Of
Roden's Landscaping, Inc.
7800 Hwy. N., O'Fallon, MO.
This Document is not to be Duplicated
or used for Irrigation Installation
Unless Written Permission is Given by
Karen A. Roden, President
Roden's Landscaping, Inc.

LEGEND
1. THE PRO BY A LIC SEALED REQUIRE OWNERS APPROV
2. COORDI OWNER'S ARCHITE
3. PROVIDE AND CUT
4. INSTALL SPACING LOCATIO AS INDIC
5. SEE IRR

REQUIREMENTS.
1. IRRIGATION CONTRACTOR SHALL COMPLY WITH ALL LOCAL, ST
7800 Hwy N
O'Fallon, MO 63368
Roden's
LANDSCAPING, INC.
Office: (636) 561-3947
Fax: (636) 561-3948
E FOR CA
TO INCL
IES AND
EXCAVA
ID), AND
COORDINATED WITH THE GENERAL CONTRACTOR AND OWNER
8. THE IRRIGATION CONTRACTOR SHALL VERIFY WATER PRESSUR
REPORT ANY DIFFERENCE BETWEEN THE WATER PRESSURE RE
CONNECTION AND THE DESIGN PRESSURE TO THE OWNER'S RE
PRESSURE DIFFERENCES ARE NOT REPORTED PRIOR TO STAR
IRRIGATION CONTRACTOR SHALL ASSUME FULL RESPONSIBILI
1. IRRIGATION CONTROLLER: SYSTEM SHALL BE RAINBIRD OR TORO OR APPROV
RAIN BIRD: ESP-LXME, CONTROLLER IN PLASTIC CABINET TAPE ARCHITECT AND OW
WITH WALL MOUNT, INSTALL CONTROLLER AND CABINET
ON WALL PER MANUFACTURER'S RECOMMENDATIONS: 1.50 GPM @ 65 PSI. CONTRA
CONDITIONS. LOCATION OF CONTROLLERS AND POINT OF CON
2. JUNCTION BOX
3. 1-INCH CONDUIT AND FITTINGS TO POWER SUPPLY
4. POWER SUPPLY WIRE
5. 2-INCH CONDUIT AND FITTINGS FOR STATION WIRES
6. WIRES TO REMOTE CONTROL VALVES
14. CONTRACTOR SHALL SUBMIT MANUFACTURER'S LITERATURE, I
PROCEDURES AND DETAILS FOR IRRIGATION SYSTEM.
15. ALL PLANT MATERIAL SHALL BE AUTOMATICALLY IRRIGATED AS
PER THE SPECIFICATIONS.
16. IRRIGATION SHALL BE ZONED APPROPRIATELY (SUNNY VS. SHA
AREAS, SLOPED VS. FLAT AREAS) AND USING APPROPRIATE HE
17. EACH TREE SHALL GET A DRIP RING.
18. SHRUB MASSES SHALL GET A DRIP DISTRIBUTION ZONE (1 EMT
19. NATIVE PLUGS SHALL GET HIGH POP-UP SPRAYS.
20. ALL DRIP ZONES ARE TO HAVE 1CY OF DRAINAGE GRAVEL AT T
21. INSTALL ONE (1) QUICK COUPLER VALVE EVERY 200' OF MAINLI
END RUNS OF MAINLINE. CONTRACTOR TO DETERMINE LOCATI
1. IRRIGATION CONTRACTOR IS RESPONSIBLE FOR THE INSTA
WIRING TO BE DIRECT BURIAL IN THE SAME TRENCH WITH MAIN
3. 30-INCH LINEAR LENGTH OF
WIRE, COILED
2. WATERPROOF CONNECTION
RAIN BIRD SPLICE-1 (1 OF 2)
3. ID TAG: RAIN BIRD VID SERIES
4. REMOTE CONTROL VALVE
RAIN BIRD PGA
5. VALVE BOX WITH COVER
RAIN BIRD V-STD
6. FINISH GRADE/TOP OF MULCH
7. PVC SCH 80 NIPPLE (CLOSE
8. PVC SCH 40 ELL
9. PVC SCH 80 NIPPLE
(LENGTH AS REQUIRED)
10. BRICK (1 OF 4)
11. PVC MAINLINE PIPE
12. SCH 80 NIPPLE (2-INCH
LENGTH, HIDDEN)
13. PVC SCH 40 TEE OR ELL
14. PVC SCH 40 MALE ADAPTER
15. PVC LATERAL PIPE
16. 3.0-INCH MINIMUM DEPTH OF
3/4-INCH WASHED GRAVEL

	RAINBIRD 1804 SPRAY HEAD WITH FLEX CONNECTION
	RAINBIRD 1812 SPRAY HEAD WITH FLEX CONNECTION
	RAINBIRD 5000 ROTOR HEAD WITH FLEX CONNECTION
	RAINBIRD PGA ELECTRIC ZONE VALVE IN 10" VALVE BOX
	RAINBIRD "ESP" SERIES CONTROLLER
	PVC SLEEVE UNDER PAVEMENT
	PVC IRRIGATION MAINLINE, SIZED AS SHOWN
	PVC LATERAL PIPING, SIZED AS SHOWN
	POINT OF CONNECTION, VALVED STUB SIZED AS SHOWN
	WILKEN'S REDUCED PRESSURE BACKFLOW PREVENTER
	VALVE SIZE AND ZONE SEQUENCE
	16MM DRIP IRRIGATION TUBING



AS BUILT DRAWING 10/18/12

revisions		
no.	date	description

IRRIGATION SYSTEM BY:



PROJECT: WEBSTER UNIVERSITY
GARDEN AVE. PLAZA
COMPASS PLAZA

job no.

date
8/6/12

sheet no.

IRR-1