



PARIC CORPORATION
77 Westport Plaza Suite 250
St. Louis, MO 63146
TEL: 636-561-9500
FAX: 636-561-9501

REQUEST FOR INFORMATION	DATE: May 03, 2016	NO.: RFI-060
--------------------------------	---------------------------	---------------------

To: Cannon Design

Attn: Kelvin Patel

From: Paric Corporation

Requested By: Devin Gates

Project Name: Webster University Interdisciplinary Science Building Project No.: 15051

Subject: Vertical Bracing Connection Design Joint Forces

Response Required By: May 10, 2016

Drawing / Spec Reference:

Information Requested:

Please advise the shear connection for each beam at braced frame. They are missing from floor reaction files we received.

Response:

Attached are the composite beam reactions requested. These are the same documents sent on 5/5/2016 to AIW.


ARCHITECT'S RESPONSE:

This information is provided as an interpretation of the Contract Documents for implementation. It is not an authorization for change to the Contract Sum or Contract Time. If this information results in a claim for a change to the Contract, the Contractor shall notify the [Construction Manager][Architect] of a change through the change process.

JILL WALKER / DMA

Answered By: _____

Date: 5/6/2016

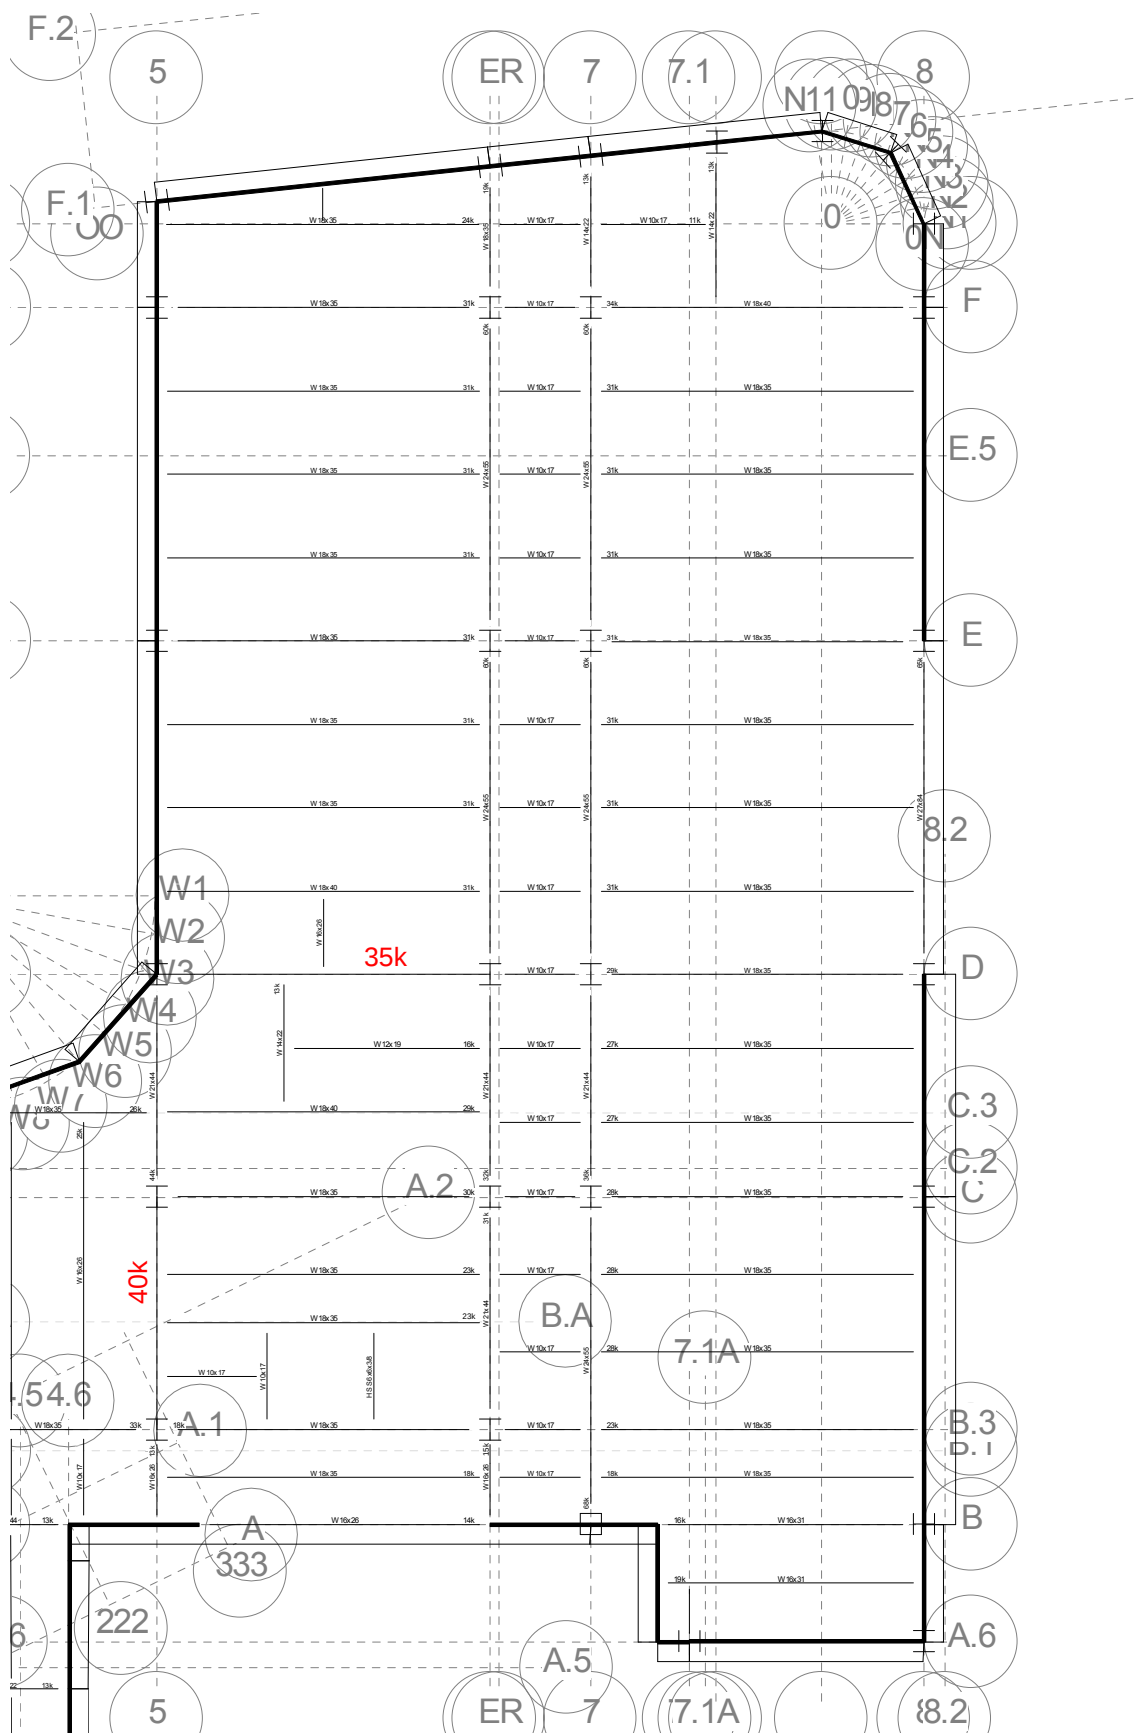



Floor Map

RAM Steel 14.07.01.01


DataBase: Webster ISB wLateral V1

Building Code: IBC

04/18/16 08:32:02

Steel Code: AISC360-05 ASD

Floor Type: Level 02

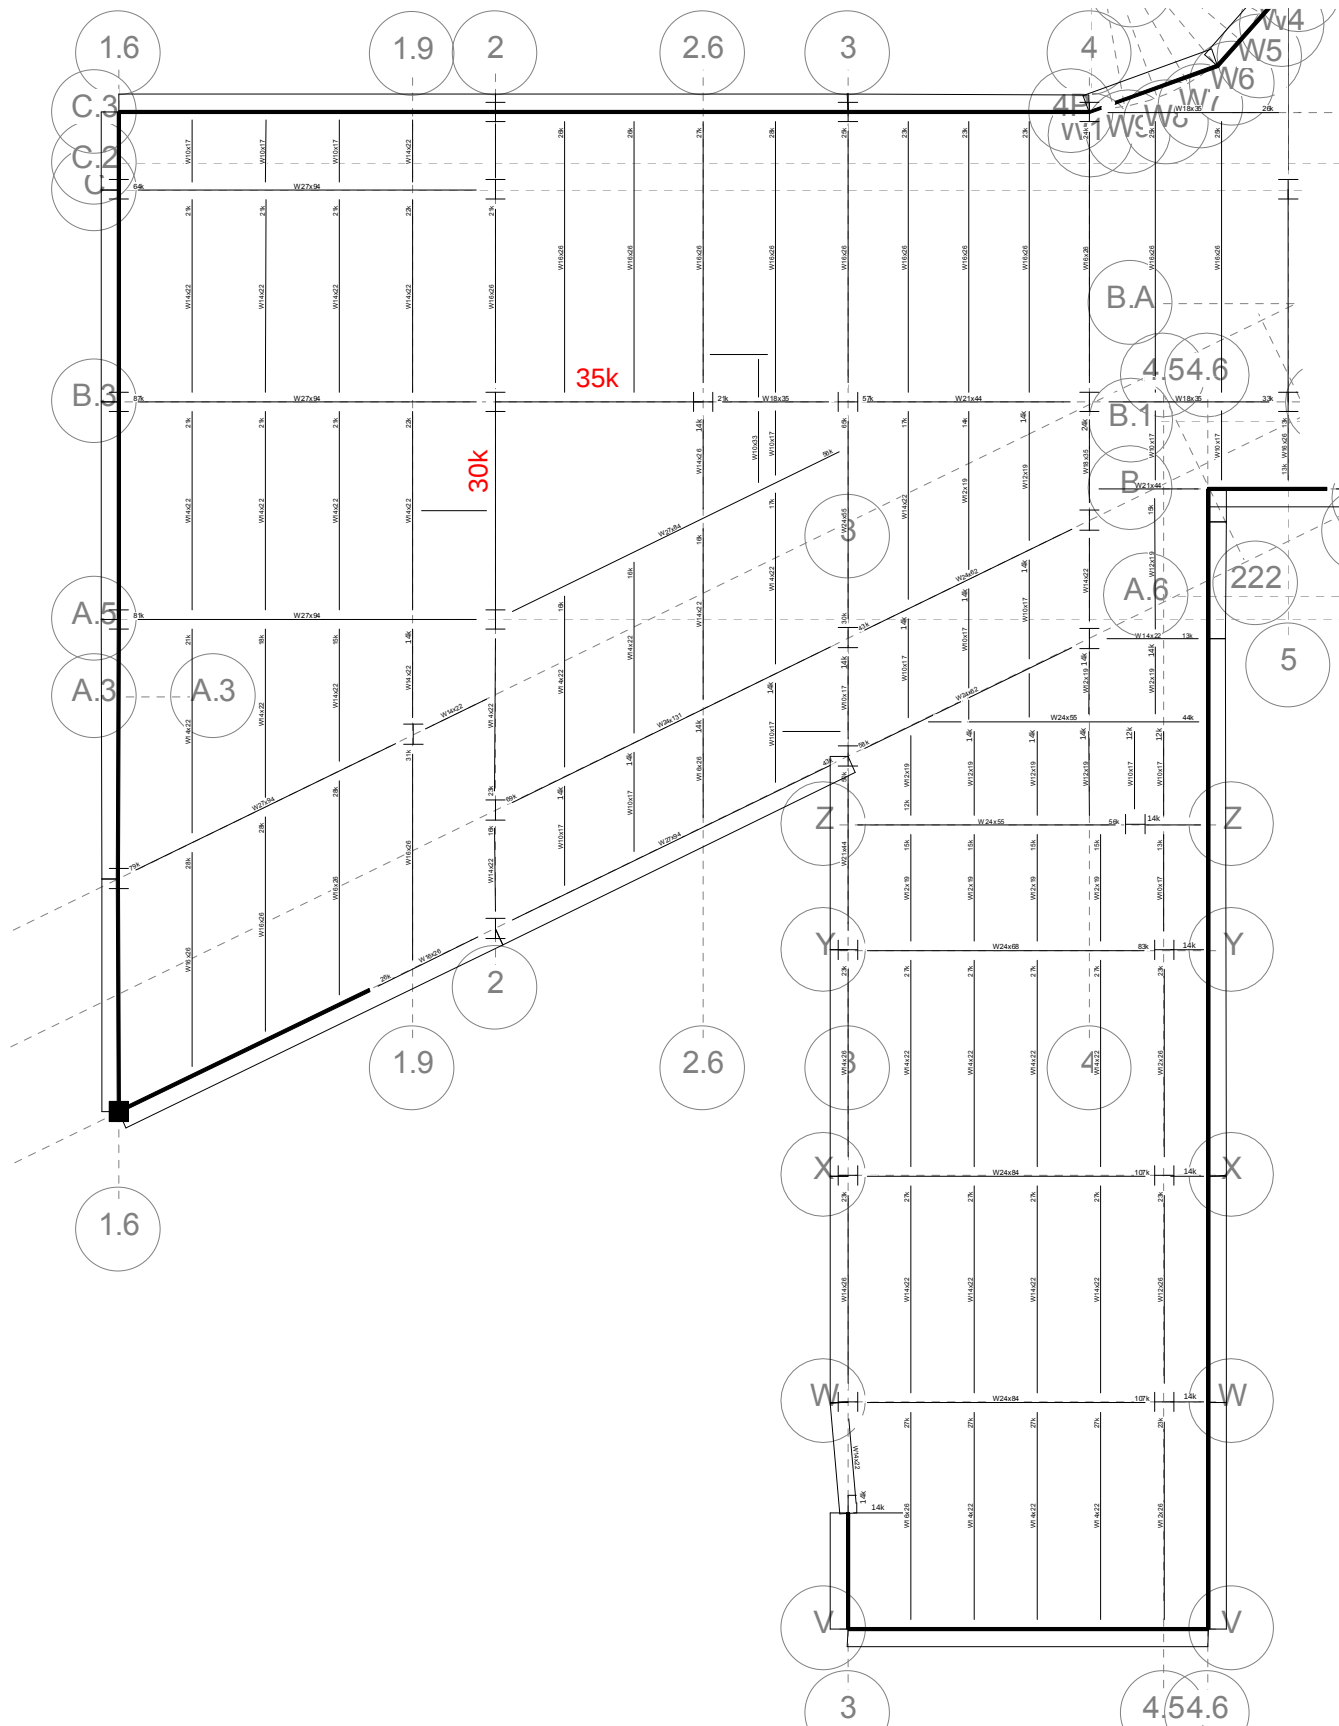

L04 NORTH
REACTIONS
ARE SAME AS
THOSE LISTED
FOR L03 NORTH





RAM Steel 14.07.01.01
DataBase: Webster ISB wLateral V1
Building Code: IBC

Floor Map

04/18/16 08:32:02
Steel Code: AISC360-05 ASD

Floor Type: Level 03

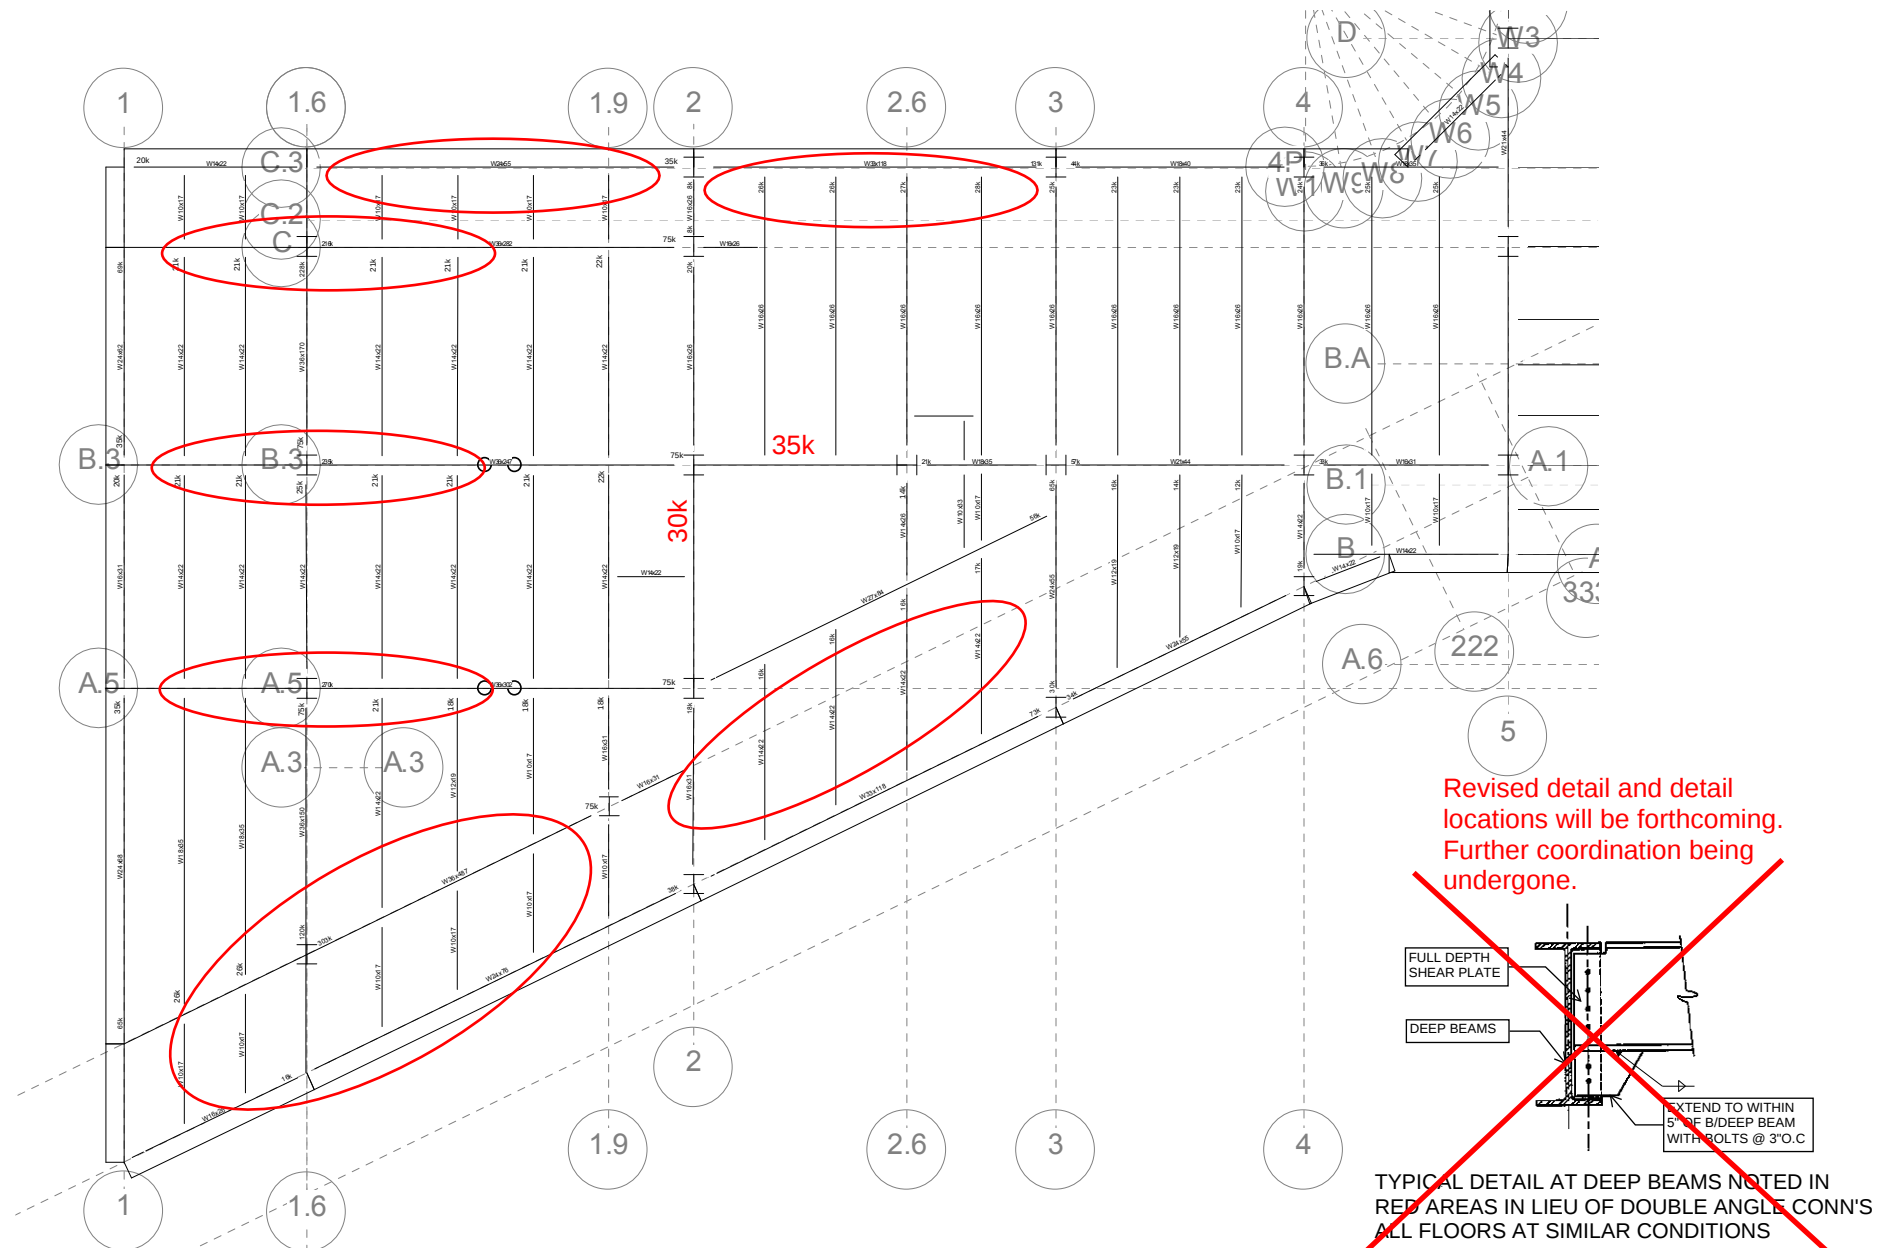

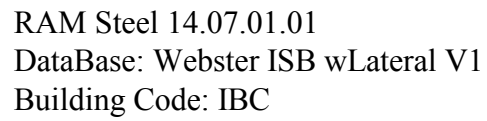

05/04/16 16:20:25
Steel Code: AISC360-05 ASD

Floor Type: Level 04

