



PARIC CORPORATION
77 Westport Plaza Suite 250
St. Louis, MO 63146
TEL: 636-561-9500
FAX: 636-561-9501

REQUEST FOR INFORMATION **DATE:** May 11, 2016 **NO.:** RFI-071

To: Cannon Design

Attn: Kelvin Patel

From: Paric Corporation

Requested By: Devin Gates

Project Name: Webster University Interdisciplinary Science Building Project No.: 15051

Subject: Level 0 vent connections

Response Required By: May 18, 2016

Drawing / Spec Reference:

Information Requested:

Plumbing plan for L0 ceiling shows several vents combining in the L0 ceiling near D-8: three floor drain vents, and the vent from the draintile basin. Please confirm that these vents are indeed supposed to connect together in L0 ceiling, since it appears to be below the flood rim level of the floor drains. See attached sketch.

Response:

The three vents from the floor drains will be modified to turn up to Level 1 and make the tie-ins on that level.
This will be addressed in an up-coming addendum.


ARCHITECT'S RESPONSE:

This information is provided as an interpretation of the Contract Documents for implementation. It is not an authorization for change to the Contract Sum or Contract Time. If this information results in a claim for a change to the Contract, the Contractor shall notify the [Construction Manager][Architect] of a change through the change process.

..

Answered By: Mike Whitworth - WES

Date: May 13, 2016

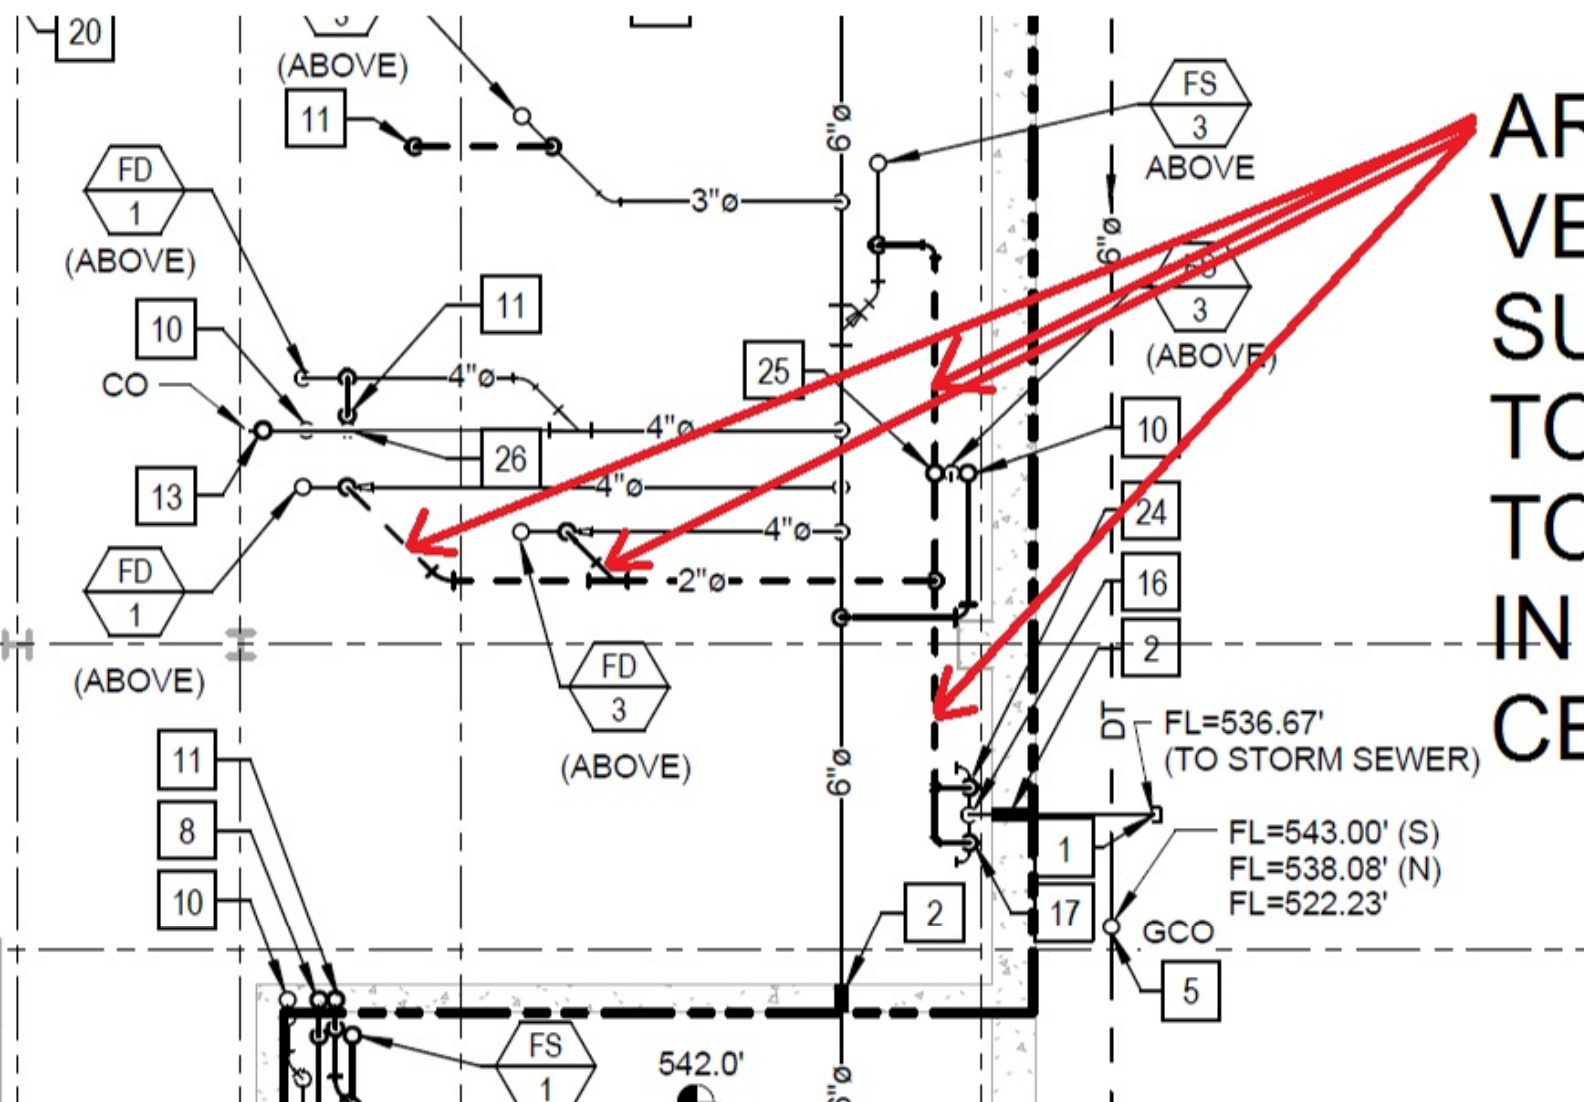

ARE THESE
VENTS
SUPPOSED
TO ALL TIE
TOGETHER
IN LEVEL 0
CEILING?