



PARIC CORPORATION
77 Westport Plaza Suite 250
St. Louis, MO 63146
TEL: 636-561-9500
FAX: 636-561-9501

REQUEST FOR INFORMATION	DATE: May 27, 2016	NO.: RFI-123
--------------------------------	---------------------------	---------------------

To: Cannon Design

Attn: Kelvin Patel

From: Paric Corporation

Requested By: Devin Gates

Project Name: 15051-Webster University Interdisciplinary Science Building	Project No.: 15051
---	--------------------

Subject: Dimensions for opening in level 2 floor

Response Required By: June 03, 2016

Drawing / Spec Reference:

Information Requested:

RFI 45 note 4 provided a dimension of 1'8" from the face of wall for the opening south of D along 8 line. Addendum 1-11 now shows this dimension at 1'2". Please clarify which dimension is to be used.

Response:

SEE NEXT SHEET


ARCHITECT'S RESPONSE:

This information is provided as an interpretation of the Contract Documents for implementation. It is not an authorization for change to the Contract Sum or Contract Time. If this information results in a claim for a change to the Contract, the Contractor shall notify the [Construction Manager][Architect] of a change through the change process.

Cc: Kathy Bathe, Paric Corporation

Answered By: JILL WALKER / DMA

Date: 2/9/2016

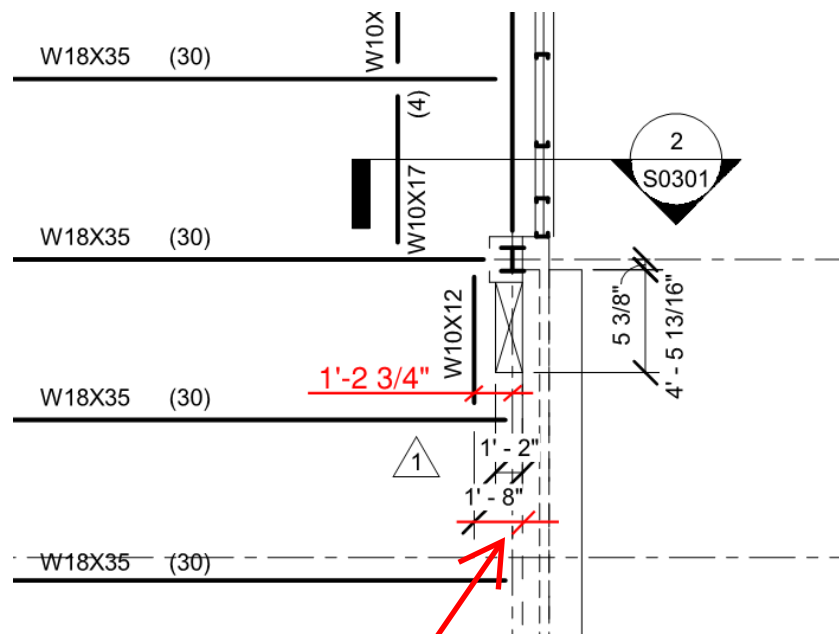

TICK MARK IS
LOCATED ON THE
WRONG LINE IN
ADD 1-11