



PARIC CORPORATION
77 Westport Plaza Suite 250
St. Louis, MO 63146
TEL: 636-561-9500
FAX: 636-561-9501

REQUEST FOR INFORMATION DATE: May 31, 2016 NO.: RFI-135

To: Cannon Design

Attn: Kelvin Patel

From: Paric Corporation

Requested By: Joe Voypick

Project Name: 15051-Webster University Interdisciplinary Science Building Project No.: 15051

Subject: Exterior EOS, L3 & L4 at 5 - C.3

Response Required By: June 07, 2016

Drawing / Spec Reference:

Information Requested:

Please see the attached pdf concerning the exterior edge-of-slab at Levels 3 & 4 near column lines 5 – C.3; and advise if kicker angles will be required where the slab overhang increases beyond the 1'-0 3/4" (17/S0301) due to the radius.

- If kickers are required, please advise the parameters for locating them (EOS greater than ____?)
- Also verify that any kickers would not need to align with the curtainwall mullions.

Response:

FOR GENERAL INFORMATION AT EDGES, REFER TO DETAILS 26/S0002 AND 9/S0003. KICKERS SHOULD BE PROVIDED WHEN THE EOS EXCEEDS 1'-2". AT ROOFS, DETAIL 7/S0302 IS MISSING THE LINEWORK FOR THE EXTERIOR GUSSETS (AS ARE 4/S0302, 4&15&22/S0303, AND 13/S0304). TYPICAL ROOF EDGE DETAILS ARE TO FOLLOW 5&6/S0303. PREVIOUS CORRESPONDENCE WITH ATLAS ALSO ATTACHED.


ARCHITECT'S RESPONSE:

This information is provided as an interpretation of the Contract Documents for implementation. It is not an authorization for change to the Contract Sum or Contract Time. If this information results in a claim for a change to the Contract, the Contractor shall notify the [Construction Manager][Architect] of a change through the change process.


Cc: Kathy Bathe, Paric Corporation

Answered By: JILL WALKER / DMA

Date: 06/09/2016

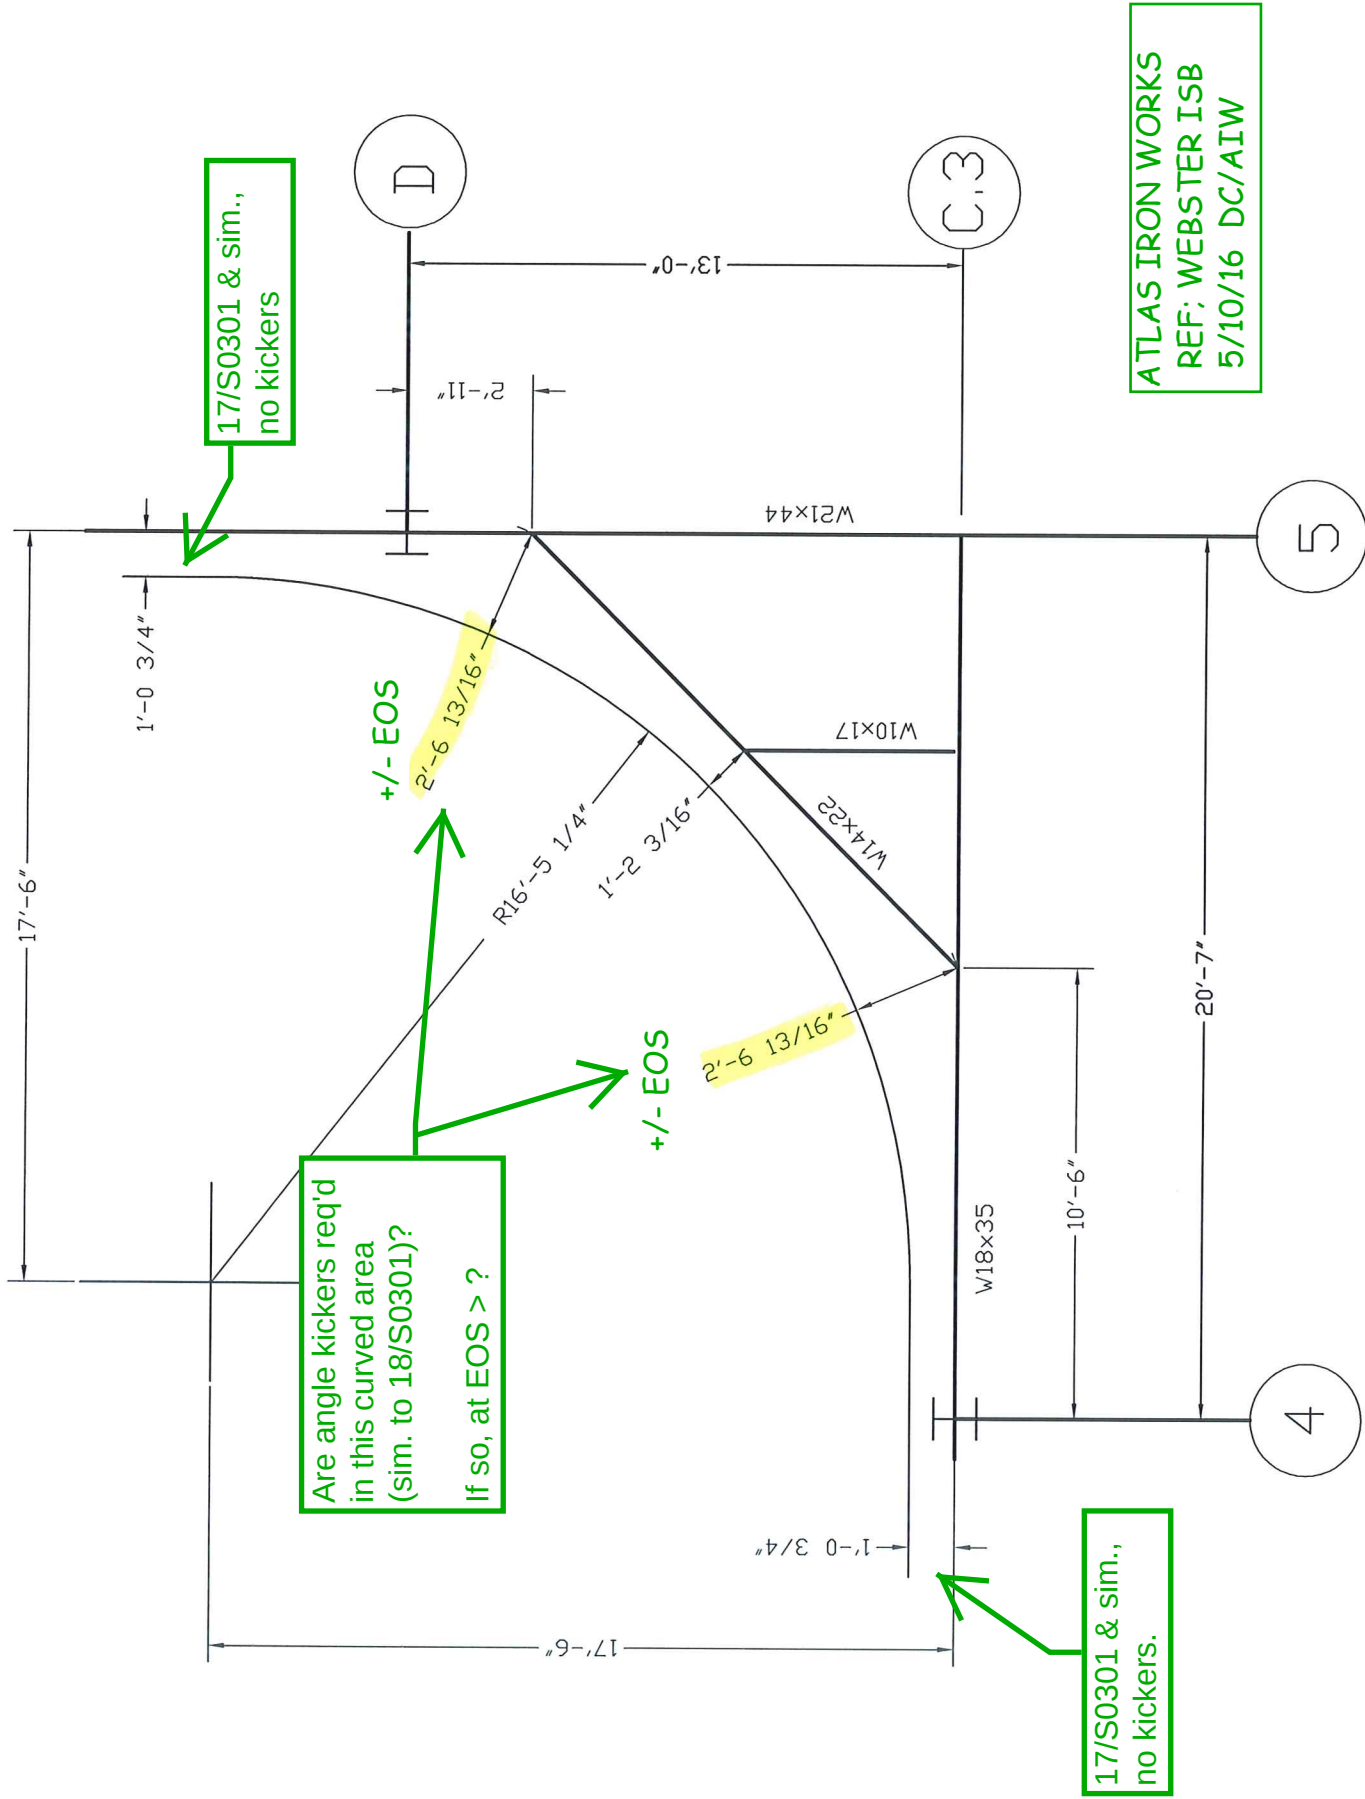

PARTIAL LEVEL 03 & 04 PLAN

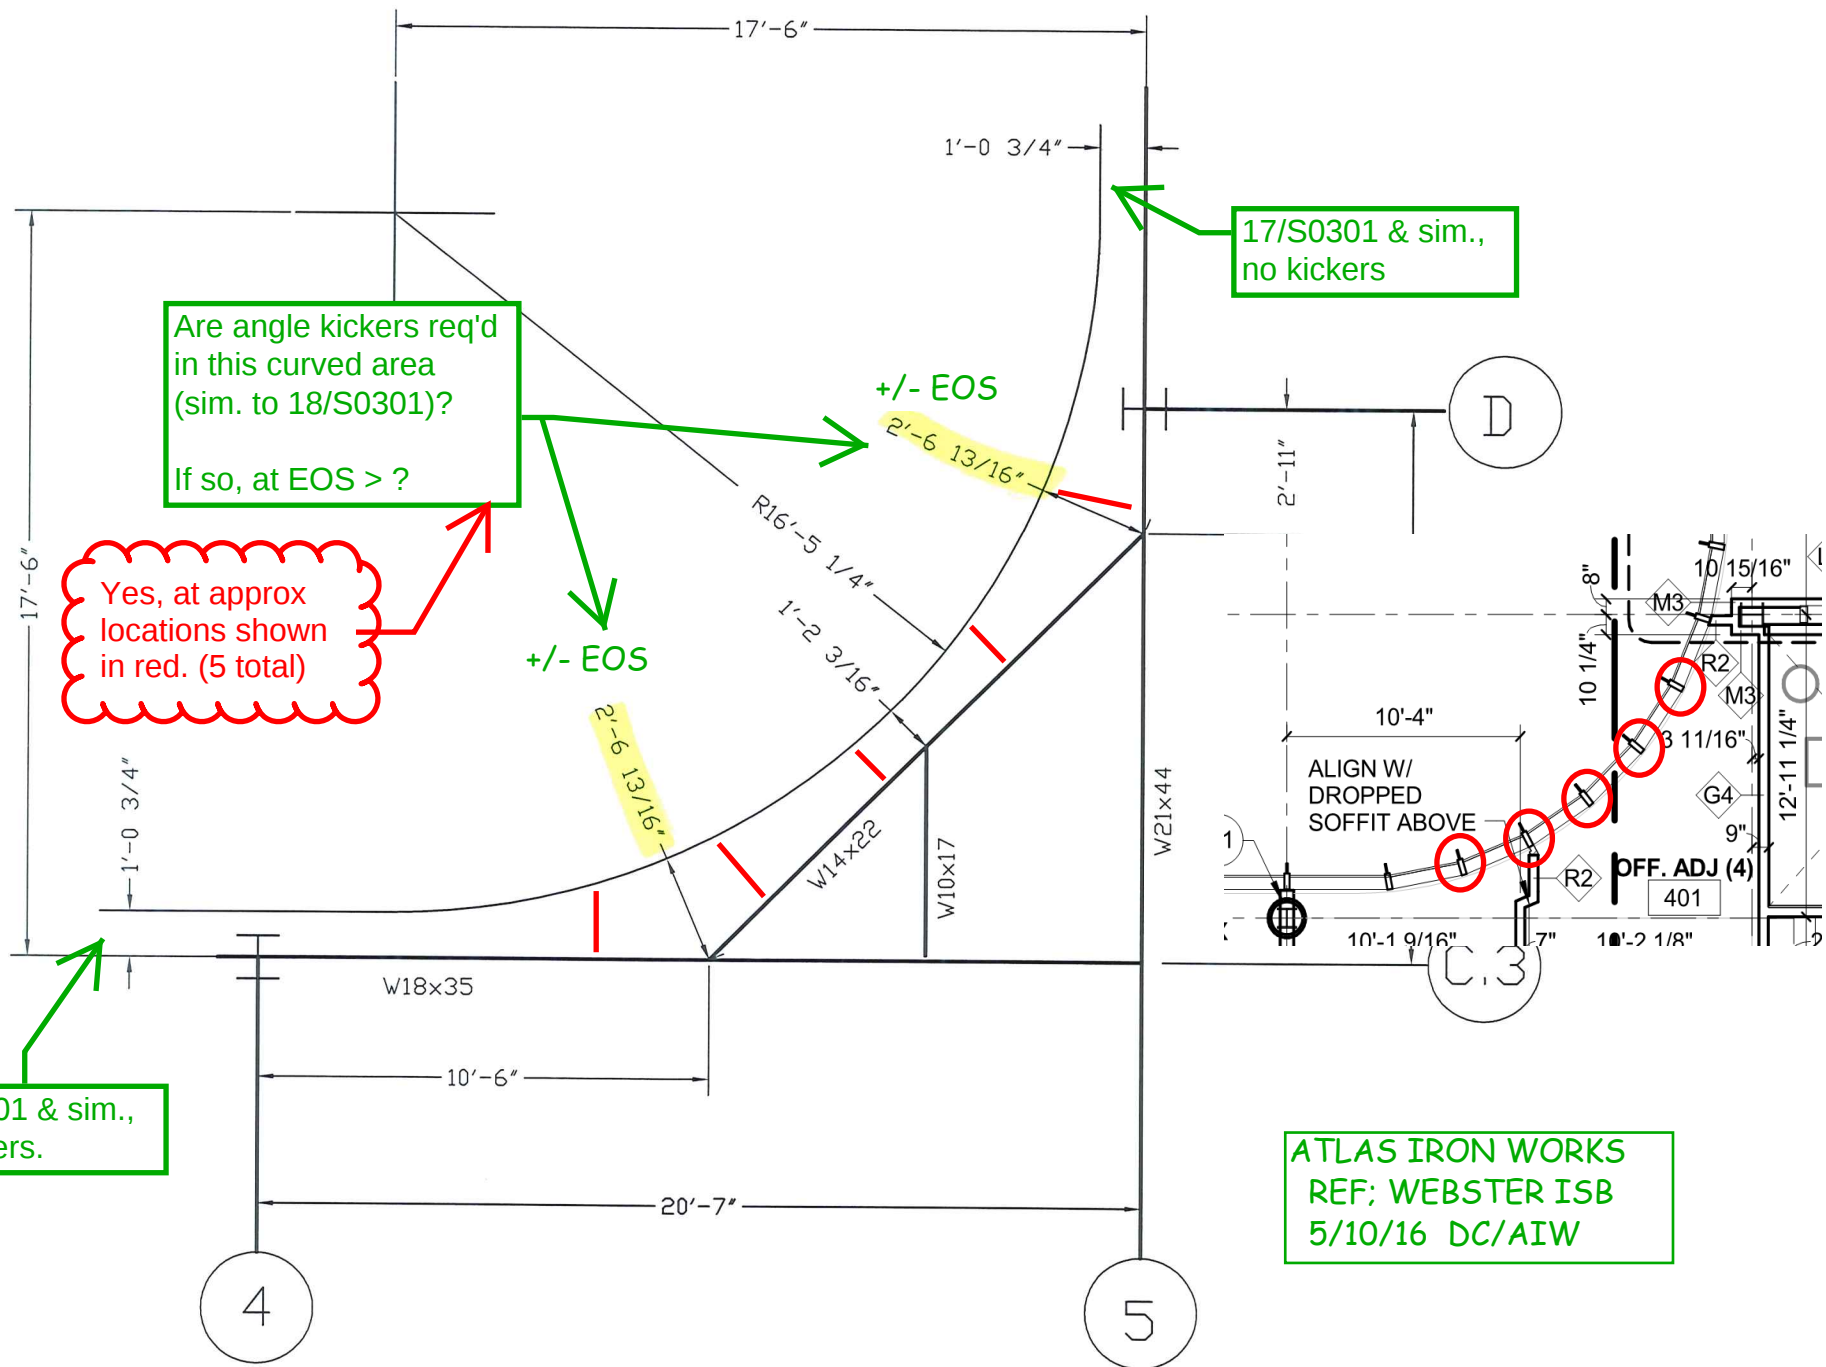

PARTIAL LEVEL 03 & 04 PLAN